


 

HYDROLOGY CALCULATIONS

- AREAS:
TOTAL SITE = 115,000 SF = 2.64 ACRES
PROPOSED IMPERVIOUS AREAS = 76,000 SF = 1.7447 ACRES
- TIME OF CONCENTRATION
 $T_c = 0.0078 \frac{L^{0.77}}{S^{0.385}}$ WHERE $L=652'$
 $S = \frac{H}{L} = \frac{26.8-5.0}{652} = 0.0334 \text{ FT./FT.}$
 $T_c = 0.0078 (652)^{0.77} = 4.24 \text{ MIN.} - \text{USE}$
 $T_c = 10 \text{ MIN.}$
SCS SOILS GROUP: TYPE B
6 HR - 100 YR. STORM = 2.5" (PLATE 22.2 D-1, PAGE 13)
 $I_{100} = (2.5)^{(6.84)(10)^{-0.51}} = 5.28 \text{ IN/HR}$
- UNDEVELOPED CONDITIONS
ONSITE FLOWS:
 $CN = 80$ (PLATE 22.2 C-2, PG. 9)
 $CRN = 83$ (PLATE 22.2 C-3, PG. 10) FOR 0% IMPERVIOUS
DIRECT RUNOFF = 0.88" (PLATE 22.2 C-4, PG. 11)
VOLUME OF RUNOFF = $\frac{(0.88") (115,000 \text{ SF})}{12} = 8,433 \text{ CF}$
 $Q_{p1} = CIA = 0.38 (5.28 \text{ IN/HR}) (2.64 \text{ ACRES}) = 4.7 \text{ CFS}$
C-0.38 FOR 0% IMPERVIOUS (PLATE 22.2 C-1, PG. 8)
OFFSITE FLOWS: FLOWS COMING FROM BACKYARD LOT PONDS. 4 LOTS CONTRIBUTING.
C-SAME AS DEVELOPED SITE=0.67
 $Q_{p2} = (4 \text{ LOTS}) (5,000 \text{ ACRES}) (0.67) (5.28) = 1.6 \text{ CFS}$
VOLUME OF RUNOFF = $\frac{(0.88") (20,000 \text{ SF})}{12} = 1,470 \text{ CF}$
 $Q_{TOTAL} = 6.3 \text{ CFS}$ $V_{TOTAL} = 9,870 \text{ CFS}$

SECTION C-C

DEVELOPED CONDITIONS:

- ONSITE FLOWS:
 $CN=88$ (PLATE 22.2 C-2, PG. 9)
 $CRN=94$ (PLATE 22.2 C-3, PG. 10)
DIRECT RUNOFF = 1.92 IN. (PLATE 22.2, C-4, PG. 11)
VOLUME OF RUNOFF = $\frac{(1.92") (115,000)}{12} = 18,430 \text{ CF}$
 $Q_{p3} = CIA = (0.64) (5.28) (2.64) = 8.9 \text{ CFS}$
C=0.64 (PLATE 22.2, C-1, PG. 8)
- DRAINAGE PLAN
1. ROUTE ROOF RUNOFF, PLAYGROUND AREAS AND OFFSITE FLOWS TO EXISTING INLET THAT WAS DESIGNED FOR 9 CFS.
 $V_{DISC} = 11,480 \text{ CF}$ $Q_{DISC} = 7.5 \text{ CFS}$ LESS THAN 9.0 CFS DESIGN
2. ROUTE PARKING LOT RUNOFF TO NEW DROP INLET AT THE SOUTHWEST CORNER OF THE DEVELOPMENT.
 $V_{DISC} = 8,430 \text{ CF}$ $Q_{DISC} = 4.9 \text{ CFS}$ (APPROXIMATELY EQUAL TO UN-DEVELOPED)



DRAINAGE & GRADING PLAN FOR LEARNING TECH CENTER

5528 EUBANK BLVD. N.E.
APPROVED AUGUST 24, 1984

I, J. MARK GOODWIN, N.M.P.E., N° 6948
DO HEREBY CERTIFY THAT THIS PLAN AS NOTED HAS BEEN CONSTRUCTED IN SUBSTANTIAL COMPLIANCE WITH THE APPROVED PLAN.

CITY OF ALBUQUERQUE
THIS MICROMAP IS THE BEST POSSIBLE REPRODUCTION DUE TO THE POOR QUALITY OF THE ORIGINAL DOCUMENT

"AS-BUILT"
REVISED 1-3-85
REVISED 11-21-84
MOLZEN-CORBIN & ASSOCIATES
CONSULTING ENGINEERS
ALBUQUERQUE, CARLSBAD - NEW MEXICO

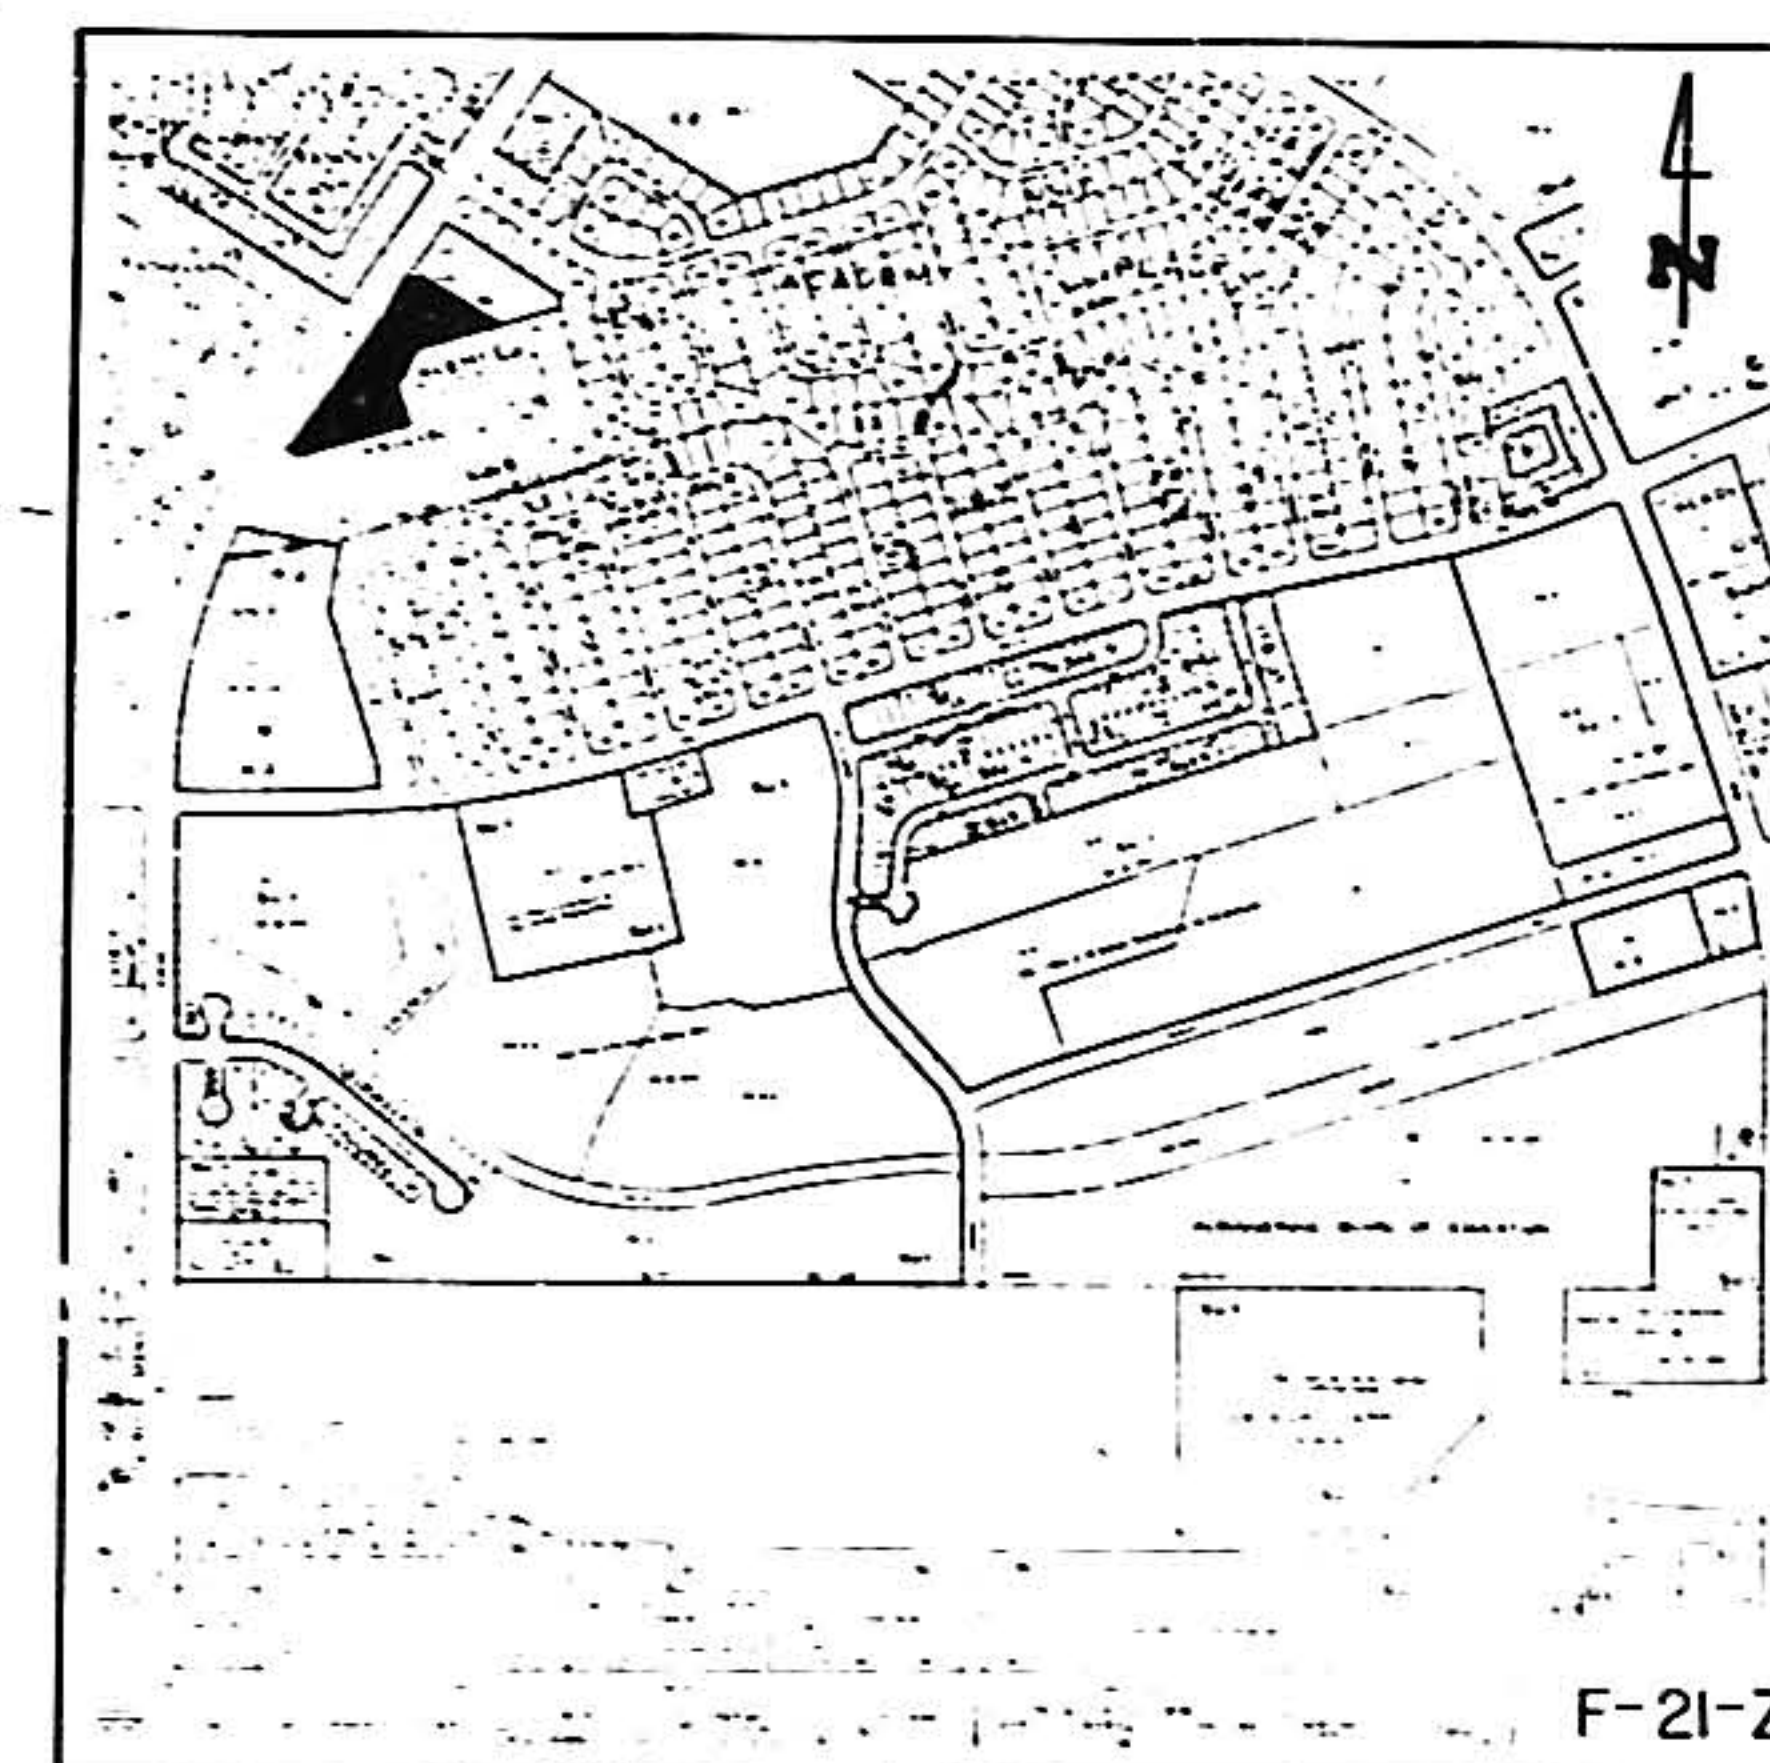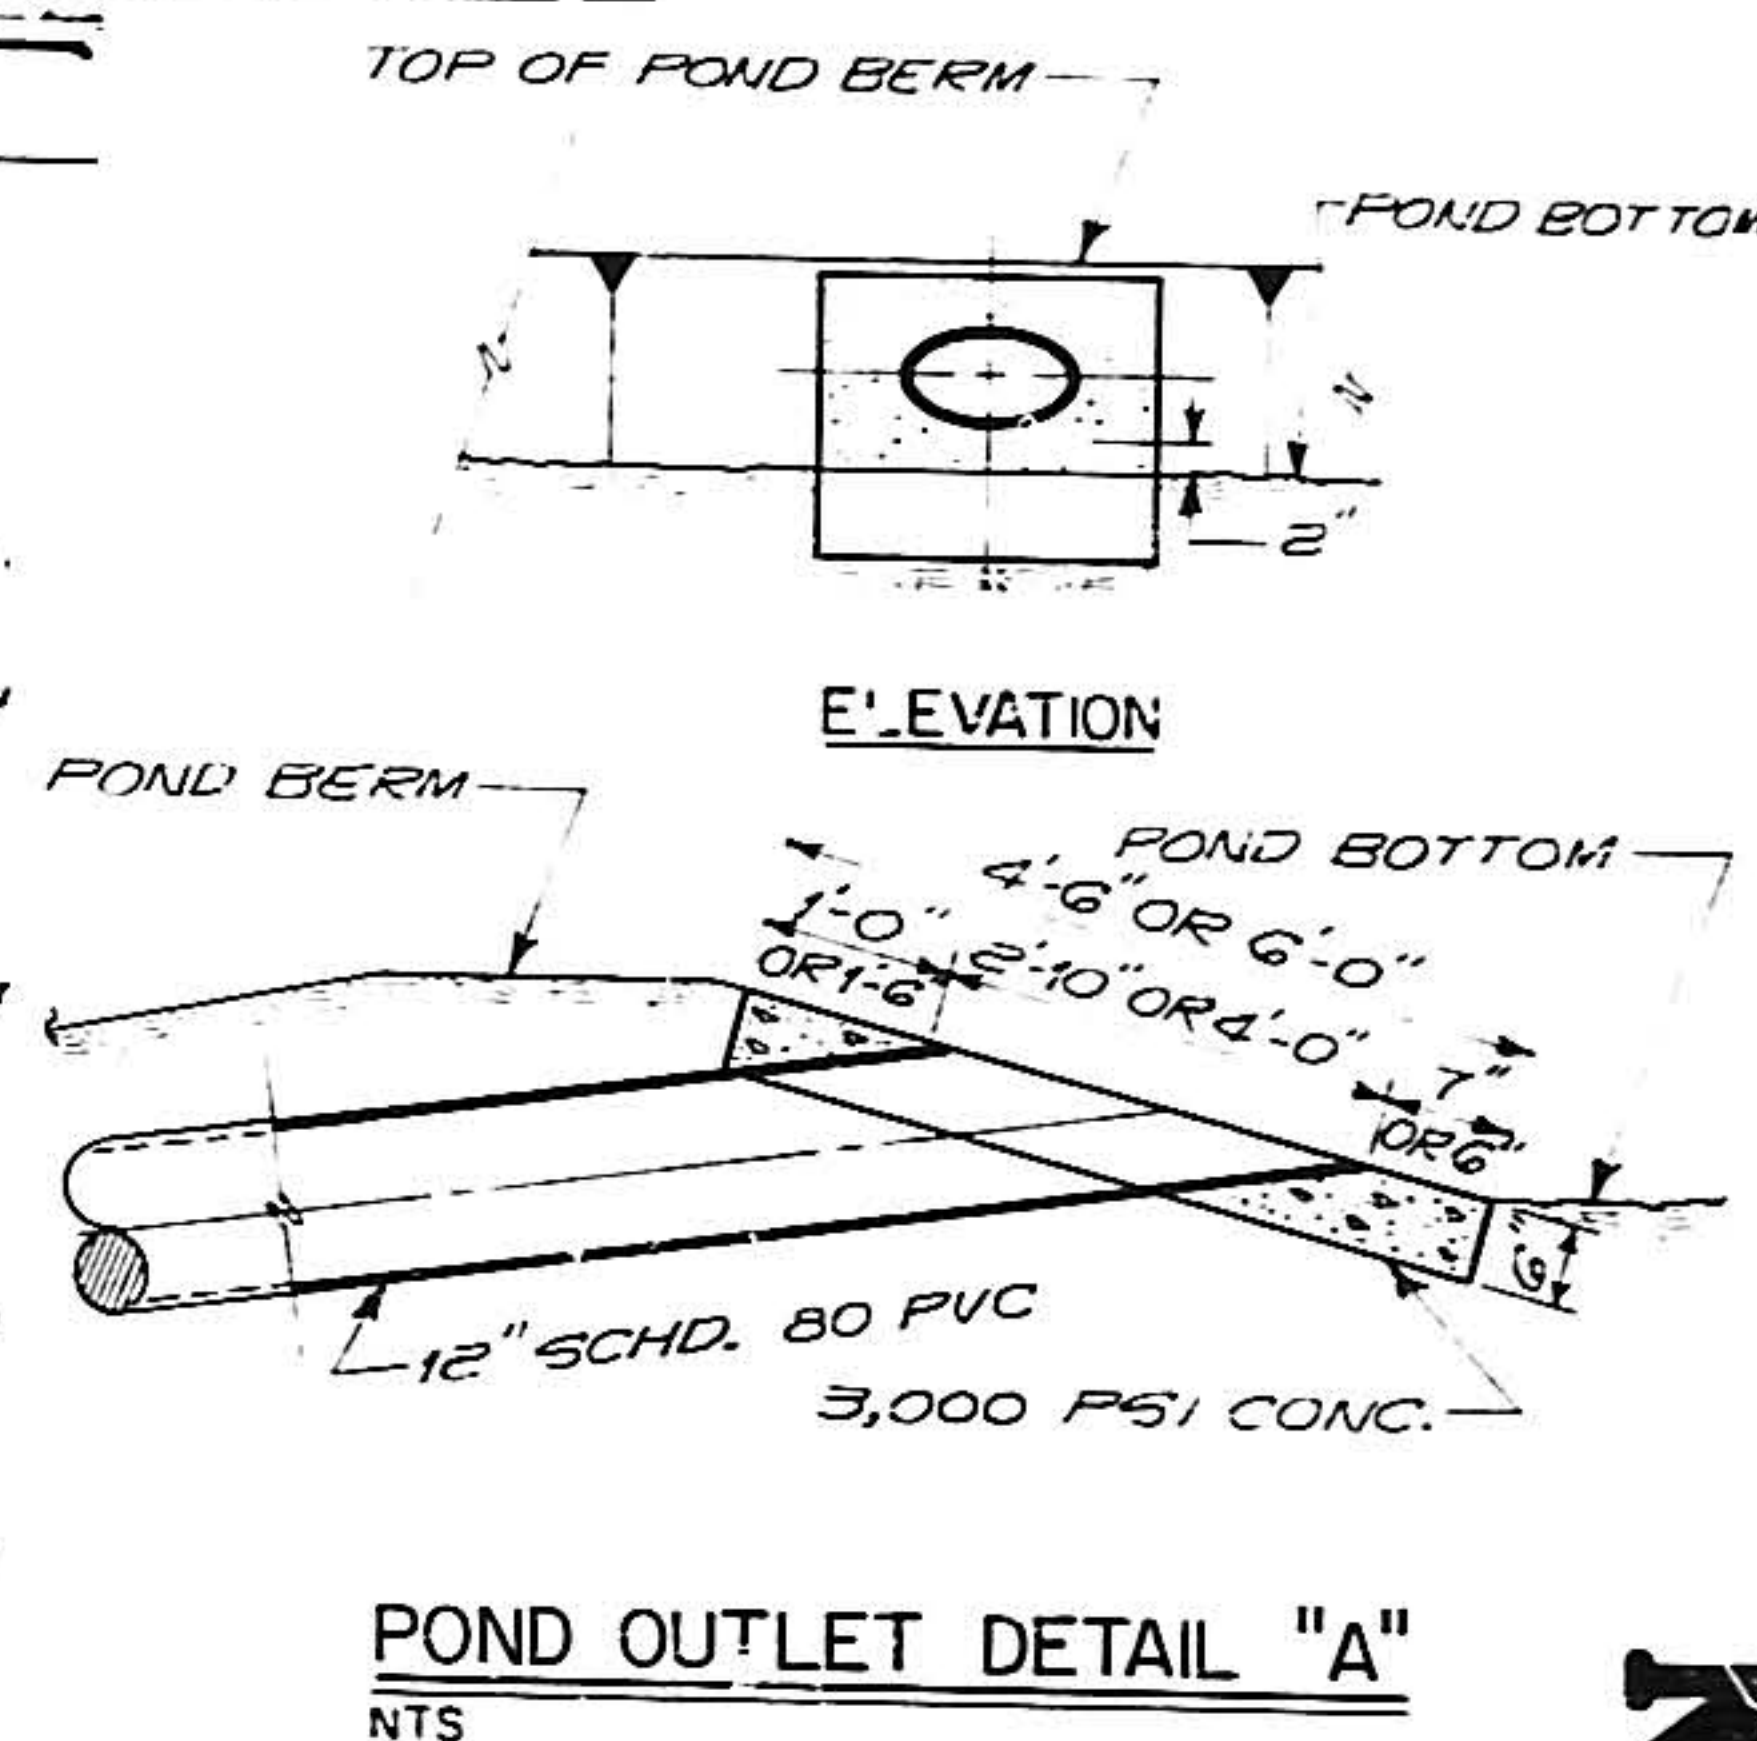

LEGEND

- PROPERTY LINE
- SANITARY SEWER LINE
- SANITARY SEWER MANHOLE
- STORM DRAIN LINE
- STORM DRAIN INLET (CATCH BASIN)
- GAS LINE
- WATER LINE
- FIRE HYDRANT
- CURB & GUTTER
- SIDEWALKS
- VALVES
- ASPHALT
- AVAILABLE 100 YR. STORM POND AREA.

DRAINAGE PLAN GRADING PLAN

LEARNING TECH CENTER
5528 EUBANK BLVD. N.E.
ALBUQUERQUE, NEW MEXICO

CLAUDIO ANTONIO VIGIL & ASSOCIATES, P.A.
ARCHITECTS/PLANNERS/ENGINEERS
2340 ALAMO S.E. SUITE 101
ALBUQUERQUE, NEW MEXICO 87106
505-247-1000



C-2

F21/D36