PUBLIC WORKS/HYDROLOGY

F23/D4B

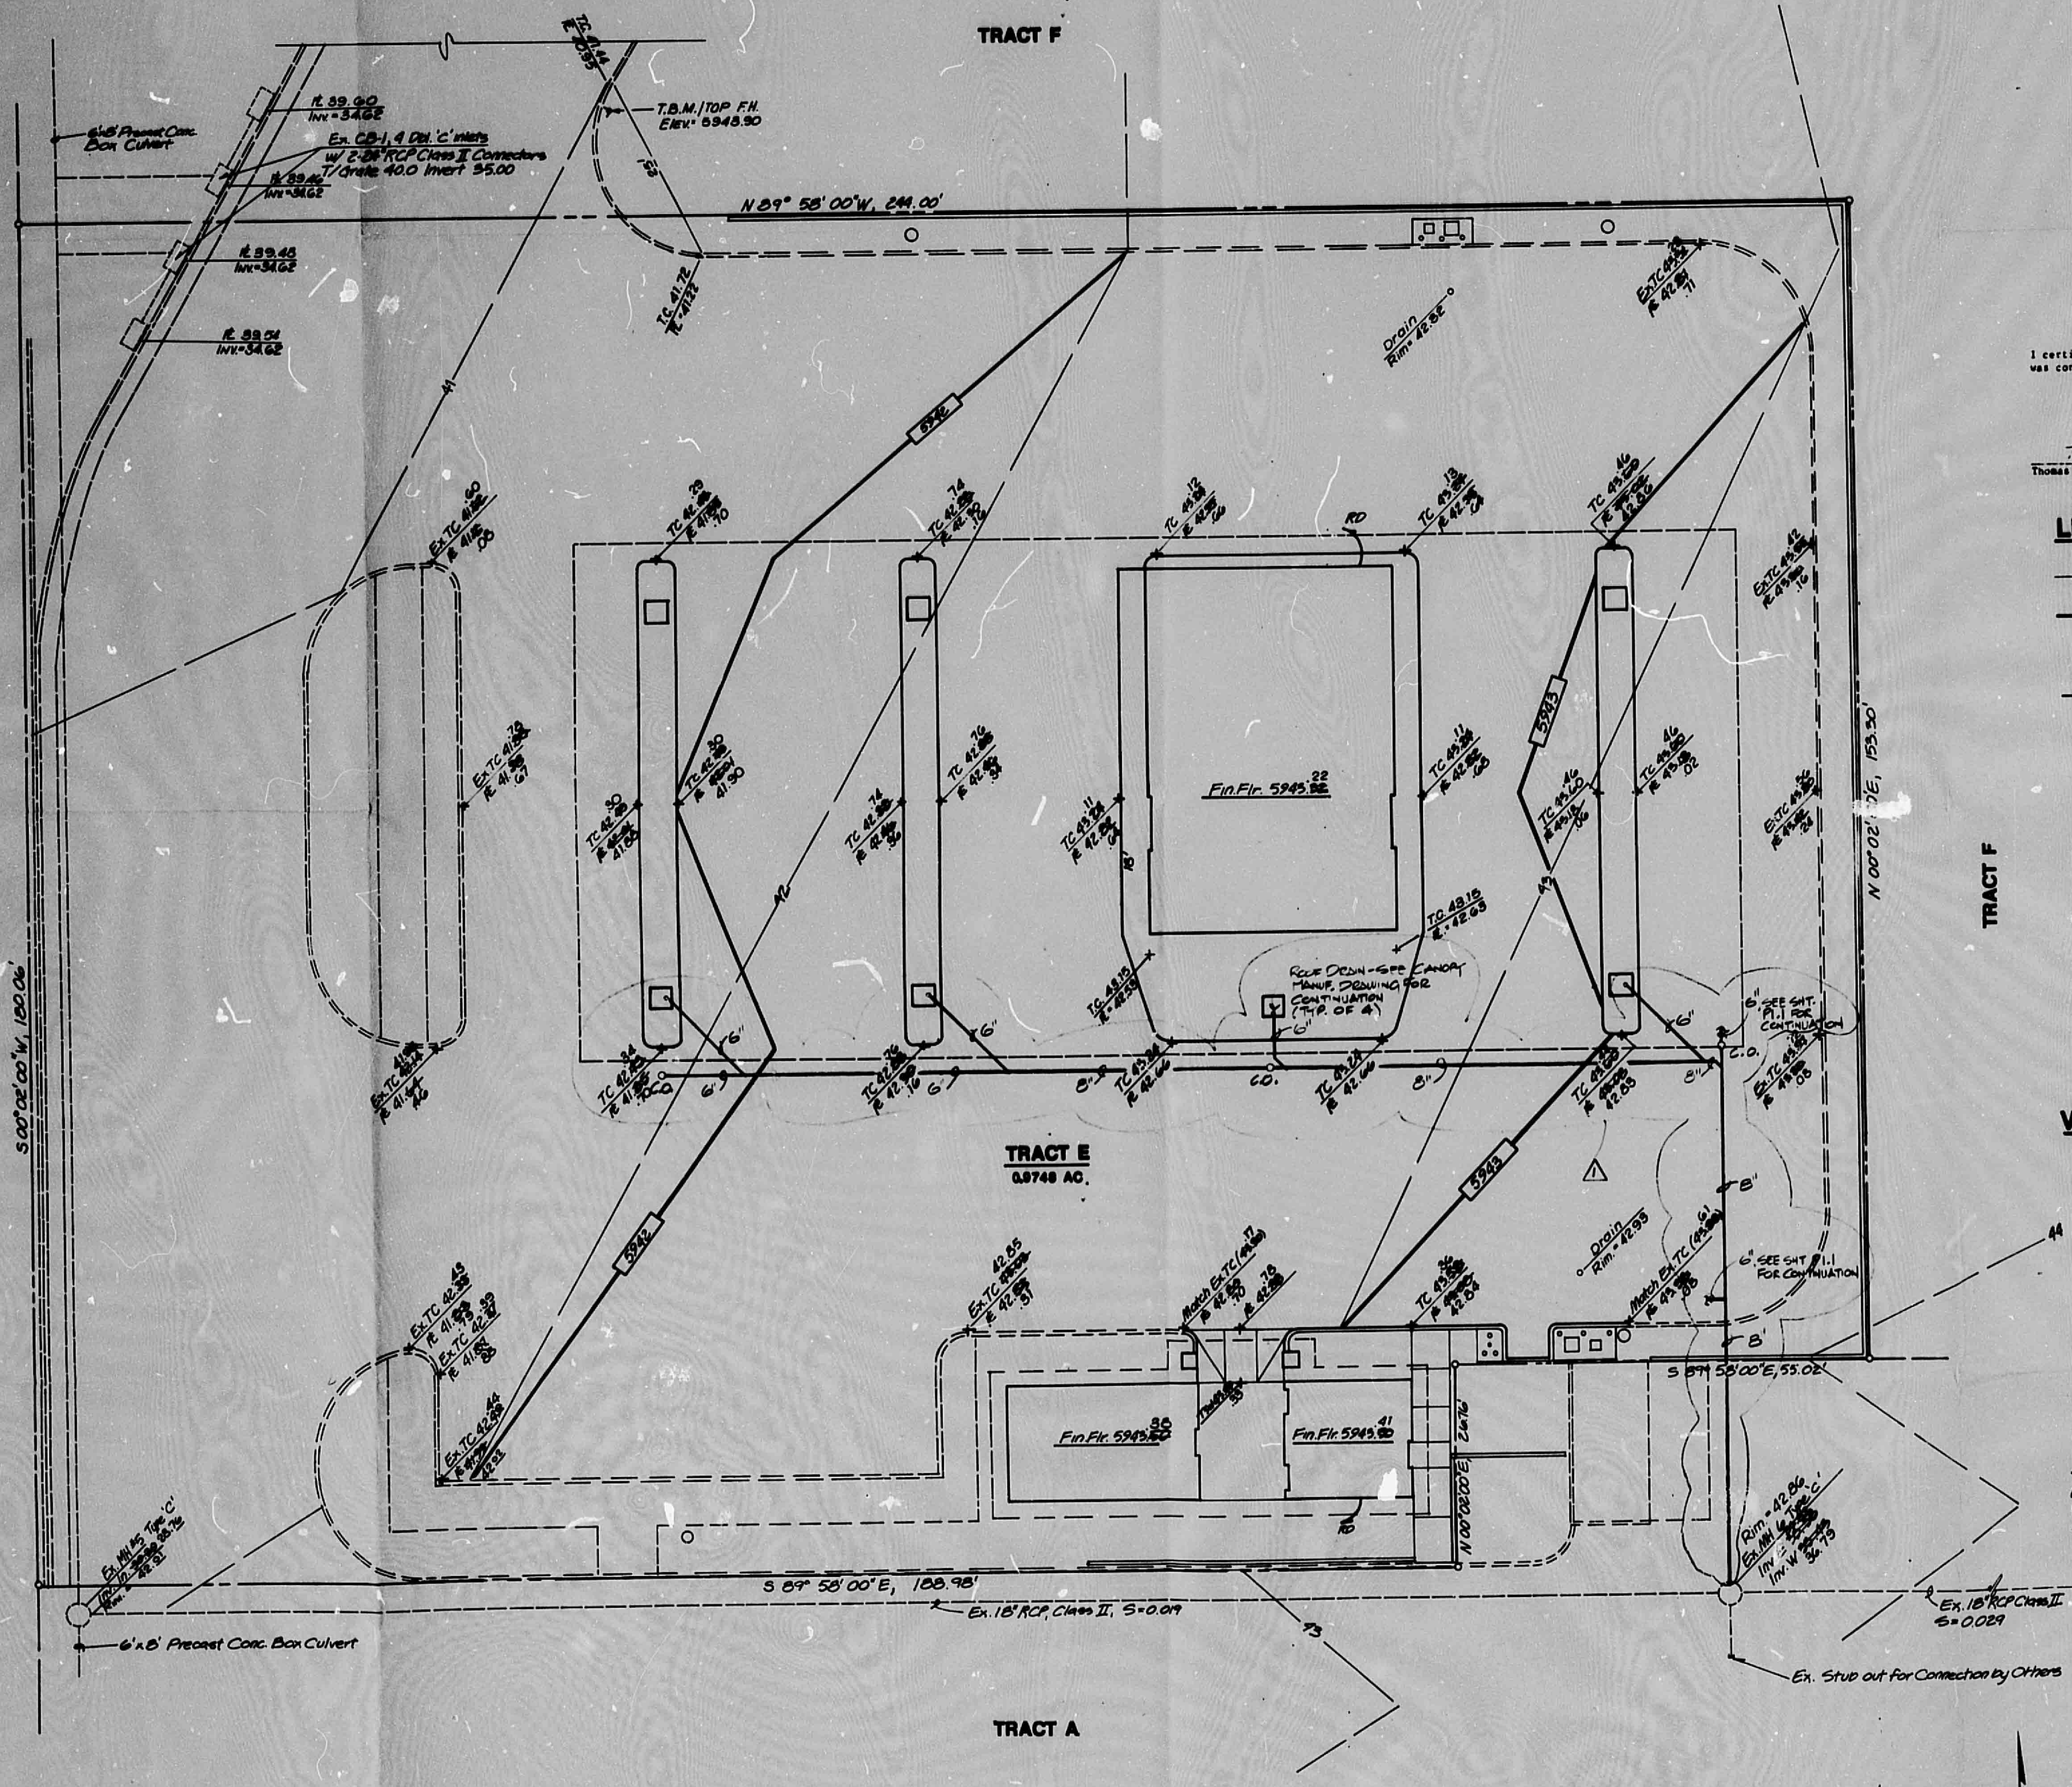

I certify that I am a Registered Professional Engineer and that this project was constructed in substantial compliance with the approved drainage report.

Thomas E. Boothby, P.E. No. 10510

3-21-89
Date

LEGEND

— — 42 — —	EXISTING CONTOUR
━ 5942 ━	NEW CONTOUR
42.10 ↙	NEW SPOT GRADE
——— - - ———	PROPERTY LINE
═ ═ ═ ═	EXISTING CURB
═══════	NEW CURB
↙ RD	ROOF DRAIN
TC	TOP OF CURB
FL	FLOW LINE
TSW	TOP OF SIDEWALK

TRACT F

VICINITY MAP

F-23

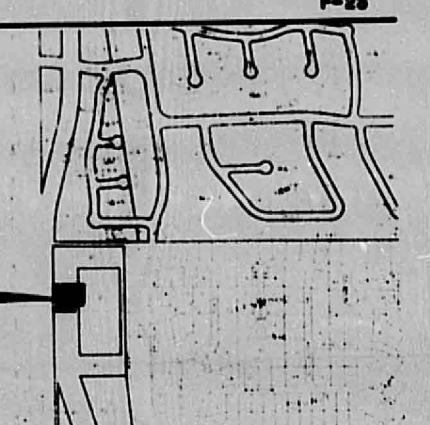

BENCH MARK DATA

ACS No. 2-F23 Alum. Tablet set in Concrete inside Monument Box. Elev. 5918.14 Located at Median Nose on Tramway north of Montgomery Blvd. NE

C.B. INLET
RIM = 45.20
INV. = 39.90

Ex. 18" RCP Class II
S=0.029

LEGAL DESCRIPTION:
TRACT E, REPLAT OF LOTS 1 THROUGH 4,
BLOCK 3, GLENWOOD HILLS UNIT

RECEIVED
MAR 2 2 1989
HYDROLOGY SECTION

PARTIAL GRADING & DRAINAGE PLAN

SCALE: 1"= 10'

RECORD DRAWING
Drawings revised to reflect the best information available. Do not use without field verification.

WILSON & COMPANY
ENGINEERS | ARCHITECTS
6611 GULTON CT. NE
505·345·5345
ALBUQUERQUE N.M.
87109

Thomas E. Boothby
9-12-88

PROJECT **GIANT SERVICE STATION # 624**
GLENWOOD VILLAGE
4720 TRAMWAY BLVD. NE ALBUQUERQUE, NEW MEXICO

DRAWING TITLE
PARTIAL GRADING & DRAINAGE PLAN

NO.	DATE	REVISION
1	Nov. 1,88	Fear Crown
2	Mar 7,89	As-Builts

DATE AUGUST 1988
JOB NO. 88-521
DRAWN FHM

WILSON
COMPANY
ENGINEERS
ARCHITECTS

DRAWING NO.
C1.2

R# 26 DATE 3-26-02 OP EJP.

CITY OF ALBUQUERQUE

This microimage is certified to be a complete and accurate copy of the original as it appears in the files of the Public Works Department and was created in the normal course of business.

The photographic process used meets the Basic Microfilm Standards of the National Micrographics Association (MS115-1977)

1/15/02
DIRECTOR

Roberta Duran
NOTARY PUBLIC

OFFICIAL SEAL
Roberta Duran
NOTARY PUBLIC
STATE OF NEW MEXICO

CITY OF ALBUQUERQUE
THIS MICROIMAGE IS THE BEST POSSIBLE REPRODUCTION DUE TO THE POOR QUALITY OF THE ORIGINAL DOCUMENT.

PLANS/PLATS ON FILE

FILE DESC: F23/D4B

# PLANS/PLATS 1

CITY OF ALBUQUERQUE C D F