Hydrology G11/D3d Burger King

611/D 3D

Burger King

1 Plan

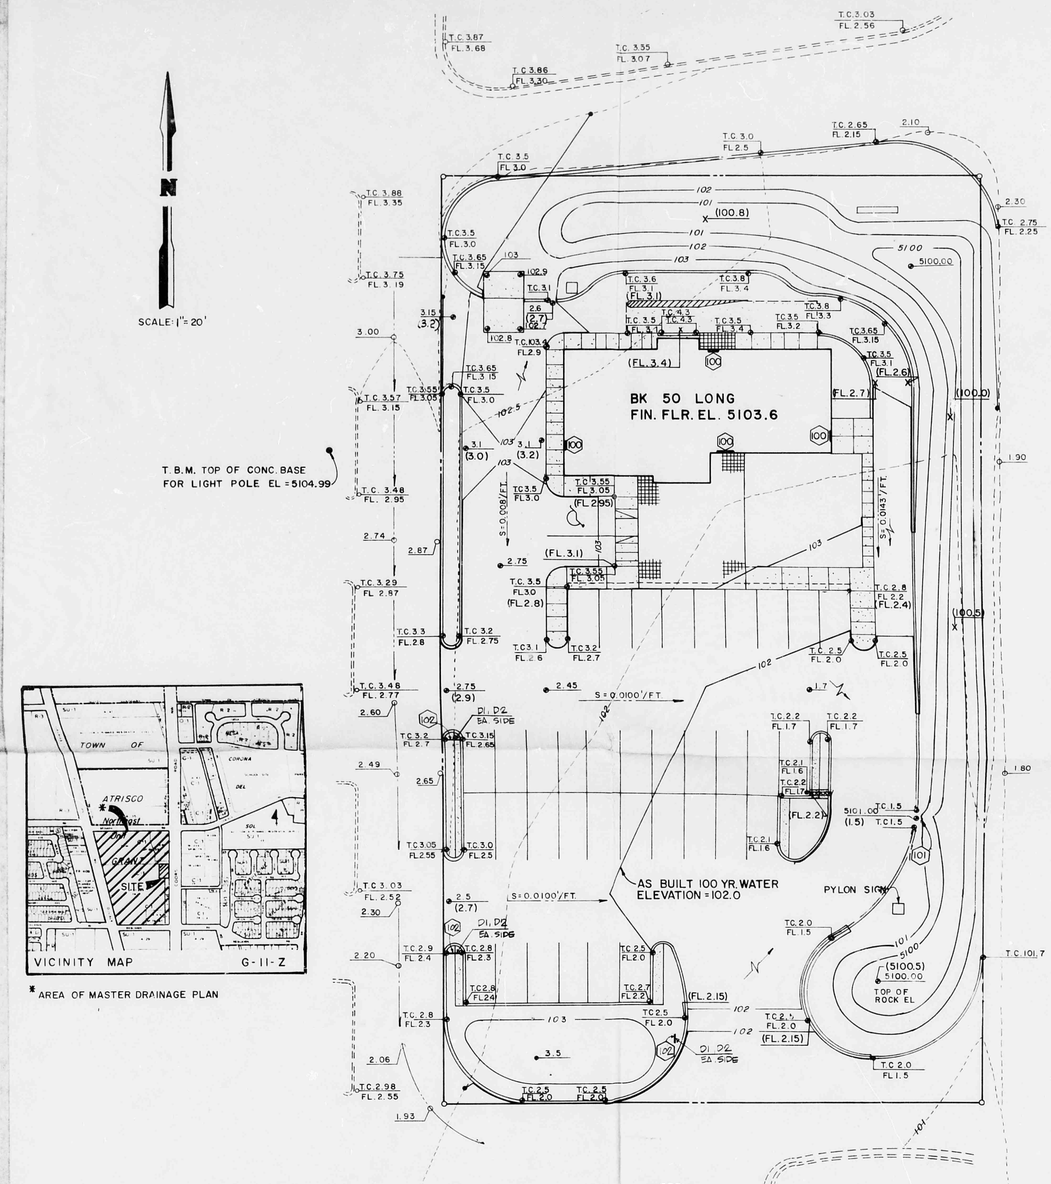
N
SCALE: 1" = 20'
T.B.M. TOP OF CONC. BASE FOR LIGHT POLE EL = 5104.99
BK 50 LONG
FIN. FLR. EL. 5103.6
(FL. 3.4)
(FL. 2.71)
(FL. 3.1)
(FL. 2.95)
(FL. 2.8)
(FL. 2.4)
(FL. 2.2)
(FL. 2.15)
AS BUILT 100 YR. WATER ELEVATION = 102.0
PYLON SIGN
TOP OF ROCK EL
S = 0.0100'/FT.
S = 0.0100'/FT.
S = 0.0100'/FT.
S = 0.0100'/FT.
DI. D2 EA SIDE
DI. D2 EA SIDE
DI. D2 EA SIDE
(100.8)
(100.0)
(100.5)
(5100.5)
5100.00
5101.00
(1.5)
ROAD
COORS

* AREA OF MASTER DRAINAGE PLAN

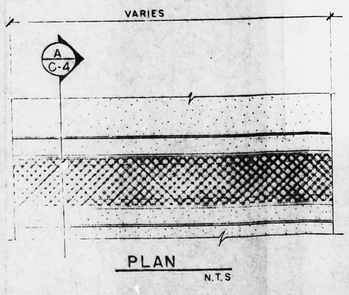

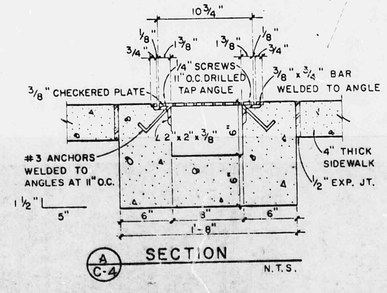

SIDEWALK DRAIN DETAILS

AS BUILT DRAINAGE PLAN
GRADING AND DRAINAGE PLAN

CONSTRUCTION COMPLETED IN SUBSTANTIAL COMPLIANCE WITH THE APPROVED DRAINAGE PLAN AND REPORT.

VICTOR J. CHAVEZ — STATE OF NEW MEXICO — REGISTERED PROFESSIONAL ENGINEER — 6/11/84

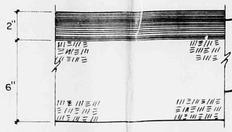

PAVING SECTION

*1	6" CONCRETE CURB
*3	STANDARD CURB NOSING
*4	9" BARRIER CURB
*7	TILE PAVER WALK
*8	BRUSHED CONCRETE WALK
*9	CONCRETE RAMP EXTERNAL
*11	HANDICAP PARKING STALL PAINT STD. SYMBOL
13	CEDAR TRASH ENCLOSURE - SEE DUMPSTER DETAILS
*29	PAINTED TRAFFIC ARROW
*30	ROOF DRAIN FLUME
*32	HANDRAIL 5 L.F.
40	ROOF DRAIN LEADER THRU CURB
45	4" WIDE PAINTED STRIPES (TYP)
46	4" WIDE PAINTED STRIPES AT 1.5' O.C. 45°
52	BIKE RACK FOR 4 BIKES
54	NEW PAVING TO MATCH EXIST. ELEV.
56	EXISTING PAVING TO REMAIN
58	EDGE OF EXISTING PAVING (NO CURB)
61	TRANSFORMER PAD TO PNM REQUIRMENTS
65	CONCRETE DRIVE THRU LANE
67	LANDSCAPED AREA
69	WALK IN BOXES (SEE ARCH.)
*70	GUARD POST AT DRIVE-THRU WINDOW
99	4" CONCRETE SIDEWALK 3000 P.S.I., 3/4" AGG.
100	DOOR OPENING

*SEE SHT C-5 THRU C-9 FOR DETAILS
NOTE: ALL DIMENIONS FOR PARKING AREAS AND DRIVES ARE TO FACE OF CURB

101	CONSTRUCT RIP-RAP RUN DOWN
A	BURGER KING LOGO
B	CLEARANCE SIGN 8'-6"
C	ORDER STATION
102	DIRECTIONAL SIGN SEE SHEET C-9

LEGEND

4	SITE NOTE
●	BUILDING TIE
———	NEW 6" CURB
———	NEW SIDEWALK
- - - -	EXISTING CURB AND GUTTER
3.40	EXISTING SPOT ELEV.
●3.5	NEW SPOT ELEV.
102	EXISTING CONTOUR
101	NEW CONTOUR
x(03.5)	AS BUILT ELEVATIONS

JUN 11 1984 — CITY OF ALBUQUERQUE — HYDROLOGY SECTION

CHECKED BY: H.A.V. BARGER — DATE — REVISION

© 1981 BURGER KING CORPORATION; THE PLANS ARE THE PROPERTY OF BURGER KING CORPORATION AND ARE NOT TO BE COPIED THROUGH ELECTRONIC OR BY ANY OTHER MEANS.

PREPARED FOR:

BURGER KING CORPORATION

RESTAURANT #

P.O. BOX 520783
GENERAL MAIL FACILITY
MIAMI, FL. 33152
PHONE 305-596-7978

VICTOR J. CHAVEZ — STATE OF NEW MEXICO — REGISTERED PROFESSIONAL ENGINEER

PARKING
CIVIL ENGINEERING PLANS
GRADING PLAN

C-4

G11/D3D