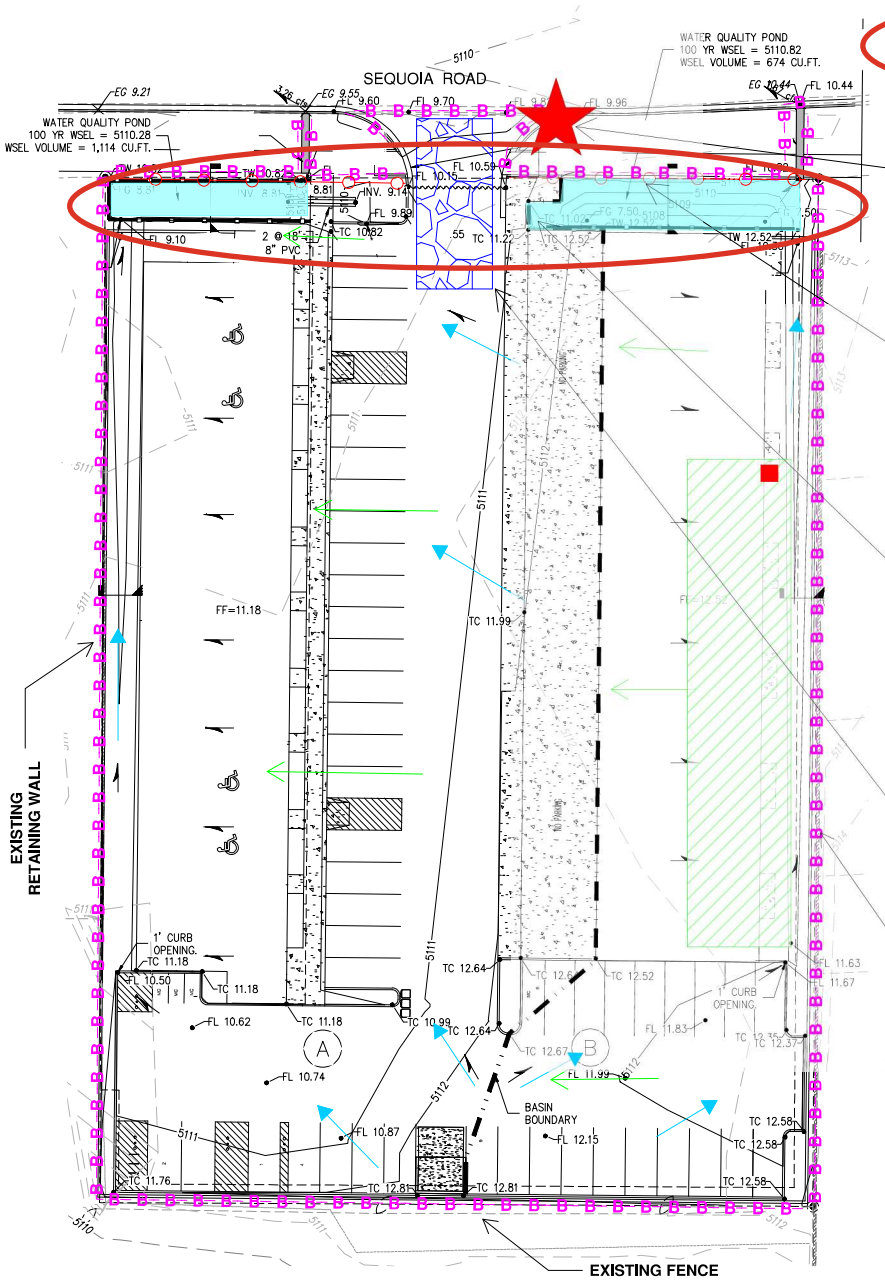

STORWMATER QUALITY POND FOR SEDIMENT CONTROL PURPOSES TO BE CONSTRUCTED DURING FIRST PHASES OF GRADING.

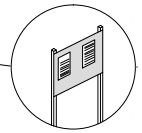

NPDES PERMITTING

IMPLEMENTATION	
BMP INSTALL	BMP REMOVE

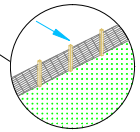

SILT FENCE

IMPLEMENTATION	
BMP INSTALL	BMP REMOVE

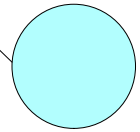

STORMWATER QUALITY PONDS

IMPLEMENTATION	
BMP INSTALL	BMP REMOVE

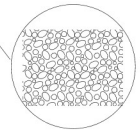

STABILIZED CONSTRUCTION ENTRANCE

IMPLEMENTATION	
BMP INSTALL	BMP REMOVE

N

0' 40' 80'

KARLEY VINCENT FETTER
STATE OF NEW MEXICO
13450
REGISTERED PROFESSIONAL ENGINEER
12/22/2021

e2RC
SWPPP
Stormwater
Erosion Control
Reclamation
Seeding
www.e2rc.com | 505.867.4040

CERTIFIED PROFESSIONAL IN STORM WATER QUALITY CPSWQ

#	REVISION ITEM	DATE

SEQUOIA APARTMENTS
TESCP

DESIGNED BY:
K. FETTER, P.E.
DRAWN BY:
S. FETTER

SHEET:
8