HYDROLOGY

G21/D24
1 PLAN
NO DOCUMENTS

G 21/D24

1 PLAN

No Documents

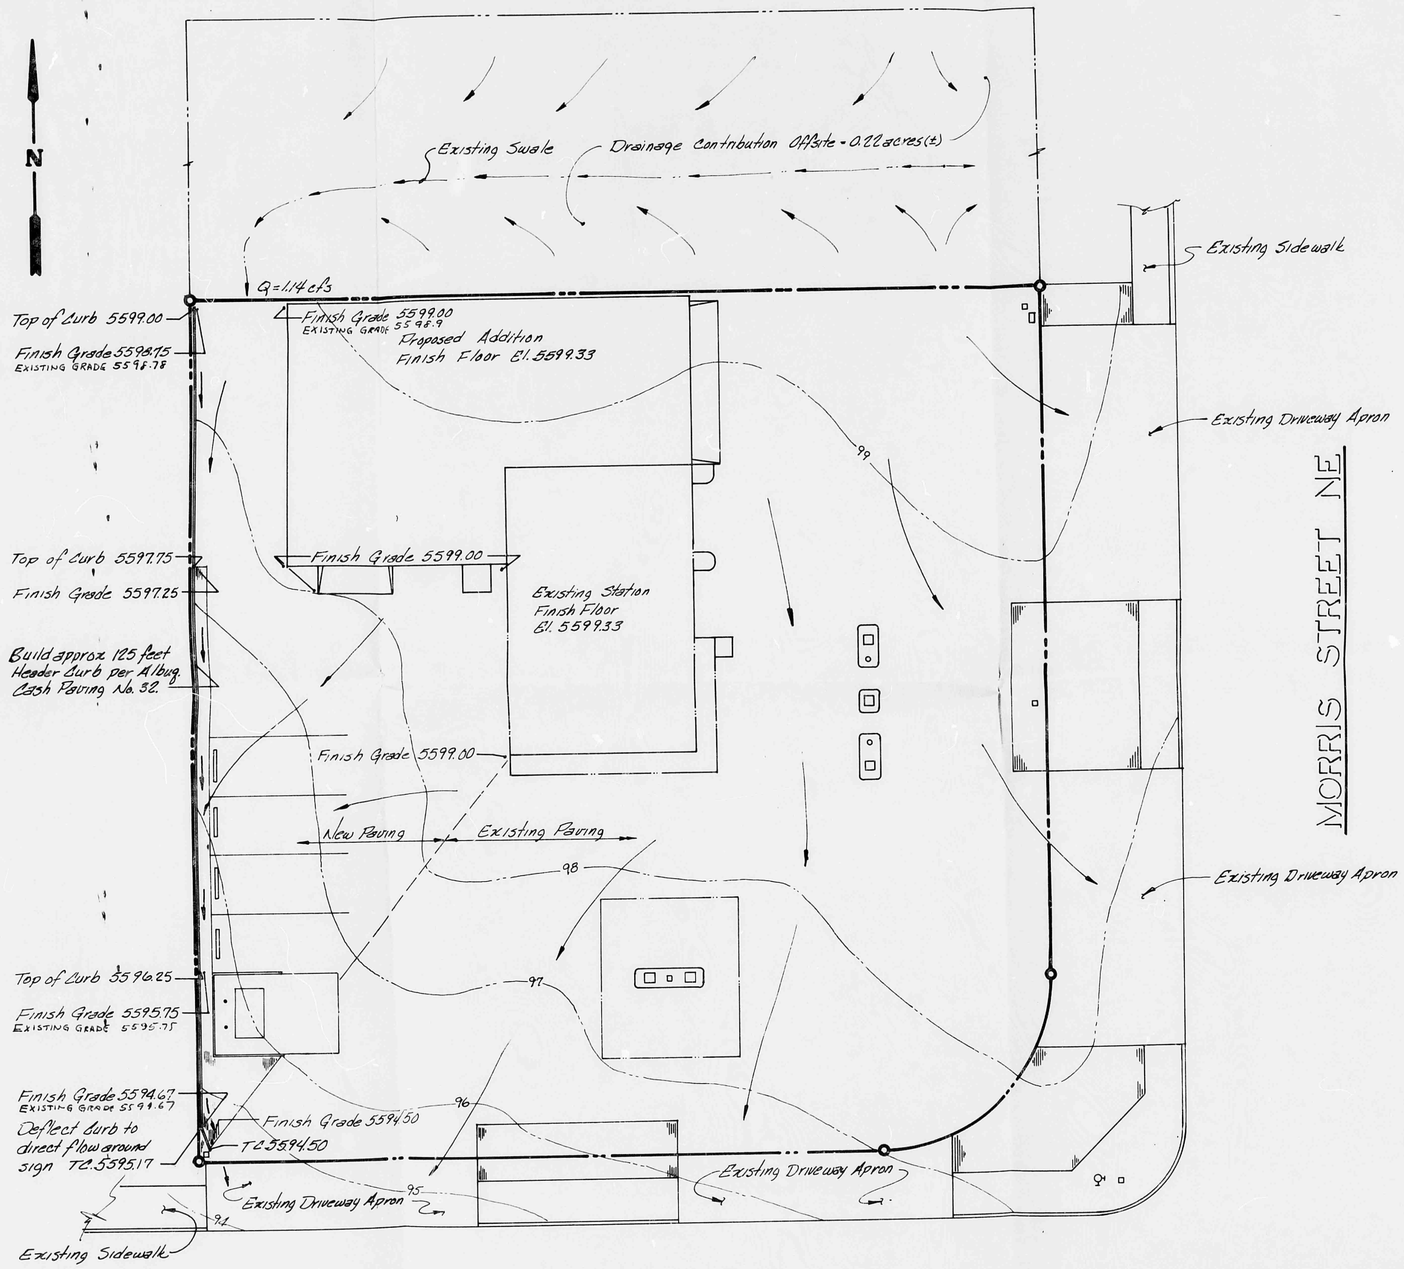

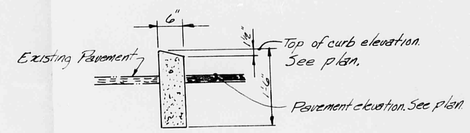

HEADER CURB SECTION

NO SCALE

LEGAL DESCRIPTION

LOT "A"

TRACT 42

San Gabriel Subdivision

Zone Map G-21

NOTES

1. Elevation control based on City of Albuq. Bench Mark 8-9-21-A, El 5597.68 @ SE corner of Commanche and Morris.
2. Property survey, building locations by others.
3. Contours based on survey December 1982.
4. Legend

TC	Top of curb
—99—	Existing contour elevation
→	Existing flow pattern
➡	Proposed flow pattern

EXISTING ELEVATIONS SHOWN IN RED WERE CONFIRMED BY TELEPHONE WITH THE ENGINEER (WAYNE WELTY) ON 12/10/82

APPROVED FOR PERMIT 12/10/82

DRAINAGE PLAN

SCALE 1"=10'

DESIGNER-
K WAYNE WELTY, PE
9420 AVENIDA DEL OSO NE
821-7689

ADDITION TO SHAMROCK STATION

3701 MORRIS STREET NE

REVISIONS

December 1982

1