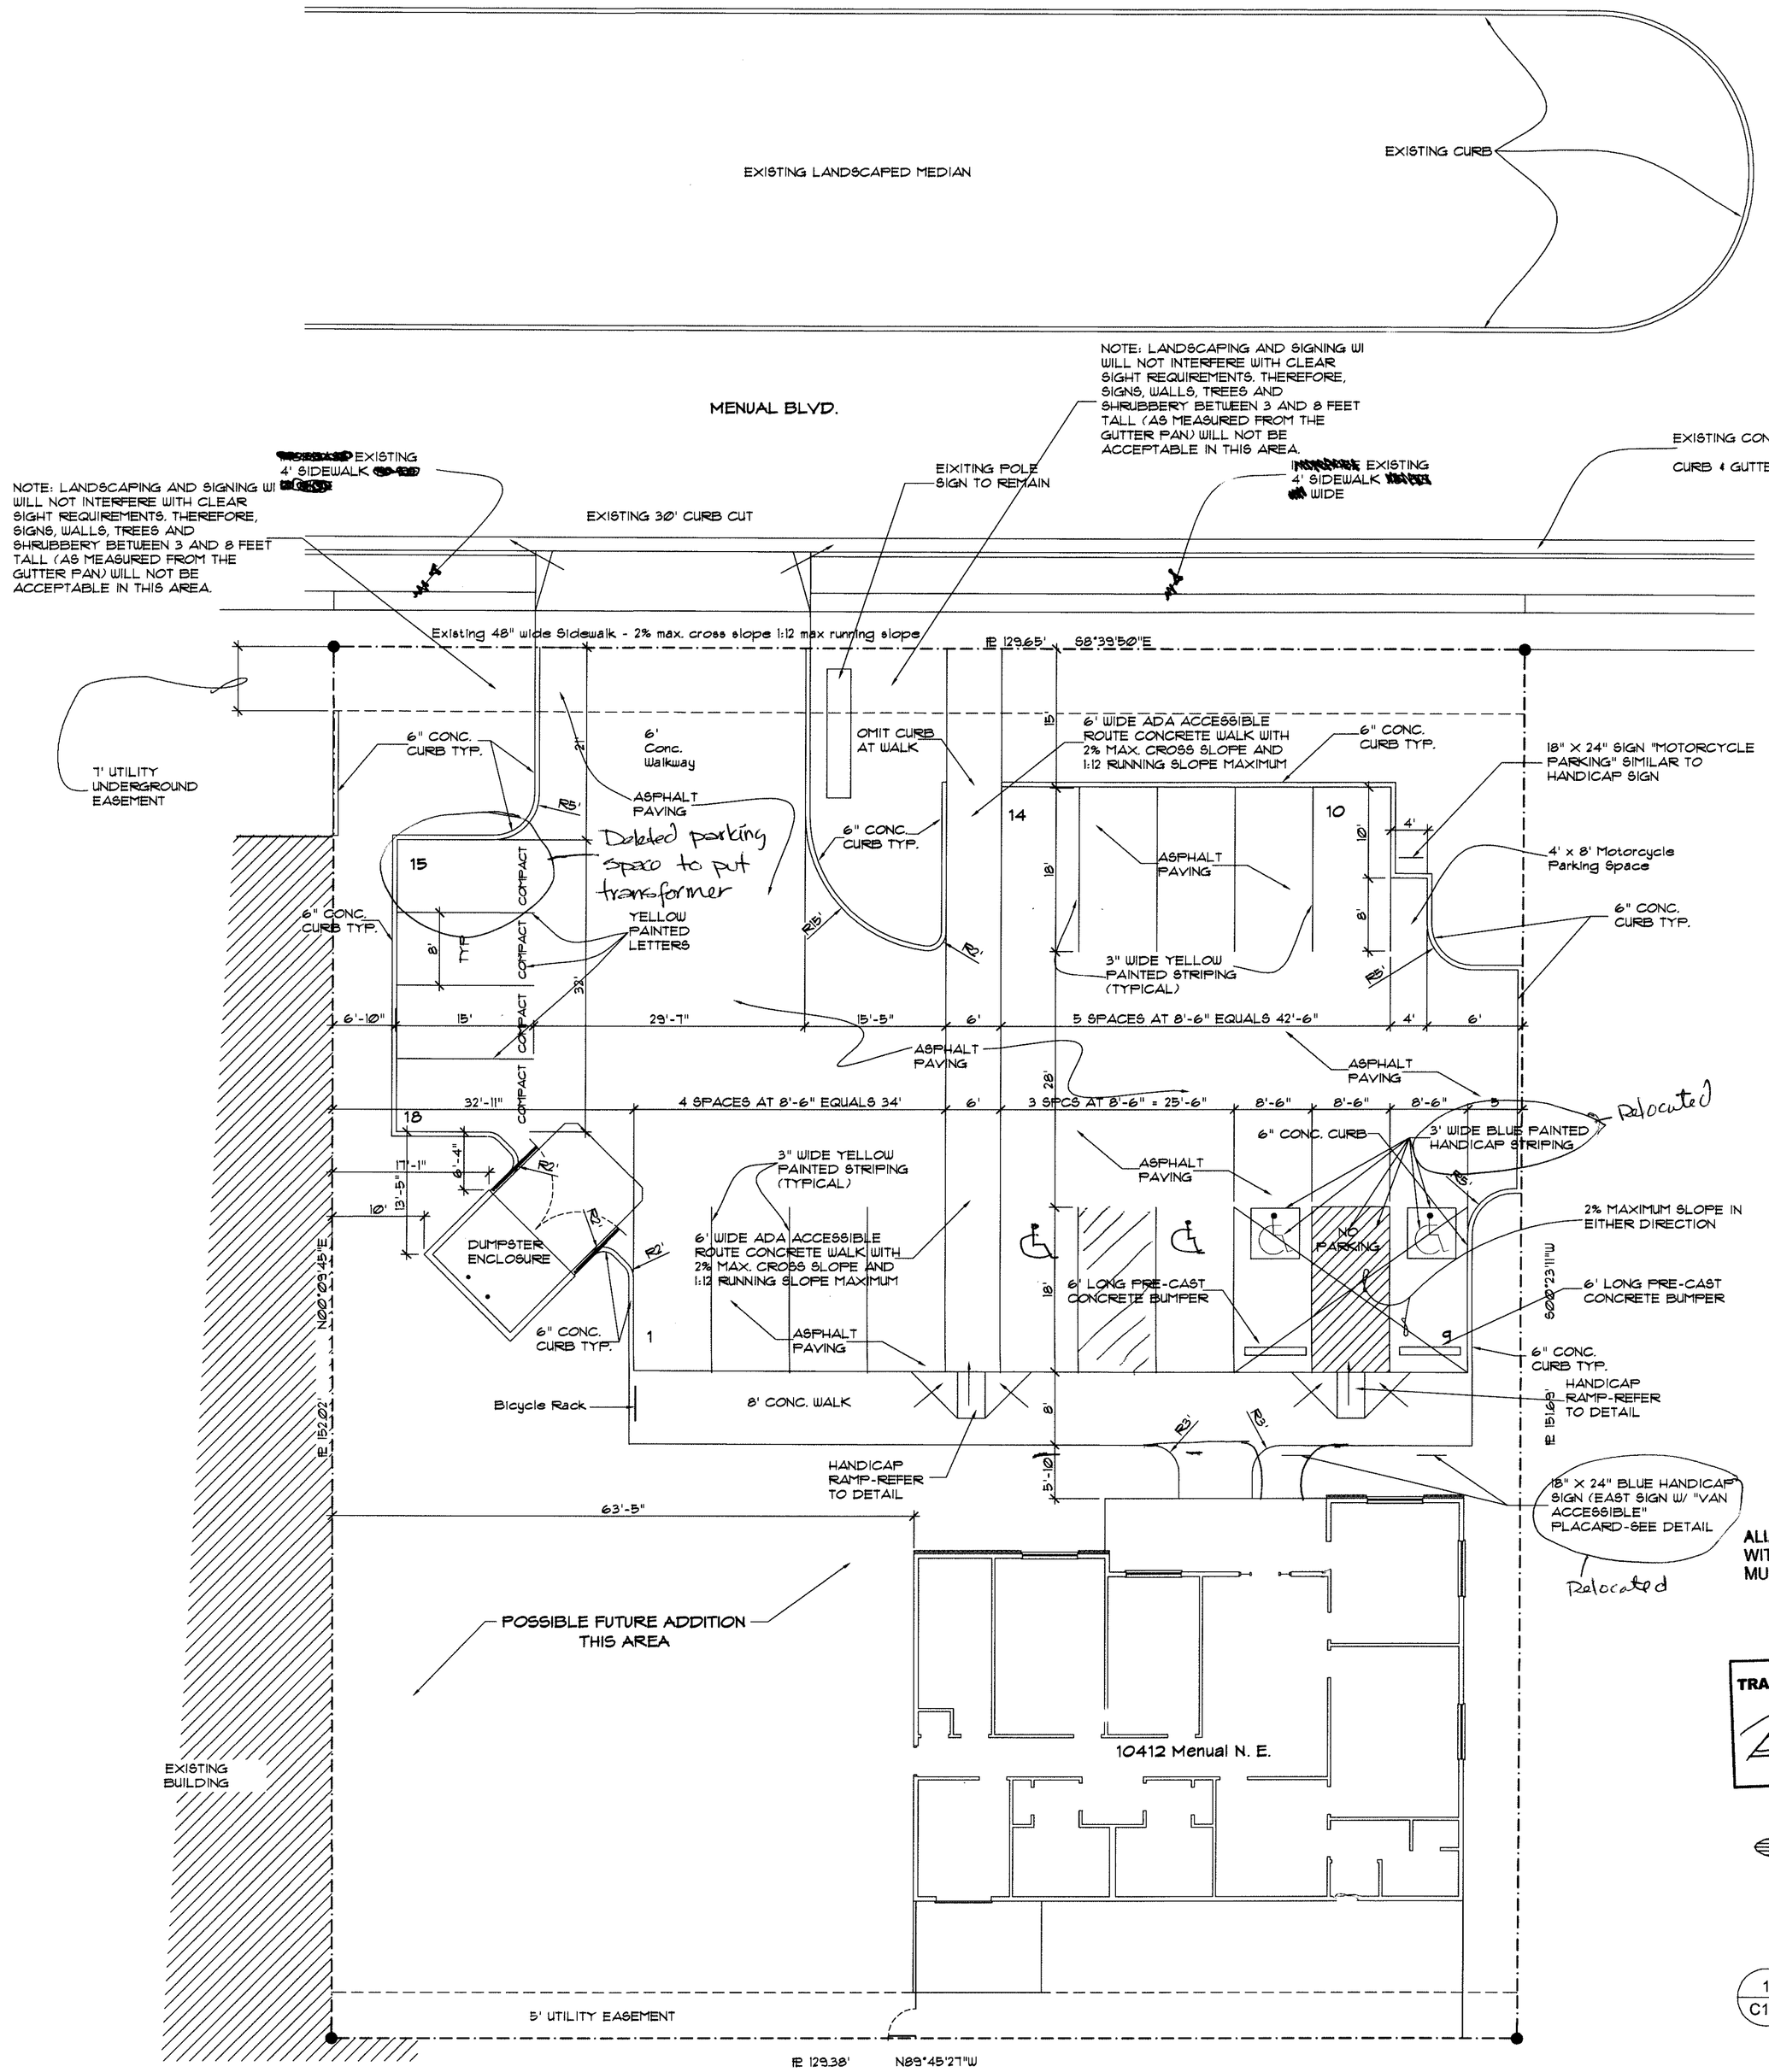

LEGAL DESCRIPTION:

LOT 25-A, BLOCK 109
SNOW HEIGHTS ADDITION
ALBUQUERQUE,
BERNALILLO COUNTY NEW MEXICO

Parking "Calculations:

1662 Sq. Ft. Leasable Area/200 = 9 spaces required

Provided (including 4 small car and 2 handicap spaces plus 1 motorcycle space. 18 Spaces Provided

ACCESSIBLE PARKING CHECKLIST

REFER TO 2009 N. M. ACCESSIBLE PARKING CHECKLIST EFFECTIVE MARCH 15, 2012 REVISED 7-10-13.

Public Infrastructure shown on these plans for information only and not part of approval. Separate DRC/Permit approval and Work Order required.

ALL WHEELCHAIR RAMPS LOCATED WITHIN THE PUBLIC RIGHT OF WAY MUST HAVE TRUNCATED DOMES.

TRAFFIC CIRCULATION LAYOUT APPROVED
Signed 3/5/14 Date

Vicinity Map
Scale: None
Map H-21-Z-1

City of Albuquerque Building & Safety
MAR 07 2014
I.B.C. Plan Check Section

RECEIVED
MAR 05 2014
LAND DEVELOPMENT SECTION

1 / C1.1 Traffic Circulation Layout with Landscape
Scale: 1" = 10'

STATE OF NEW MEXICO
JAMES M. MEDLEY
NO. 10002
3/5/14
REGISTERED ARCHITECT

JIM MEDLEY, Architect AIA
NCARB Certificate No. 35,895
3100 Christine N. E. Albuquerque, NM 87111
email: jmedley@jim-medley-architect.com
Phone (505) 292-3514 Fax (505) 294-5593

Plan No.	
Date:	March '14
Drawn by:	JMM
Checked by:	JMM

Project: Office Building
Rahim Gillani
Albuquerque, New Mexico

No.	Revision / Issue	Date:
1		
2		
3	Re: City of Albuq. Plan Review	2/6-13/14

Sheet Description: Traffic Circulation Layout

Sheet: C1.3