

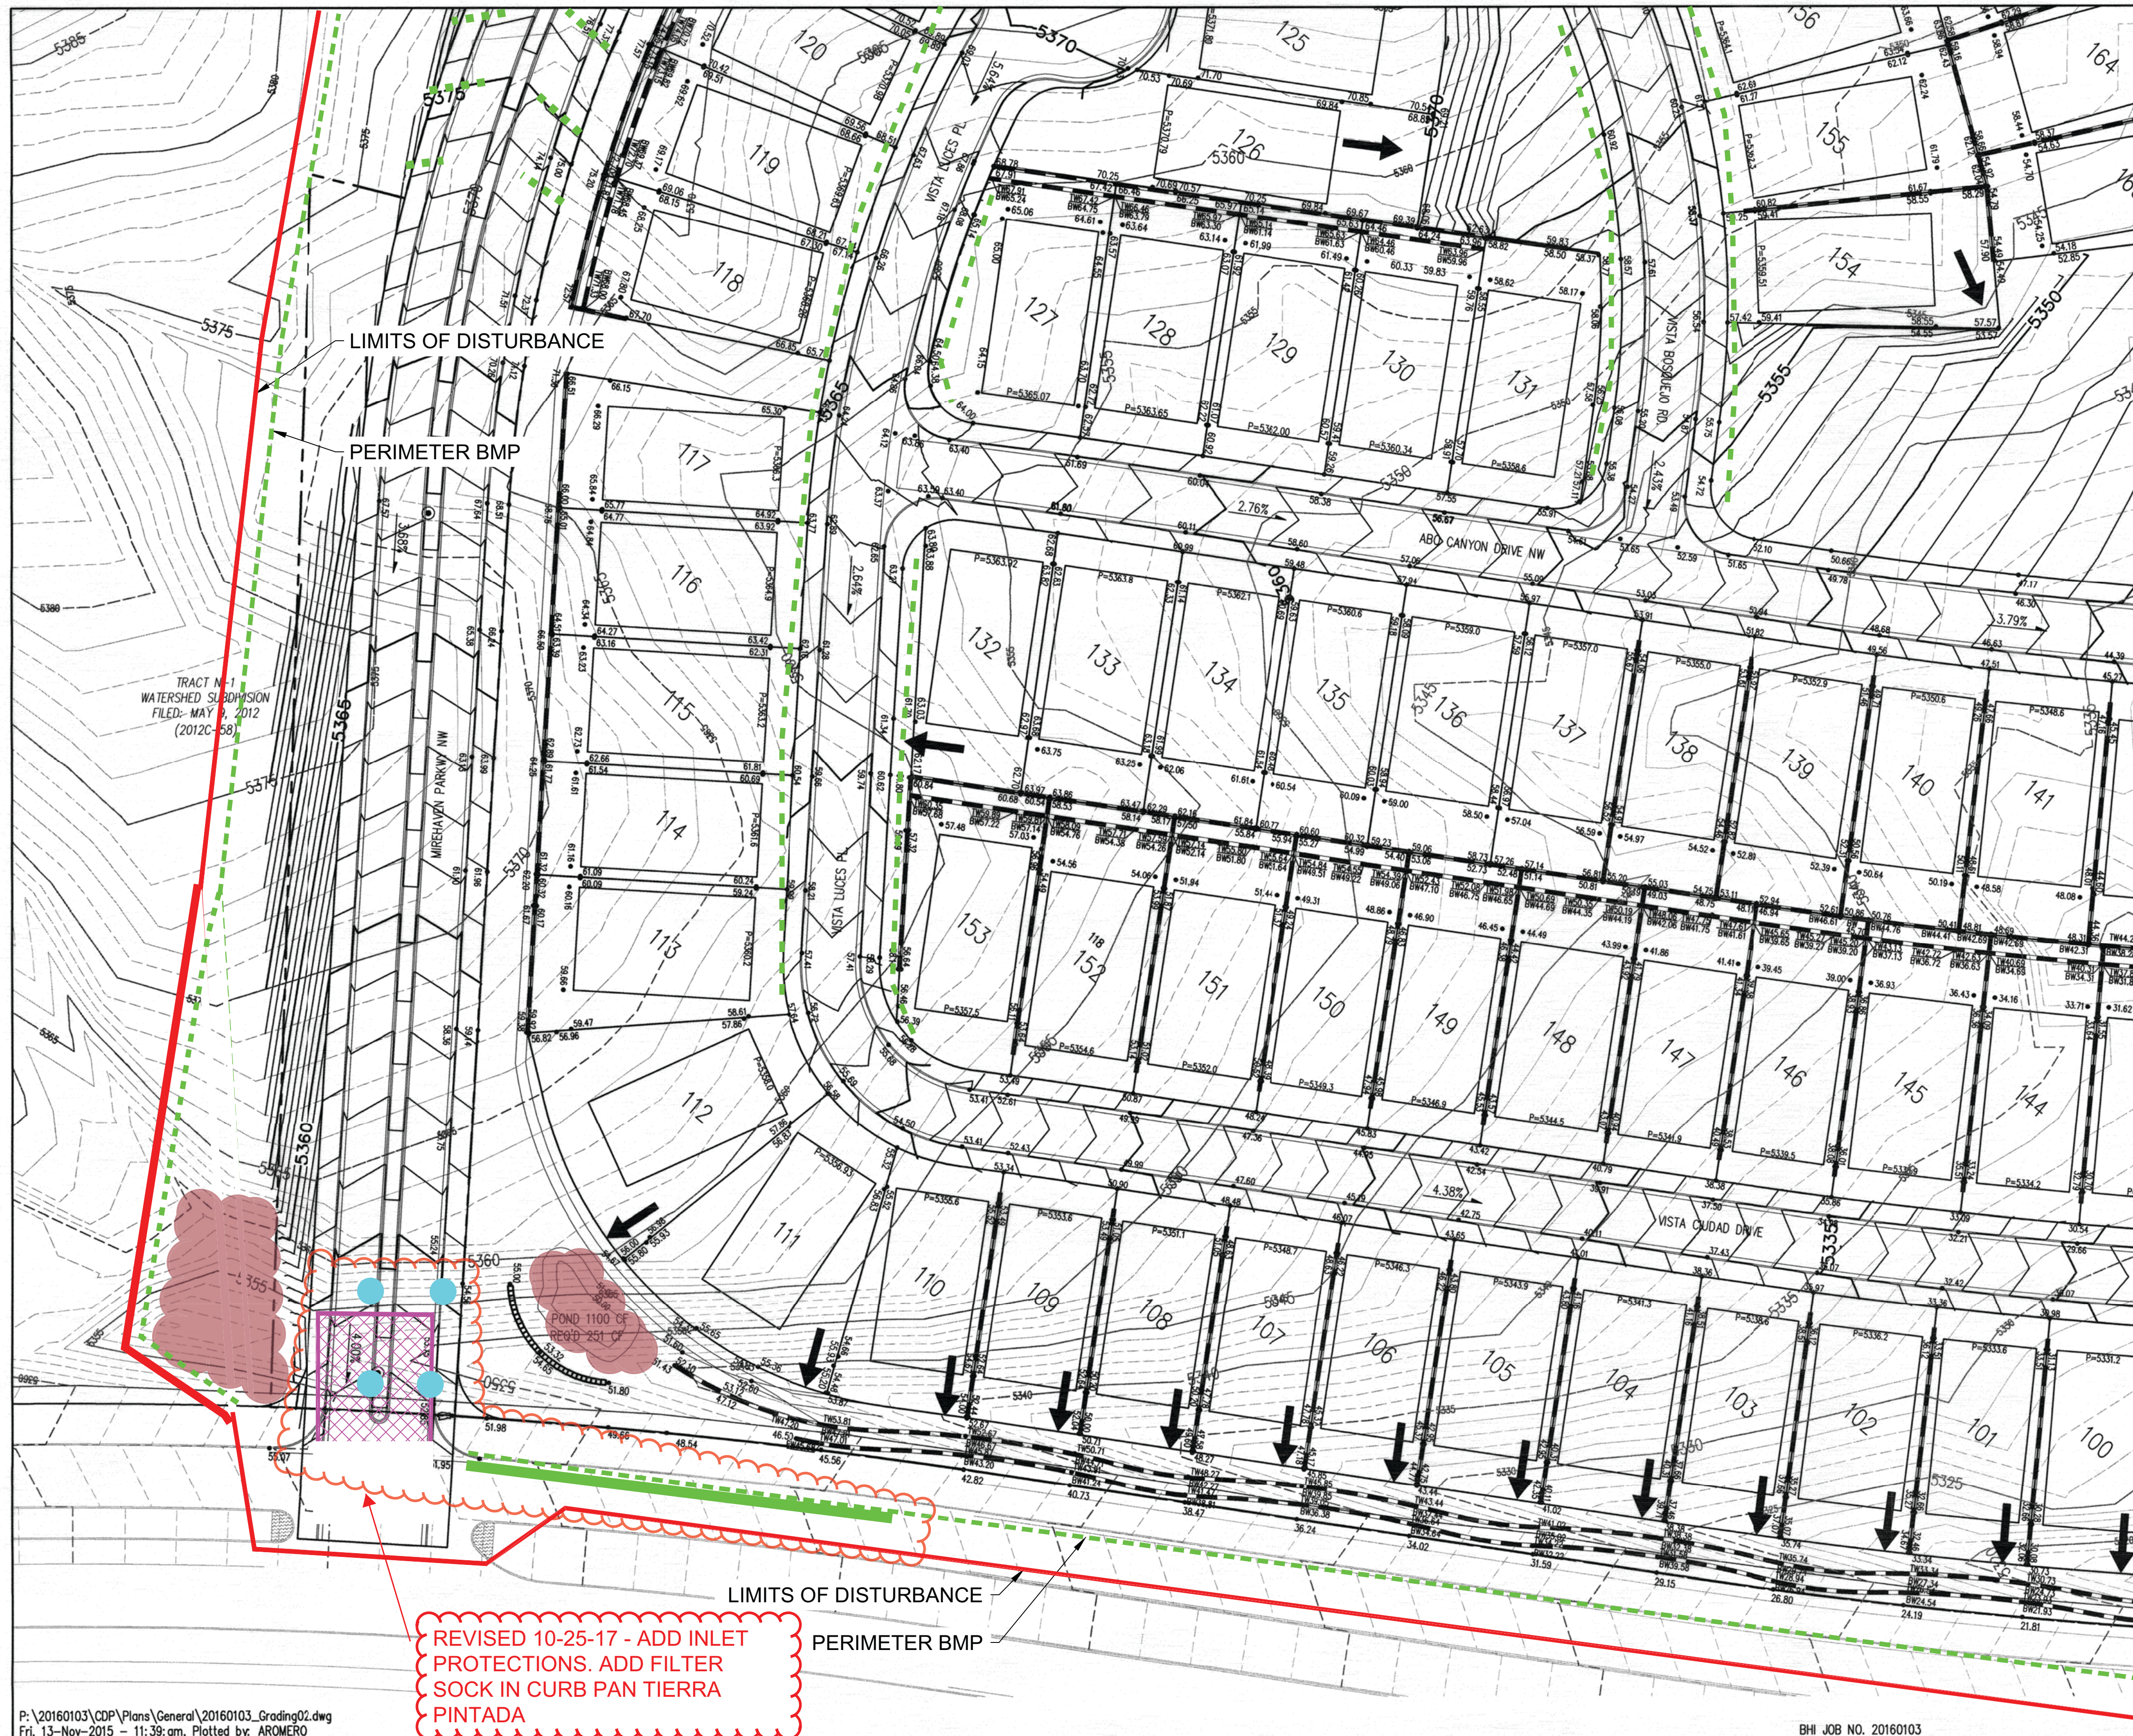


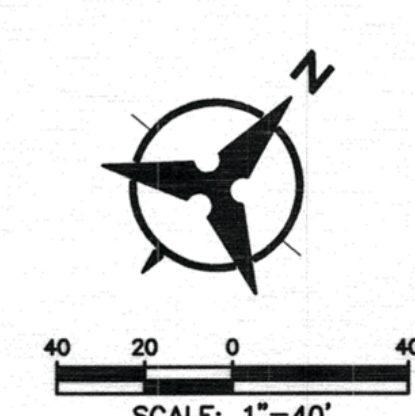

- LEGEND**
- PROPOSED SPOT ELEVATION: 5235.25
  - EXISTING SPOT ELEVATION: EX 5235.25
  - PROPOSED CONTOUR: 5225
  - EXISTING STORM DRAIN LINE: ---
  - PROPOSED STORM DRAIN INLET: [Symbol]
  - PROPOSED STORM DRAIN LINE: [Symbol]
  - PROPOSED STORM DRAIN MANHOLE: [Symbol]
  - PROPOSED WATER BLOCK: [Symbol]
  - RETAINING WALL: [Symbol]
  - PAD: [Symbol]
  - WALL OPENING: [Symbol]
  - STREET SLOPE: XY
- ESC PLAN LEGEND**
- LIMIT OF DISTURBANCE: [Red Line]
  - PERIMETER BMP: [Green Dashed Line]
  - VTC: [Blue Dashed Line]
  - POND: [Blue Hatched Area]
  - FLOW DIRECTION: [Blue Arrow]
  - FRONT YARD BMP: [Green Dashed Line]
  - OUTLET PROTECTION: [Blue Circle]
  - SED. TRAP: [Red Circle]
  - FILTER SOCK: [Green Line]

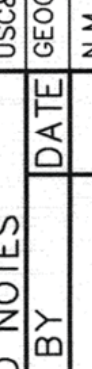

|                                                                 |                        |                                                                   |         |
|-----------------------------------------------------------------|------------------------|-------------------------------------------------------------------|---------|
|                                                                 |                        | <b>CITY OF ALBUQUERQUE</b><br>DEPARTMENT OF MUNICIPAL DEVELOPMENT |         |
| PULTE @ MIREHAVEN PHASE 2A<br>EROSION AND SEDIMENT CONTROL PLAN |                        |                                                                   |         |
| DESIGN REVIEW COMMITTEE                                         | CITY ENGINEER APPROVAL | MO./DAY/YR. MO./DAY/YR.                                           |         |
| LAST DESIGN UPDATE                                              |                        | SHEET                                                             |         |
| CITY PROJECT NO.                                                |                        | ZONE MAP NO.                                                      | ESC 104 |

|   |  
|---|--|---------|--|----|--|--|--|--|--|--------------------|--|--------------------------------|--|-------------|--|-----------------------------------------|--|----------------------|--|---------------------------|--|--|--|
| ENGINEER'S SEAL                                                                                               |  |         |  |    |  |  |  |  |  | SURVEY INFORMATION |  |                                |  | BENCH MARKS |  |                                         |  | AS-BUILT INFORMATION |  |                           |  |  |  |
| <br><i>Michael D. Tula</i> |  |         |  |    |  |  |  |  |  | NO.                |  | BY                             |  | DATE        |  | USC&GS BRASS DISC STAMPED "REWARD 1969" |  |                      |  | CONTRACTOR                |  |  |  |
|   |  |         |  |    |  |  |  |  |  |                    |  |                                |  |             |  | N.M. STATE PLANE COORDINATES            |  |                      |  | INSPECTOR'S ACCEPTANCE BY |  |  |  |
|   |  |         |  |    |  |  |  |  |  |                    |  |                                |  |             |  | (CENTRAL ZONE)                          |  |                      |  | FIELD CORON BY            |  |  |  |
|   |  |         |  |    |  |  |  |  |  |                    |  |                                |  |             |  | N=1487364.063 E=149190.819              |  |                      |  | DRAWINGS                  |  |  |  |
| NO. DATE   |  | REMARKS |  | BY |  |  |  |  |  |                    |  | GROUND TO GRID = 0.999675005   |  |             |  | MICRO-FILM INFORMATION                  |  |                      |  |                           |  |  |  |
|   |  |         |  |    |  |  |  |  |  |                    |  | DELTA ALPHA = -007712.26"      |  |             |  | RECORDED BY                             |  |                      |  |                           |  |  |  |
|   |  |         |  |    |  |  |  |  |  |                    |  | NAVD 1988 ELEVATION = 5319.688 |  |             |  | NO.                                     |  |                      |  |                           |  |  |  |
|   |  
