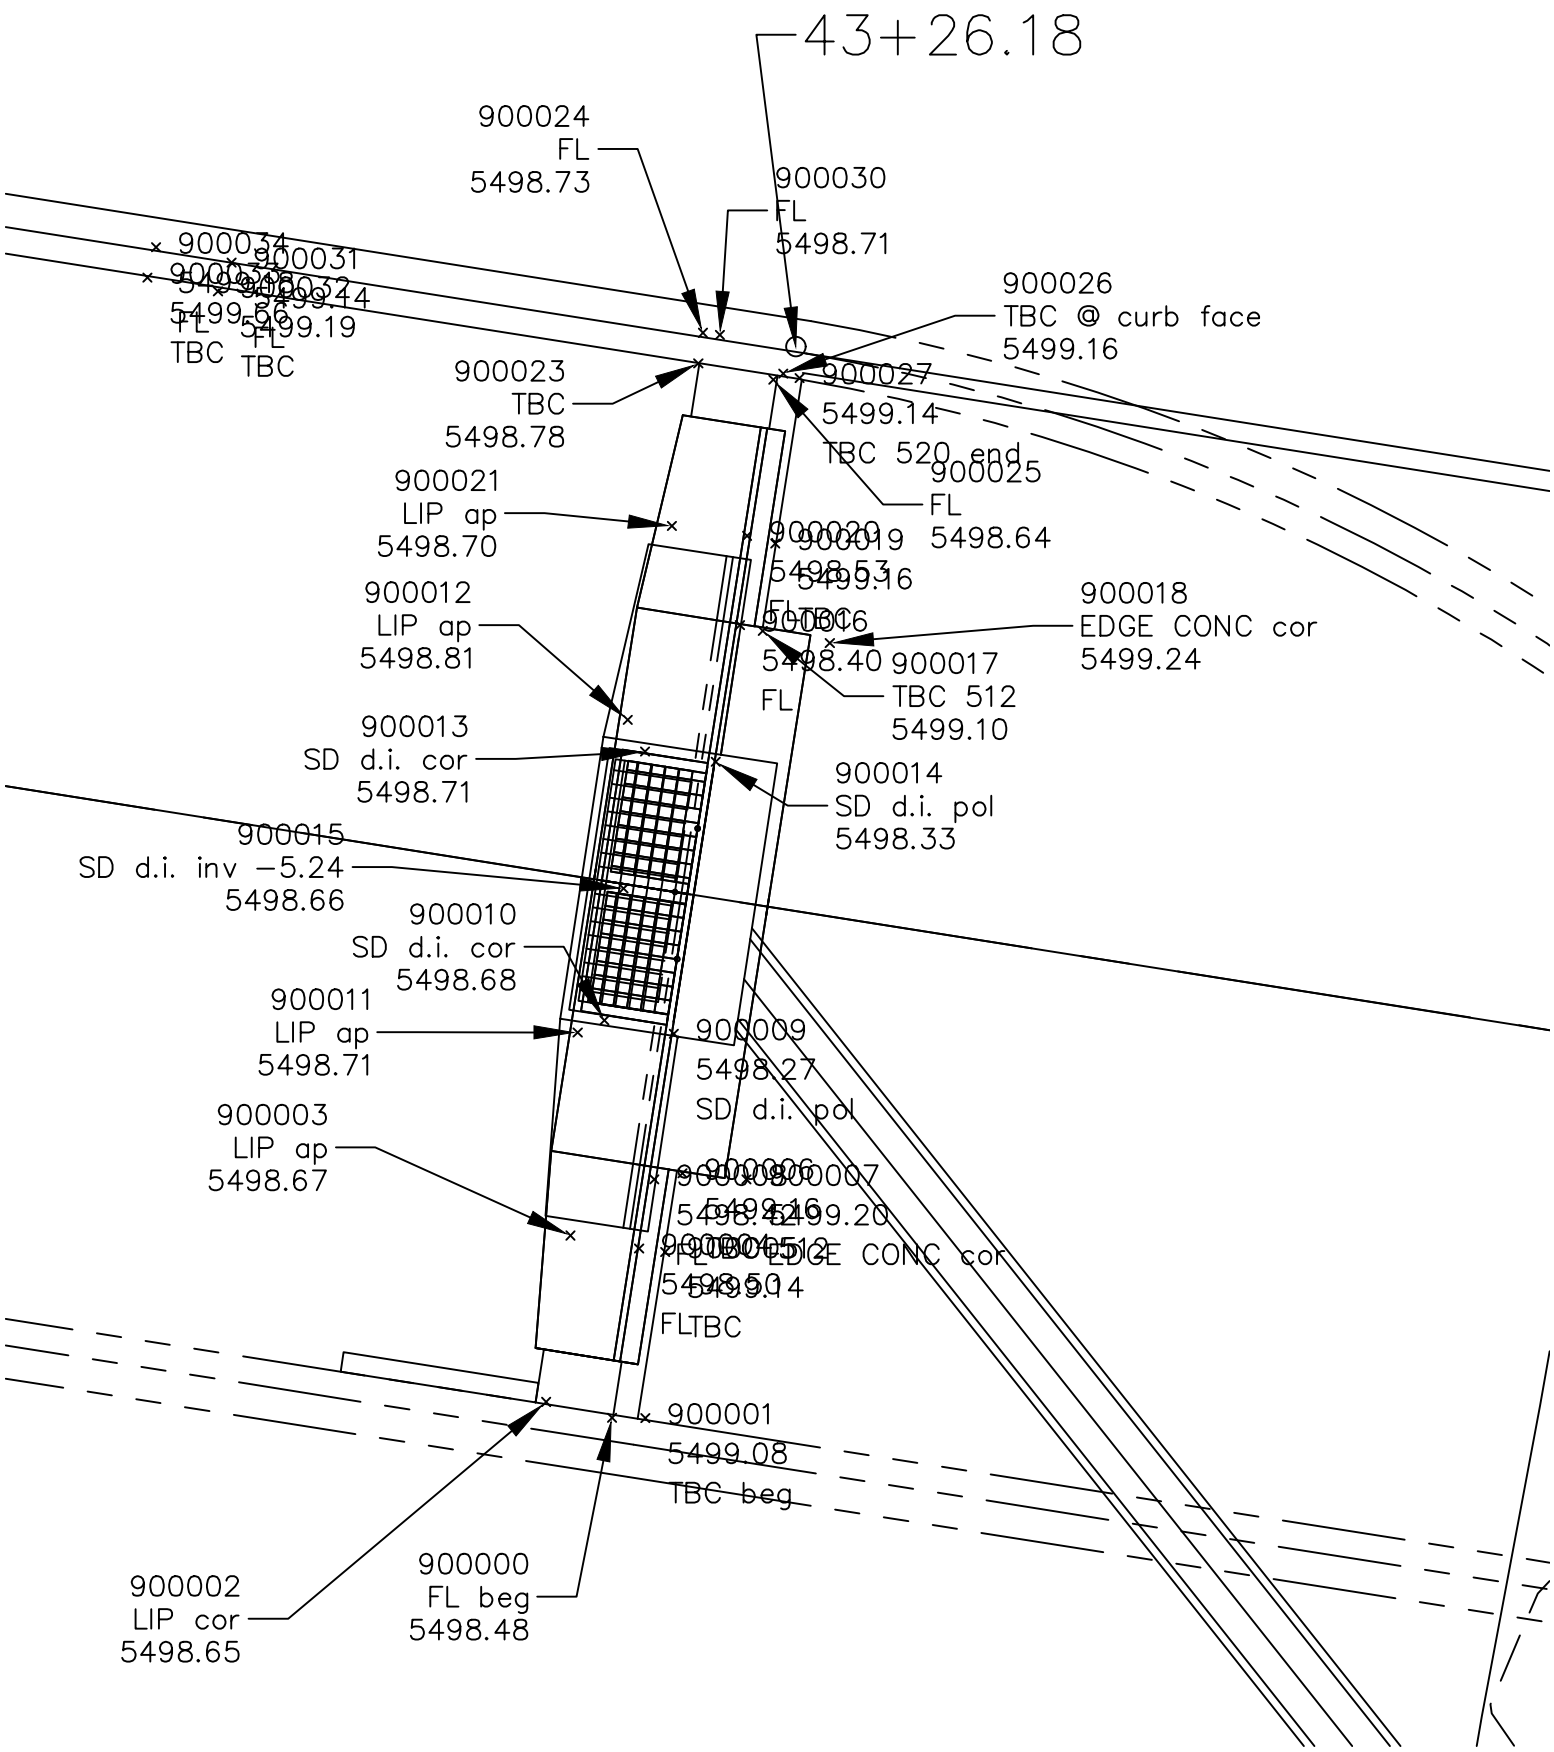
43+26.18
900024
FL
5498.73
900030
FL
5498.71
900026
TBC @ curb face
5499.16
900023
TBC
5498.78
900027
5499.14
TBC 520 end
900025
FL
5498.64
900021
LIP ap
5498.70
900020
5498.53
900019
5499.16
900012
LIP ap
5498.81
900018
EDGE CONC cor
5499.24
900016
5498.40
900017
TBC 512
5499.10
900013
SD d.i. cor
5498.71
900014
SD d.i. pol
5498.33
900015
SD d.i. inv −5.24
5498.66
900010
SD d.i. cor
5498.68
900011
LIP ap
5498.71
900009
5498.27
SD d.i. pol
900003
LIP ap
5498.67
900006
5498.42
900007
5499.20
EDGE CONC cor
5499.14
900001
5499.08
TBC beg
900002
LIP cor
5498.65
900000
FL beg
5498.48