
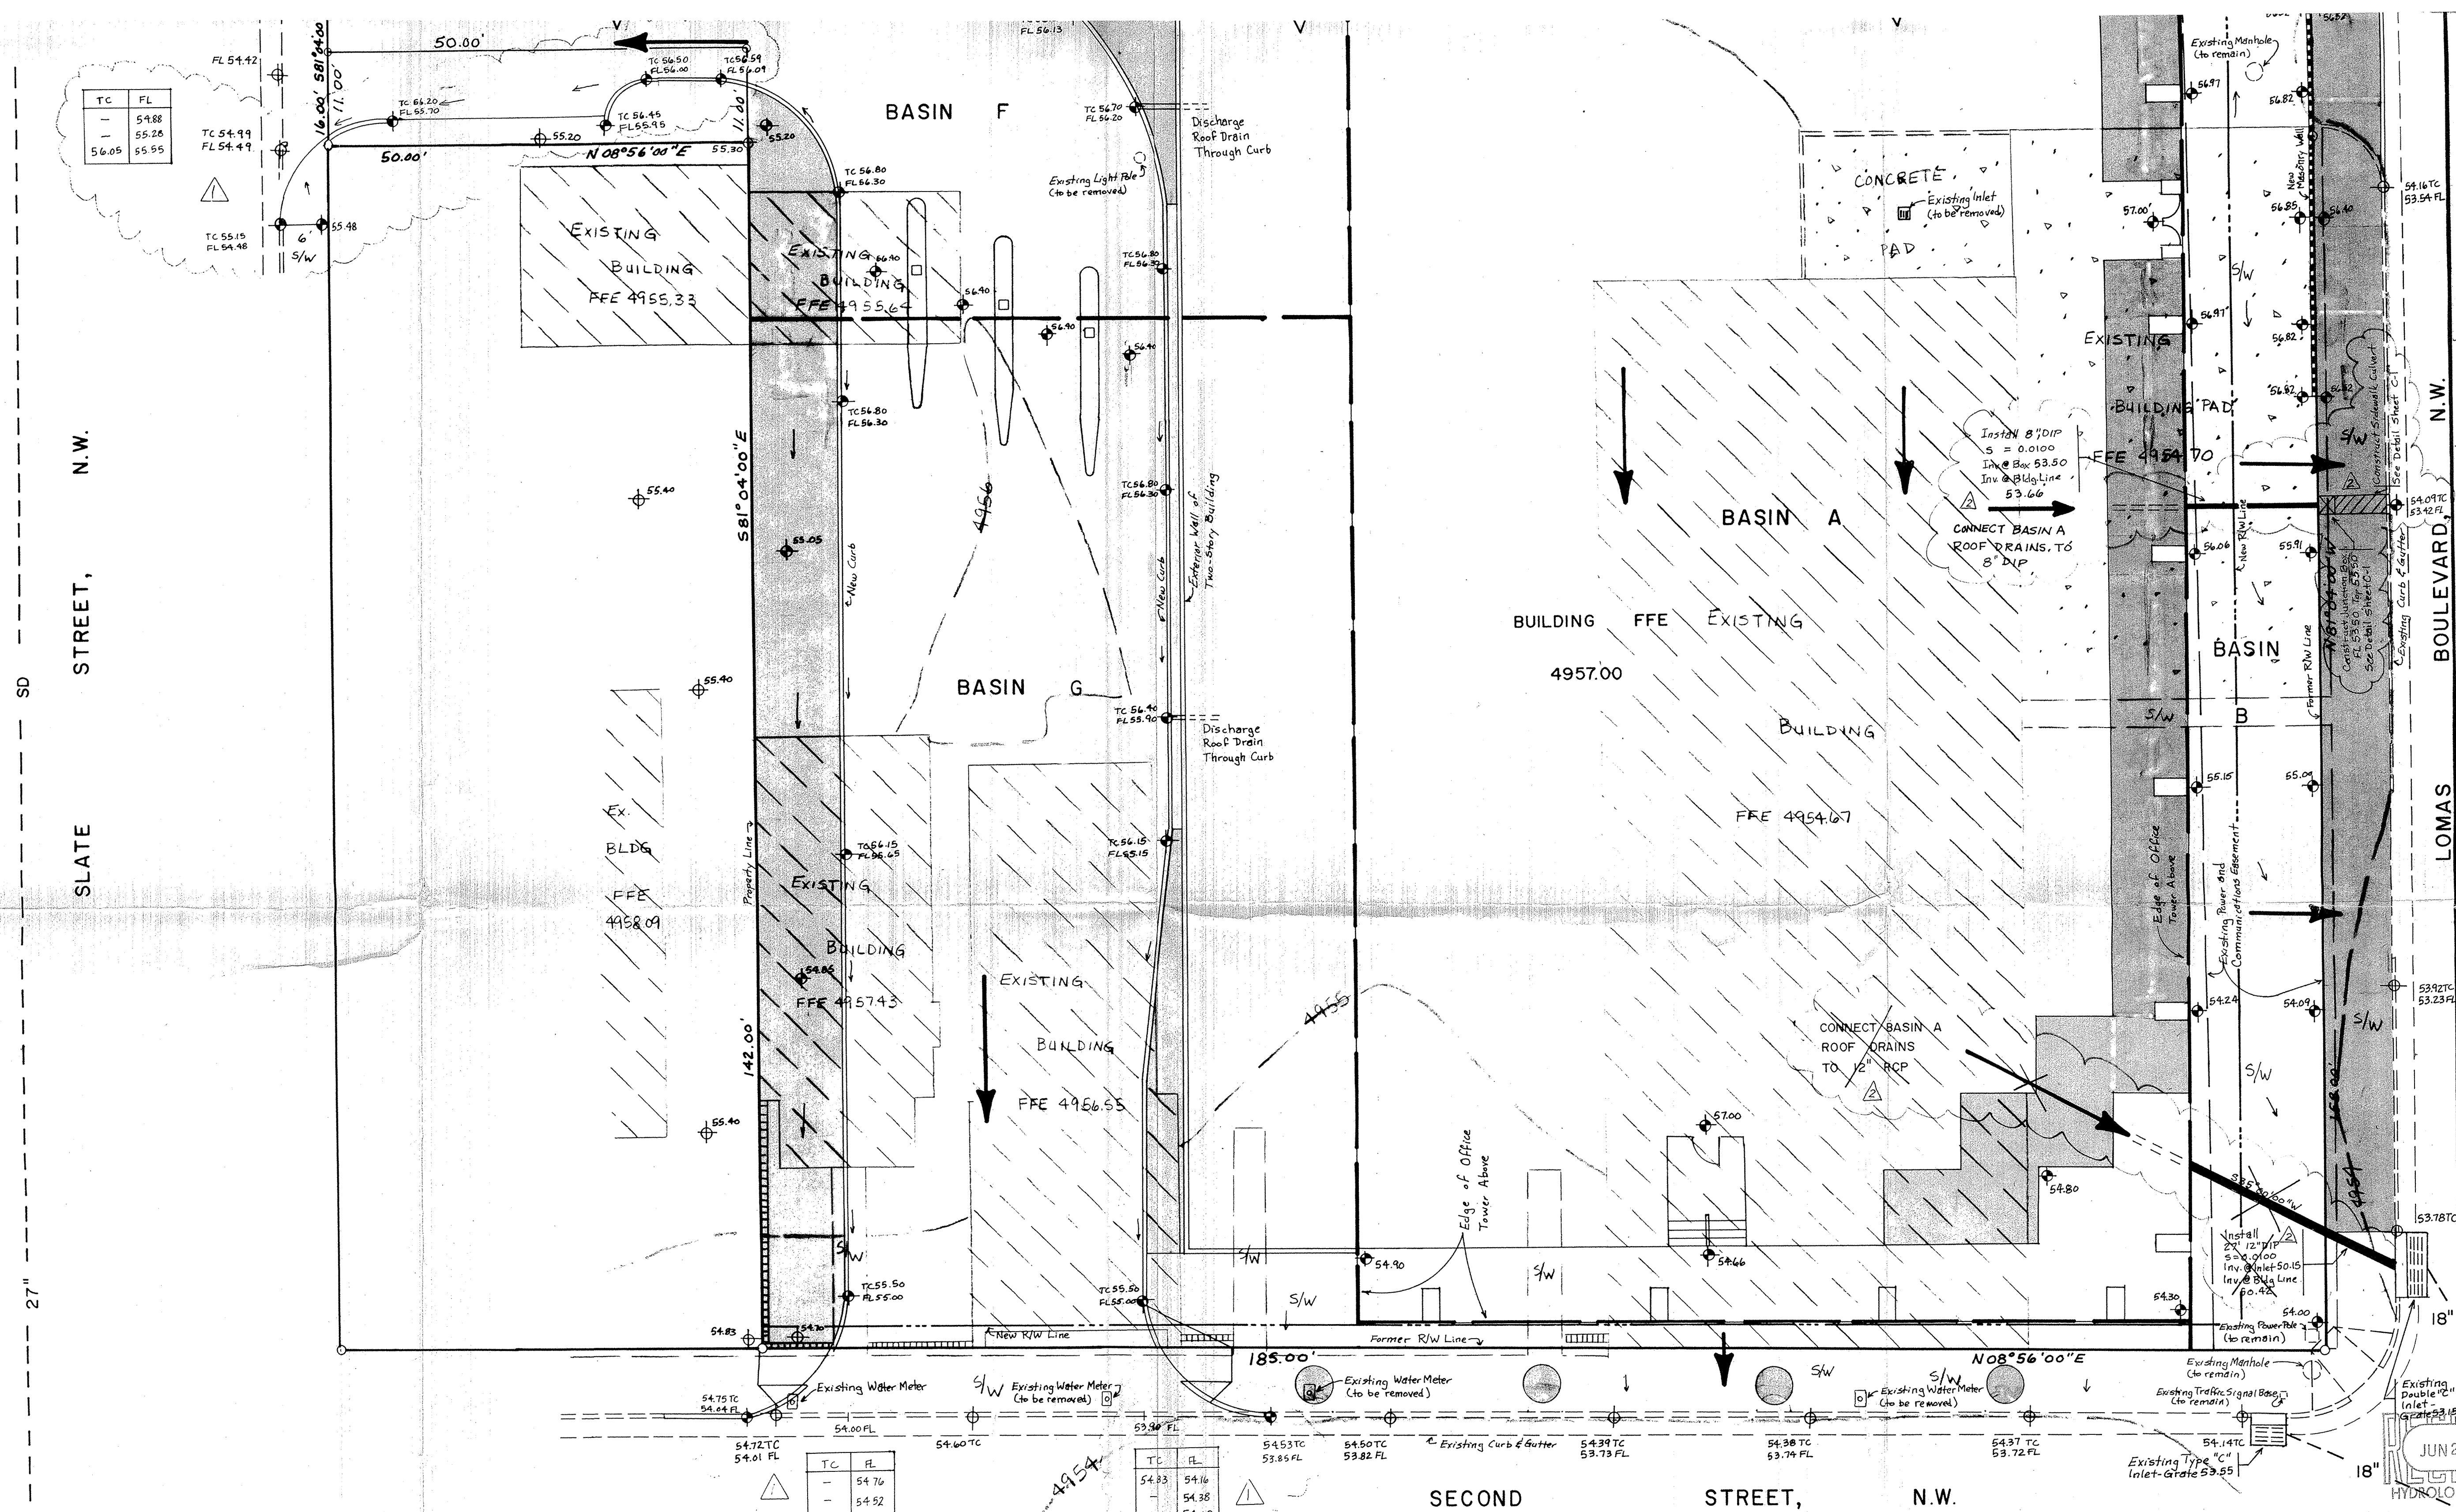


SCALE: 1" = 10'

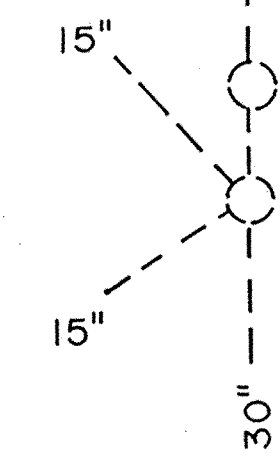

SEE NOTES SHEET C-1

EXISTING FACILITIES WITHIN THE SITE AND ADJACENT TO THE SITE ARE BASED ON TOPOGRAPHIC SURVEYS PREPARED BY SOUTHWEST SURVEYING COMPANY, INC. 505-247-4444, DATED SEPT. 11, 1987 & NOV. 23, 1987. EXISTING STORM DRAIN LINES IN ADJACENT STREETS ARE BASED ON CITY AS-BUILT INFORMATION.

BENCHMARK STATION IS LOCATED 2.0' WEST OF THE BACK OF CURB ON 4TH STREET AND 3.0' NORTH OF THE BACK OF CURB ON LOMAS. IT IS A STANDARD DISK STAMPED "2-J 14 R". ELEVATION 4954.40.

- LEGEND**
- DRAINAGE BASIN BOUNDARY
 - BASIN DISCHARGE LOCATION
 - DIRECTION OF FLOW
 - EXISTING CONTOUR
 - EXISTING SPOT ELEVATION
 - PROPOSED TOP OF CURB ELEVATION
 - PROPOSED FLOWLINE ELEVATION
 - LANDSCAPED AREA



David M. Y. Millikan, P.E.

P.O. Box 881954
Houston, Texas 77088
713/444-5072

R&A
architects a.i.a.
10101 Fondren
Houston, Texas 77066

BANQUEST BUILDING
ALBUQUERQUE
NEW MEXICO

JOB NO.
DRAWN
CHKD.
DATE

REV NO.
11-30-88 DMYM
5-19-89 DMYM