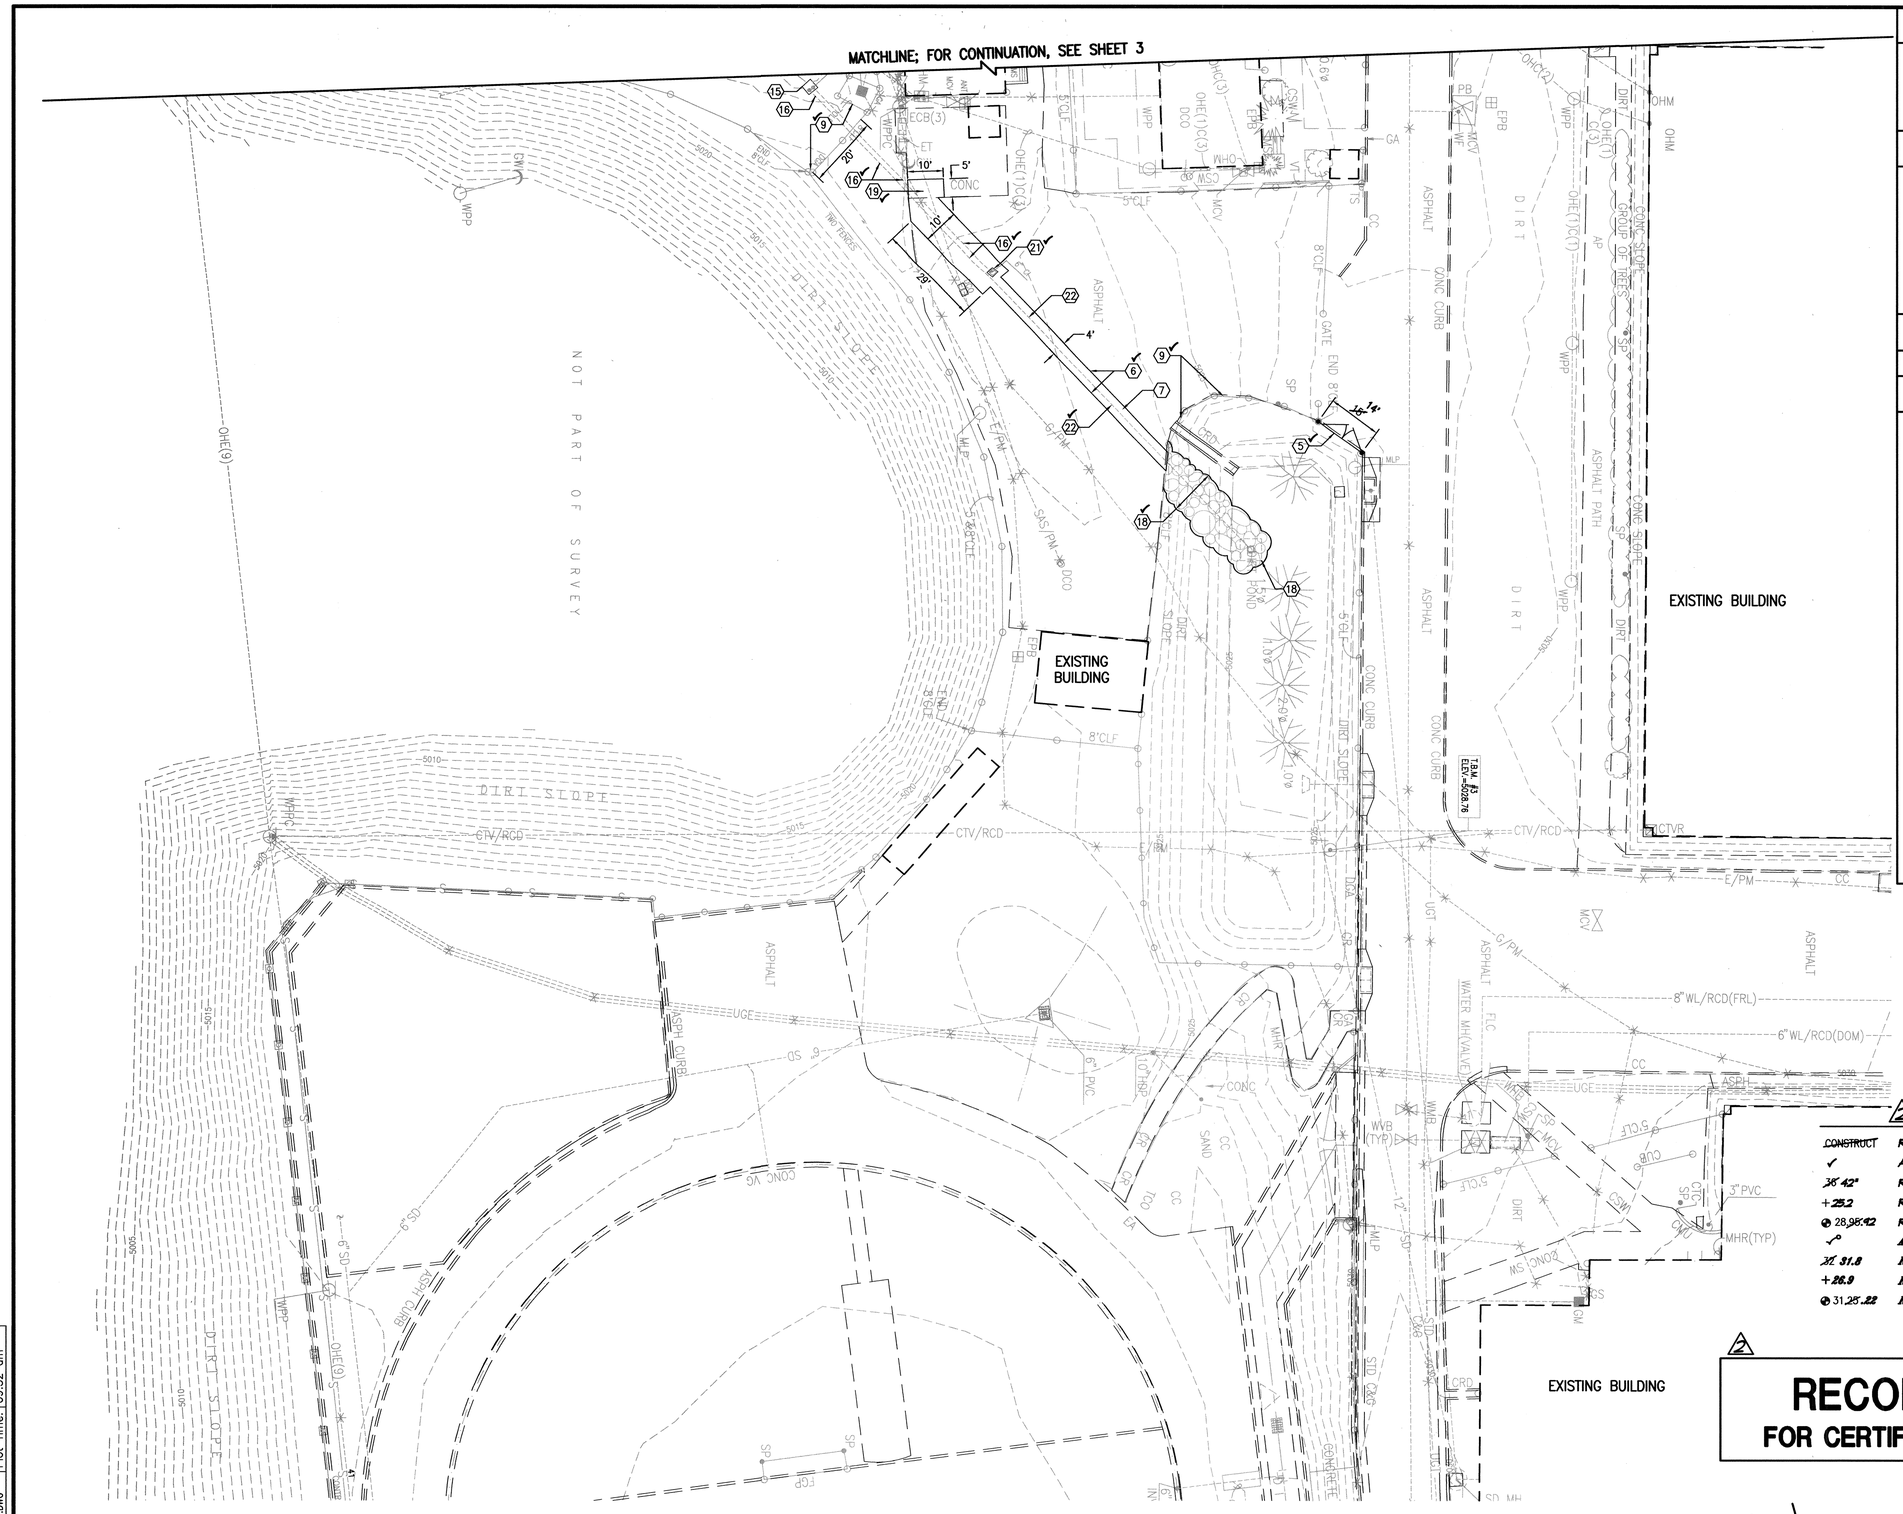

SURVEY NOTE

THIS IS NOT A BOUNDARY SURVEY; TOPOGRAPHIC INFORMATION IS BASED UPON A PARTIAL TOPOGRAPHIC SURVEY PREPARED BY HIGH MESA CONSULTING GROUP, NMPS NO. 11184, DATED 11/15/2007. SUPPLEMENTAL INFORMATION SHOWN IS BASED UPON RECORD DRAWINGS PREPARED BY HIGH MESA CONSULTING GROUP, CERTIFIED 03/09/09 BY ENGINEER ON RECORD, NMPE 8547

BENCHMARKS

PROJECT BENCHMARK

A NMSHC BRASS DISK STAMPED "STA I-25-30" SET IN TOP OF A CONCRETE POST 0.2' ABOVE GROUND LOCATED ADJACENT TO THE NORTHWEST INTERSECTION OF GIBSON BOULEVARD AND THE I-25 BRIDGE INTERCHANGE.
ELEVATION = 5041.30 FEET (NAVD 88)

T.B.M. #1

A P.K. NAIL AND SHINER AS SHOWN ON SHEET 3.
ELEVATION = 5026.94 FEET (NAVD 88)

LEGAL DESCRIPTION

A PORTION OF ALBUQUERQUE HIGH SCHOOL, UNPLATTED.

KEYED NOTES

1. NEATLY SAWCUT EXISTING CONCRETE CURB & GUTTER.
2. REMOVE AND DISPOSE OF EXISTING CONCRETE CURB & GUTTER.
3. EXISTING CURB & GUTTER TO REMAIN.
4. CLEAR AND GRUB EXISTING DETENTION POND. REMOVE AND DISPOSE OF ALL TREES, SHRUBS AND VEGETATION.
5. REMOVE EXISTING CHAINLINK FENCE AND RETURN TO OWNER.
6. NEATLY SAWCUT EXISTING ASPHALT PAVEMENT.
7. REMOVE & DISPOSE OF EXISTING PAVEMENT.
8. EXISTING ASPHALT PAVEMENT TO REMAIN.
9. EXISTING CHAINLINK FENCE TO REMAIN.
10. REMOVE AND DISPOSE OF EXISTING 16" C.I. STORM DRAIN.
11. NEATLY SAWCUT EXISTING CONCRETE DRAINAGE CHANNEL @ BACK OF SIDEWALK.
12. REMOVE AND DISPOSE OF EXISTING CONCRETE CHANNEL.
13. REMOVE AND DISPOSE OF EXISTING CONCRETE VALLEY GUTTER.
14. REMOVE AND DISPOSE EXISTING 8" DISCHARGE PIPE.
15. REMOVE AND DISPOSE OF EXISTING CONCRETE HEADWALL.
16. REMOVE AND DISPOSE OF TWO (2) EACH EXISTING 6" PVC STORM PIPES.
17. REMOVE AND RETURN EXISTING METAL LIGHT POST AND FIXTURES TO OWNER.
18. REMOVE AND SALVAGE RIP-RAP FROM AROUND EXISTING STAND PIPE AND SIDE OF POND. CONTRACTOR SHALL KEEP RIP-RAP CLEAN AND FREE OF DEBRIS FOR SUBSEQUENT REINSTALLATION. REMOVE AND DISPOSE OF EXISTING CONCRETE PAD AT STAND PIPE.
19. NEATLY SAWCUT, REMOVE AND DISPOSE EXISTING CONCRETE PAVEMENT
20. EXISTING 16" C.I. STORM DRAIN PIPE TO REMAIN.
21. REMOVE AND DISPOSE OF EXISTING STORM INLET
22. REMOVE AND DISPOSE OF EXISTING 6" STORM DRAIN

2 RECORD DRAWING LEGEND

CONSTRUCT	RECORD INFORMATION (VERIFIED BY ENGINEER)
✓	AS-CONSTRUCTED = AS-DESIGNED (VERIFIED BY ENGINEER)
36' 42"	RECORD INFORMATION (VERIFIED BY ENGINEER)
+25.2	RECORD INFORMATION (VERIFIED BY ENGINEER)
⊕ 28,96.42	RECORD INFORMATION (VERIFIED BY ENGINEER)
✓°	AS-CONSTRUCTED = AS-DESIGNED (VERIFIED BY AS-BUILT SURVEY)
31' 31.8	RECORD INFORMATION FROM AS-BUILT SURVEY
+26.9	RECORD INFORMATION FROM AS-BUILT SURVEY
⊕ 31,25.22	RECORD INFORMATION FROM AS-BUILT SURVEY

2

RECORD DRAWING
FOR CERTIFICATION, SEE SHEET 1

A1 DEMOLITION PLAN – SOUTH
SCALE: 1" = 20'

HIGH MESA Consulting Group
6010-B MIDWAY PARK BLVD. NE
ALBUQUERQUE, NEW MEXICO 87109
PHONE: 505.345.4250 FAX: 505.345.4254
www.highmesacg.com

01-11-2010
06-05-2009

MASTER DRAINAGE PLAN IMPROVEMENTS
PHASE 2-B
ALBUQUERQUE HIGH SCHOOL

NO.	DATE	BY	REVISIONS
2	12/09	A.K.	REC. DWG. & CERT.

PROJECT No.	2007.183.7
DESIGNED BY	G.R.B.
DRAWN BY	J.Y.R.
APPROVED BY	J.G.M.

SHEET TITLE

DEMOLITION PLAN– SOUTH

C-104

SHEET 4 OF 14

File Path: [illegible]
File Name: 7183772B_DPSR2.DWG
Plot Date: 01-06-2010
Plot Time: 09:52 am