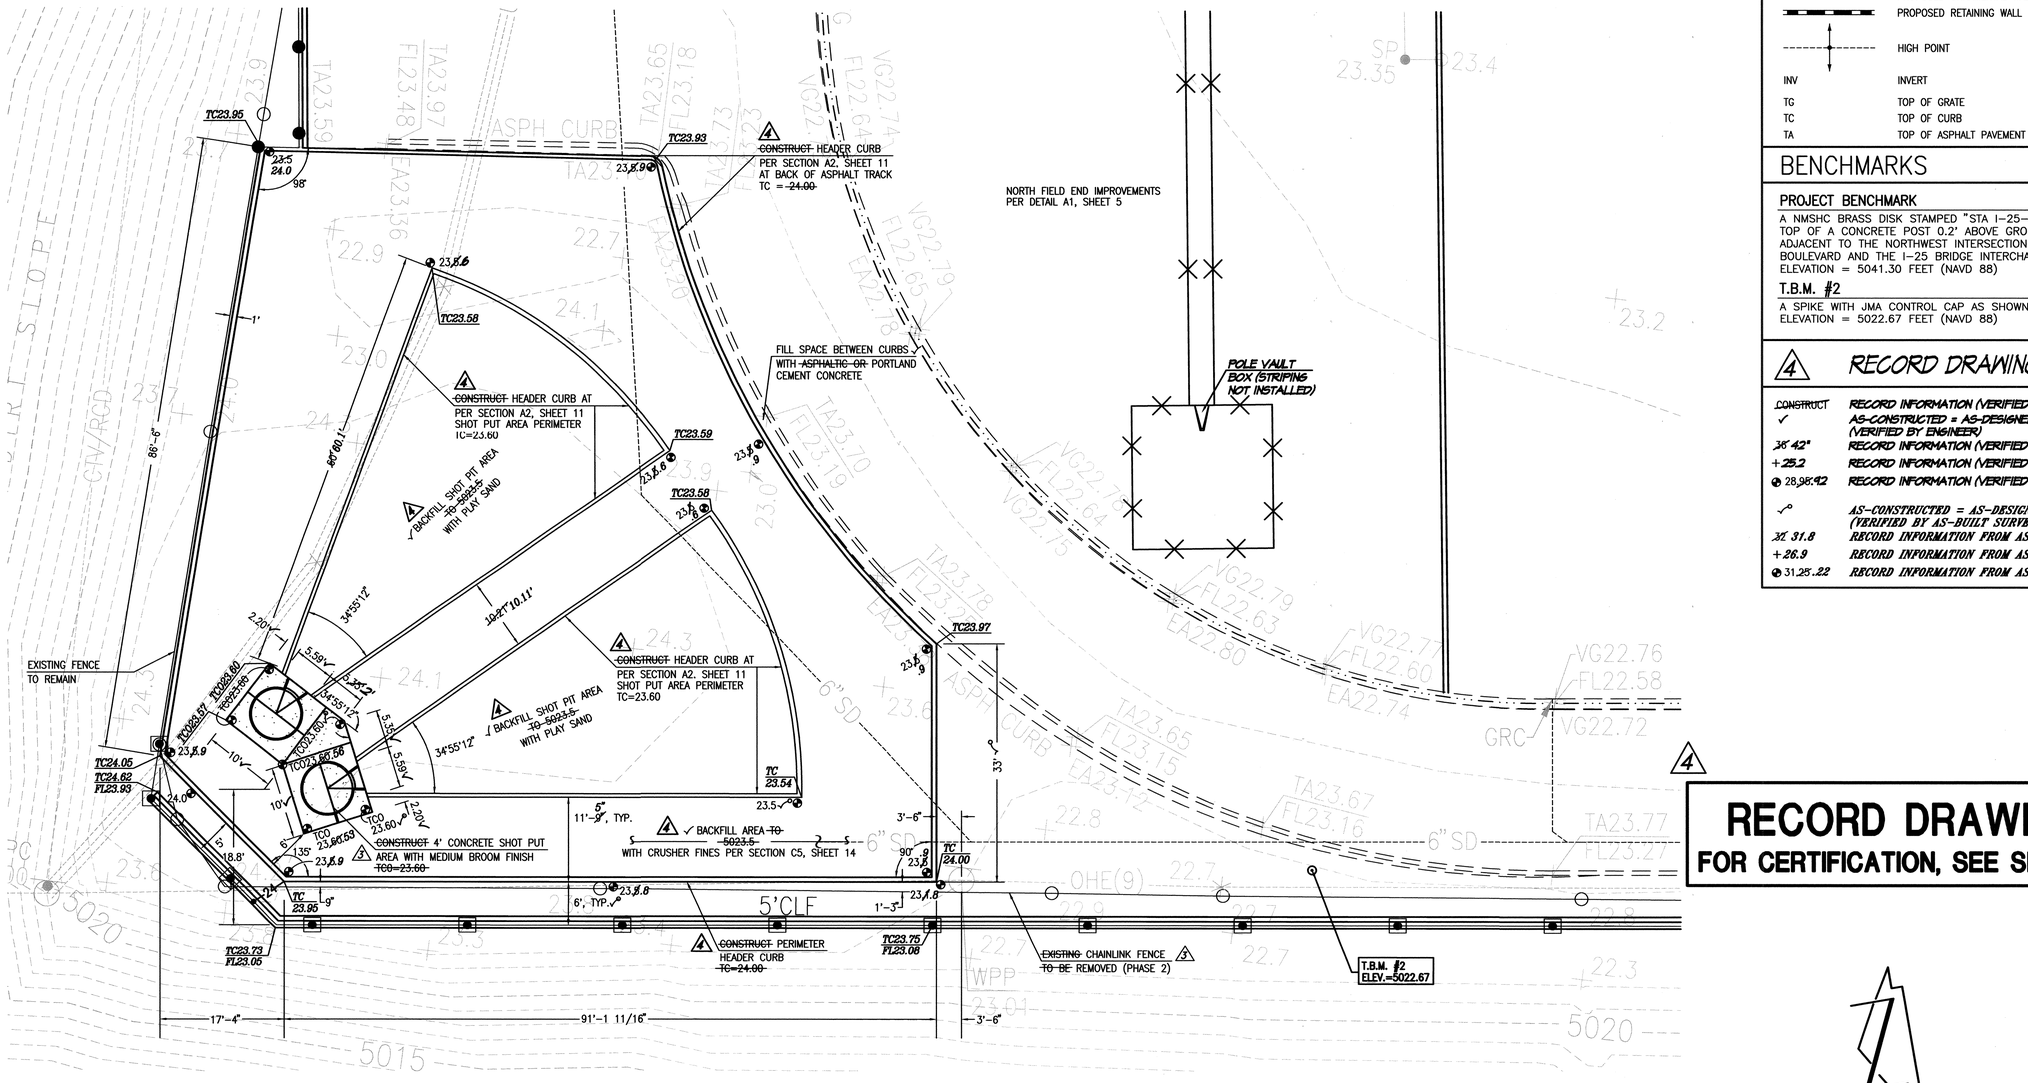

A1 SHOT PUT IMPROVEMENTS AND GRADING PLAN

SCALE: 1" = 10'

10 5 0 10 20

SURVEY NOTE

THIS IS NOT A BOUNDARY SURVEY; DATA IS SHOWN FOR ORIENTATION ONLY. THE BOUNDARY INFORMATION DEPICTED BY THIS PLAN IS BASED UPON THE BOUNDARY SURVEY PREPARED BY HIGH MESA CONSULTING GROUP, NMPS NO. 11184, DATED 11\15\2007. TOPOGRAPHIC INFORMATION IS BASED UPON A TOPOGRAPHIC SURVEY PREPARED BY HIGH MESA CONSULTING GROUP, NMPS NO. 11184, DATED 11/15/2007.

LEGEND

25.41	PROPOSED SPOT ELEVATION
+24.86	EXISTING FLOWLINE ELEVATION
08	PROPOSED CONTOUR
5008	EXISTING CONTOUR
	PROPOSED FLOWLINE
	ROOF DRAINAGE
	EXISTING ROOF DRAINAGE
	NEW BUILDING ENVELOPE
	RIGHT OF WAY LINE
	PUBLIC EASEMENT LINE
	PROPOSED CONCRETE
	PROPOSED ASPHALT
	RIVER ROCK DRY STREAM BED
	PROPOSED ORNAMENTAL WALL
	PROPOSED RETAINING WALL
	HIGH POINT
INV	INVERT
TG	TOP OF GRATE
TC	TOP OF CURB
TA	TOP OF ASPHALT PAVEMENT

BENCHMARKS

PROJECT BENCHMARK

A NMSHC BRASS DISK STAMPED "STA I-25-30" SET IN TOP OF A CONCRETE POST 0.2' ABOVE GROUND LOCATED ADJACENT TO THE NORTHWEST INTERSECTION OF GIBSON BOULEVARD AND THE I-25 BRIDGE INTERCHANGE.
ELEVATION = 5041.30 FEET (NAVD 88)

T.B.M. #2

A SPIKE WITH JMA CONTROL CAP AS SHOWN ON THIS SHEET.
ELEVATION = 5022.67 FEET (NAVD 88)

4 RECORD DRAWING LEGEND

~~CONSTRUCT~~	RECORD INFORMATION (VERIFIED BY ENGINEER)
✓	AS-CONSTRUCTED = AS-DESIGNED (VERIFIED BY ENGINEER)
36'42"	RECORD INFORMATION (VERIFIED BY ENGINEER)
+25.2	RECORD INFORMATION (VERIFIED BY ENGINEER)
28.98'42	RECORD INFORMATION (VERIFIED BY ENGINEER)
✓	AS-CONSTRUCTED = AS-DESIGNED (VERIFIED BY AS-BUILT SURVEY)
31.8	RECORD INFORMATION FROM AS-BUILT SURVEY
+26.9	RECORD INFORMATION FROM AS-BUILT SURVEY
31.25'.22	RECORD INFORMATION FROM AS-BUILT SURVEY

RECORD DRAWING
FOR CERTIFICATION, SEE SHEET 1

HIGH MESA Consulting Group
FORMERLY JEFF MORTENSEN AND ASSOCIATES, INC.
6010-B MIDWAY PARK BLVD. NE
ALBUQUERQUE, NEW MEXICO 87109
PHONE: 505.345.4250 FAX: 505.345.4254
www.highmesacg.com

JEFFREY G. MORTENSEN NEW MEXICO 9344 REGISTERED PROFESSIONAL ENGINEER

12-01-2011
07-10-08

TRACK AND FIELD RENOVATIONS
ALBUQUERQUE HIGH SCHOOL

NO.	DATE	BY	REVISIONS
4	11/11	J.G.M.	RECORD DRAWING & CERTIFICATION

2007.183.7

PROJECT No. 2007.181.7
DESIGNED BY J.G.M.
DRAWN BY JYR/CFA/BLE/JLP
APPROVED BY J.G.M.
SHEET TITLE

SHOT PUT IMPROVEMENTS & GRADING PLAN

C-118
SHEET 18 OF 25

File Path:D:\JMA\AZDATA\2007.183.7\8-A | Plot Date: 11-30-2011
File Name:7183.7-SH18-R4.DWG | Plot Time: 08:43 am