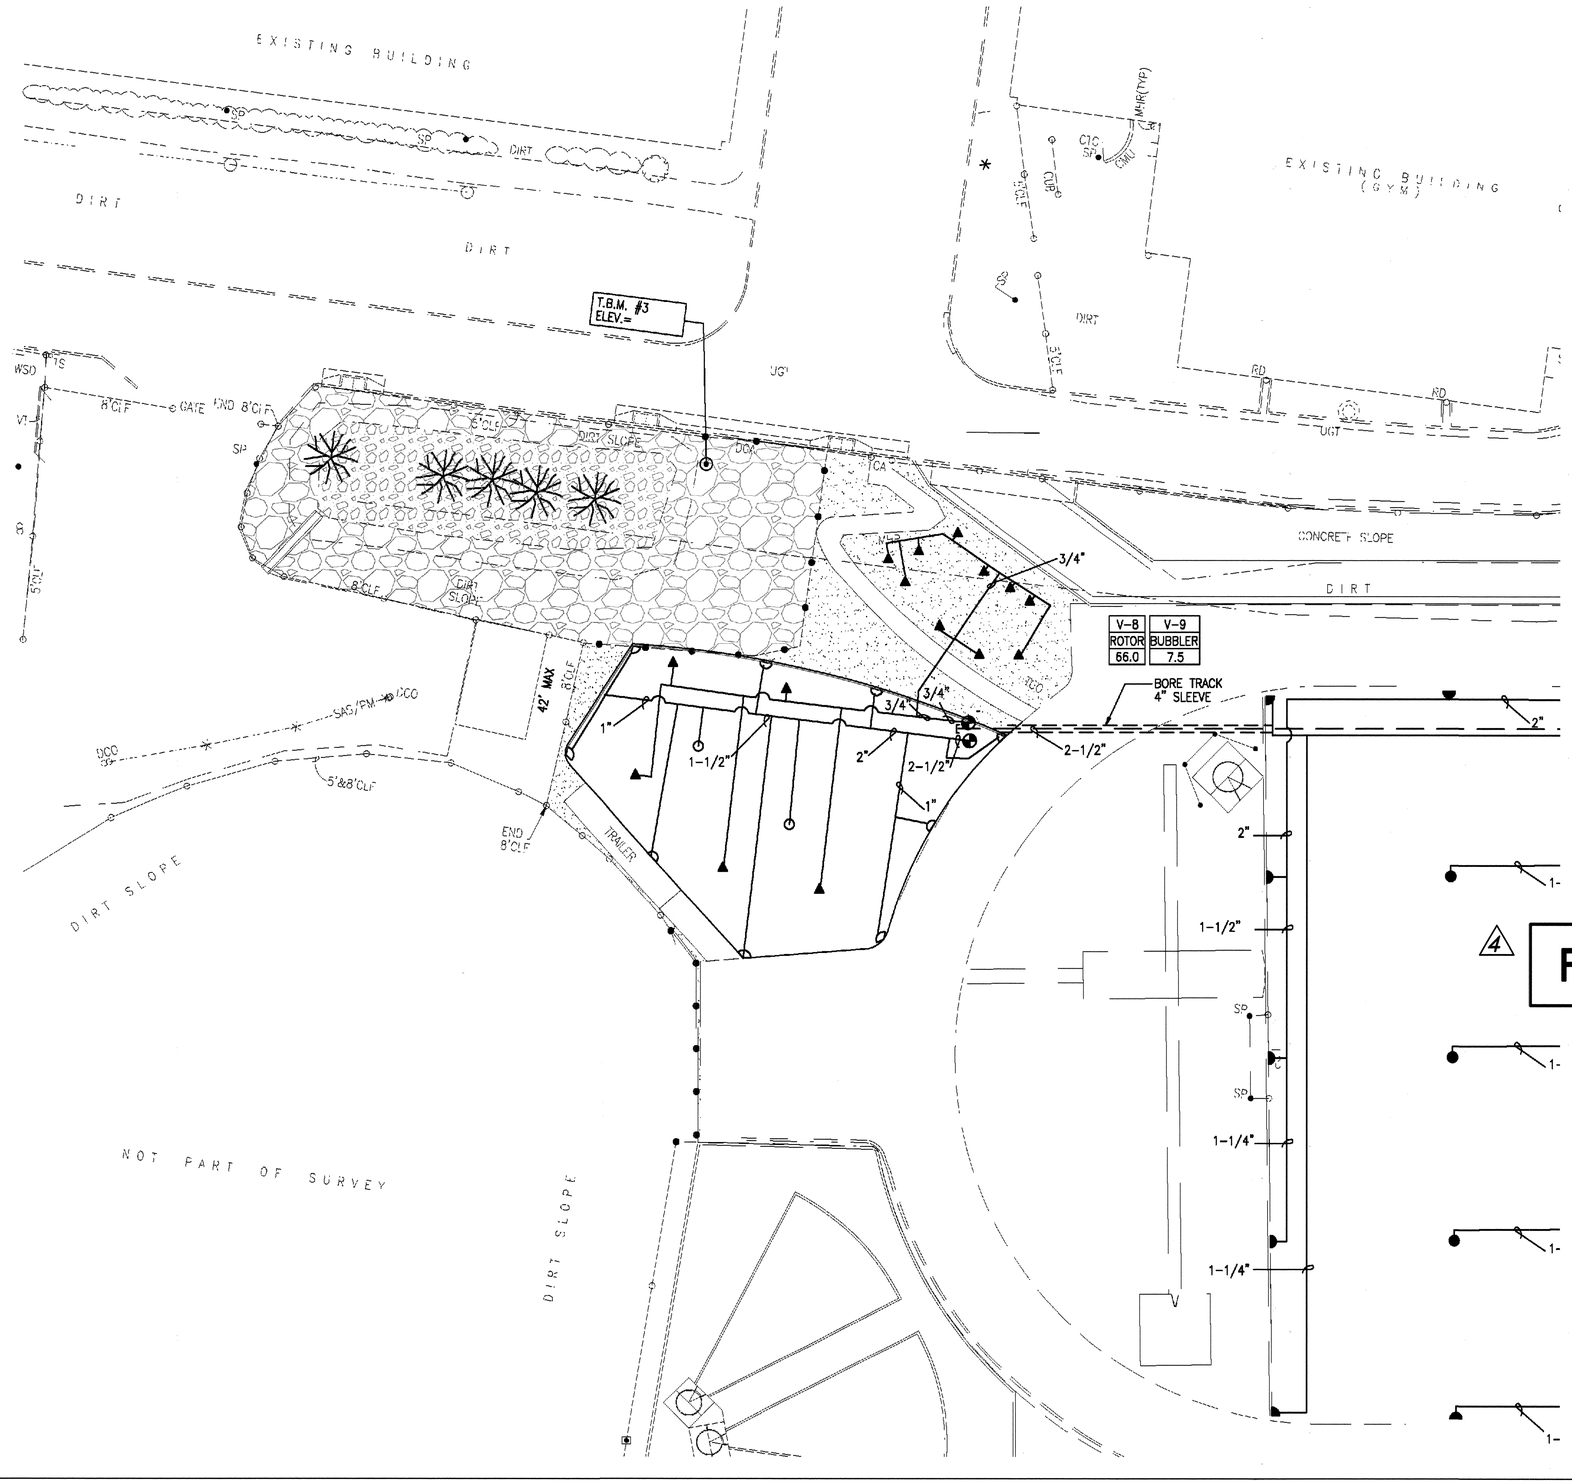

IRRIGATION LEGEND

IRRIGATION MAINLINE-SCHEDULE 40 SOLVENT WELD PVC SIZE PER PLAN	— —
IRRIGATION LATERAL PIPING-SCHEDULE 40 SOLVENT SIZE PER PLAN	——
AUTOMATIC VALVE ASSEMBLY-WEATHERMATIC AUTOMATIC VALVE	
HUNTER I-25 ROTORHEAD #10 NOZZLE	
HUNTER I-20 W/#8 NOZZLE	
FIXED BUBBLER ASSEMBLY-RAINBIRD 1400 SERIES PRESSURE COMPENSATING BUBBLER. INSTALL 1-1404 (1 GPM) BUBBLER PER TREE AND 1-1401 (.25 GPM) PER SHRUB SIZE PER PLAN.	▲
IRRIGATION CONTROLLER-IRRINET 32 STATION CONTROLLER (EXISTING). UTILIZE UNUSED STATIONS FOR NEW IRRIGATION VALVE ADDITIONS. ADD 16 STATION EXPANSION MODULE	C
TEMPORARY QUICK COUPLER TO BE REMOVED FOLLOWING CONSTRUCTION	Q

NOTES:

- ALL WORK SHOWN ON THIS SHEET TO BE INSTALLED PER ALBUQUERQUE PUBLIC SCHOOLS – STANDARD SPECIFICATIONS
- REPAIR SOD AT NEW TRENCHES

4 **RECORD DRAWING**

0' 20' 40' 60'

SCALE: 1" = 20'

ALBUQUERQUE HIGH SCHOOL
IRRIGATION PLAN-NORTHEAST CORNER

REVISIONS
4 RECORD DRAWING

DRAWN BY: WCLI
DESIGNED BY: WCLI
CHECKED BY: WCLI
DATE: N/A

WESTWIND LANDSCAPE CONSTRUCTION INC.
2739 VASSAR PLACE NE
ALBUQUERQUE, NEW MEXICO 87107
TEL 505.881.8925
FAX 505.883.7052

4 L-123
SHEET 23 OF 25