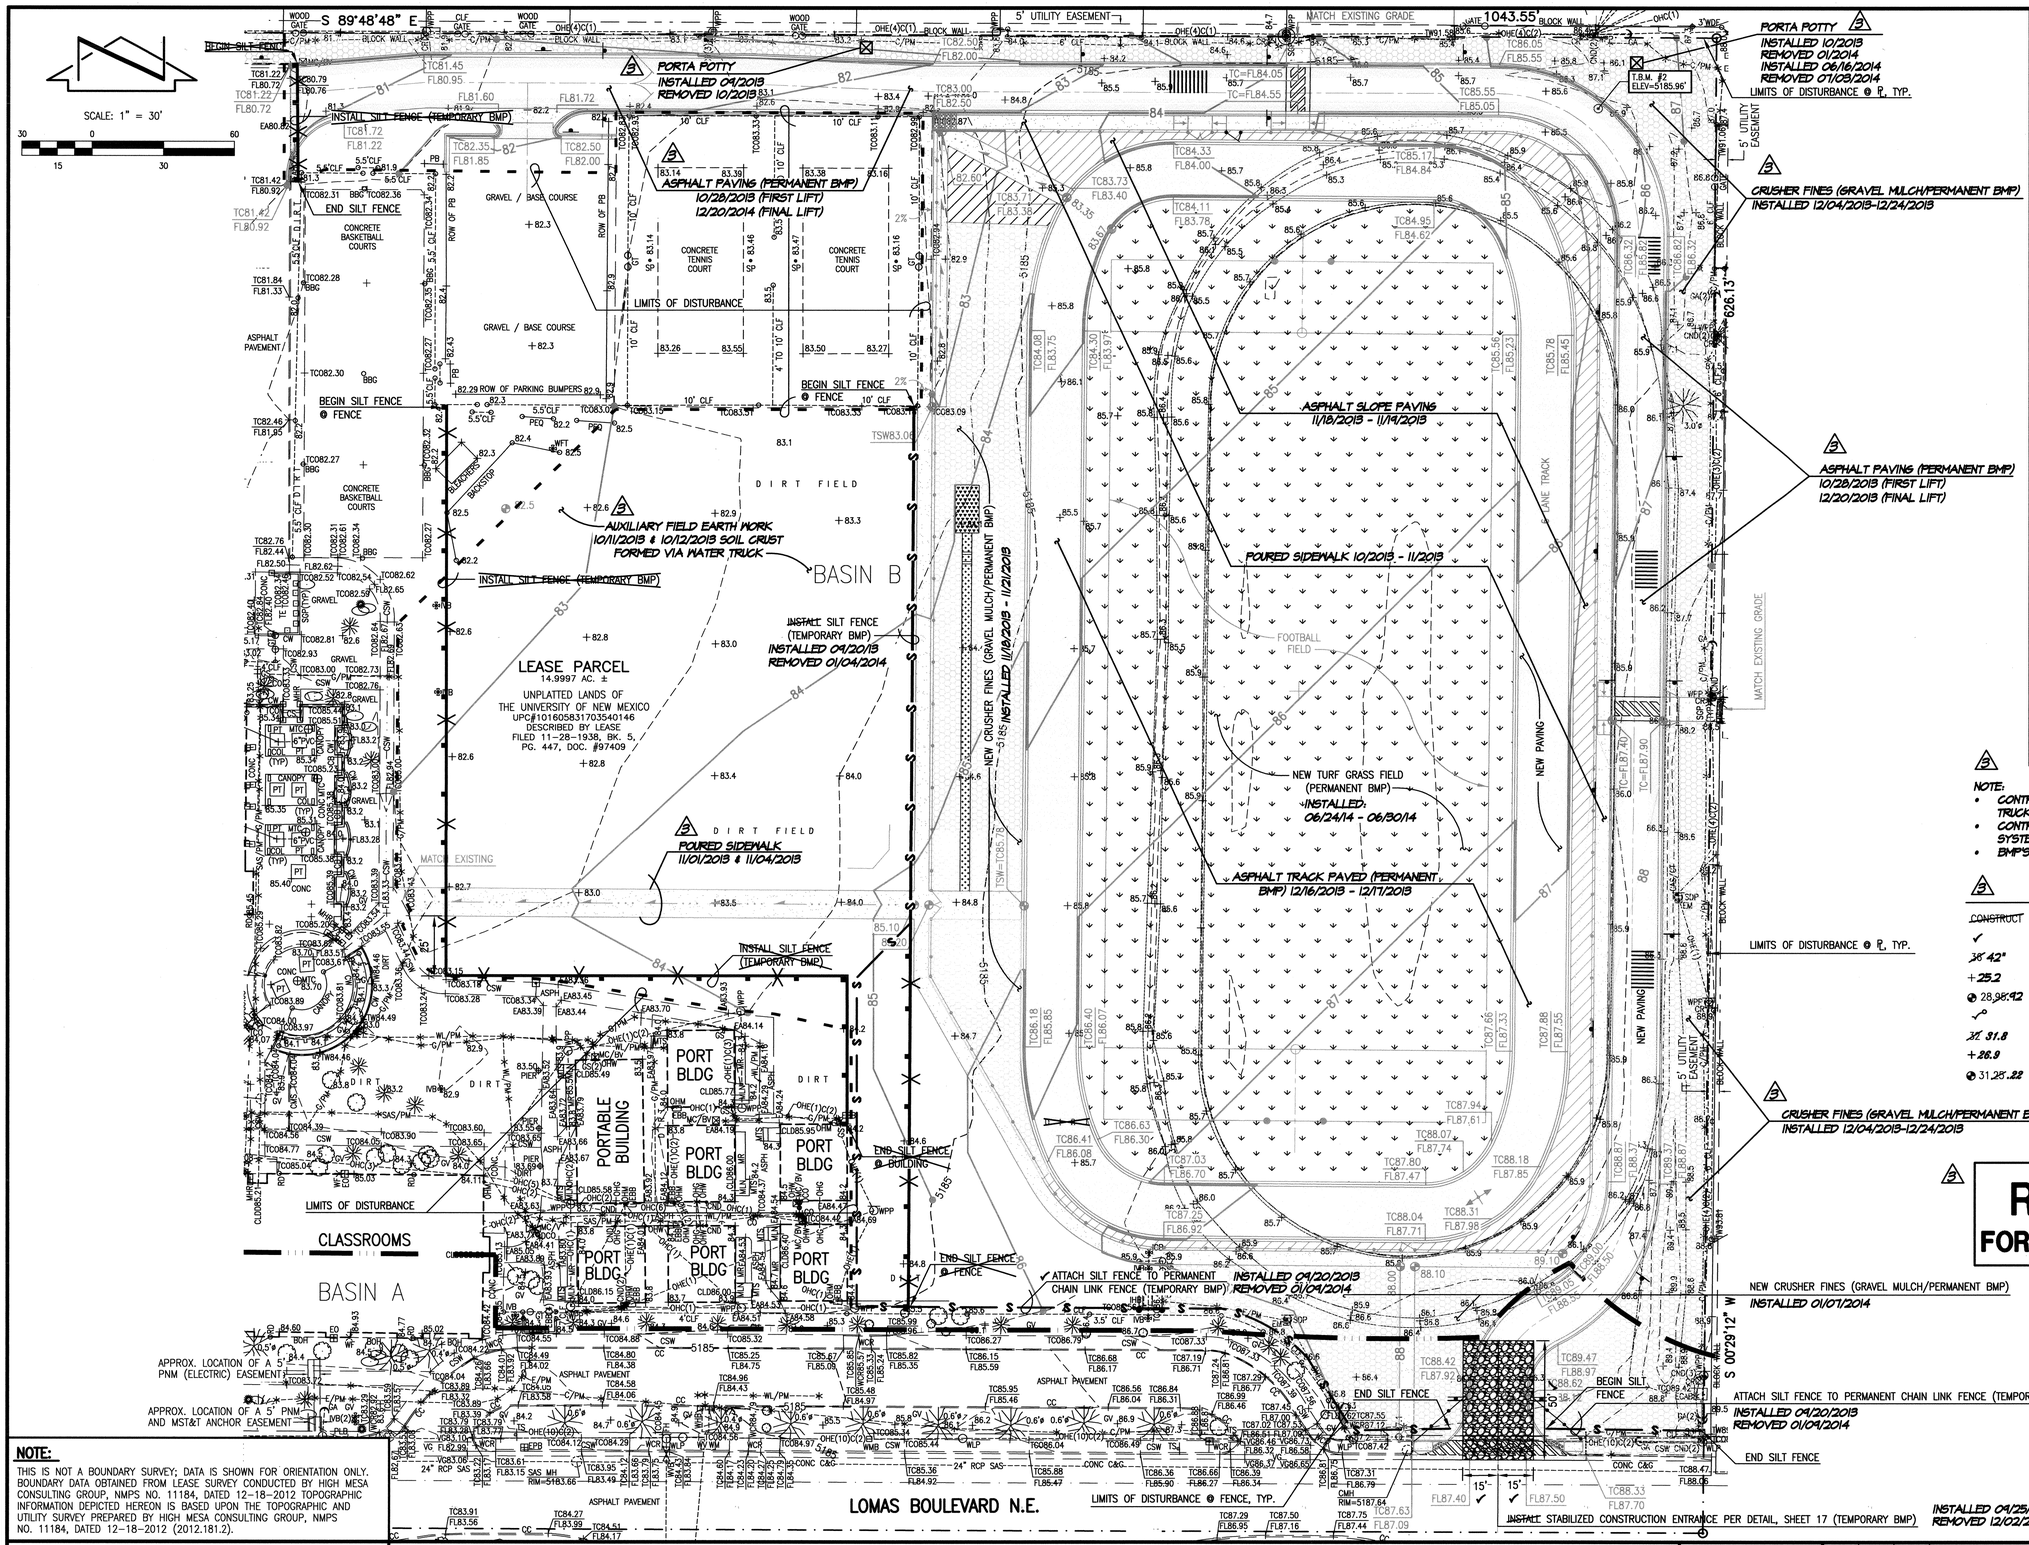

EROSION LEGEND

- EXISTING BASIN BOUNDARY
- EXISTING FLOWLINE
- EXISTING DIRECTION OF FLOW
- GRAPHIC POINT OF DISCHARGE
- PROPOSED BASIN BOUNDARY
- PROPOSED FLOWLINE
- PROPOSED DIRECTION OF FLOW
- PROPOSED GRAPHIC POINT OF DISCHARGE
- EXISTING FENCE
- CHAIN LINK FENCE WITH SILT FENCE ATTACHED
- SILT FENCE
- LIMITS OF DISTURBANCE
- INV — INVERT
- TA — TOP OF ASPHALT PAVEMENT
- TC — TOP OF CURB
- TG — TOP OF GRATE
- + 83.1 — EXISTING SPOT ELEVATION
- 83.35 — PROPOSED SPOT ELEVATION
- 5185 — EXISTING CONTOUR
- 85 — PROPOSED CONTOUR
- RIGHT OF WAY LINE
- PUBLIC EASEMENT LINE
- HIGH POINT / DIVIDE
- ASPHALT PAVING
- PAVED TRACK
- ASPHALT SLOPE PAVING
- CRUSHER FINES
- TURF GRASS FIELD
- PROPOSED CONCRETE
- PROPOSED CONSTRUCTION ENTRANCE

NOTE:
- CONTRACTOR MITIGATING DUST VIA WATER TRUCK THROUGHOUT CONSTRUCTION
- CONTRACTOR MITIGATING DUST VIA IRRIGATION SYSTEM PRIOR TO SOD INSTALLATION
- BMP'S MAINTAINED WHEN NECESSARY

RECORD DRAWING LEGEND

CONSTRUCT	RECORD INFORMATION (VERIFIED BY ENGINEER)
✓	AS-CONSTRUCTED = AS-DESIGNED (VERIFIED BY ENGINEER)
38.42'	RECORD INFORMATION (VERIFIED BY ENGINEER)
+25.2	RECORD INFORMATION (VERIFIED BY ENGINEER)
@ 28.98.42	RECORD INFORMATION (VERIFIED BY ENGINEER)
✓°	AS-CONSTRUCTED = AS-DESIGNED (VERIFIED BY AS-BUILT SURVEY)
31.8	RECORD INFORMATION FROM AS-BUILT SURVEY
+ 26.9	RECORD INFORMATION FROM AS-BUILT SURVEY
@ 31.28.22	RECORD INFORMATION FROM AS-BUILT SURVEY

RECORD DRAWING
FOR CERTIFICATION, SEE SHEET 1

07-09-2014
REGISTERED PROFESSIONAL ENGINEER
JEFFREY G. MORTENSEN
NEW MEXICO
8547
05-23-2013
07-31-2013

NOTE:
THIS IS NOT A BOUNDARY SURVEY; DATA IS SHOWN FOR ORIENTATION ONLY. BOUNDARY DATA OBTAINED FROM LEASE SURVEY CONDUCTED BY HIGH MESA CONSULTING GROUP, NMPS NO. 11184, DATED 12-18-2012 TOPOGRAPHIC INFORMATION DEPICTED HEREON IS BASED UPON THE TOPOGRAPHIC AND UTILITY SURVEY PREPARED BY HIGH MESA CONSULTING GROUP, NMPS NO. 11184, DATED 12-18-2012 (2012.181.2).

HIGH MESA Consulting Group
6010-B MIDWAY PARK BLVD. NE • ALBUQUERQUE, NEW MEXICO 87109
PHONE: 505.345.4250 • FAX: 505.345.4254 • www.highmesacg.com

File Path:P:\DATA\2012.181.4\ENG\R3\ | Plot Date: 07-08-2014
File Name:121814_SH16_R3.DWG | Plot Time: 3:13 pm

PARENT DROP-OFF, TRACK AND FIELD EROSION AND SEDIMENT CONTROL PLAN
EAST CAMPUS IMPROVEMENTS
JEFFERSON MIDDLE SCHOOL

DESIGNED BY J.D.S.
DRAWN BY J.Y.R./E.J.S.
APPROVED BY J.G.M.

NO.	DATE	BY	REVISIONS
1	07/13	J.G.M.	REDUCE DROPOFF / PICKUP WIDTH TO 21' F-F, ADD CROSSWALK @ LOMAS
3	01/14	BEE	RECORD DRAWINGS & CERTIFICATION

JOB NO. 2012.181.4
DATE 05-2013
SHEET 16 OF 20