ASBUILT SURVEY
SHOWING
FLYING J TRAVEL PLAZA
POND GRADES AND SPILLWAY DETAILS
CITY OF ALBUQUERQUE, BERNALILLO COUNTY, NEW MEXICO

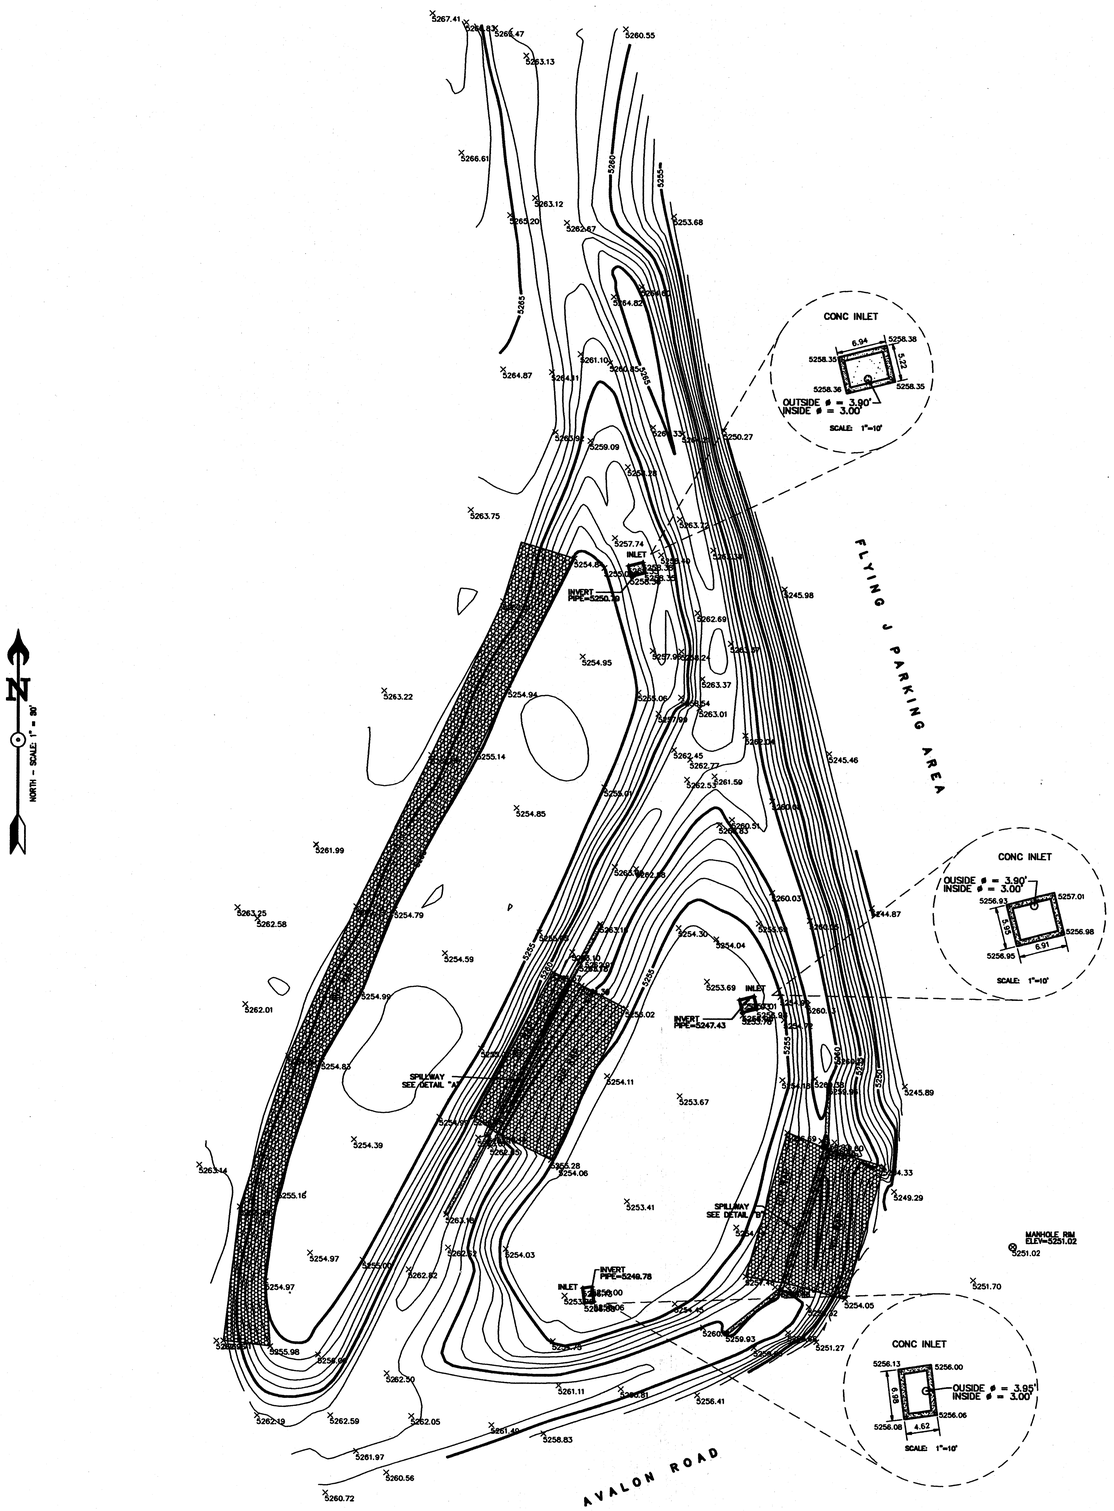

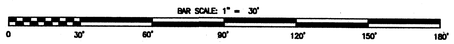

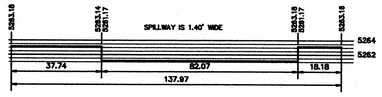

DETAIL "A" – SPILLWAY
HOR SCALE: 1"=30'
VERT SCALE: 1"=10'

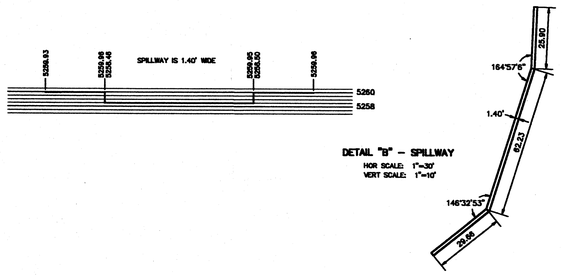

DETAIL "B" – SPILLWAY
HOR SCALE: 1"=30'
VERT SCALE: 1"=10'

RECEIVED
APR 26 2000
HYDROLOGY SECTION

RECEIVED
APR 26 2000
HYDROLOGY SECTION

2/22/00

GARY L. MARKS
NEW MEXICO
7436
REGISTERED LAND SURVEYOR

FIELD SURVEY AND PLATTING BY:
2112 MAIN STREET, N.E. – SUITE A
LOS LUNAS, NEW MEXICO 87031
SURVEYED: JANUARY, 2000

R2H AND ASSOCIATES, INC.
PHONE: (505) 865-6019
FAX: (505) 865-0237
DRAWING NO. 99-199