


THIS DOCUMENT, TOGETHER WITH THE CONCEPTS AND DESIGNS PRESENTED HEREIN, IS INTENDED ONLY FOR THE SPECIFIC PURPOSE AND CLIENT FOR WHICH IT WAS PREPARED. REVIEW OF AND IMPROPER RELIANCE ON THIS DOCUMENT WITHOUT WRITTEN AUTHORIZATION AND ADAPTATION BY KIMLEY-HORN AND ASSOCIATES, INC. SHALL BE WITHOUT LIABILITY TO KIMLEY-HORN AND ASSOCIATES, INC.

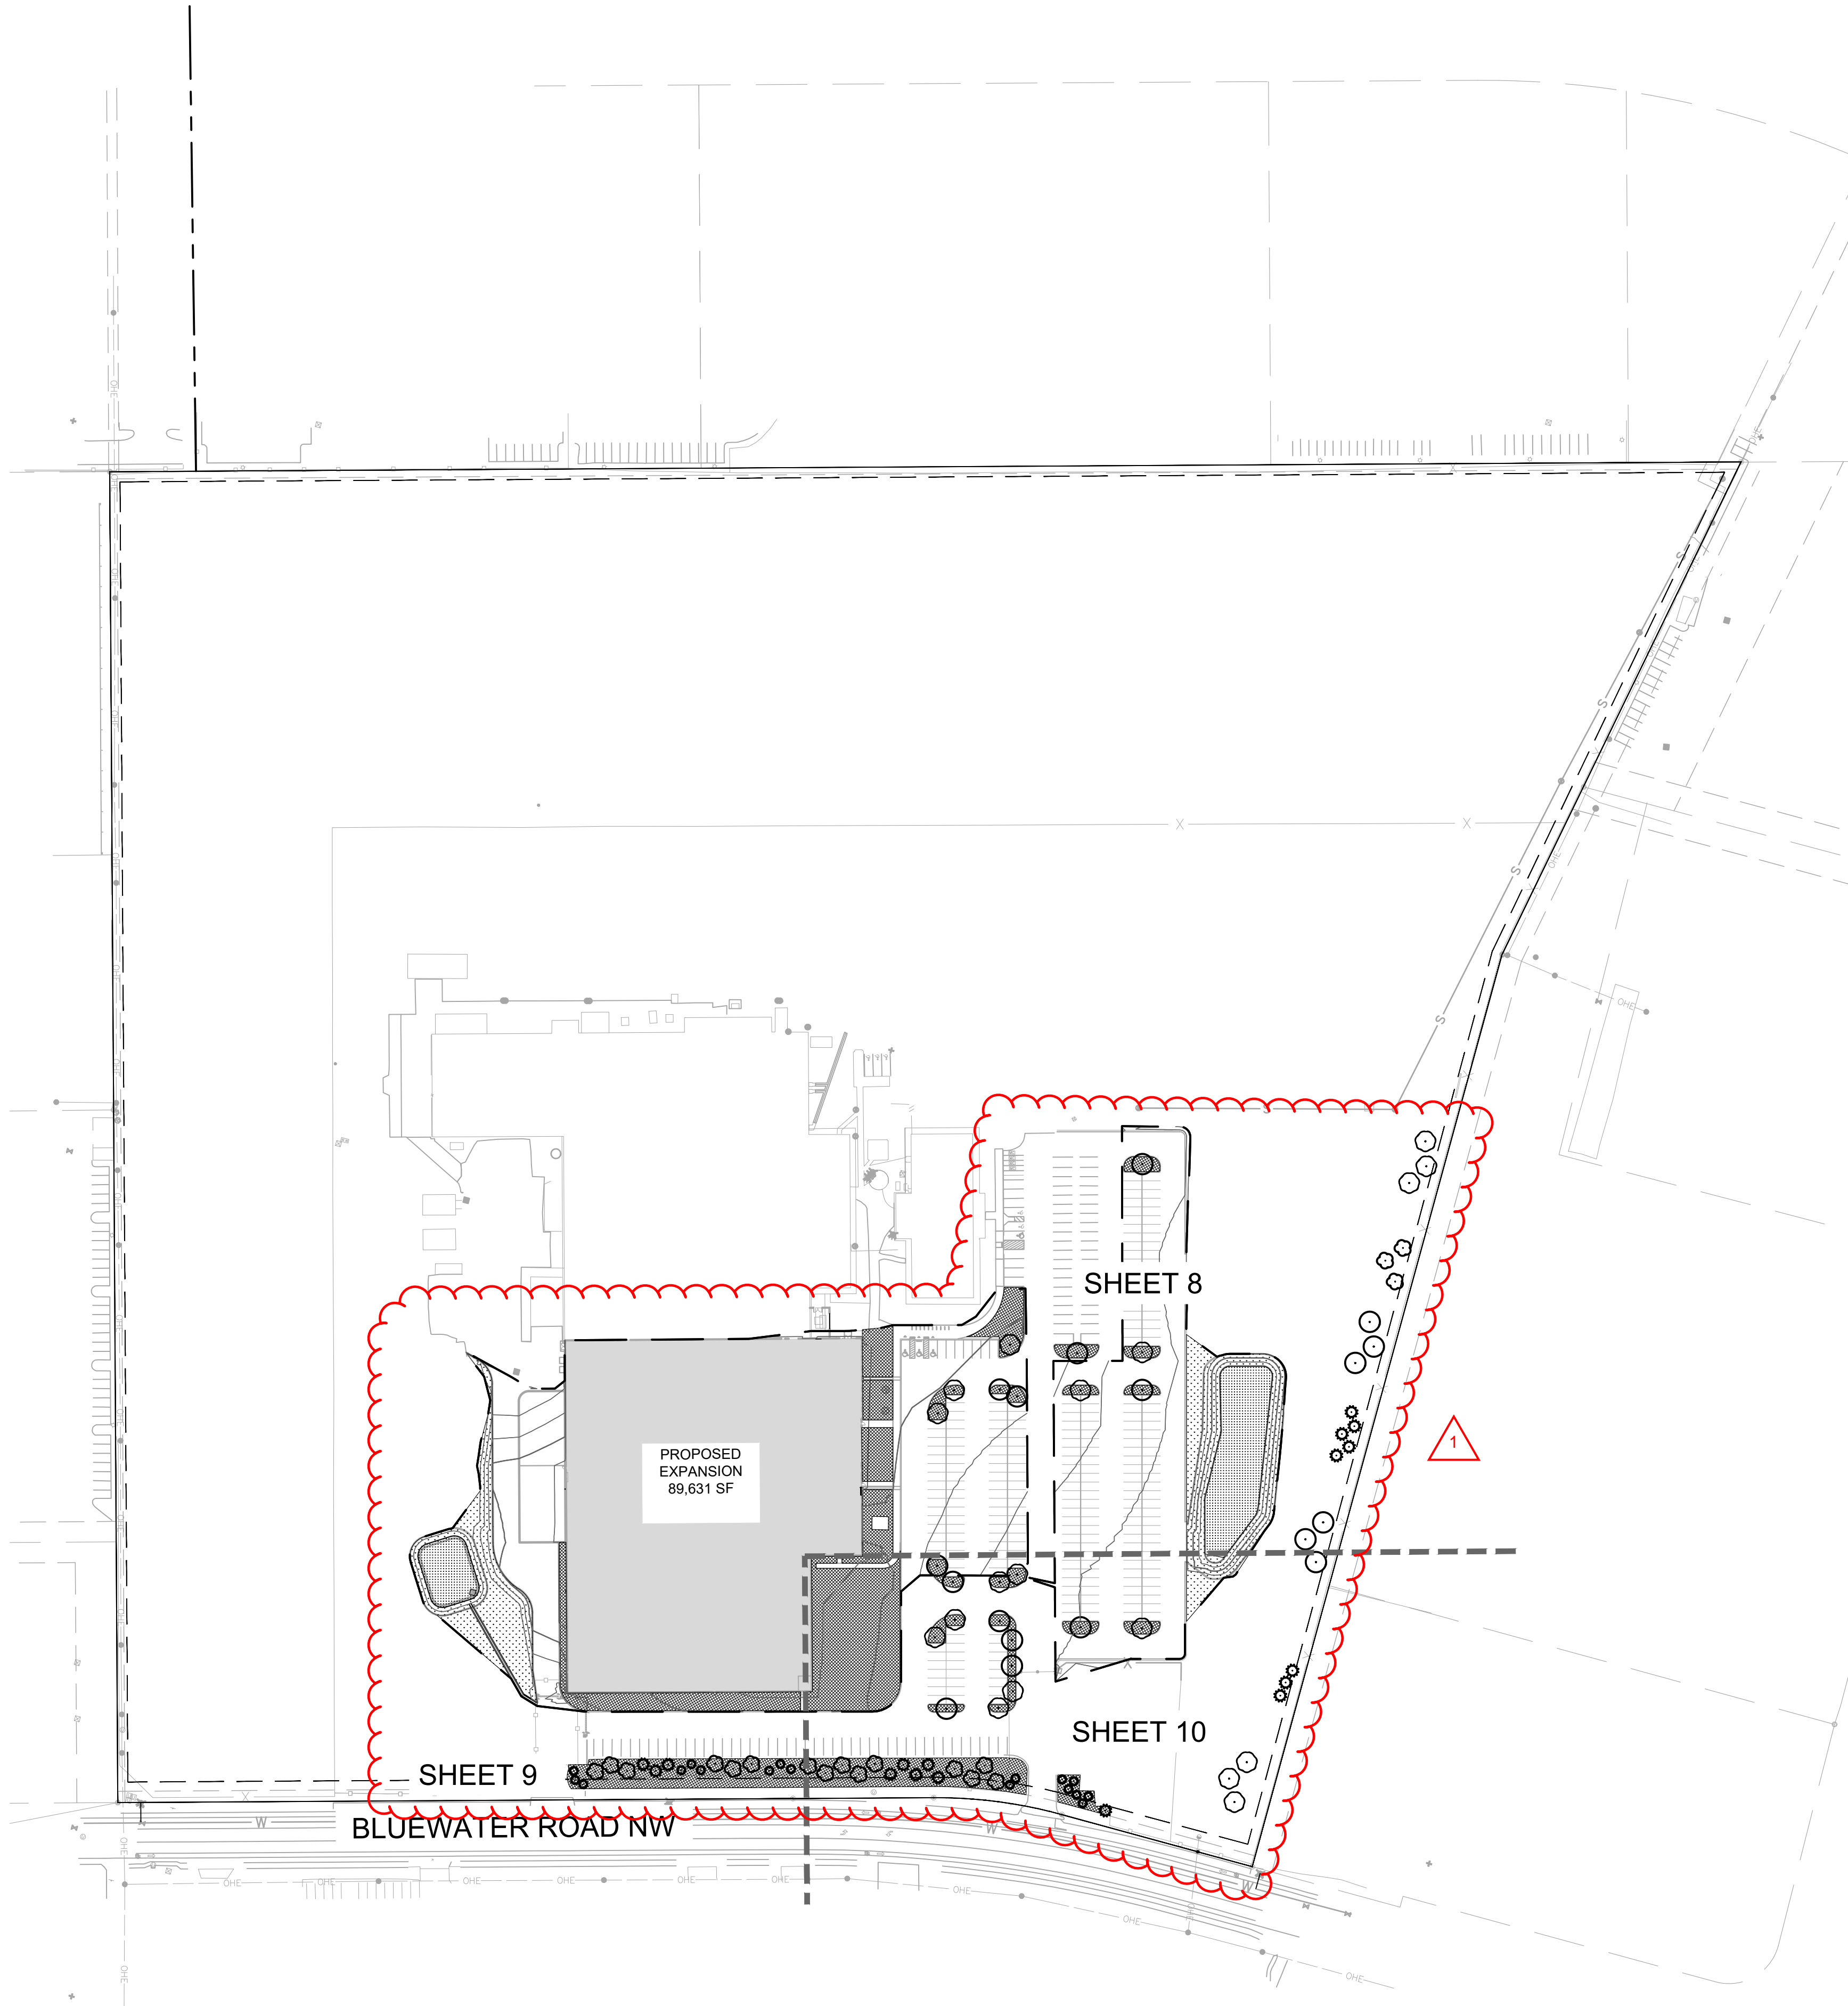

1

MAJOR AMENDMENT TO GOVERNING SITE PLAN DRB-95-146 (OCT 4, 2023).  
ADDITIONAL LANDSCAPE ADDITIONS TO NEW LANDSCAPE ISLANDS, NEW  
LANDSCAPE AROUND BUILDING EXPANSION, ALONG EASTERN AND  
SOUTHERN PROPERTY LINES

### PLANT SCHEDULE LANDSCAPE AREA


DECIDUOUS TREES	CODE	BOTANICAL NAME	COMMON NAME
	CO	CELTIS OCCIDENTALIS	COMMON HACKBERRY
	GS	GLEDITSIA TRIACANTHOS INERMIS 'SHADEMASTER'	SHADEMASTER HONEY LOCUST
	SD	SAPINDUS DRUMMONDII	WESTERN SOAPBERRY
EVERGREEN TREES	CODE	BOTANICAL NAME	COMMON NAME
	JS	JUNIPERUS MONOSPERMA	ONESEED JUNIPER
	PN	PINUS NIGRA	AUSTRIAN PINE
GROUND COVERS	CODE	BOTANICAL NAME	COMMON NAME
	RM	1-1/2" - 2" RIVER ROCK MULCH	1-1/2" - 2" RIVER ROCK MULCH
	XA	APPLEWOOD SEED MIX	DETENTION SEED MIX
	XL	NATIVE SEED MIX	NATIVE SEED MIX

SEE SHEET 12 FOR COMPLETE PLANT SCHEDULE

### EXISTING GOVERNING SITE PLAN PLANTING SCHEDULE

		spacing	mature size		emitters (number & size)	
			height	spread	young	mature
A	ARIZONA SYCAMORE (Platanus wrightii)		40'-80'	30'-60'	(3) 2 gal.	(6) 2 gal.
B	HONEY LOCUST (Gleditsia triacanthos)		50'	30'-40'	(3) 2 gal.	(6) 2 gal.
C	LIMBER PINE (Pinus flexilis)		25'	15'	(3) 2 gal.	(4) 2 gal.
D	RUSSIAN OLIVE (Elaeagnus angustifolia)		25'	15'	(3) 2 gal.	(4) 2 gal.
E	DESERT WILLOW (Chilopsis linearis)		25'	15'	(3) 2 gal.	(4) 2 gal.
F	CHAMISA (Chrysothamnus nauseosus)	5'	5'	5'	(1) 1/2 gal.	(1) 1/2 gal.
G	THREE-LEAF SUMAC (Rhus trilobata)	4'	4'	4'	(1) 1 gal.	(1) 1 gal.
H	RED BARBERRY (Berberis thunbergii 'Atropurpurea')	3'	4'	4'	(1) 1 gal.	(1) 1 gal.
I	JUNIPER, CALGARY CARPET (Juniperus sabiniana 'Calgary Carpet')	7'	9'	10'	(1) 1 gal.	(1) 1 gal.
J	HALLS HONEYSUCKLE (Lonicera japonica 'halliana')	8'	1'-3'	12'	(1) 1 gal.	(1) 1 gal.

MINIMUM PLANT SIZES: TREES - 2" caliper or 10'-12', SHRUBS AND VINES - 5 gal.  
GRAVEL: 3/4" crushed gravel, 2" deep, Santa Fe brown  
FILTER FABRIC: DuPont "Tyfon" spunbonded polypropylene  
IRRIGATION SYSTEM: Landscape Contractor shall submit a drip irrigation plan for approval by Architect. Include electric valves and electronic timer. Provide necessary connections to existing water and electric.  
All plants and irrigation system shall be guaranteed for (1) year. Any plants not surviving (1) year shall be replaced at Contractors expense.

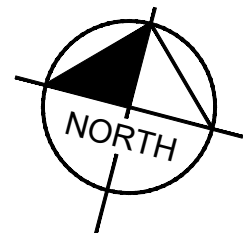

GRAPHIC SCALE IN FEET  
0 50 100 200

Kimley»Horn

©2023 KIMLEY-HORN AND ASSOCIATES, INC.  
6200 South Syracuse Way, Suite 300  
Greenwood Village, Colorado 80111 (303) 228-2300

DESIGNED BY: ECS  
DRAWN BY: ECS  
CHECKED BY: EIWS  
DATE: 10/3/2023

LEGAL DESCRIPTION:  
TRACT A ATRISCO BUSINESS  
PARK UNIT 1 CONTAINING  
39.775 ACRES

ABB ABQ ADDITION  
6625 BLUEWATER ROAD NW  
MAJOR AMENDMENT  
OVERALL LANDSCAPE PLAN

PRELIMINARY  
FOR REVIEW ONLY  
NOT FOR  
CONSTRUCTION  
Kimley»Horn  
Kimley-Horn and Associates, Inc.

PROJECT NO.  
096523009

SHEET

7

NO. REVISION BY DATE APPR



EXISTING BUILDING

EXISTING BUILDING

REPAIR UP TO LIMIT OF DISTURBANCE (TYP.)

REPAIR UP TO LIMIT OF DISTURBANCE (TYP.)

PROPERTY LINE (TYP.)

APPROXIMATE LIMITS OF DISTURBANCE. CONTRACTOR TO PROVIDE NATIVE SEED IN ALL AREAS DISTURBED DUE TO CONSTRUCTION (TYP.)



 
NATIVE SEED MIX (TYP.)


DETENTION SEED MIX (TYP.)

MATCHLINE: SEE SHEET 9





 

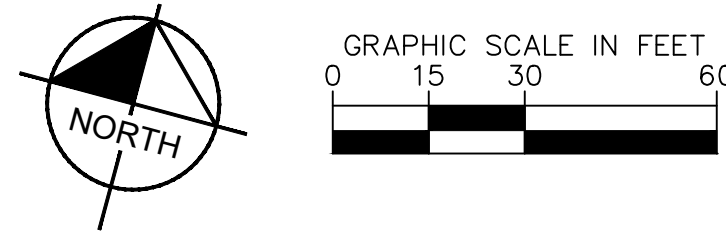











MATCHLINE: SEE SHEET 10



<u>GROUND COVERS</u>	<u>CODE</u>	<u>BOTANICAL NAME</u>	<u>COMMON NAME</u>
	RM	1-1/2" - 2" RIVER ROCK MULCH	1-1/2" - 2" RIVER ROCK MULCH
	XA	APPLEWOOD SEED MIX	DETENTION SEED MIX
	XL	NATIVE SEED MIX	NATIVE SEED MIX



- CONSTRUCTION BID NOTES:**
1. ALL CONDITIONS IN THE PLANT SCHEDULE SHALL BE CONSIDERED THE MINIMUM ALLOWABLE SPECIFICATIONS. CONTRACTOR SHALL PROCURE PLANT MATERIALS AND UPSIZE AS NECESSARY TO MEET THE MOST STRINGENT SPECIFICATION.
  2. LANDSCAPE ARCHITECT RESERVES THE RIGHT TO FIELD ADJUST ALL PLANT MATERIAL.
  3. ALL QUANTITIES PROVIDED FOR CONVENIENCE ONLY. CONTRACTOR SHALL CONFIRM ALL QUANTITIES FROM PLAN PRIOR TO BIDDING AND CONSTRUCTION. PLANS TAKE PRECEDENT OVER PLANT SCHEDULE FOR PLANT QUANTITY COUNT.
- LANDSCAPE NOTES:**
1. TREES CHANGES AND GROUND-LEVEL PLANS SHALL COVER A MINIMUM OF 75 PERCENT OF THE TOTAL LANDSCAPE AREA AS MEASURED BY CANOPY WIDTH OR THE AREA BENEATH THE DRUPLINE OF THE MATURED SIZE OF THE ACTUAL VEGETATION.
  2. NO MORE THAN 10 PERCENT OF REQUIRED LANDSCAPE AREAS SHALL BE TURF GRASS SPECIES REQUIRING IRRIGATION FOR SURVIVAL AFTER THE FIRST 2 GROWING SEASONS.
  3. THE USE OF GRASS OR CRUSHER FINES AS GROUND COVER IS LIMITED TO A MAXIMUM OF 75 PERCENT OF ANY LANDSCAPED AREA.
  4. VEGETATION REQUIRED BY THIS SECTION 14-16-5-6 SHALL BE LOCATED AT LEAST 3 FEET IN ANY DIRECTION FROM ANY FIRE HYDRANTS, VALVE VAULTS, HOSES BIBS, MANHOLES, HYDRANTS, AND FIRE DEPARTMENT CONNECTIONS.
  5. TREES SHALL NOT BE PLANTED WITHIN 10 FEET IN ANY DIRECTION OF THE CENTERLINE OF A SEWER OR WATER LINE.
  6. IRRIGATION WILL BE PROPOSED FOR THIS SITE AT THE CD PLAN LEVEL.

<div> <div>  </div> <div> <p><b>ABB ABQ ADDITION</b> 6625 BLUEWATER ROAD NW MAJOR AMENDMENT DETAILED LANDSCAPE PLAN</p> </div> </div>	<div> <div>  </div> <div> <p><b>Kimley-Horn</b></p> </div> </div>		<div> <div>  </div> <div> <p><b>LEGAL DESCRIPTION:</b> TRACT 4, ATRISCO BUSINESS PARK, UNITS 1-5 39.775 ACRES</p> </div> </div>		<div> <div>  </div> <div> <p><b>DESIGNED BY:</b> ECS <b>DRAWN BY:</b> ECS <b>CHECKED BY:</b> EWS <b>DATE:</b> 10/3/2023</p> </div> </div>		<div> <div>  </div> <div> <p><b>Kimley»»Horn</b></p> </div> </div>		<div> <div>  </div> <div> <p>© 2023 KIMLEY-HORN AND ASSOCIATES, INC. 6200 South Syracuse Way, Suite 300 Greenwood Village, Colorado 80111 (303) 228-2300</p> </div> </div>		<div> <div>  </div> <div> <p><b>NO.</b></p> </div> </div>		<div> <div>  </div> <div> <p><b>REVISION</b></p> </div> </div>		<div> <div>  </div> <div> <p><b>BY</b></p> </div> </div>		<div> <div>  </div> <div> <p><b>DATE</b></p> </div> </div>		<div> <div>  </div> <div> <p><b>APPR</b></p> </div> </div>	
	<div> <div>  </div> <div> <p><b>PRELIMINARY</b></p> </div> </div>		<div> <div>  </div> <div> <p>FOR REVIEW ONLY NOT FOR CONSTRUCTION</p> </div> </div>		<div> <div>  </div> <div> <p><b>Kimley»»Horn</b></p> </div> </div>		<div> <div>  </div> <div> <p>Kimley-Horn and Associates, Inc.</p> </div> </div>		<div> <div>  </div> <div> <p><b>PROJECT NO.</b> 096523009</p> </div> </div>		<div> <div>  </div> <div> <p><b>SHEET</b></p> </div> </div>		<div> <div>  </div> <div> <p><b>8</b></p> </div> </div>							



PROPERTY LINE (TYP.)

EXISTING LANDSCAPE TO REMAIN (TYP.)

1

DETENTION SEED MIX (TYP.)


NATIVE SEED MIX (TYP.)

APPROXIMATE LIMITS OF DISTURBANCE. CONTRACTOR TO PROVIDE NATIVE SEED IN ALL AREAS DISTURBED DUE TO CONSTRUCTION (TYP.)




APPROXIMATE LIMITS OF DISTURBANCE. CONTRACTOR TO PROVIDE NATIVE SEED IN ALL AREAS DISTURBED DUE TO CONSTRUCTION (TYP.)


PROPERTY LINE (TYP.)

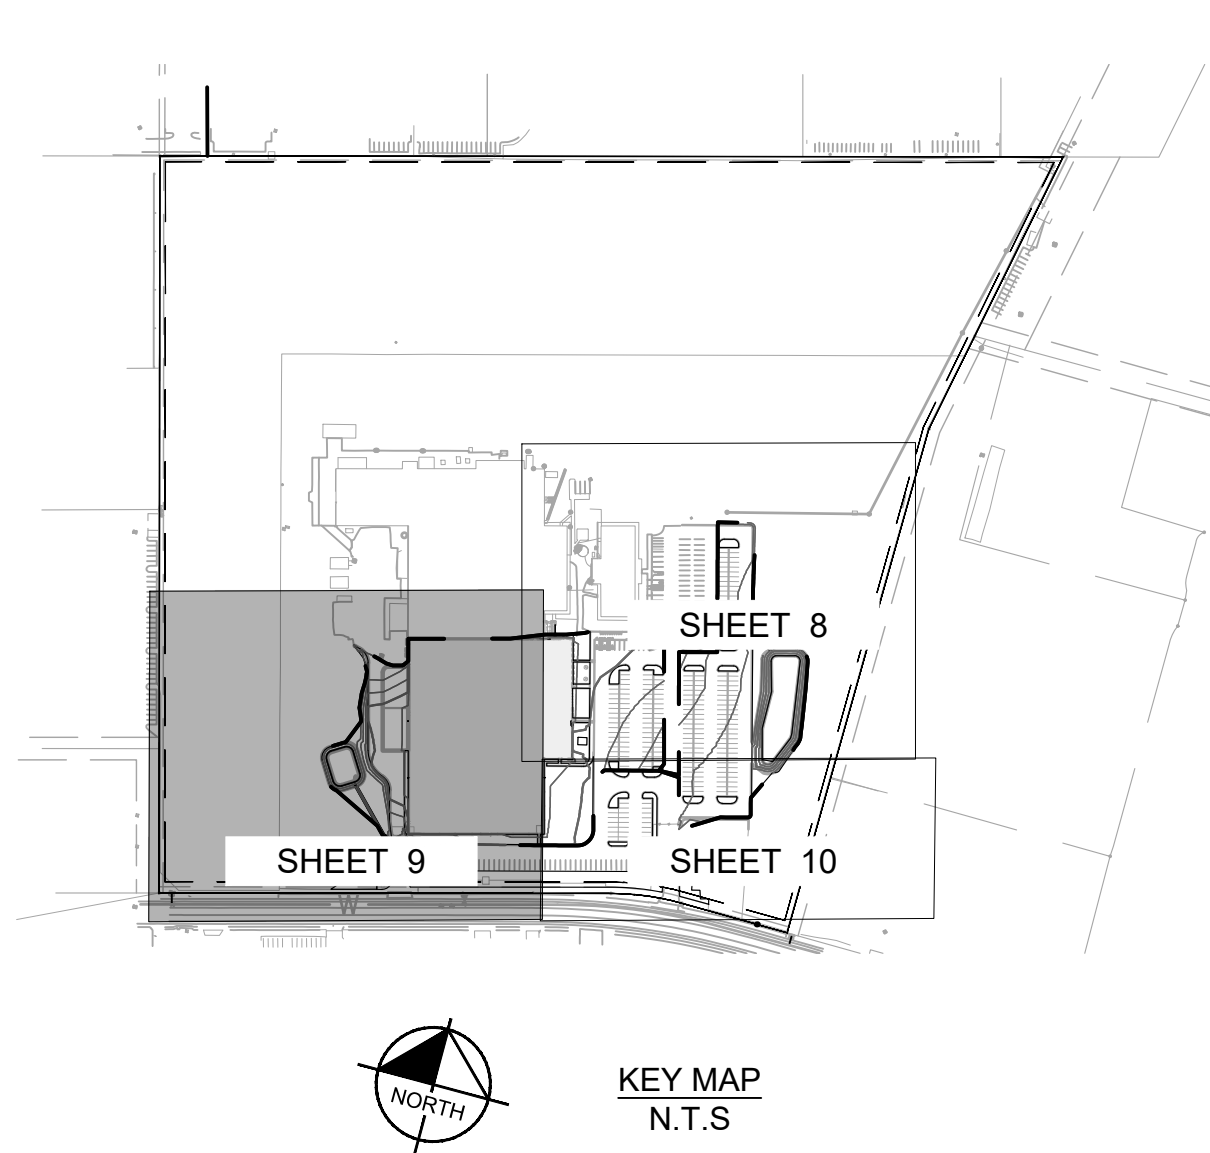BLUEWATER ROAD NW

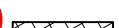

**MAJOR AMENDMENT TO GOVERNING SITE PLAN DRB-95-146 (OCT 4, 2023).  
ADDITIONAL LANDSCAPE ADDITIONS TO NEW LANDSCAPE ISLANDS, NEW  
LANDSCAPE AROUND BUILDING EXPANSION, ALONG EASTERN AND  
SOUTHERN PROPERTY LINES**

<u>GROUND COVERS</u>	<u>CODE</u>	<u>BOTANICAL NAME</u>	<u>COMMON NAME</u>
	RM	1-1/2" - 2" RIVER ROCK MULCH	1-1/2" - 2" RIVER ROCK MULCH
	XA	APPLEWOOD SEED MIX	DETENTION SEED MIX
	XL	NATIVE SEED MIX	NATIVE SEED MIX

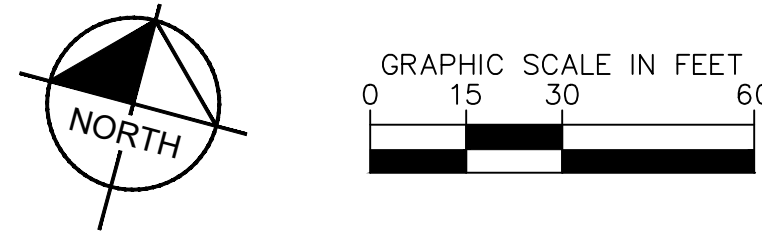

- CONSTRUCTION BID NOTES:**
1. ALL PLANT SPECIFICATIONS IN THE PLANT SCHEDULE SHALL BE CONSIDERED THE MINIMUM ALLOWABLE SPECIFICATIONS. CONTRACTOR SHALL ACQUIRE PLANT MATERIALS AND UPSIZE AS NECESSARY TO MEET THE MOST STRINGENT SPECIFICATION.
  2. LANDSCAPE ARCHITECT RESERVES THE RIGHT TO FIELD ADJUST ALL PLANT MATERIAL.
  3. ALL QUANTITIES PROVIDED FOR CONVENIENCE ONLY. CONTRACTOR SHALL CONFIRM ALL QUANTITIES PER PLAN PRIOR TO BIDDING AND CONSTRUCTION. PLANS TAKE PRECEDENT OVER PLANT SCHEDULE FOR PLANT QUANTITY COUNT.
- LANDSCAPE NOTES:**
1. TREE CANOPIES AND GROUND-LEVEL PLANS SHALL COVER A MINIMUM OF 75 PERCENT OF THE TOTAL LANDSCAPE AREA AS MEASURED BY CANOPY WIDTH OR THE AREA BENEATH THE DRIFLINE OF THE MATURE SIZE OF THE ACTUAL VEGETATION.
  2. NO MORE THAN 10 PERCENT OF REQUIRED LANDSCAPE AREAS SHALL BE TURF GRASS SPECIES REQUIRING IRRIGATION FOR SURVIVAL AFTER THE FIRST 2 GROWING SEASONS.
  3. THE USE OF GRAVEL OR CRUSHER FINES AS GROUND COVER IS LIMITED TO A MAXIMUM OF 75 PERCENT OF ANY UNDESIGNED AREA.
  4. VEGETATION REQUIRED BY THIS SECTION 14-16-54 SHALL BE LOCATED AT LEAST 3 FEET IN ANY DIRECTION FROM ANY FIRE HYDRANTS, VALVE VAULTS, HOSE BIBS, MANHOLES, HYDRANTS, AND FIRE DEPARTMENT CONNECTIONS.
  5. TREES SHALL NOT BE PLANTED WITHIN 10 FEET IN ANY DIRECTION OF THE CENTERLINE OF A SEWER OR WATER LINE.
  6. IRRIGATION WILL BE PROPOSED FOR THIS SITE AT THE CD PLAN LEVEL.

[illegible]



MATCHLINE, SEE SHEET 9

MATCHLINE, SEE SHEET 8

REPAIR UP TO LIMIT OF DISTURBANCE (TYP.)

21'-0" UTILITY EASEMENT


BLUEWATER ROAD NW

PROPERTY LINE (TYP.)

1



SEE SHEET 12 FOR COMPLETE PLANT SCHEDULE

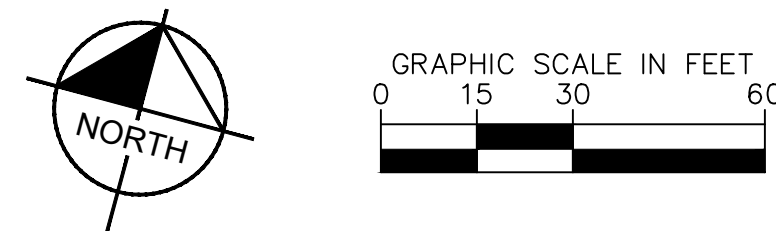

### CONSTRUCTION BID NOTES

1. ALL PLANT SPECIFICATIONS IN THE PLANT SCHEDULE SHALL BE CONSIDERED THE MINIMUM ALLOWABLE SPECIFICATIONS. CONTRACTOR SHALL PROCURE PLANT MATERIALS AND UPSIZE AS NECESSARY TO MEET THE MOST STRINGENT SPECIFICATION.
2. LANDSCAPE ARCHITECT RESERVES THE RIGHT TO FIELD ADJUST ALL PLANT MATERIAL.
3. ALL QUANTITIES PROVIDED FOR CONVENIENCE ONLY. CONTRACTOR SHALL CONFIRM ALL QUANTITIES PER PLAN PRIOR TO BIDDING AND CONSTRUCTION. PLANS TAKE PRECEDENT OVER PLANT SCHEDULE FOR PLANT QUANTITY COUNT.

## LANDSCAPE NOTES:

1. TREE CANOPIES AND GROUND-LEVEL PLANS SHALL COVER A MINIMUM OF 75 PERCENT OF THE TOTAL LANDSCAPE AREA AS MEASURED BY CANOPY WIDTH OR THE AREA BENEATH THE DRIPLINE OF THE MATURE SIZE OF THE ACTUAL VEGETATION.
2. NO MORE THAN 10 PERCENT OF REQUIRED LANDSCAPE AREAS SHALL BE TURF GRASS SPECIES REQUIRED FOR IRRIGATION FOR SURVIVAL AFTER THE FIRST 2 GROWING SEASONS.
3. THE USE OF GRAVEL OR CRUSHER FINES AS GROUND COVER IS LIMITED TO A MAXIMUM OF 75 PERCENT OF ANY LANDSCAPED AREA.
4. VEGETATION REQUIRED BY THIS SECTION 14-16-54 SHALL BE LOCATED AT LEAST 3 FEET IN ANY DIRECTION FROM ANY FIRE HYDRANTS, VALVE VAULTS, HOSE BIBS, MANHOLES, HYDRANTS, AND FIRE DEPARTMENT CONNECTIONS.
5. TREES SHALL NOT BE PLANTED WITHIN 10 FEET IN ANY DIRECTION OF A SEWER OR WATER LINE.
6. IRRIGATION WILL BE PROPOSED FOR THIS SITE AT THE CD PLAN LEVEL.

# Kimley»»Horn

© 2023 KIMLEY-HORN AND ASSOCIATES, INC.  
6200 South Syracuse Way, Suite 300  
Greenwood Village, Colorado 80111 (303) 228-2300

DESIGNED BY: ECS  
DRAWN BY: ECS  
CHECKED BY: EIWS  
DATE: 10/3/2023

**LEGAL DESCRIPTION:**  
TRACT A ATRISCO BUSINESS  
PARK UNIT 1 CONTAINING  
39.775 ACRES

**ABB ABQ ADDITION**  
6625 BLUEWATER ROAD NW  
**MAJOR AMENDMENT**  
**DETAILED LANDSCAPE PLAN**

**PRELIMINARY**  
FOR REVIEW ONLY  
NOT FOR  
CONSTRUCTION  
**Kimley»Horn**  
Kimley-Horn and Associates, Inc.

PROJECT NO.  
096523009

SHEET

10



THIS DOCUMENT, TOGETHER WITH THE CONCEPTS AND DESIGNS PRESENTED HEREIN, IS AN INSTRUMENT OF SERVICE. IT IS INTENDED ONLY FOR THE SPECIFIC PURPOSE AND CLIENT FOR WHICH IT WAS PREPARED. REVIEW OF, AND MODIFIED RELIANCE ON, THIS DOCUMENT WITHOUT WRITTEN AUTHORIZATION AND ADAPTATION BY KIMLEY-HORN AND ASSOCIATES, INC. SHALL BE WITHOUT LIABILITY TO KIMLEY-HORN AND ASSOCIATES, INC.

## GENERAL LANDSCAPE SPECIFICATIONS

### A. SCOPE OF WORK

- THE WORK CONSISTS OF: FURNISHING ALL LABOR, MATERIALS, EQUIPMENT, TOOLS, TRANSPORTATION, AND ANY OTHER APPURTENANCES NECESSARY FOR THE COMPLETION OF THIS PROJECT AS SHOWN ON THE DRAWINGS AND AS SPECIFIED HEREIN.
- WORK SHALL INCLUDE MAINTENANCE AND WATERING OF ALL CONTRACT PLANTING AREAS UNTIL CERTIFICATION OF ACCEPTANCE BY THE OWNER.

### B. PROTECTION OF EXISTING STRUCTURES

- ALL EXISTING BUILDINGS, WALKS, WALLS, PAVING, PIPING, OTHER SITE CONSTRUCTION ITEMS, AND PLANTING ALREADY COMPLETED OR ESTABLISHED AND DESIGNATED TO REMAIN SHALL BE PROTECTED FROM DAMAGE BY THE CONTRACTOR UNLESS OTHERWISE SPECIFIED. ALL DAMAGE RESULTING FROM NEGLIGENCE SHALL BE REPAIRED OR REPLACED TO THE SATISFACTION OF THE OWNER, AT NO COST TO THE OWNER.
- THE CONTRACTOR SHALL BE RESPONSIBLE FOR MAINTAINING ALL NECESSARY BEST MANAGEMENT PRACTICES (BMP) DEVICES ACCORDING TO ALL REGULATORY AGENCY'S STANDARDS THROUGH THE DURATION OF ALL CONSTRUCTION ACTIVITIES.
- THE CONTRACTOR SHALL BE RESPONSIBLE FOR ANY MAINTENANCE OF TRAFFIC (MOT) THAT MAY BE REQUIRED FOR THE PROJECT.
- THE CONTRACTOR SHALL BE RESPONSIBLE FOR LOCATING ALL UTILITIES, WHETHER PUBLIC OR PRIVATE, PRIOR TO EXCAVATION. THE OWNER AND DESIGN PROFESSIONAL SHALL NOT BE RESPONSIBLE FOR THE ACCURACY AND COMPLETENESS OF ANY SUCH INFORMATION OR DATA. THE CONTRACTOR SHALL HAVE FULL RESPONSIBILITY FOR: REVIEWING AND CHECKING ALL SUCH INFORMATION AND DATA; LOCATING ALL UNDERGROUND FACILITIES DURING CONSTRUCTION; THE SAFETY AND PROTECTION THEREOF; REPAIRING ANY DAMAGE THERETO RESULTING FROM THE WORK. THE COST OF ALL WILL BE CONSIDERED AS HAVING BEEN INCLUDED IN THE CONTRACT PRICE. THE CONTRACTOR SHALL NOTIFY ANY AFFECTED UTILITY COMPANIES OR AGENCIES IN WRITING AT LEAST 48 HOURS PRIOR TO BEGINNING CONSTRUCTION.

### C. PROTECTION OF EXISTING PLANT MATERIALS

- THE CONTRACTOR SHALL BE RESPONSIBLE FOR ALL UNAUTHORIZED CUTTING OR DAMAGE TO TREES AND SHRUBS EXISTING OR OTHERWISE CAUSED BY CARELESS EQUIPMENT OPERATION, MATERIAL STOCKPILING, ETC.. THIS SHALL INCLUDE COMPACTION BY DRIVING OR PARKING INSIDE THE DRIP-LINE AND SPILLING OIL, GASOLINE, OR OTHER DELETERIOUS MATERIALS WITHIN THE DRIP-LINE. NO MATERIALS SHALL BE BURNED ON SITE. EXISTING TREES KILLED OR DAMAGED SO THAT THEY ARE MISSHAPEN AND/OR UNSIGHTLY SHALL BE REPLACED AT THE COST TO THE CONTRACTOR OF FOUR HUNDRED DOLLARS (\$400) PER CALIPER INCH ON AN ESCALATING SCALE WHICH ADDS AN ADDITIONAL TWENTY (20) PERCENT PER INCH OVER FOUR (4) INCHES CALIPER AS FIXED AND AGREED LIQUIDATED DAMAGES. CALIPER SHALL BE MEASURED SIX (6) INCHES ABOVE GROUND LEVEL FOR TREES UP TO AND INCLUDING FOUR (4) INCHES IN CALIPER AND TWELVE (12) INCHES ABOVE GROUND LEVEL FOR TREES OVER FOUR (4) INCHES IN CALIPER.
- SEE TREE MITIGATION PLAN AND NOTES, IF APPLICABLE.

### D. MATERIALS

#### 1. GENERAL

MATERIAL SAMPLES LISTED BELOW SHALL BE SUBMITTED FOR APPROVAL, ON SITE OR AS DETERMINED BY THE OWNER, UPON APPROVAL, DELIVERY OF MATERIALS MAY COMMENCE.

MATERIAL	SAMPLE SIZE
MULCH	ONE (1) CUBIC FOOT
TOPSOIL MIX	ONE (1) CUBIC FOOT
PLANTS	ONE (1) OF EACH VARIETY (OR TAGGED IN NURSERY)

#### 2. PLANT MATERIALS

a. FURNISH NURSERY-GROWN PLANTS TRUE TO GENUS, SPECIES, VARIETY, CULTIVAR, STEM FORM, SHEARING, AND OTHER FEATURES INDICATED IN PLANT SCHEDULE SHOWN ON DRAWINGS AND COMPLYING WITH ANSI Z60.1 AND WITH HEALTHY ROOT SYSTEMS DEVELOPED BY TOP PLANTING OR ROOT PRUNING. PROVIDE WELL-SHAPED, FULLY BRANCHED, HEALTHY, VIGOROUS STOCK, DENSELY FOLIATED WHEN IN LEAF AND FREE OF DISEASE, PESTS, EGGS, LARVAE, AND DEFECTS SUCH AS KNOTS, SUN SCALD, INJURIES, ABRASIONS, AND DISFIGUREMENT.

#### b. TREES FOR PLANTING IN ROWS SHALL BE UNIFORM IN SIZE AND SHAPE.

c. NO SUBSTITUTIONS SHALL BE MADE WITHOUT WRITTEN PERMISSION FROM THE PROJECT LANDSCAPE ARCHITECT. ANY ROW TREES MUST BE APPROVED BY OFFICE OF THE CITY FORESTER.

d. PROVIDE PLANTS OF SIZES, GRADES, AND BALL OR CONTAINER SIZES COMPLYING WITH ANSI Z60.1 FOR TYPES AND FORM OF PLANTS REQUIRED. PLANTS OF A LARGER SIZE MAY BE USED IF ACCEPTABLE TO PROJECT LANDSCAPE ARCHITECT WITH A PROPORTIONATE INCREASE IN SIZE OF ROOTS OR BALLS.

e. PLANTS SHALL BE SUBJECT TO INSPECTION AND APPROVAL AT THE PLACE OF GROWTH, OR UPON DELIVERY TO THE SITE, AS DETERMINED BY THE OWNER, FOR QUALITY, SIZE, AND VARIETY. SUCH APPROVAL SHALL NOT IMPAIR THE RIGHT OF INSPECTION AND REJECTION AT THE SITE DURING PROGRESS OF THE WORK OR AFTER COMPLETION FOR SIZE AND CONDITION OF ROOT BALLS OR ROOTS, LATENT DEFECTS OR INJURIES. REJECTED PLANTS SHALL BE REMOVED IMMEDIATELY FROM THE SITE. NOTICE REQUESTING INSPECTION SHALL BE SUBMITTED IN WRITING BY THE CONTRACTOR AT LEAST ONE (1) WEEK PRIOR TO ANTICIPATED DATE.

f. TREES WITH DAMAGED, CROOKED, OR MULTIPLE LEADERS; TIGHT VERTICAL BRANCHES WHERE BARK IS SQUEEZED BETWEEN TWO BRANCHES OR BETWEEN BRANCH AND TRUNK ("INCLUDED BARK"); CROSSING TRUNKS; CUT-OFF LIMBS MORE THAN  $\frac{1}{4}$  INCH (19 MM) IN DIAMETER; OR WITH STEM GIRDLING ROOTS WILL BE REJECTED.

g. FURNISH TREES AND SHRUBS WITH ROOTS BALLS MEASURED FROM TOP OF ROOT BALL, WHICH SHALL BEGIN AT ROOT FLARE ACCORDING TO ANSI Z60.1. ROOT FLARE SHALL BE VISIBLE BEFORE PLANTING.

h. LABEL AT LEAST ONE PLANT OF EACH VARIETY, SIZE, AND CALIPER WITH A SECURELY ATTACHED, WATERPROOF TAG BEARING LEGIBLE DESIGNATION OF COMMON NAME AND FULL SCIENTIFIC NAME, INCLUDING GENUS AND SPECIES, INCLUDE NOMENCLATURE FOR HYBRID, VARIETY, OR CULTIVAR, IF APPLICABLE FOR THE PLANT AS SHOWN ON DRAWINGS.

i. IF FORMAL ARRANGEMENTS OR CONSECUTIVE ORDER OF PLANTS IS SHOWN ON DRAWINGS, SELECT STOCK FOR UNIFORM HEIGHT AND SPREAD, AND NUMBER THE LABELS TO ASSURE SYMMETRY IN PLANTING.

### E. SOIL MIXTURE

#### 1. CONTRACTOR SHALL TEST EXISTING SOIL AND AMEND AS NECESSARY IN ACCORDANCE WITH THE GUIDELINES BELOW:

2. SOIL MIXTURE SHALL CONSIST OF TWO PARTS OF TOPSOIL AND ONE PART SAND, AS DESCRIBED BELOW. CONTRACTOR TO SUBMIT SAMPLES AND PH TESTING RESULTS FOR OWNER'S REPRESENTATIVE APPROVAL PRIOR TO PLANT INSTALLATION OPERATIONS COMMENCE.

a. TOPSOIL FOR USE IN PREPARING SOIL MIXTURE FOR BACKFILLING PLANT OPENINGS SHALL BE FERTILE, FRIABLE, AND OF A LOAMY CHARACTER, REASONABLY FREE OF SUBSOIL, CLAY LUMPS, BRUSH WEEDS, OR OTHER LITTER; FREE OF ROOTS, STUMPS, STONES LARGER THAN 2" IN ANY DIRECTION, AND OTHER EXTRANEIOUS OR TOXIC MATTER HARMFUL TO PLANT GROWTH. IT SHALL CONTAIN THREE (3) TO FIVE (5) PERCENT DECOMPOSED ORGANIC MATTER. HAVE A PH BETWEEN 5.5 AND 8.0, AND SOLUBLE SALTS LESS THAN 3.0 MMHOS/CM. SUBMIT SOIL SAMPLE AND PH TESTING RESULTS FOR APPROVAL.

b. SAND SHALL BE COARSE, CLEAN, WELL-DRAINING, NATIVE SAND.

3. TREES SHALL BE PLANTED IN THE EXISTING NATIVE SOIL ON SITE, UNLESS DETERMINED TO BE UNSUITABLE - AT WHICH POINT THE CONTRACTOR SHALL CONTACT THE PROJECT LANDSCAPE ARCHITECT TO DISCUSS ALTERNATE RECOMMENDATION PRIOR TO PLANTING.

### F. WATER

- WATER NECESSARY FOR PLANTING AND MAINTENANCE SHALL BE OF SATISFACTORY QUALITY TO SUSTAIN ADEQUATE PLANT GROWTH AND SHALL NOT CONTAIN HARMFUL, NATURAL OR MAN-MADE ELEMENTS DETRIMENTAL TO PLANTS. WATER MEETING THE ABOVE STANDARD SHALL BE OBTAINED ON THE SITE FROM THE OWNER, IF AVAILABLE, AND THE CONTRACTOR SHALL BE RESPONSIBLE TO MAKE ARRANGEMENTS FOR ITS USE BY HIS TANKS, HOSES, SPRINKLERS, ETC.... IF SUCH WATER IS NOT AVAILABLE AT THE SITE, THE CONTRACTOR SHALL PROVIDE SATISFACTORY WATER FROM SOURCES OFF THE SITE AT NO ADDITIONAL COST TO THE OWNER.

\* WATERING/IRRIGATION RESTRICTIONS MAY APPLY - REFER TO PROPERTY'S JURISDICTIONAL AUTHORITY.

### G. FERTILIZER

- CONTRACTOR SHALL PROVIDE FERTILIZER APPLICATION SCHEDULE TO OWNER, AS APPLICABLE TO SOIL TYPE, PLANT INSTALLATION TYPE, AND SITE'S PROPOSED USE. SUGGESTED FERTILIZER TYPES SHALL BE ORGANIC OR OTHERWISE NATURALLY-DERIVED.

\* FERTILIZER RESTRICTIONS MAY APPLY - REFER TO PROPERTY'S JURISDICTIONAL AUTHORITY.

### H. MULCH

- MULCH MATERIAL SHALL BE MOISTENED AT THE TIME OF APPLICATION TO PREVENT WIND DISPLACEMENT, AND APPLIED AT A DEPTH OF THREE (3) INCHES. CLEAR MULCH FROM EACH PLANT'S CROWN (BASE) OR AS SHOWN IN PLANTING DETAILS. UNLESS OTHERWISE NOTED ON PLANS, MULCH SHALL BE DOUBLE SHREDDED HARDWOOD MULCH DARK BROWN FINES BY MOUNTAIN HIGH SAVATREE OR APPROVED EQUAL. DYED MULCH IS NOT ACCEPTABLE. SUBMIT SAMPLES TO PROJECT LANDSCAPE ARCHITECT FOR APPROVAL. MULCH SHALL BE PROVIDED OVER THE ENTIRE AREA OF EACH SHRUB BED, GROUND COVER, VINE BED, AND TREE RING (6" MINIMUM) PLANTED UNDER THIS CONTRACT, AS WELL AS FOR ANY EXISTING LANDSCAPE AREAS AS SHOWN ON PLANS.

### I. DIGGING AND HANDLING

- ALL TREES SPECIFIED SHALL BE BALLED AND BURLAPPED (B&B) UNLESS OTHERWISE APPROVED BY PROJECT LANDSCAPE ARCHITECT.
- PROTECT ROOTS OR ROOT BALLS OF PLANTS AT ALL TIMES FROM SUN, DRYING WINDS, WATER AND FREEZING, AS NECESSARY UNTIL PLANTING. PLANT MATERIALS SHALL BE ADEQUATELY PACKED TO PREVENT DAMAGE DURING TRANSIT. TREES TRANSPORTED MORE THAN TEN (10) MILES OR WHICH ARE NOT PLANTED WITHIN THREE (3) DAYS OF DELIVERY TO THE SITE SHALL BE SPRAYED WITH AN ANTITRANSPIRANT PRODUCT ("WILTPRUF" OR EQUAL) TO MINIMIZE TRANSPIRATIONAL WATER LOSS.
- B&B, AND FIELD GROWN (FG) PLANTS SHALL BE DUG WITH FIRM, NATURAL BALLS OF SOIL OF SUFFICIENT SIZE TO ENCOMPASS THE FIBROUS AND FEEDING ROOTS OF THE PLANTS. NO PLANTS MOVED WITH A ROOT BALL SHALL BE PLANTED IF THE BALL IS CRACKED OR BROKEN. PLANTS SHALL NOT BE HANDLED BY STEMS.

### J. CONTAINER GROWN STOCK

- ALL CONTAINER GROWN MATERIAL SHALL BE HEALTHY, VIGOROUS, WELL-ROOTED PLANTS ESTABLISHED IN THE CONTAINER IN WHICH THEY ARE SOLD. THE PLANTS SHALL HAVE TOPS WHICH ARE OF GOOD QUALITY AND ARE IN A HEALTHY GROWING CONDITION.
- AN ESTABLISHED CONTAINER GROWN PLANT SHALL BE TRANSPLANTED INTO A CONTAINER AND GROWN IN THAT CONTAINER SUFFICIENTLY LONG ENOUGH FOR THE NEW FIBROUS ROOTS TO HAVE DEVELOPED SO THAT THE ROOT MASS WILL RETAIN ITS SHAPE AND HOLD TOGETHER WHEN REMOVED FROM THE CONTAINER. CONTAINER GROWN STOCK SHALL NOT BE HANDLED BY THEIR STEMS.
- ROOT BOUND PLANTS ARE NOT ACCEPTABLE AND WILL BE REJECTED.

### K. MATERIALS LIST

- QUANTITIES NECESSARY TO COMPLETE THE WORK ON THE DRAWINGS SHALL BE FURNISHED BY THE CONTRACTOR. QUANTITY ESTIMATES HAVE BEEN MADE CAREFULLY, BUT THE LANDSCAPE ARCHITECT OR OWNER ASSUMES NO LIABILITY FOR OMISSIONS OR ERRORS. SHOULD A DISCREPANCY OCCUR BETWEEN THE PLANS AND THE PLANT LIST QUANTITY, THE PLANS SHALL GOVERN. ALL DIMENSIONS AND/OR SIZES SPECIFIED SHALL BE THE MINIMUM ACCEPTABLE SIZE.

### L. FINE GRADING

- FINE GRADING UNDER THIS CONTRACT SHALL CONSIST OF FINAL FINISHED GRADING OF LAWN AND PLANTING AREAS THAT HAVE BEEN DISTURBED DURING CONSTRUCTION.
- THE CONTRACTOR SHALL FINE GRADE THE LAWN AND PLANTING AREAS TO BRING THE ROUGH GRADE UP TO FINAL FINISHED GRADE ALLOWING FOR THICKNESS OF SOD AND/OR MULCH DEPTH.
- ALL PLANTING AREAS SHALL BE GRADED AND MAINTAINED FOR POSITIVE DRAINAGE TO SURFACE/SUBSURFACE STORM DRAIN SYSTEMS. AREAS ADJACENT TO BUILDINGS SHALL SLOPE AWAY FROM THE BUILDINGS. REFER TO CIVIL ENGINEERS PLANS FOR FINAL GRADES, IF APPLICABLE.

### M. PLANTING PROCEDURES

- THE CONTRACTOR SHALL CLEAN WORK AND SURROUNDING AREAS OF ALL RUBBISH OR OBJECTIONABLE MATTER DAILY. ALL MORTAR, CEMENT, BUILDING MATERIALS, AND TOXIC MATERIAL SHALL BE COMPLETELY REMOVED FROM PLANTING AREAS. THESE MATERIALS SHALL NOT BE MIXED WITH THE SOIL. SHOULD THE CONTRACTOR FIND SUCH SOIL CONDITIONS IN PLANTING AREAS WHICH WILL ADVERSELY AFFECT THE PLANT GROWTH, THE CONTRACTOR SHALL IMMEDIATELY CALL IT TO THE ATTENTION OF THE OWNER'S REPRESENTATIVE. FAILURE TO DO SO BEFORE PLANTING SHALL MAKE THE CORRECTIVE MEASURES THE RESPONSIBILITY OF THE CONTRACTOR.

2. VERIFY LOCATIONS OF ALL UTILITIES, CONDUITS, SUPPLY LINES AND CABLES, INCLUDING BUT NOT LIMITED TO: ELECTRIC, GAS LINES AND TANKS), WATER, SANITARY SEWER, STORMWATER SYSTEMS, CABLE, AND TELEPHONE. PROPERLY MAINTAIN AND PROTECT EXISTING UTILITIES. CALL COLORADO (811) TO LOCATE UTILITIES AT LEAST 48 HOURS PRIOR TO CONSTRUCTION.

3. CONTRACTOR IS RESPONSIBLE TO REMOVE ALL EXISTING AND IMPORTED LIMEROCK AND LIMEROCK SUB-BASE FROM ALL PLANTING AREAS TO A MINIMUM DEPTH OF 36" OR TO NATIVE SOIL. CONTRACTOR IS RESPONSIBLE TO BACKFILL THESE PLANTING AREAS TO ROUGH FINISHED GRADE WITH CLEAN TOPSOIL FROM AN ON-SITE SOURCE OR AN IMPORTED SOURCE. IF LIMEROCK OR OTHER ADVERSE CONDITIONS OCCUR IN PLANTED AREAS AFTER 36" DEEP EXCAVATION BY THE CONTRACTOR, AND POSITIVE DRAINAGE CAN NOT BE ACHIEVED, CONTRACTOR SHALL UTILIZE POOR DRAINAGE CONDITION PLANTING DETAIL.

4. FURNISH NURSERY'S CERTIFICATE OF COMPLIANCE WITH ALL REQUIREMENTS AS SPECIFIED HEREIN. INSPECT AND SELECT PLANT MATERIALS BEFORE PLANTS ARE DUG AT NURSERY OR GROWING SITE.

5. COMPLY WITH APPLICABLE FEDERAL, STATE, COUNTY, AND LOCAL REGULATIONS GOVERNING LANDSCAPE MATERIALS AND WORK. UPON ARRIVAL AT THE SITE, PLANTS SHALL BE THOROUGHLY WATERED AND PROPERLY MAINTAINED UNTIL PLANTED. PLANTS SHOULD REMAIN UNPLANTED OR APPROPRIATELY HEADED IN FOR A PERIOD EXCEEDING TWENTY-FOUR (24) HOURS, AT ALL TIMES WORKMANKLIKE METHODS CUSTOMARY IN ACCEPTED HORTICULTURAL PRACTICES AS USED IN THE TRADE SHALL BE EXERCISED.

6. WORK SHALL BE COORDINATED WITH OTHER TRADES TO PREVENT CONFLICTS. COORDINATE PLANTING WITH IRRIGATION WORK TO ASSURE AVAILABILITY OF WATER AND PROPER LOCATION OF IRRIGATION APPURTENANCES AND PLANTS.

7. ALL PLANTING OPENINGS SHALL BE EXCAVATED TO SIZE AND DEPTH IN ACCORDANCE WITH ANSI Z60.1-2014 AMERICAN STANDARD FOR NURSERY STOCK.

8. TEST ALL TREE OPENINGS WITH WATER BEFORE PLANTING TO ASSURE PROPER DRAINAGE PERCOLATION IS AVAILABLE. NO ALLOWANCE WILL BE MADE FOR LOST PLANTS DUE TO IMPROPER DRAINAGE. IF POOR DRAINAGE EXISTS, UTILIZE "POOR DRAINAGE CONDITION" PLANTING DETAIL.

9. TREES SHALL BE SET PLUMB AND HELD IN POSITION UNTIL THE PLANTING MIXTURE HAS BEEN FLUSHED INTO PLACE WITH A SLOW, FULL HOSE STREAM. ALL PLANTING SHALL BE PERFORMED BY PERSONNEL FAMILIAR WITH PLANTING PROCEDURES AND UNDER THE SUPERVISION OF A QUALIFIED LANDSCAPE FOREMAN.

10. PRIOR TO EXCAVATION OF TREE OPENINGS, AN AREA EQUAL TO TWO TIMES THE DIAMETER OF THE ROOT BALL SHALL BE ROTO-TILLED TO A DEPTH EQUAL TO THE DEPTH OF THE ROOT BALL.

11. EXCAVATION OF TREE OPENINGS SHALL BE PERFORMED USING EXTREME CARE TO AVOID DAMAGE TO SURFACE AND SUBSURFACE ELEMENTS SUCH AS UTILITIES OR HARDSCAPE ELEMENTS, FOOTERS AND PREPARED SUB-BASES.

12. IN CONTINUOUS SHRUB AND GROUND COVER BEDS, THE ROTO-TILLED PERIMETER SHOULD EXTEND TO A DISTANCE OF ONE FOOT BEYOND THE DIAMETER OF A SINGLE ROOT BALL. THE BED SHALL BE TILLED TO A DEPTH EQUAL TO THE ROOT BALL DEPTH PLUS 6".

13. TREE OPENINGS FOR WELL DRAINED SOILS SHALL BE DUG SO THAT THE BOTTOM OF THE ROOT BALL WILL REST ON UNDISTURBED SOIL AND THE TOP OF THE ROOT BALL WILL BE FLUSH WITH FINISH GRADE. IN POORLY DRAINED SOILS THE TREE OPENING SHALL BE DUG SO THAT THE ROOT BALL RESTS ON UNDISTURBED SOIL AND THE TOP OF THE ROOT BALL IS 1" ABOVE FINISH GRADE. PLANT PIT WALLS SHALL BE SCARIFIED PRIOR TO PLANT INSTALLATION.

14. TAKE ALL NECESSARY PRECAUTIONS TO AVOID DAMAGE TO BUILDINGS AND BUILDING STRUCTURES WHILE INSTALLING TREES.

15. SOIL MIXTURE SHALL BE AS SPECIFIED IN SECTION 'E'.

16. TREES AND SHRUBS SHALL BE SET STRAIGHT AT AN ELEVATION THAT, AFTER SETTLEMENT, THE PLANT CROWN WILL STAND ONE (1) TO TWO (2) INCHES ABOVE GRADE. EACH PLANT SHALL BE SET IN THE CENTER OF THE PIT. SOIL MIXTURE SHALL BE BACK FILLED, THOROUGHLY TAMPED AROUND THE BALL, AND SETTLED BY WATER (AFTER TAMPING).

17. AMEND PINE AND OAK PLANT OPENINGS WITH ECTOMYCORRHIZAL SOIL APPLICATION PER MANUFACTURER'S RECOMMENDATION. ALL OTHER PLANT OPENINGS SHALL BE AMENDED WITH ENDOMYCORRHIZAL SOIL APPLICATION PER MANUFACTURER'S RECOMMENDATION. PROVIDE PRODUCT INFORMATION SUBMITTAL PRIOR TO INOCULATION.

- FILL HOLE WITH SOIL MIXTURE, MAKING CERTAIN ALL SOIL IS SATURATED. TO DO THIS, FILL HOLE WITH WATER AND ALLOW TO SOAK MINIMUM TWENTY (20) MINUTES, STIRRING IF NECESSARY TO GET SOIL THOROUGHLY WET. PACK LIGHTLY WITH FEET, ADD MORE WET SOIL MIXTURE. DO NOT COVER TOP OF BALL WITH SOIL MIXTURE.

19. ALL BURLAP, ROPE, WIRES, BASKETS, ETC., SHALL BE REMOVED FROM THE SIDES AND TOPS OF BALLS, BUT NO BURLAP SHALL BE PULLED FROM UNDERNEATH.

20. TREES SHALL BE PRUNED, IN ACCORDANCE WITH ANSI A-300, TO PRESERVE THE NATURAL CHARACTER OF THE PLANT. ALL SOFT WOOD OR SUCKER GROWTH AND ALL BROKEN OR BADLY DAMAGED BRANCHES SHALL BE REMOVED WITH A CLEAN CUT. ALL PRUNING TO BE PERFORMED BY CERTIFIED ARBORIST.

21. SHRUBS AND GROUND COVER PLANTS SHALL BE EVENLY SPACED IN ACCORDANCE WITH THE DRAWINGS AND AS INDICATED ON THE PLANT LIST. MATERIALS INSTALLED SHALL MEET MINIMUM SPECIMEN REQUIREMENTS OR QUANTITIES SHOWN ON PLANS. WHICHEVER IS GREATER. CULTIVATE ALL PLANTING AREAS TO A MINIMUM DEPTH OF 6". REMOVE AND DISPOSE ALL DEBRIS. MIX TOP 4" THE PLANTING SOIL MIXTURE AS SPECIFIED IN SECTION E. THOROUGHLY WATER ALL PLANTS AFTER INSTALLATION.

22. TREE GUYING AND BRACING SHALL BE INSTALLED BY THE CONTRACTOR IN ACCORDANCE WITH THE PLANS TO INSURE STABILITY AND MAINTAIN TREES IN AN UPRIGHT POSITION. IF THE CONTRACTOR AND OWNER DECIDE TO WAIVE THE TREE GUYING AND BRACING, THE OWNER SHALL NOTIFY THE PROJECT LANDSCAPE ARCHITECT IN WRITING AND AGREE TO INDEMNIFY AND HOLD HARMLESS THE PROJECT LANDSCAPE ARCHITECT IN THE EVENT UNSUPPORTED TREES PLANTED UNDER THIS CONTRACT FALL AND DAMAGE PERSON OR PROPERTY.

23. ALL PLANT BEDS SHALL BE KEPT FREE OF NOXIOUS WEEDS UNTIL FINAL ACCEPTANCE OF WORK. IF DIRECTED BY THE OWNER, "ROUND-UP" SHALL BE APPLIED FOR WEED CONTROL BY QUALIFIED PERSONNEL TO ALL PLANTING AREAS IN SPOT APPLICATIONS PER MANUFACTURER'S RECOMMENDATIONS. PRIOR TO FINAL INSPECTION, TREAT ALL PLANTING BEDS WITH AN APPROVED PRE-EMERGENT HERBICIDE AT AN APPLICATION RATE RECOMMENDED BY THE MANUFACTURER, (AS ALLOWED BY JURISDICTIONAL AUTHORITY)

### N. LAWN SODDING

- THE WORK CONSISTS OF LAWN BED PREPARATION, SOIL PREPARATION, AND SODDING COMPLETE, IN STRICT ACCORDANCE WITH THE SPECIFICATIONS AND THE APPLICABLE DRAWINGS TO PRODUCE A TURF GRASS LAWN ACCEPTABLE TO THE OWNER.

2. ALL AREAS THAT ARE TO BE SODDED SHALL BE CLEARED OF ANY ROUGH GRASS, WEEDS, AND DEBRIS BY MEANS OF A SOD CUTTER (24" DEEP) (3" INCHES), AND THE GROUND BROUGHT TO AN EVEN GRADE. THE ENTIRE SURFACE SHALL BE ROLLED WITH A ROLLER WEIGHING NOT MORE THAN ONE-HUNDRED (100) POUNDS PER FOOT OF WIDTH. DURING THE ROLLING, ALL DEPRESSIONS CAUSED BY SETTLEMENT SHALL BE FILLED WITH ADDITIONAL SOIL, AND THE SURFACE SHALL BE REGRADED AND ROLLED UNTIL PRESENTING A SMOOTH AND EVEN FINISH TO THE REQUIRED GRADE.

3. PREPARE LOOSE BED FOUR (4) INCHES DEEP. HAND RAKE UNTIL ALL BUMPS AND DEPRESSIONS ARE REMOVED. WET PREPARED AREA THOROUGHLY.

#### 4. SODDING

a. THE CONTRACTOR SHALL SOD ALL AREAS THAT ARE NOT PAVED OR PLANTED AS DESIGNATED ON THE DRAWINGS WITHIN THE CONTRACT LIMITS, UNLESS SPECIFICALLY NOTED OTHERWISE.

b. SOD PANELS SHALL BE LAID TIGHTLY TOGETHER SO AS TO MAKE A SOD DODDED LAWN AREA. SOD SHALL BE LAID UNIFORMLY AGAINST THE EDGES OF ALL CURBS AND OTHER HARDSCAPE ELEMENTS, PAVED AND PLANTED AREAS. ADJACENT TO BUILDINGS, A 24 INCH STONE MULCH STRIP SHALL BE PROVIDED, IMMEDIATELY FOLLOWING SOD LAYING. THE LAWN AREAS SHALL BE ROLLED WITH A LAWN ROLLER CUSTOMARILY USED FOR SUCH PURPOSES, AND THEN THOROUGHLY IRRIGATED. IF, IN THE OPINION OF THE OWNER, TOP-DRESSING IS NECESSARY AFTER ROLLING TO FILL THE VOIDS BETWEEN THE SOD PANELS AND TO EVEN OUT INCONSISTENCIES IN THE SOD, CLEAN SAND, AS APPROVED BY THE OWNER'S REPRESENTATIVE, SHALL BE UNIFORMLY SPREAD OVER THE ENTIRE SURFACE OF THE SOD AND THOROUGHLY WATERED IN. FERTILIZE INSTALLED SOD AS ALLOWED BY PROPERTY'S JURISDICTIONAL AUTHORITY.

5. DURING DELIVERY, PRIOR TO, AND DURING THE PLANTING OF THE LAWN AREAS, THE SOD PANELS SHALL AT ALL TIMES BE PROTECTED FROM EXCESSIVE DRYING AND UNNECESSARY EXPOSURE OF THE ROOTS TO THE SUN. ALL SOD SHALL BE STACKED SO AS NOT TO BE DAMAGED BY SWEATING OR EXCESSIVE HEAT AND MOISTURE.

#### 6. LAWN MAINTENANCE

a. WITHIN THE CONTRACT LIMITS, THE CONTRACTOR SHALL PRODUCE A DENSE, WELL ESTABLISHED LAWN. THE CONTRACTOR SHALL BE RESPONSIBLE FOR THE REPAIR AND RE-SODDING OF ALL ERODED, SUNKEN OR BARE SPOTS (LARGER THAN 12"x12") UNTIL CERTIFICATION OF ACCEPTANCE BY THE OWNER'S REPRESENTATIVE. REPAIRED SODDING SHALL BE ACCOMPLISHED AS IN THE ORIGINAL WORK, INCLUDING REGRADED IF NECESSARY.

b. CONTRACTOR SHALL BE RESPONSIBLE FOR ESTABLISHING AND MAINTAINING SOD/LAWN UNTIL ACCEPTANCE BY THE OWNER'S REPRESENTATIVE. PRIOR TO AND UPON ACCEPTANCE, CONTRACTOR TO PROVIDE WATERING/IRRIGATION SCHEDULE TO OWNER. OBSERVE ALL APPLICABLE WATERING RESTRICTIONS AS SET FORTH BY THE PROPERTY'S JURISDICTIONAL AUTHORITY.

### O. EDGING

a. CONTRACTOR SHALL INSTALL 4"x6" ROLLED TOP STEEL EDGING BETWEEN ALL SOD/SEED AREAS AND PLANTING BEDS.

### P. CLEANUP

1. UPON COMPLETION OF ALL PLANTING WORK AND BEFORE FINAL ACCEPTANCE, THE CONTRACTOR SHALL REMOVE ALL MATERIAL, EQUIPMENT, AND DEBRIS RESULTING FROM CONTRACTORS WORK. ALL PAVED AREAS SHALL BE CLEANED AND THE SITE LEFT IN A NEAT AND ACCEPTABLE CONDITION AS APPROVED BY THE OWNER'S REPRESENTATIVE.

### Q. PLANT MATERIAL MAINTENANCE

- ALL PLANTS AND PLANTING INCLUDED UNDER THIS CONTRACT SHALL BE MAINTAINED BY WATERING, CULTIVATING, SPRAYING, PRUNING, AND ALL OTHER OPERATIONS (SUCH AS RE-STAKING OR REPAIRING GUY SUPPORTS) NECESSARY TO INSURE A HEALTHY PLANT CONDITION BY THE CONTRACTOR UNTIL CERTIFICATION OF ACCEPTANCE BY THE OWNER'S REPRESENTATIVE.

### R. FINAL INSPECTION AND ACCEPTANCE OF WORK

- FINAL INSPECTION AT THE END OF THE WARRANTY PERIOD SHALL BE ON PLANTING. CONSTRUCTION AND ALL OTHER INCIDENTAL WORK PERTAINING TO THIS CONTRACT, ANY REPLACEMENT AT THIS TIME SHALL BE SUBJECT TO THE SAME ONE (1) YEAR WARRANTY (OR AS SPECIFIED BY THE LANDSCAPE ARCHITECT OR OWNER IN WRITING) BEGINNING WITH THE TIME OF REPLACEMENT AND ENDING WITH THE SAME INSPECTION AND ACCEPTANCE HEREIN DESCRIBED.

### S. WARRANTY

- THE LIFE AND SATISFACTORY CONDITION OF ALL PLANT MATERIAL INSTALLED (INCLUDING SOD) BY THE LANDSCAPE CONTRACTOR SHALL BE WARRANTED BY THE CONTRACTOR FOR A MINIMUM OF ONE (1) CALENDAR YEAR COMMENCING AT THE TIME OF CERTIFICATION OF ACCEPTANCE BY THE OWNER'S REPRESENTATIVE.

2. ANY PLANT NOT FOUND IN A HEALTHY GROWING CONDITION AT THE END OF THE WARRANTY PERIOD SHALL BE REMOVED FROM THE SITE AND REPLACED AS SOON AS WEATHER CONDITIONS PERMIT. ALL REPLACEMENTS SHALL BE PLANTS OF THE SAME KIND AND SIZE AS SPECIFIED IN THE PLANT LIST. THEY SHALL BE FURNISHED PLANTED AND MULCHED AS SPECIFIED AT NO ADDITIONAL COST TO THE OWNER.

3. IN THE EVENT THE OWNER DOES NOT CONTRACT WITH THE CONTRACTOR FOR LANDSCAPE AND IRRIGATION MAINTENANCE, THE CONTRACTOR SHOULD VISIT THE PROJECT SITE PERIODICALLY DURING THE ONE (1) YEAR WARRANTY PERIOD TO EVALUATE MAINTENANCE PROCEDURES BEING PERFORMED BY THE OWNER. CONTRACTOR SHALL NOTIFY THE OWNER IN WRITING OF MAINTENANCE PROCEDURES OR CONDITIONS WHICH THREATEN VIGOROUS AND HEALTHY PLANT GROWTH.

1

**MAJOR AMENDMENT TO GOVERNING SITE PLAN DRB-95-146 (OCT 4, 2023).  
ADDITIONAL LANDSCAPE ADDITIONS TO NEW LANDSCAPE ISLANDS, NEW  
LANDSCAPE AROUND BUILDING EXPANSION, ALONG EASTERN AND  
SOUTHERN PROPERTY LINES**

1

**Kimley»Horn**

© 2023 KIMLEY-HORN AND ASSOCIATES, INC.

6200 South Syracuse Way, Suite 300

Greenwood Village, Colorado 80111 (303) 228-2300

DESIGNED BY: ECS  
DRAWN BY: ECS  
CHECKED BY: EIWS  
DATE: 10/3/2023

LEGAL DESCRIPTION:  
TRACT A, ATRISCO BUSINESS  
PARK UNIT 1 CONTAINING  
39.775 ACRES

**ABB ABQ ADDITION**  
6625 BLUEWATER ROAD NW  
**MAJOR AMENDMENT**  
**LANDSCAPE NOTES**

**PRELIMINARY**  
FOR REVIEW ONLY  
NOT FOR  
CONSTRUCTION  
**Kimley»Horn**  
Kimley-Horn and Associates, Inc.







PROJECT NO.  
096523009




SHEET

11

NO. REVISION BY DATE



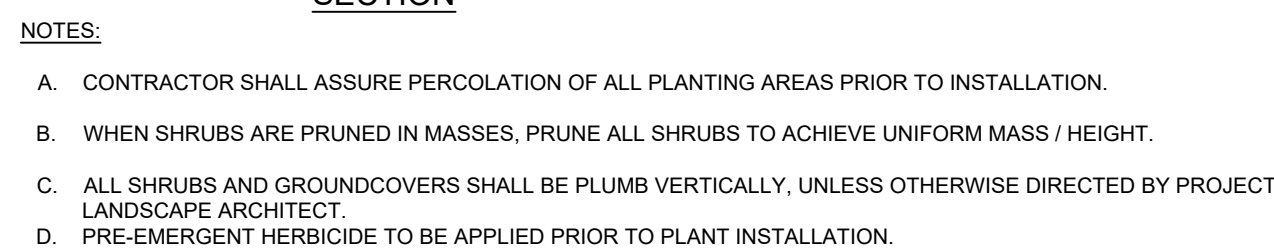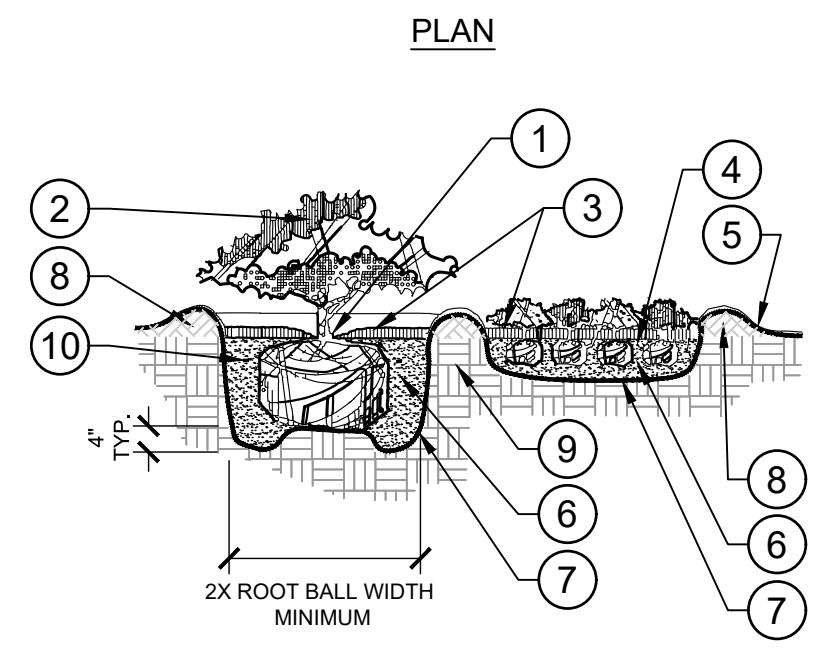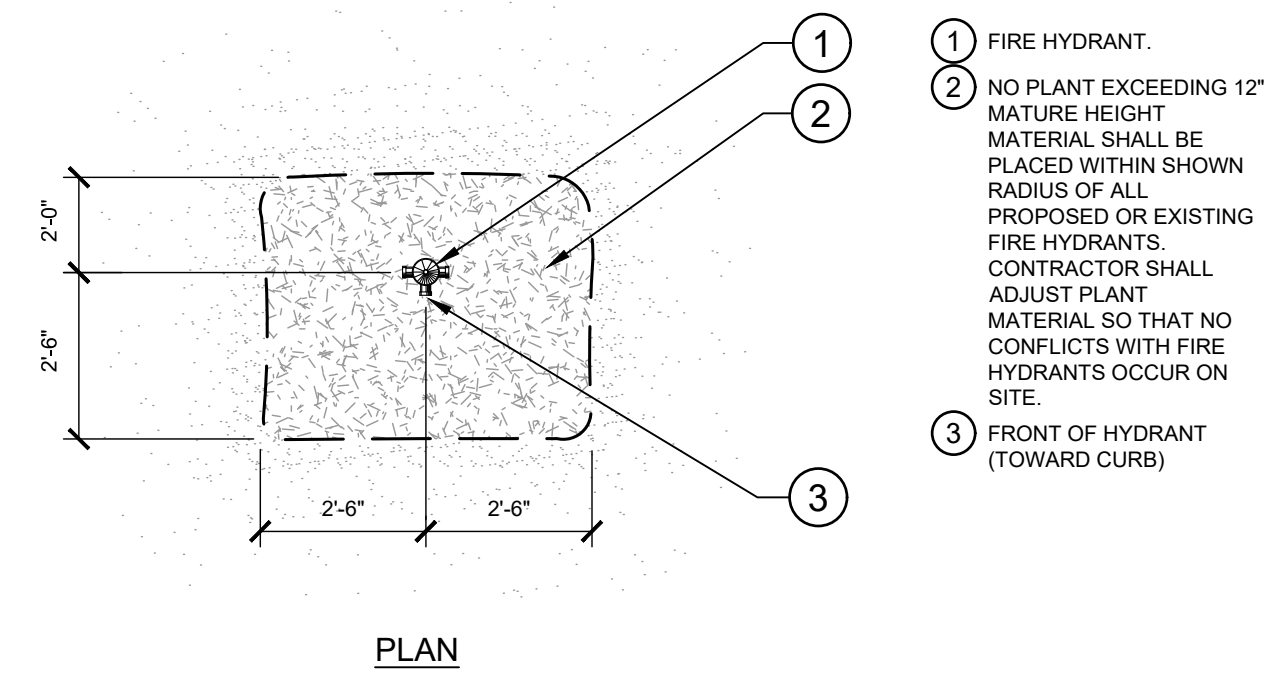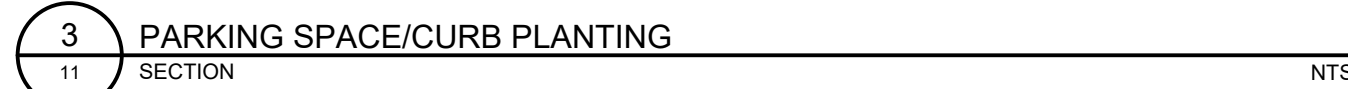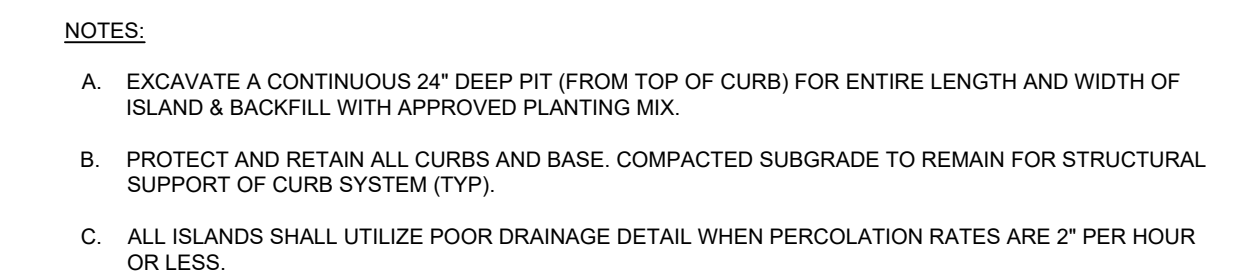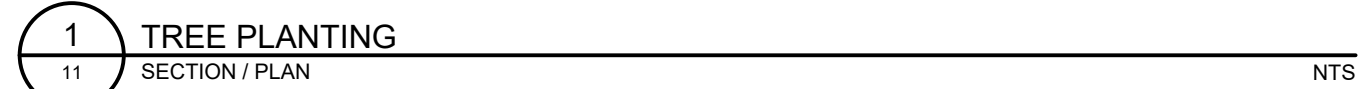

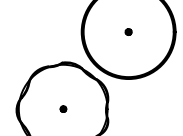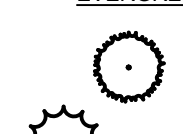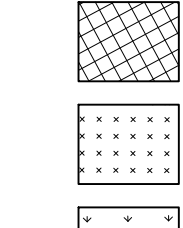DECIDUOUS TREES			BOTANICAL NAME	COMMON NAME	CONT	CAL	SIZE
	CO	18	CELTIS OCCIDENTALIS	COMMON HACKBERRY	B & B	2" CAL MIN	10' - 12' HT. MIN.
	GS	18	GLEDITSIA TRIACANTHOS INERMIS 'SHADEMASTER'	SHADEMASTER HONEY LOCUST	B & B	2" CAL MIN	10' - 12' HT. MIN.
	SD	18	SAPINDUS DRUMMONDII	WESTERN SOAPBERRY	B & B	2" CAL MIN	10' - 12' HT. MIN.
EVERGREEN TREES			BOTANICAL NAME	COMMON NAME	CONT	CAL	SIZE
	JS	17	JUNIPERUS MONOSPERMA	ONESEED JUNIPER	B & B		6' HT MIN
	PN	22	PINUS NIGRA	AUSTRIAN PINE	B & B		6' HT MIN
GROUND COVERS			BOTANICAL NAME	COMMON NAME	CONT	SIZE	SPACING
	RM	45,464 SF	1-1/2" - 2" RIVER ROCK MULCH	1-1/2" - 2" RIVER ROCK MULCH	-		
	XA	11,502 SF	APPLEWOOD SEED MIX	DETENTION SEED MIX	SEED		
	XL	22,444 SF	NATIVE SEED MIX SEE DETAILS FOR SEED MIX	NATIVE SEED MIX	SEED		

NATIVE-GRASS SEED MIX SHALL BE 50% / 50% (BY WEIGHT) COMBINATION OF BOUTELOUA GRACILIS 'HACHITA' -BLUE GRAMA, AND BUCHLOE DACTYLOIDES - BUFFALO GRASS, APPLIED AT A RATE OF 100# PLS/AC

<b>LANDSCAPE AREA</b>		
TOTAL LOT AREA = 39.94 ACRES / 1,739,791 SF		
TOTAL GROSS LOT AREA		1,739,791 SF
TOTAL BUILDING AREA (EXISTING TO REMAIN)	-	103,007 SF
TOTAL BUILDING AREA (PROPOSED)		89,631 SF
NET LOT AREA		1,547,153 SF

TOTAL COVERAGE (PROPOSED LANDSCAPE AREA)	79,410 x 75% =
TOTAL COVERAGE REQUIREMENT	= 59,896.5 SF
TOTAL COVERAGE PROVIDED	= 60,783 (76%)
COVERAGE OF GROUND-LEVEL PLANTS REQ.	= 19,965.5 (25%)
COVERAGE OF GROUND-LEVEL PLANTS PROV.	= 33,946 (42%)

258 PROPOSED PARKING STALLS	
1 TREE / FOR EACH 10 PARKING STALLS REQUIRED =	26 TREES
TOTAL TREES PROVIDED	26 TREES

1,118 LF OF STREET FRONTAGE	
1 TREE / PER 25 LF OF STREET FRONTAGE REQUIRED =	45 TREES
<u>TOTAL TREES PROVIDED</u>	<u>45 TREES</u>

WATER PLANTAIN	ALISMA SUBCORDATUM
SWAMP MILKWEED	ASCLEPIAS INCARNATA
TICKSEED SUNFLOWER	BIDENS ARISTOSA
ALLEGHENY MONKEYFLOWER	MIMULUS RINGENS
DITCH STONECROP	PENTHORUM SEDOIDES
CUTLEAF CONEFLOWER	RUDBECKIA LACINIATA
COMMON ARROWHEAD	SAGITTARIA LATIFOLIA
BLUE VERVAIN	VERBENA HASTATA
AWL-FRUITED SEDGE	CAREX STIPATA
FOX SEDGE	CAREX VULPINOIDEA
VIRGINIA WILDRYE	ELYMUS VIRGINICUS
SPIKE RUSH	ELEOCHARIS SPECIES
SOFT RUSH	JUNCUS EFFUSUS
PATH RUSH	JUNCUS TENUIS
RICE CUT GRASS	LEERSIA ORYZOIDES
SWITCHGRASS	PANICUM VIRGATUM
SOFTSTEM BULBRUSH	SCHOENOPLECTIS TABERNAEMONTANI
PRAIRIE CORDGRASS	SPARTINA PECTINATA

AVENA SATIVA  
LOLIUM MULTIFLORUM

PLANTING RATE: 35 LBS./ACRE

\*MIXTURE MAY VARY OCCASIONALLY FROM THE INDICATED LISTING, BASED ON AVAILABILITY OF INDIVIDUAL SPECIES.



1

**Kimley»»Horn**

©2023 KIMLEY-HORN AND ASSOCIATES, INC.  
6200 South Syracuse Way, Suite 300  
Greenwood Village, Colorado 80111 (303) 228-2300

**LEGAL DESCRIPTION:**  
TRACT A ATRISCO BUSINESS  
PARK UNIT 1 CONTAINING  
39.775 ACRES

**ABB ABQ ADDITION**  
6825 BLUEWATER ROAD NW  
**MAJOR AMENDMENT**  
**LANDSCAPE DETAILS**

**PRELIMINARY**  
FOR REVIEW ONLY  
NOT FOR  
CONSTRUCTION  
**Kimley»Horn**  
Kimley-Horn and Associates, Inc.

PROJECT NO.  
096523009

SHEET  
12