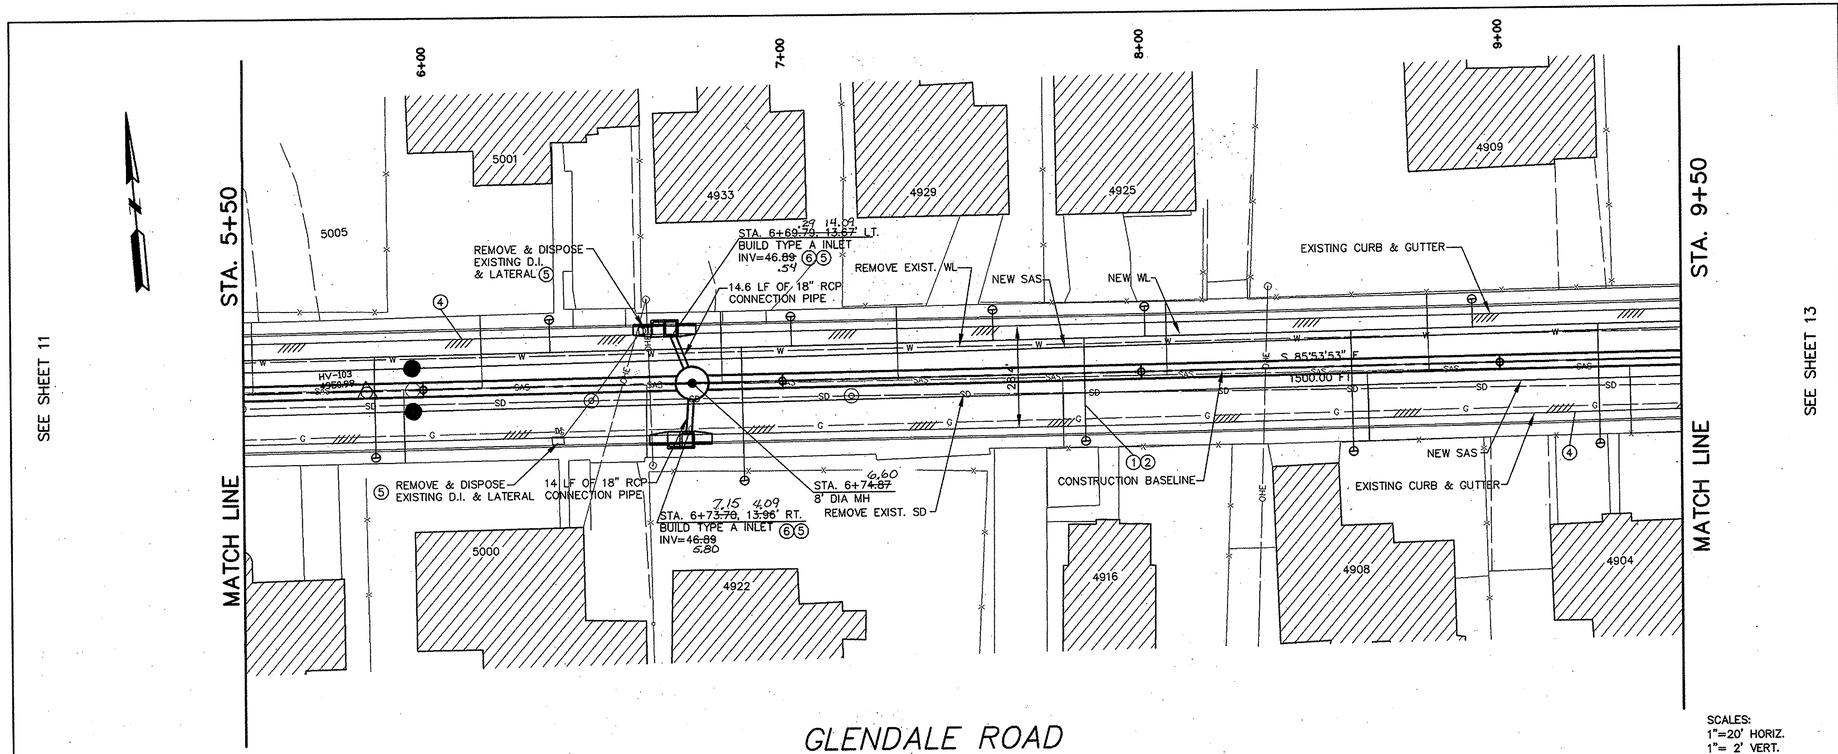

GLENDALE ROAD

SCALES:
1"=20' HORIZ.
1"= 2' VERT.

NGVD DATUM 1929

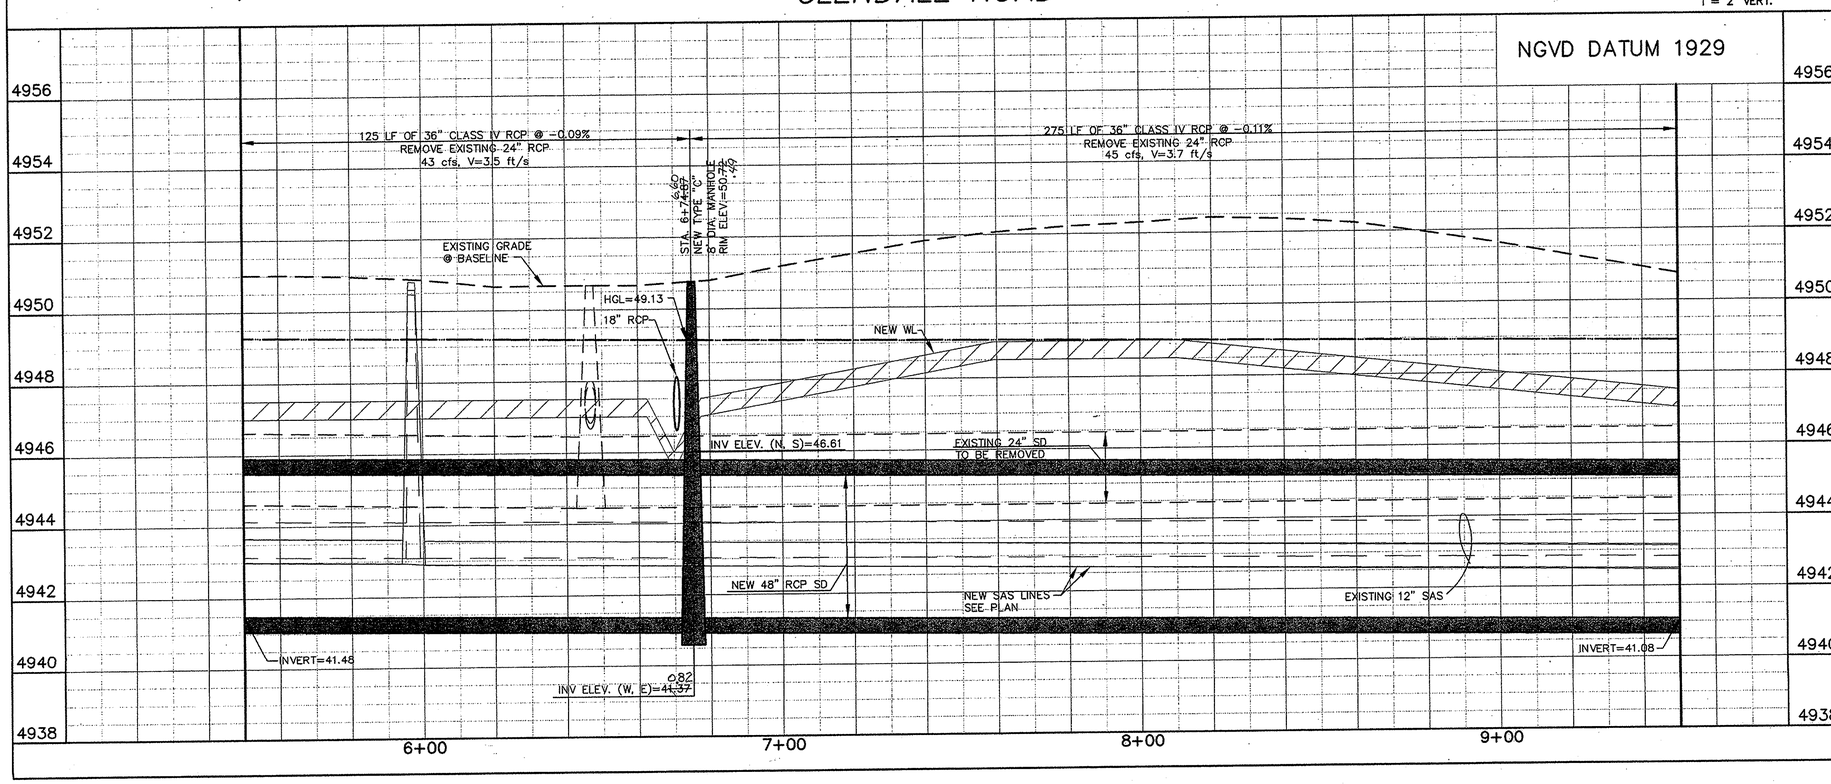

KEYED NOTES

1. REPLACED WATER SERVICE LINES SHALL BE REPLACED WITH COPPER TUBING WITH NO SPLICES FROM METER TO MAIN PER COA STD. DWG. 2362.
2. ANY EXISTING UTILITIES EXPOSED DURING CONSTRUCTION SHALL BE SUPPORTED AND PROTECTED DURING CONSTRUCTION. THIS SUPPORT AND PROTECTION SHALL BE CONSIDERED INCIDENTAL TO PROJECT CONSTRUCTION AND NO SEPARATE PAYMENT WILL BE MADE.
3. NOT USED THIS SHEET
4. MAJOR LOCAL PAVEMENT SHALL BE REPLACED PER COA STD. DWG. 2405. SEE SHEET 31.
5. CURB AND GUTTER REPLACEMENT SHALL BE PER COA STD. DWG. 2415A, SEE SHEET 2 NOTES.
6. STORM DRAIN INLETS SHALL BE PER COA STD. DWG. 2201. INLET GRATES WILL BE PER COA STD. DWG. 2220.
7. NOT USED THIS SHEET
8. NOT USED THIS SHEET
9. NOT USED THIS SHEET
10. NOT USED THIS SHEET
11. NOT USED THIS SHEET
12. NOT USED THIS SHEET
13. NOT USED THIS SHEET

AS BUILT INFORMATION
CONTRACTOR New Mexico Underground
WORK STAKED BY Terra Land Surveys DATE 9/06
FIELD VERIFICATION AND ACCEPTANCE BY C.O.A. DATE 5/07
FIELD VERIFICATION BY Terra Land Surveys DATE 5/07
DRAWINGS CORRECTED BY Larkin Group NM DATE 7/07
MICRO-FILM INFORMATION
RECORDED BY DATE
RECORDED BY DATE
RECORDED BY DATE

BENCH MARKS
CITY OF ALBUQUERQUE STATION 2-K12B
BEING A 3 1/4" ALUMINUM TABLET SET IN THE TOP OF CURB AT THE SOUTHEAST QUADRANT OF CENTRAL & ATRISCO SW
COORDINATES ARE MODIFIED GROUND VALUES BASED ON NAD 27 U.S. SURVEY FEET
NORTHING=1487200.64 PROJECT GRID FACTOR
EASTING=370304.57 GF=0.999681630
ELEV.=4954.92 NGVD 29

SURVEY INFORMATION
FIELD NOTES

NO.	BY	DATE
1		

ENGINEER'S SEAL
REGISTERED PROFESSIONAL ENGINEER STATE OF NEW MEXICO 13960 JOHN A. MEYER

NO.	DATE	REMARKS	BY
4			
3			
2			
1			

REVISIONS

DESIGN
DESIGNED BY: XX
DRAWN BY: XX
CHECKED BY: XX

RECORD DRAWINGS WERE PREPARED FROM INFORMATION PROVIDED BY THE CONTRACTOR

RECORD DRAWING
JUNE 2007

LARKIN GROUP INC.
CONSULTING ENGINEERS AND SURVEYORS
8500 MENAUL BLVD. NE A-440
ALBUQUERQUE, NEW MEXICO 87112
(505) 275-7500 FAX (505) 275-0748

2002-0021

CITY OF ALBUQUERQUE
DEPARTMENT OF MUNICIPAL DEVELOPMENT
STORM DRAINAGE DESIGN DIVISION

TITLE: CENTRAL – ATRISCO DRAINAGE IMPROVEMENTS PHASE II
GLENDALE ROAD STA. 5+50 TO 9+50

Design Review Committee: APPROVED JUN 08 2006 DESIGN REVIEW COMMITTEE
City Engineer Approval: APPROVED JUN 08 2006 CITY ENGINEER
Last Design Update | Mo./Day/Yr. | Mo./Day/Yr.

Project No. 674903 | Zone Map No. K-11-Z | Sheet 12 of 32