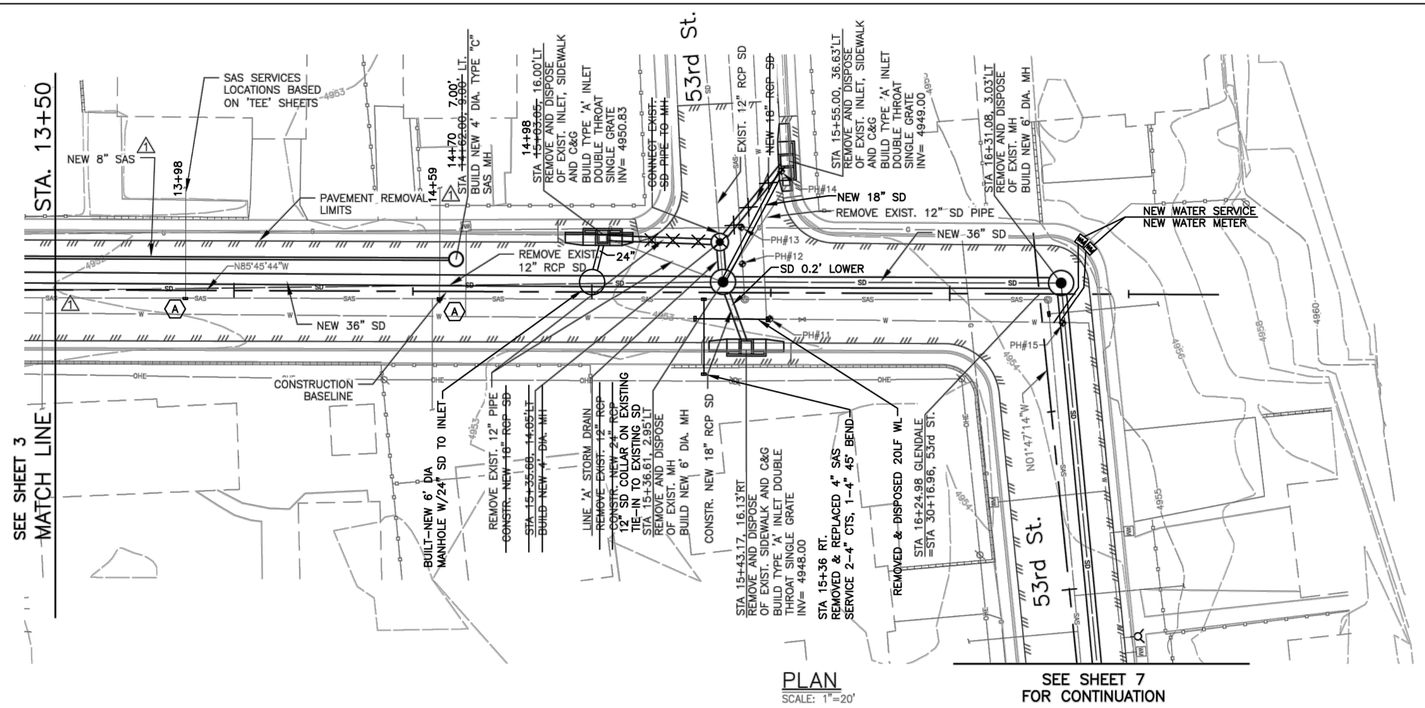

PLAN
SCALE: 1"=20'

GLENDALE RD. NW.

SCALE: 1"=20'
GRAPHIC SCALE IN FEET

NGVD29 DATUM

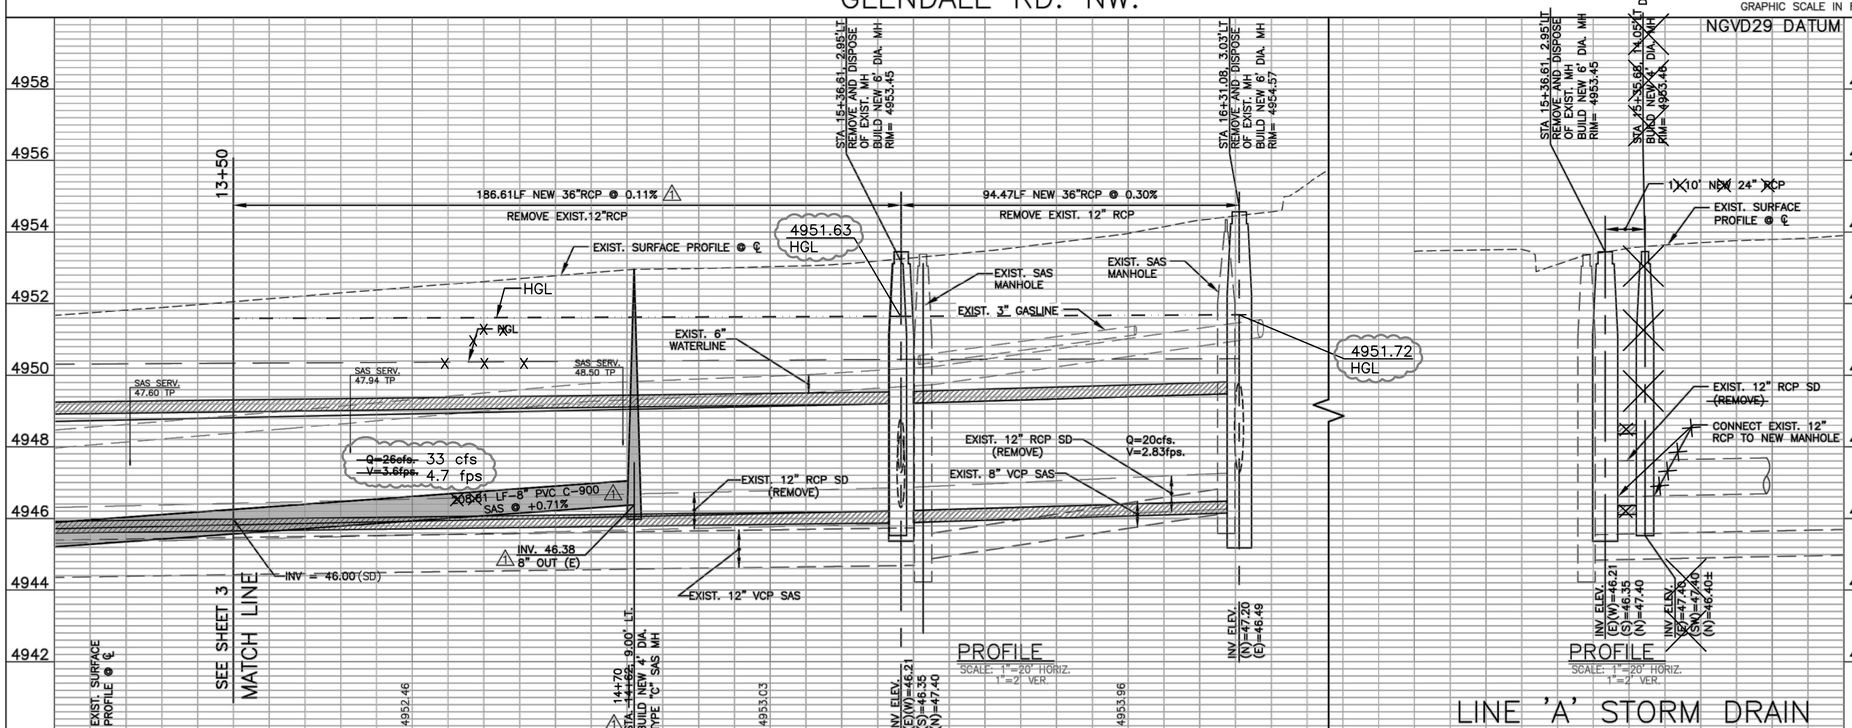

PROFILE
SCALE: 1"=20' HORIZ.
1"=2' VER.

PROFILE
SCALE: 1"=20' HORIZ.
1"=2' VER.

LINE 'A' STORM DRAIN

POTHOLE INFORMATION

POTHOLE # (PH)	TYPE & MATERIAL	GROUND ELEV.	DEPTH TO TOP OF PIPE
11	WATER/PVC	4953.37	38"
12	SAS/CONCRETE	4953.74	96"
13	GAS/HDPE	4953.78	36"
14	NO LOCATE&N/A	4953.88	120"
15	WATER/CEMENT	4954.72	39"

* PIPE SIZES & TYPES ARE BEST ESTIMATE TO BE CONFIRMED BY CONTRACTOR.

NOTES

A. ANY WATER SERVICE LINES THAT NEED TO BE REPLACED SHALL BE REPLACED WITH COPPER TUBING AND NO SPLICES FROM METER TO MAIN. AS PER COA STD DWG. 2362

B. ANY EXITING UTILITIES EXPOSED DURING CONSTRUCTION SHALL BE SUPPORTED AND PROTECTED DURING CONSTRUCTION. THIS SUPPORT AND PROTECTION SHALL BE CONSIDERED INCIDENTAL TO PROJECT CONSTRUCTION AND NO SEPARATE PAYMENT WILL BE MADE.

C. THE DISTURBANCE OF ANY EXISTING WHEELCHAIR RAMP DURING CONSTRUCTION WILL REQUIRE THE REPLACEMENT OF THE ENTIRE WHEELCHAIR RAMP. AS PER COA STD DWG 2441. CASE I, OR CASE II WITH HEADER CURB.

D. RESIDENTIAL PAVEMENT WILL BE REPLACED AS PER COA STD DWG 2465 (RESIDENTIAL).

E. CURB AND GUTTER WILL BE REPLACED AS PER COA STD DWG 2451A.

F. STORM DRAIN INLETS WILL BE AS PER COA STD DWG 2201. WITH GRATES AS PER COA STD DWG 2220.

G. ALL PAVEMENT CUTS TO BE MADE PERPENDICULAR TO TRAFFIC FLOW. PAVEMENT CUTS AT A CURB RADIUS WILL BE MADE RADIAL TO THE CURB.

H. SIDEWALKS WILL BE REPLACED AS PER COA STD DWG 2430.

I. DISTURBED DRIVEPADS WILL BE REPLACED AS PER COA STD DWG 2425.

J. ALL RCP SHALL BE CLASS IV UNLESS OTHERWISE NOTED.

(A) ABANDONED SAS SERVICE, CAPPED AT MAINLINE. NEW 4" SAS SERVICE, TAP AND LINE TO NEW 8" SAS.

RECORD DRAWINGS WERE PREPARED FROM INFORMATION PROVIDED BY THE CONTRACTOR

RECORD DRAWING
APRIL 2017
REV.11/17

2002-0021-28

LARKIN GROUP, P.A., INC.
8500 MENAUL NE, SUITE A-440
ALBUQUERQUE, NEW MEXICO 87112
(505) 275-7500, FAX (505) 275-0748
ENGINEER'S FILE No. 2002-0021-18

AS BUILT INFORMATION

CONTRACTOR	
WORK STAKED BY	DATE
INSPECTOR'S ACCEPTANCE BY	DATE
FIELD VERIFICATION BY	DATE
DRAWINGS COORDINATED BY	DATE

MICRO-FILM INFORMATION

RECORDED BY	DATE
RECORDED BY	DATE
RECORDED BY	DATE

BENCH MARKS

ALBUQ. CONTROL SURVEY STATION "NM_448_C1"
STATION IS LOCATED IN MEDIAN OF CENTRAL AVE., WEST OF 59th STREET. THE STATION IS A NMSHC BRASS DISC SET FLUSH IN THE TOP OF A CONC. POST AND IS STAMPED "NM448-C1"
NEW MEXICO STATE PLANE COORD. CENTRAL ZONE
X=364,764.30, Y=1485275.17, (NAD 27)
ELEVATION= 5074.028 (NGVD 29)
PROJECT G-G FACTOR: 0.999681630

SURVEY INFORMATION

FIELD NOTES

NO.	BY	DATE

ENGINEER'S SEAL

REGISTERED PROFESSIONAL ENGINEER
STATE OF NEW MEXICO
NO. 13960
JAY A. LARKIN
8-19-15

NO.	DATE	REVISIONS	BY
4			
3			
2	06/30/16	REVISE SD & ADD NEW SAS IN GLENDALE REMARKS	LARKIN
1			

DESIGNED BY: JAA DATE: AUG. 2015
DRAWN BY: CAI,TL DATE: AUG. 2015
CHECKED BY: JAA DATE: AUG. 2015

CITY OF ALBUQUERQUE
DEPARTMENT OF MUNICIPAL DEVELOPMENT
ENGINEERING DIVISION

TITLE: CENTRAL-ATRISCO DRAINAGE IMPROVEMENTS PHASE III
GLENDALE ROAD
STA 13+50 TO 16+75

Design Review Committee	City Engineer Approval	Last Design Update	Mo./Day/Yr.	Mo./Day/Yr.

Project No.	Zone Map No.	Sheet	of
6749.04	K-11,J-11	4.1	14