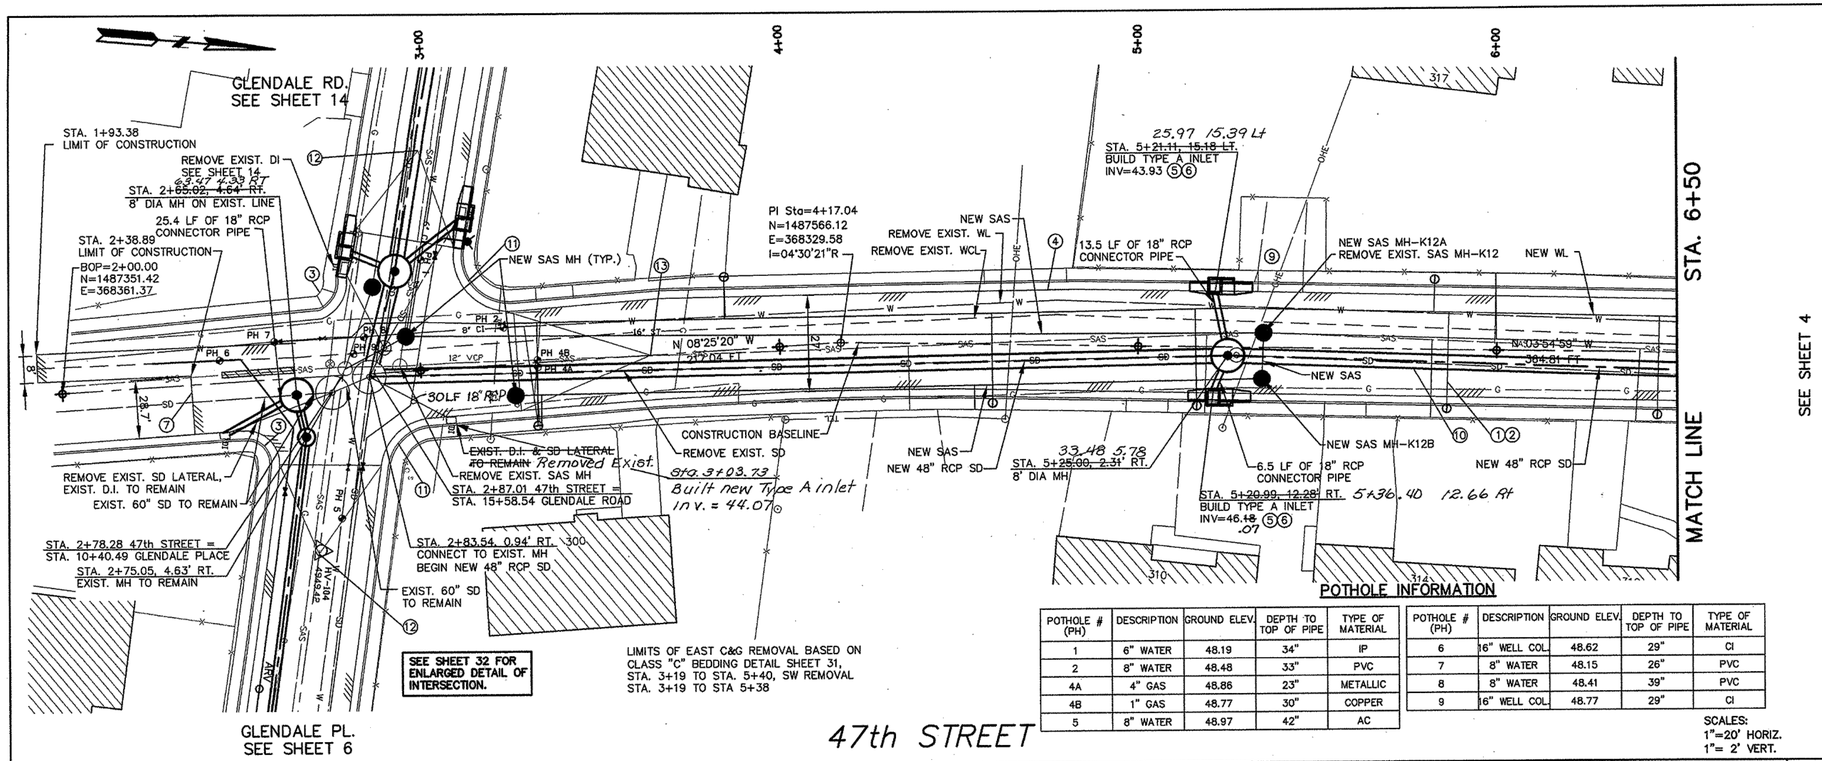

POTHOLE INFORMATION

POTHOLE # (PH)	DESCRIPTION	GROUND ELEV.	DEPTH TO TOP OF PIPE	TYPE OF MATERIAL
1	6" WATER	48.19	34"	IP
2	8" WATER	48.48	33"	PVC
4A	4" GAS	48.86	23"	METALLIC
4B	1" GAS	48.77	30"	COPPER
5	8" WATER	48.97	42"	AC

POTHOLE # (PH)	DESCRIPTION	GROUND ELEV.	DEPTH TO TOP OF PIPE	TYPE OF MATERIAL
6	16" WELL COL.	48.62	29"	CI
7	8" WATER	48.15	26"	PVC
8	8" WATER	48.41	39"	PVC
9	16" WELL COL.	48.77	29"	CI

SCALES:
1"=20' HORIZ.
1"= 2' VERT.

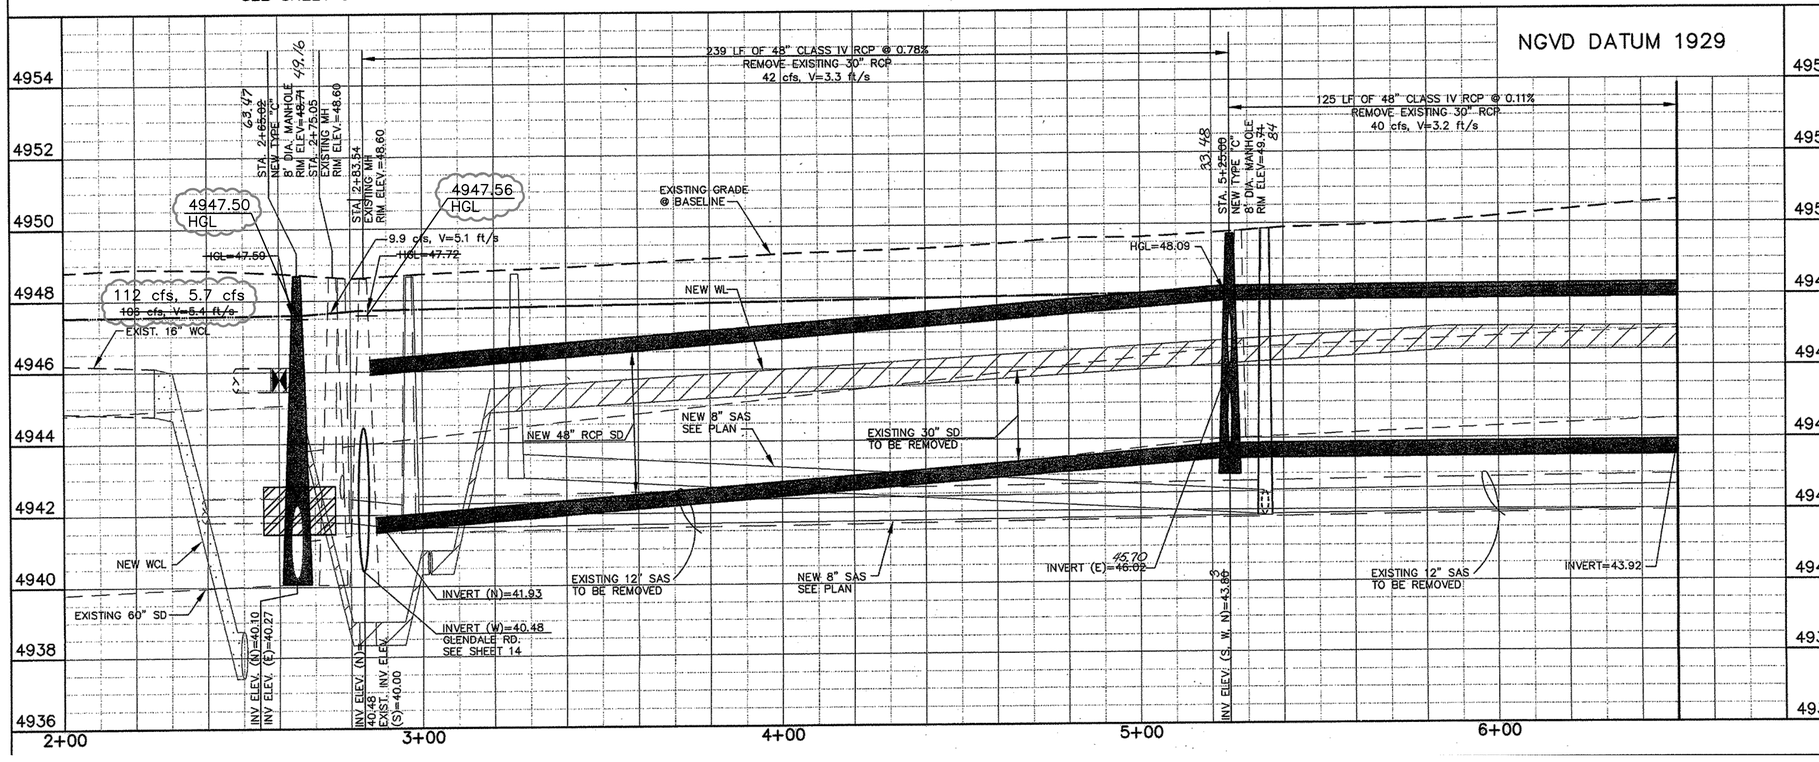

KEYED NOTES

1. REPLACED WATER SERVICE LINES SHALL BE REPLACED WITH COPPER TUBING WITH NO SPLICES FROM METER TO MAIN PER COA STD. DWG. 2362.
2. ANY EXISTING UTILITIES EXPOSED DURING CONSTRUCTION SHALL BE SUPPORTED AND PROTECTED DURING CONSTRUCTION. THIS SUPPORT AND PROTECTION SHALL BE CONSIDERED INCIDENTAL TO PROJECT CONSTRUCTION AND NO SEPARATE PAYMENT WILL BE MADE.
3. THE DISTRUBANCE OF ANY EXISTING WHEELCHAIR RAMP DURING CONSTRUCTION SHALL REQUIRE THE REPLACEMENT OF THE ENTIRE WHEELCHAIR RAMP PER COA STD. DWG. 2441, CASE I, OR CASE II WITH HEADER CURB USING TRUNCATED DOMES, DETECTABLE SURFACE, ON SURFACE.
4. MAJOR LOCAL PAVEMENT SHALL BE REPLACED PER COA STD. DWG. 2405. SEE SHEET 31.
5. CURB AND GUTTER REPLACEMENT SHALL BE PER COA STD. DWG. 2415A, SEE SHEET 2 NOTES.
6. STORM DRAIN INLETS SHALL BE PER COA STD. DWG. 2201. INLET GRATES WILL BE PER COA STD. DWG. 2220.
7. ALL PAVEMENT CUTS TO BE MADE PERPENDICULAR TO TRAFFIC FLOW. PAVEMENT CUTS AT CURB RADIUS WILL BE MADE RADIAL TO THE CURB.
8. NOT USED THIS SHEET
9. DRIVEPADS AFFECTED BY CONSTRUCTION SHALL BE RECONSTRUCTED PER COA STD. DWG. 2425.
10. VERIFY SEWER LATERAL CLEARANCE PRIOR TO INSTALLATION OF STORM DRAIN, TYP.
11. INSTALL WHEEL CHAIR RAMP PER COA STD. DWG. 2441, CASE I, OR CASE II WITH HEADER CURB USING TRUNCATED DOMES, DETECTABLE SURFACE, ON SURFACE.
12. 25' HALF CROWN TRANSITION PER COA STD. DWG. 2401.
13. 50' FULL CROWN TRANSITION PER COA STD. DWG. 2401.

RECORD DRAWINGS WERE PREPARED FROM INFORMATION PROVIDED BY THE CONTRACTOR

RECORD DRAWING
JUNE 2007
REV.11/17

2002-0021-28

LARKIN GROUP INC.
CONSULTING ENGINEERS AND SURVEYORS
8500 MENAUL BLVD. NE A-410
ALBUQUERQUE, NEW MEXICO 87112
(505) 275-7500 FAX (505) 275-0748

2002-0021

AS BUILT INFORMATION
CONTRACTOR New Mexico Underground
WORK PERFORMED BY Terra Land Surveys DATE 9/06
INSPECTORS ACCEPTANCE BY C.O.A. DATE 5/07
FIELD VERIFICATION BY Terra Land Surveys DATE 5/07
COORDINATES BY Larkin Group NM DATE 7/07
MICRO-FILM INFORMATION
RECORDED BY DATE
RECORDED BY DATE
RECORDED BY DATE

BENCH MARKS
CITY OF ALBUQUERQUE STATION 2-K12B
BEING A 3 1/4" ALUMINUM TABLET SET IN THE TOP OF CURB AT THE SOUTHEAST QUADRANT OF CENTRAL & ATRISCO SW
COORDINATES ARE MODIFIED GROUND VALUES
BASED ON NAD 27 U.S. SURVEY FEET
NORTHING = 1487200.64 PROJECT GRID FACTOR
EASTING = 370304.57 GF=0.999881630
ELEV. = 4954.92 NGVD 29

SURVEY INFORMATION
FIELD NOTES

NO.	BY	DATE
1		

ENGINEER'S SEAL
REGISTERED PROFESSIONAL ENGINEER
STATE OF NEW MEXICO
SAM A. ABBATE
13960

NO.	DATE	REMARKS	BY
1			
2			
3			
4			

REVISIONS

DESIGN
DESIGNED BY: XX
DRAWN BY: XX
CHECKED BY: XX

CITY OF ALBUQUERQUE
DEPARTMENT OF MUNICIPAL DEVELOPMENT
STORM DRAINAGE DESIGN DIVISION

TITLE: CENTRAL – ATRISCO DRAINAGE IMPROVEMENTS PHASE II
47th STREET STA. 2+00 TO 6+50

Design Review Committee: APPROVED JUN 08 2006 DESIGN REVIEW COMMITTEE
City Engineer Approval: APPROVED JUN 08 2006 CITY ENGINEER
Last Design Update | Mo./Day/Yr. | Mo./Day/Yr.

Project No. 674903 | Zone Map No. K-11-Z | Sheet 3 of 32