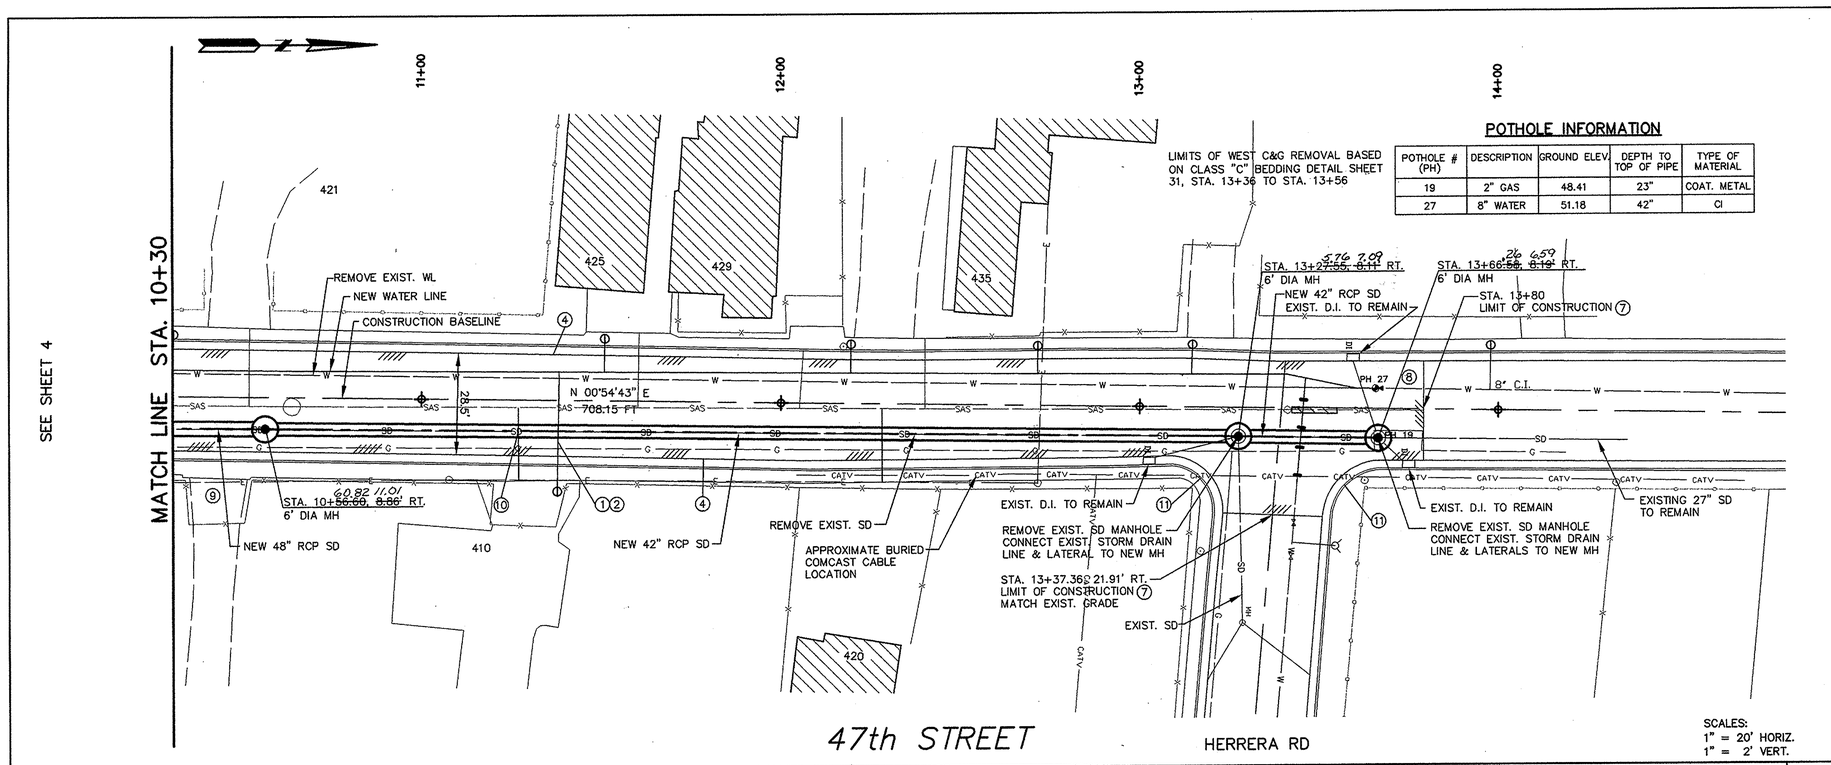

POTHOLE INFORMATION

POTHOLE # (PH)	DESCRIPTION	GROUND ELEV.	DEPTH TO TOP OF PIPE	TYPE OF MATERIAL
19	2" GAS	48.41	23"	COAT. METAL
27	8" WATER	51.18	42"	CI

SCALES:
1" = 20' HORIZ.
1" = 2' VERT.

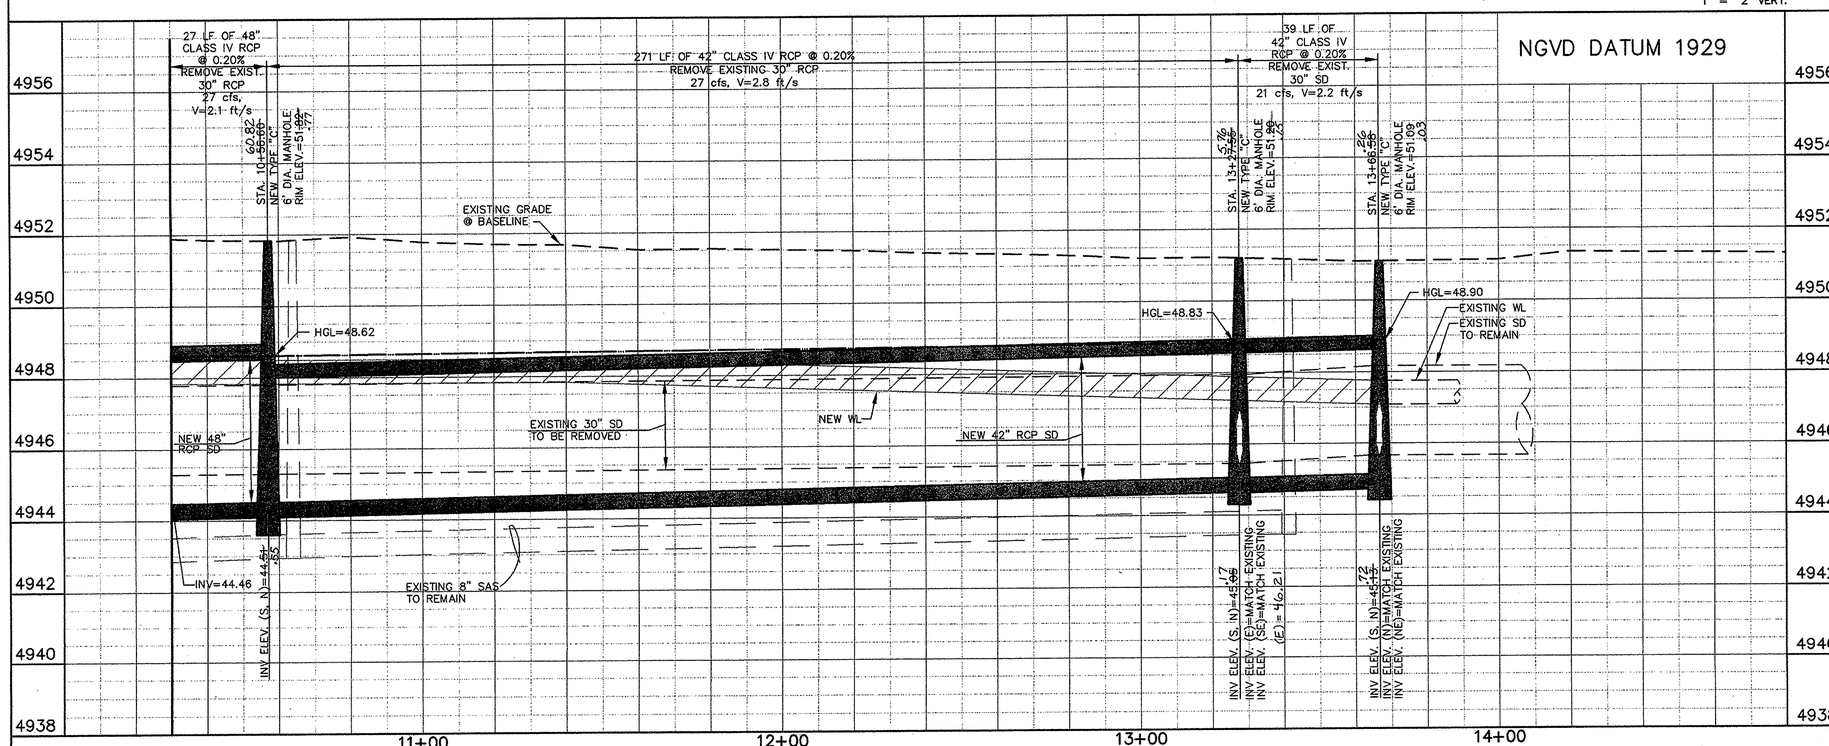

KEYED NOTES

1. REPLACED WATER SERVICE LINES SHALL BE REPLACED WITH COPPER TUBING WITH NO SPLICES FROM METER TO MAIN PER COA STD. DWG. 2362.
2. ANY EXISTING UTILITIES EXPOSED DURING CONSTRUCTION SHALL BE SUPPORTED AND PROTECTED DURING CONSTRUCTION. THIS SUPPORT AND PROTECTION SHALL BE CONSIDERED INCIDENTAL TO PROJECT CONSTRUCTION AND NO SEPARATE PAYMENT WILL BE MADE.
3. NOT USED THIS SHEET
4. MAJOR LOCAL PAVEMENT SHALL BE REPLACED PER COA STD. DWG. 2405. SEE SHEET 31.
5. NOT USED THIS SHEET
6. NOT USED THIS SHEET
7. ALL PAVEMENT CUTS TO BE MADE PERPENDICULAR TO TRAFFIC FLOW. PAVEMENT CUTS AT CURB RADIUS WILL BE MADE RADIAL TO THE CURB.
8. NOT USED THIS SHEET
9. NOT USED THIS SHEET
10. VERIFY SEWER LATERAL CLEARANCE PRIOR TO INSTALLATION OF STORM DRAIN, TYP.
11. INSTALL WHEEL CHAIR RAMP PER COA STD. DWG. 2441, CASE I, OR CASE II WITH HEADER CURB USING TRUNCATED DOMES, DETECTABLE SURFACE, ON SURFACE.
12. NOT USED THIS SHEET
13. NOT USED THIS SHEET

RECORD DRAWINGS WERE PREPARED FROM INFORMATION PROVIDED BY THE CONTRACTOR

RECORD DRAWING
JUNE 2007

AS BUILT INFORMATION
CONTRACTOR New Mexico Underground
WORK STAKED BY Terra Land Surveys DATE 9/06
INSPECTORS ACCEPTANCE BY C.O.A. DATE 5/07
FIELD VERIFICATION BY Terra Land Surveys DATE 5/07
DRAWINGS CORRECTED BY Larkin Group NM DATE 7/07
MICRO-FILM INFORMATION
RECORDED BY DATE
RECORDED BY DATE
RECORDED BY DATE

BENCH MARKS
CITY OF ALBUQUERQUE STATION 2-K12B
BEING A 3 1/4" ALUMINUM TABLET SET IN THE TOP OF CURB AT THE SOUTHEAST QUADRANT OF CENTRAL & ATRISCO SW
COORDINATES ARE MODIFIED GROUND VALUES BASED ON NAD 27 U.S. SURVEY FEET
NORTHING = 1487200.64 PROJECT GRID FACTOR
EASTING = 370304.57 GF=0.999681630
ELEV. = 4954.92 NGVD 29

SURVEY INFORMATION
FIELD NOTES

NO.	BY	DATE
1		

ENGINEER'S SEAL
PROFESSIONAL ENGINEER STATE OF NEW MEXICO NO. 13960 REGISTERED TIMOTHY A. ANDERSON

NO.	DATE	REVISIONS REMARKS	BY
1			
2			
3			
4			

DESIGN
DESIGNED BY: XX
DRAWN BY: XX
CHECKED BY: XX

2002-0021

LARKIN GROUP NM, INC.
CONSULTING ENGINEERS AND SURVEYORS
2500 MENAUL BLVD. NE A-140
ALBUQUERQUE, NEW MEXICO 87112
(505) 275-7500 FAX (505) 275-0748

CITY OF ALBUQUERQUE
DEPARTMENT OF MUNICIPAL DEVELOPMENT
STORM DRAINAGE DESIGN DIVISION

TITLE: CENTRAL – ATRISCO DRAINAGE IMPROVEMENTS PHASE II
47th STREET STA. 10+30 TO 14+00

Design Review Committee: APPROVED JUN 08 2006 DESIGN REVIEW COMMITTEE
City Engineer Approval: APPROVED JUN 08 2006 CITY ENGINEER
Last Design Update | Mo./Day/Yr. | Mo./Day/Yr.

Project No. 674903
Zone Map No. J-12-Z
Sheet 5 of 32