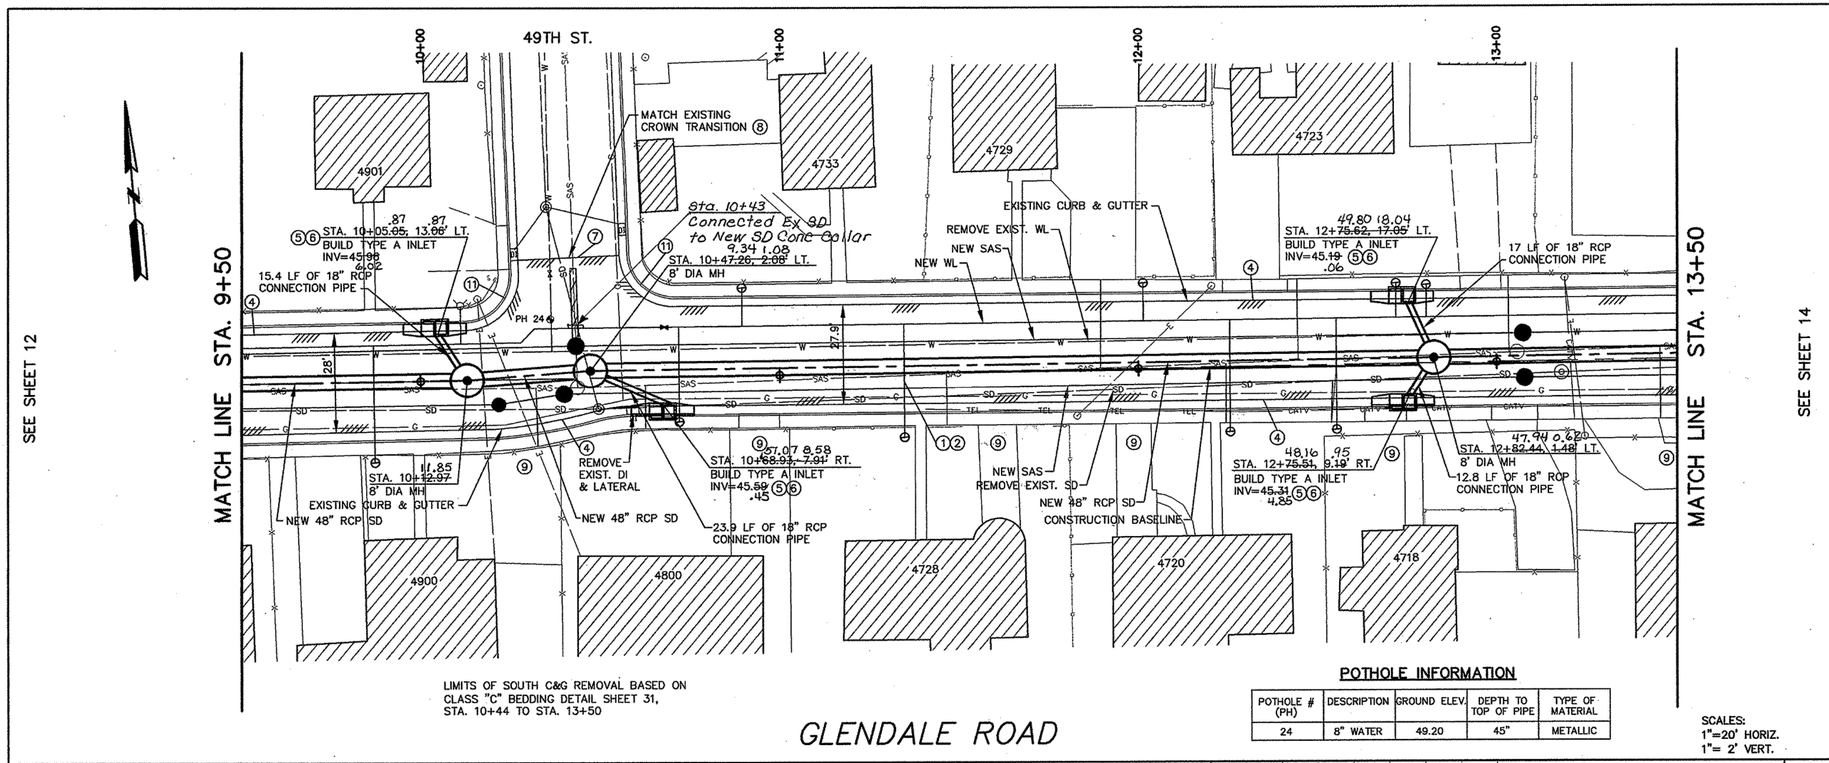

LIMITS OF SOUTH C&G REMOVAL BASED ON CLASS "C" BEDDING DETAIL SHEET 31, STA. 10+44 TO STA. 13+50

GLENDALE ROAD

POTHOLE INFORMATION

POTHOLE # (PH)	DESCRIPTION	GROUND ELEV.	DEPTH TO TOP OF PIPE	TYPE OF MATERIAL
24	8" WATER	49.20	45"	METALLIC

SCALES:
1"=20' HORIZ.
1"= 2' VERT.

KEYED NOTES

1. REPLACED WATER SERVICE LINES SHALL BE REPLACED WITH COPPER TUBING WITH NO SPLICES FROM METER TO MAIN PER COA STD. DWG. 2362.
2. ANY EXISTING UTILITIES EXPOSED DURING CONSTRUCTION SHALL BE SUPPORTED AND PROTECTED DURING CONSTRUCTION. THIS SUPPORT AND PROTECTION SHALL BE CONSIDERED INCIDENTAL TO PROJECT CONSTRUCTION AND NO SEPARATE PAYMENT WILL BE MADE.
3. NOT USED THIS SHEET.
4. MAJOR LOCAL PAVEMENT SHALL BE REPLACED PER COA STD. DWG. 2405. SEE SHEET 31.
5. CURB AND GUTTER REPLACEMENT SHALL BE PER COA STD. DWG. 2415A. SEE SHEET 2 NOTES.
6. STORM DRAIN INLETS SHALL BE PER COA STD. DWG. 2201. INLET GRATES WILL BE PER COA STD. DWG. 2220.
7. ALL PAVEMENT CUTS TO BE MADE PERPENDICULAR TO TRAFFIC FLOW. PAVEMENT CUTS AT CURB RADIUS WILL BE MADE RADIAL TO THE CURB.
8. PAVEMENT CROWN TRANSITIONS SHALL BE PER COA STD. DWG. 2401.
9. DRIVEPADS AFFECTED BY CONSTRUCTION SHALL BE RECONSTRUCTED PER COA STD. DWG. 2425.
10. NOT USED THIS SHEET.
11. INSTALL WHEEL CHAIR RAMP PER COA STD. DWG. 2441, OR CASE II WITH HEADER CURB USING TRUNCATED DOMES, DETECTABLE SURFACE, ON SURFACE.
12. NOT USED THIS SHEET.
13. NOT USED THIS SHEET.

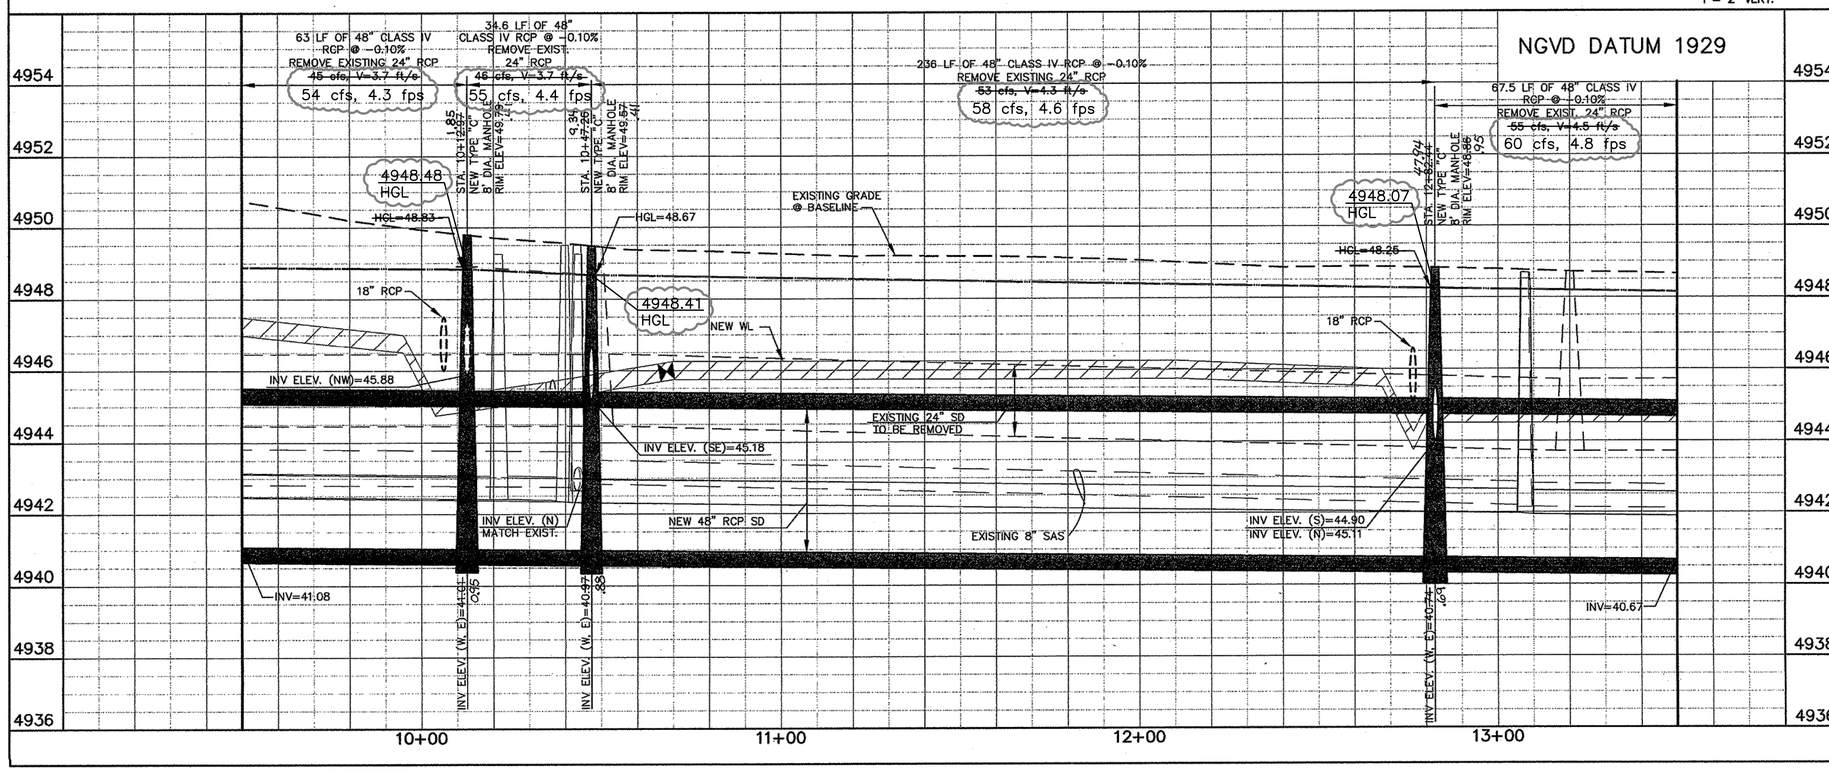

RECORD DRAWINGS WERE PREPARED FROM INFORMATION PROVIDED BY THE CONTRACTOR

RECORD DRAWING
JUNE 2007
REV.11/17

2002-0021-28

LARKIN GROUP INC.
CONSULTING ENGINEERS AND SURVEYORS
8500 MENAUL BLVD. NE A-410
ALBUQUERQUE, NEW MEXICO 87112
(505) 275-7500 FAX (505) 275-0748

2002-0021

CITY OF ALBUQUERQUE
DEPARTMENT OF MUNICIPAL DEVELOPMENT
STORM DRAINAGE DESIGN DIVISION

TITLE: CENTRAL – ATRISCO DRAINAGE IMPROVEMENTS PHASE II
GLENDALE ROAD STA. 9+50 TO 13+50

Design Review Committee: APPROVED JUN 08 2006 DESIGN REVIEW COMMITTEE
City Engineer Approval: APPROVED JUN 08 2006 CITY ENGINEER

Last Design Update | Mo./Day/Yr. | Mo./Day/Yr.

Project No. 674903 | Zone Map No. K-11-Z | Sheet 13 of 32

AS BUILT INFORMATION
CONTRACTOR New Mexico Underground DATE 9/06
WORK STAKED BY Terra Land Surveys DATE 5/07
ACCEPTANCE BY C.O.A.
FIELD VERIFICATION BY Terra Land Surveys DATE 5/07
DRAWINGS CORRECTED BY Larkin Group NM DATE 7/07
MICRO-FILM INFORMATION
RECORDED BY DATE
RECORDED BY DATE
RECORDED BY DATE

BENCH MARKS
CITY OF ALBUQUERQUE STATION 2-K12B
BEING A 3 1/4" ALUMINUM TABLET SET IN THE TOP OF CURB AT THE SOUTHEAST QUADRANT OF CENTRAL & ATRISCO SW
COORDINATES ARE MODIFIED GROUND VALUES BASED ON NAD 27 U.S. SURVEY FEET
NORTHING=1487200.64 PROJECT GRID FACTOR
EASTING=370304.57 GF=0.999681630
ELEV.=4954.92 NGVD 29

SURVEY INFORMATION
FIELD NOTES

NO.	BY	DATE
1		

ENGINEER'S SEAL
REGISTERED PROFESSIONAL ENGINEER STATE OF NEW MEXICO 10360 JOHN A. MORRIS

NO.	DATE	REMARKS	BY
4			
3			
2			
1			

REVISIONS

DESIGN
DESIGNED BY: XX
DRAWN BY: XX
CHECKED BY: XX