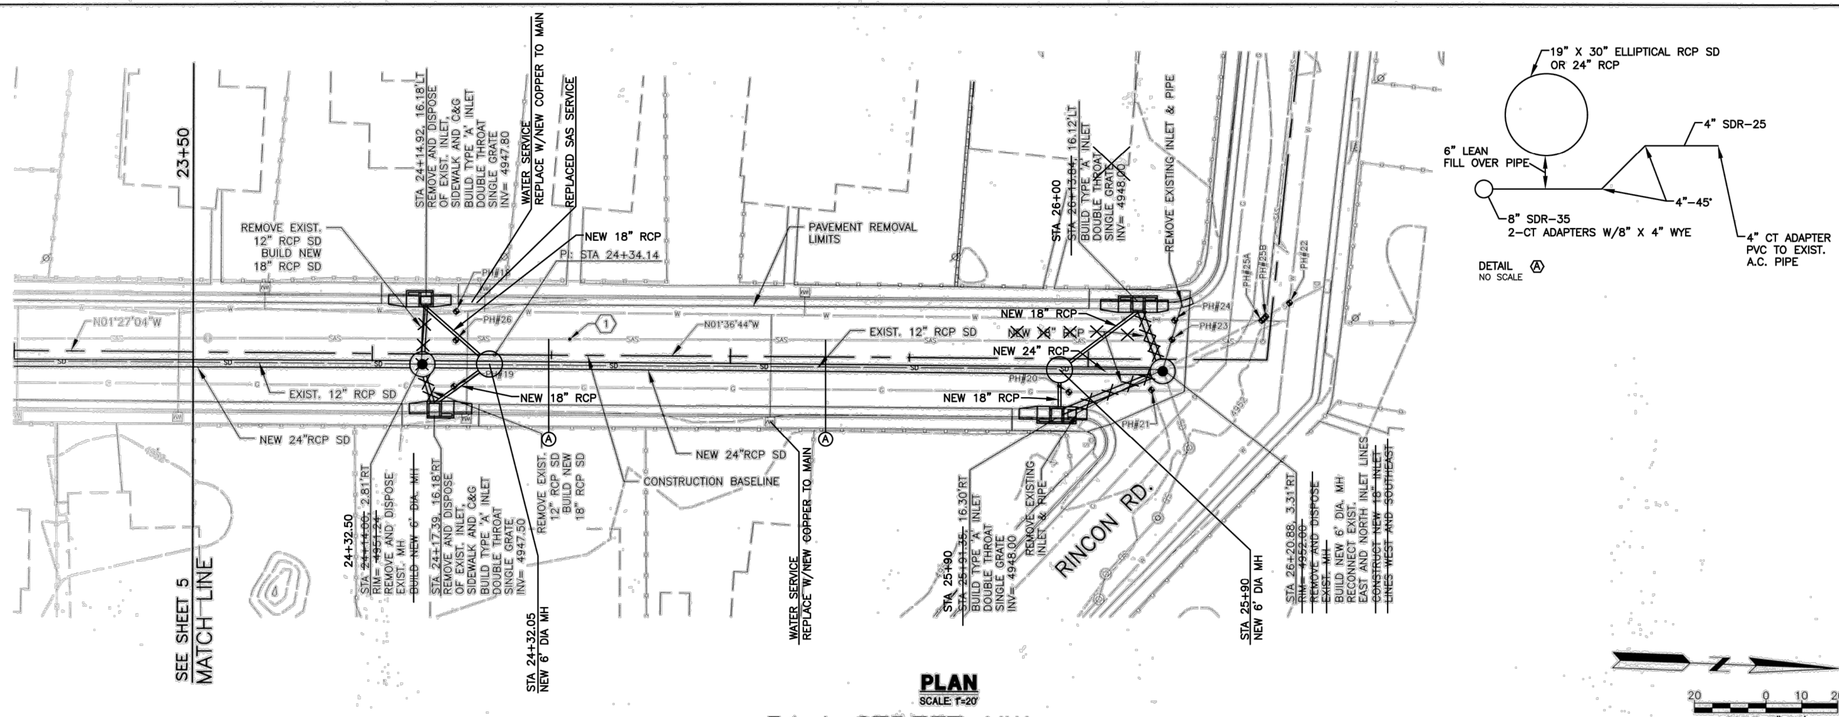

PLAN
SCALE: 1"=20'

51st STREET NW

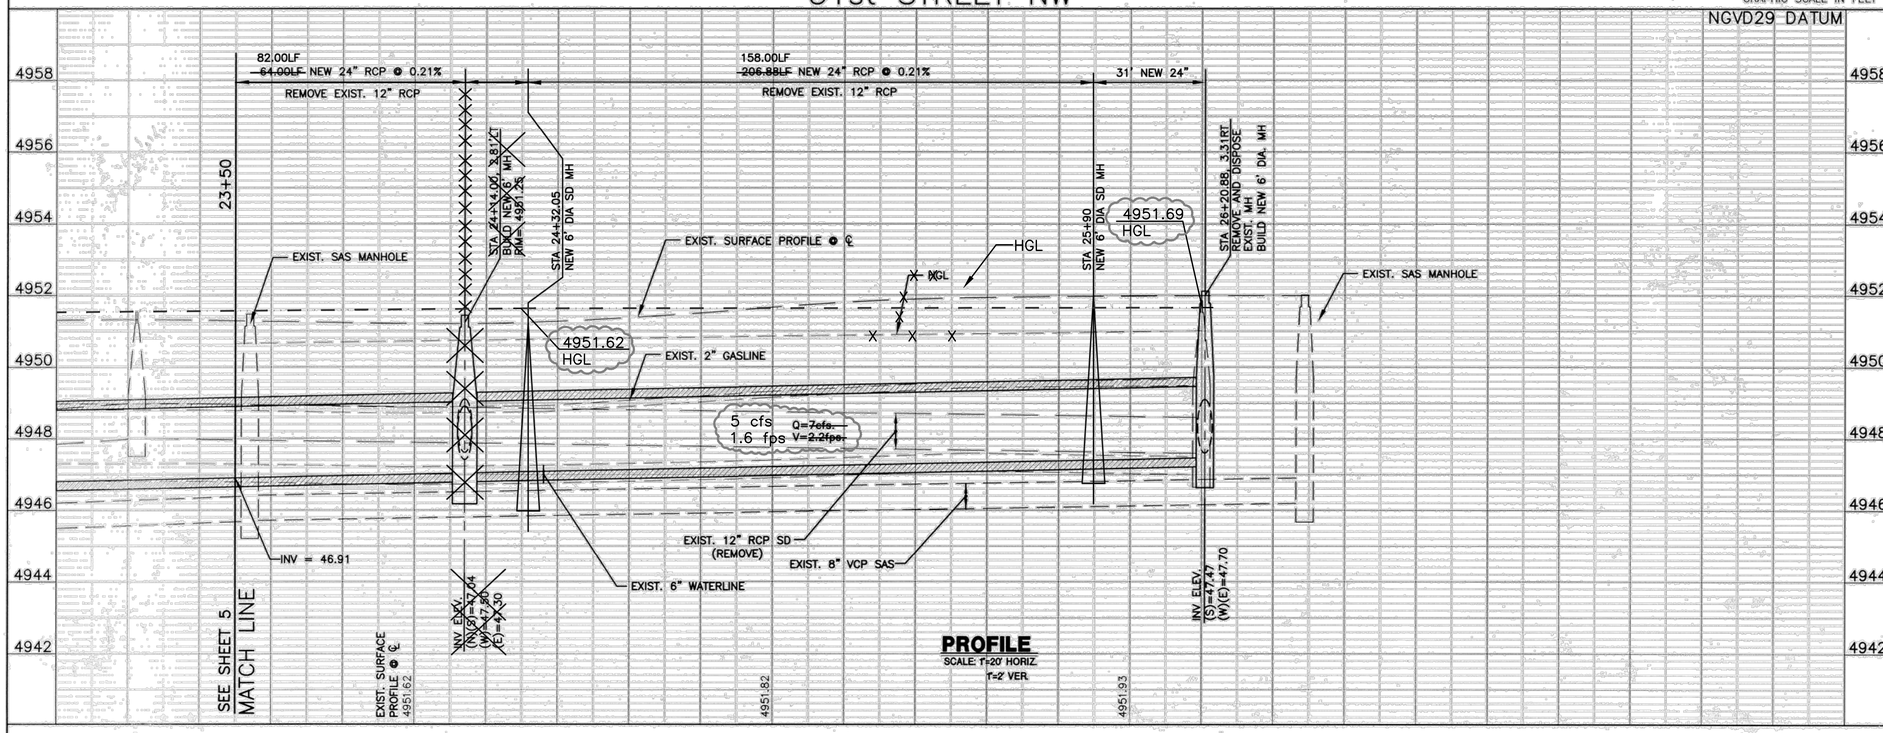

PROFILE
SCALE: ~~T=20'~~ HORIZ
~~T=2'~~ VER

KEYED NOTES

1. 8" VCP SERVICE TO VCP MAIN REPAIR PER DETAIL SHEET 11.

Ⓐ SAS SERVICE SEE DETAIL Ⓐ

POTHOLE INFORMATION

POTHOLE # (PH)	TYPE & MATERIAL	GROUND ELEV.	DEPTH TO TOP OF PIPE
18	WATER/METALIC	4951.16	46"
19	GAS/METALIC	4951.76	28"
20	GAS/METALIC	4951.97	35"
21	GAS/METALIC	4952.20	33"
22	STORM/CONCRETE	4952.27	26"
23	SAS/CONCRETE	4952.09	58"
24	WATER/PVC	4951.91	52"
25A	SAS/CONCRETE	4952.32	62"
25B	STORM/CONCRETE	4952.40	29"
26	SAS/CONCRETE	4951.55	63"

* PIPE SIZES & TYPES ARE BEST ESTIMATE TO BE CONFIRMED BY CONTRACTOR.

NOTES

A. ANY WATER SERVICE LINES THAT NEED TO BE REPLACED SHALL BE REPLACED WITH COPPER TUBING AND NO SPLICES FROM METER TO MAIN. AS PER COA STD DWG. 2362

B. ANY EXITING UTILITIES EXPOSED DURING CONSTRUCTION SHALL BE SUPPORTED AND PROTECTED DURING CONSTRUCTION. THIS SUPPORT AND PROTECTION SHALL BE CONSIDERED INCIDENTAL TO PROJECT CONSTRUCTION AND NO SEPARATE PAYMENT WILL BE MADE.

C. THE DISTURBANCE OF ANY EXISTING WHEELCHAIR RAMP DURING CONSTRUCTION WILL REQUIRE THE REPLACEMENT OF THE ENTIRE WHEELCHAIR RAMP. AS PER COA STD DWG 2441. CASE I, OR CASE II WITH HEADER CURB.

D. RESIDENTIAL PAVEMENT WILL BE REPLACED AS PER COA STD DWG 2465 (RESIDENTIAL).

E. CURB AND GUTTER WILL BE REPLACED AS PER COA STD DWG 2451A.

F. STORM DRAIN INLETS WILL BE AS PER COA STD DWG 2201. WITH GRATES AS PER COA STD DWG 2220.

G. ALL PAVEMENT CUTS TO BE MADE PERPENDICULAR TO TRAFFIC FLOW. PAVEMENT CUTS AT A CURB RADIUS WILL BE MADE RADIAL TO THE CURB.

H. SIDEWALKS WILL BE REPLACED AS PER COA STD DWG 2430.

I. DISTURBED DRIVEPADS WILL BE REPLACED AS PER COA STD DWG 2425.

J. ALL RCP SHALL BE CLASS IV UNLESS OTHERWISE NOTED.

RECORD DRAWINGS WERE PREPARED FROM INFORMATION PROVIDED BY THE CONTRACTOR

RECORD DRAWING
APRIL 2017
REV.11/17

2002-0021-28
LARKIN GROUP, N.M.
8500 MENAUL NE. SUITE A-440
ALBUQUERQUE, NEW MEXICO 87112
(505) 275-7500, FAX (505) 275-0748
ENGINEER'S FILE No. 2002-0021-19

SURVEY INFORMATION

NO.	FIELD NOTES BY	DATE

AS BUILT INFORMATION

BENCH MARKS

ALBUQ. CONTROL SURVEY STATION "NM_448_C1"
STATION IS LOCATED IN MEDIAN OF CENTRAL AVE., WEST OF 59th STREET. THE STATION IS A NMSHC BRASS DISC SET FLUSH IN THE TOP OF A CONC. POST AND IS STAMPED "NM448-C1"
NEW MEXICO STATE PLANE COORD. CENTRAL ZONE
X=364,764.30, Y=1485275.17, (NAD 27)
ELEVATION= 5074.928 (NGVD 29)
PROJECT G-S FACTOR: 0.999681630

	CONTRACTOR	DATE
	WORK STAKED BY	
	INSPECTOR'S FIELD NOTATION BY	DATE
	FIELD VERIFICATION BY	DATE
	DRAWINGS CONNECTED BY	DATE

MICRO-FILM INFORMATION

	RECORDED BY	DATE
	RECORDED BY	DATE
	RECORDED BY	DATE

ENGINEER'S SEAL

JOHN A. ANDREE
NEW MEXICO
No. 9960
REGISTERED PROFESSIONAL ENGINEER
STATE OF NEW MEXICO
8-18-15

NO.	DATE	REVISIONS	BY
4			
3			
2			
1		DESIGN	
		DESIGNED BY: JAA	DATE: AUG. 2015
		DRAWN BY: CAL/TL	DATE: AUG. 2015
		CHECKED BY: JAA	DATE: AUG. 2015

CITY OF ALBUQUERQUE
DEPARTMENT OF MUNICIPAL DEVELOPMENT
ENGINEERING DIVISION

TITLE: CENTRAL-ATRISCO DRAINAGE IMPROVEMENTS PHASE III
PLAN AND PROFILE 51st STREET
STA 23+50 TO 26+50

Design Review Committee	City Engineer Approval	Last Design Update	Mo./Day/Yr.	Mo./Day/Yr.
APPROVED	APPROVED			

Project No. 6749.04 | Zone Map No. K-11,J-11 | Sheet 6 of 14