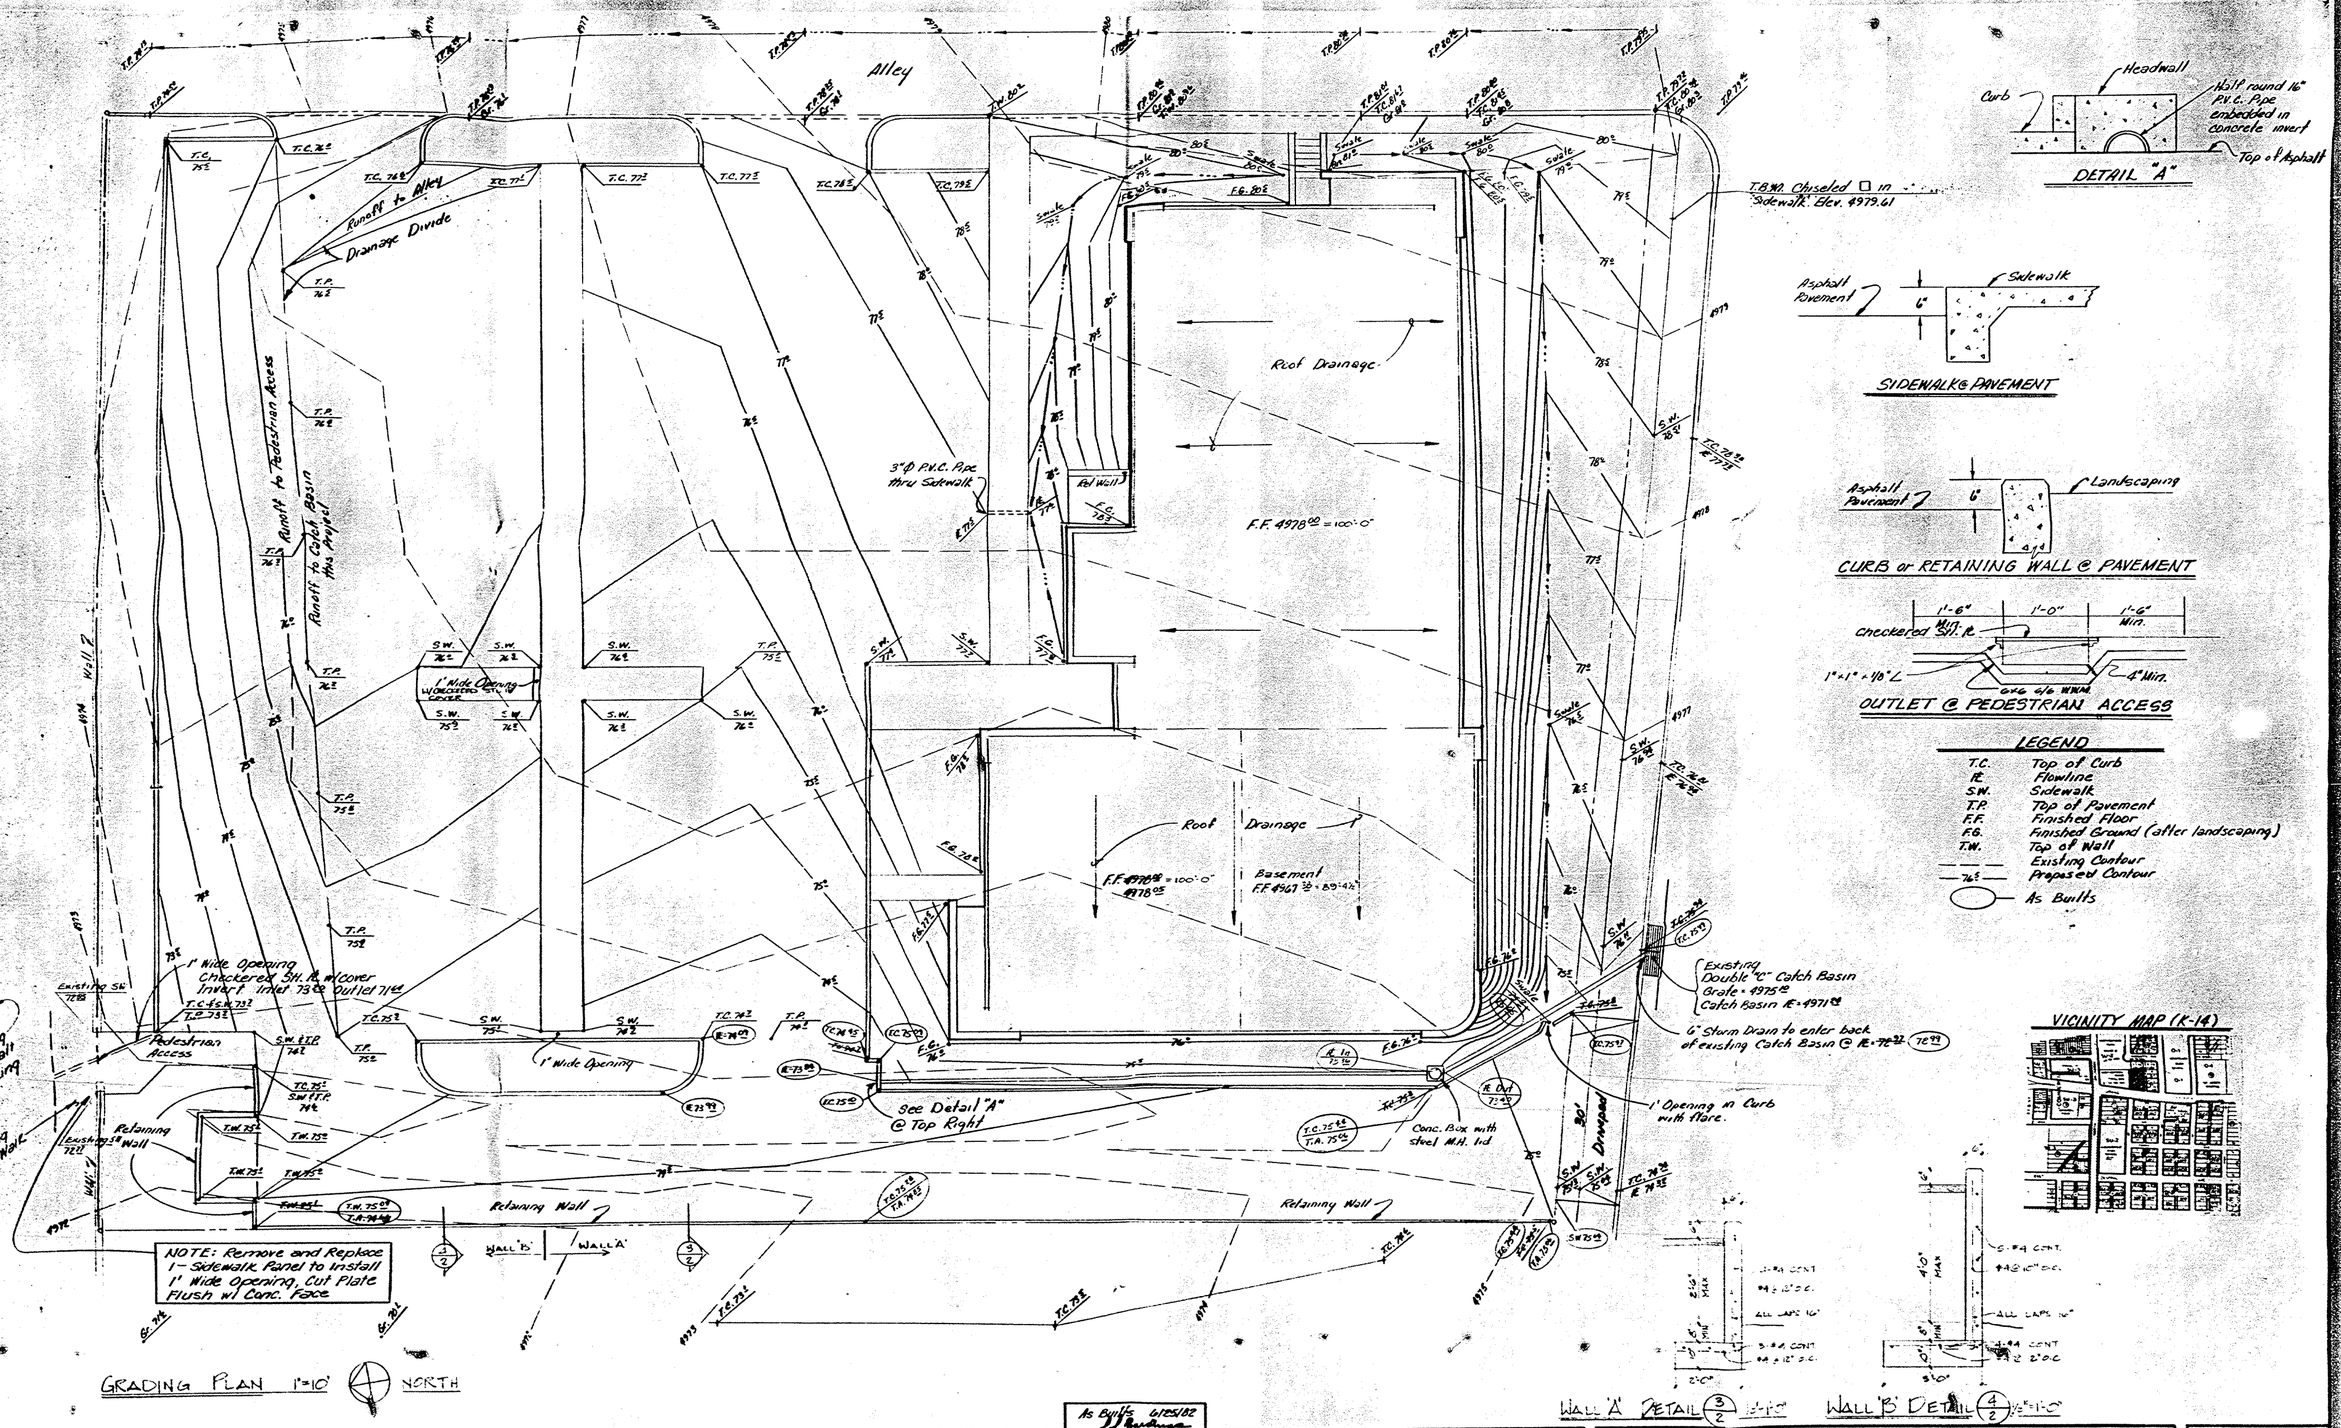

LEGEND

T.C.	Top of Curb
R.	Flowline
S.W.	Sidewalk
T.P.	Top of Pavement
F.F.	Finished Floor
F.G.	Finished Ground (after landscaping)
T.W.	Top of Wall
— — —	Existing Contour
— 76 —	Proposed Contour
◯	As Builts

VICINITY MAP (K-14)

Alan Rex & Associates, Architects 505/344-2614
2709-J PAN AMERICAN FWY, N.E.
ALBUQUERQUE, NEW MEXICO 87107

Architect

Engineer: As Builts 6/25/82 — REVISED 1/4/82 — Grading & Topo

Job Number: 80-23
Date: 9 NOV 1981
Drawn By
Checked By
Approved By

Revisions: PER ALB R

Project Title: 405 Partnership Building
405 Grand Avenue, N.E.
Sheet Title: GRADING PLAN

Sheet 2 of 23