HYDROLOGY K14/D5a 2 PLANS

K14/D5a

2 PLANS

D 24 C 20 B 16 A 12 CITY OF ALBUQUERQUE C D

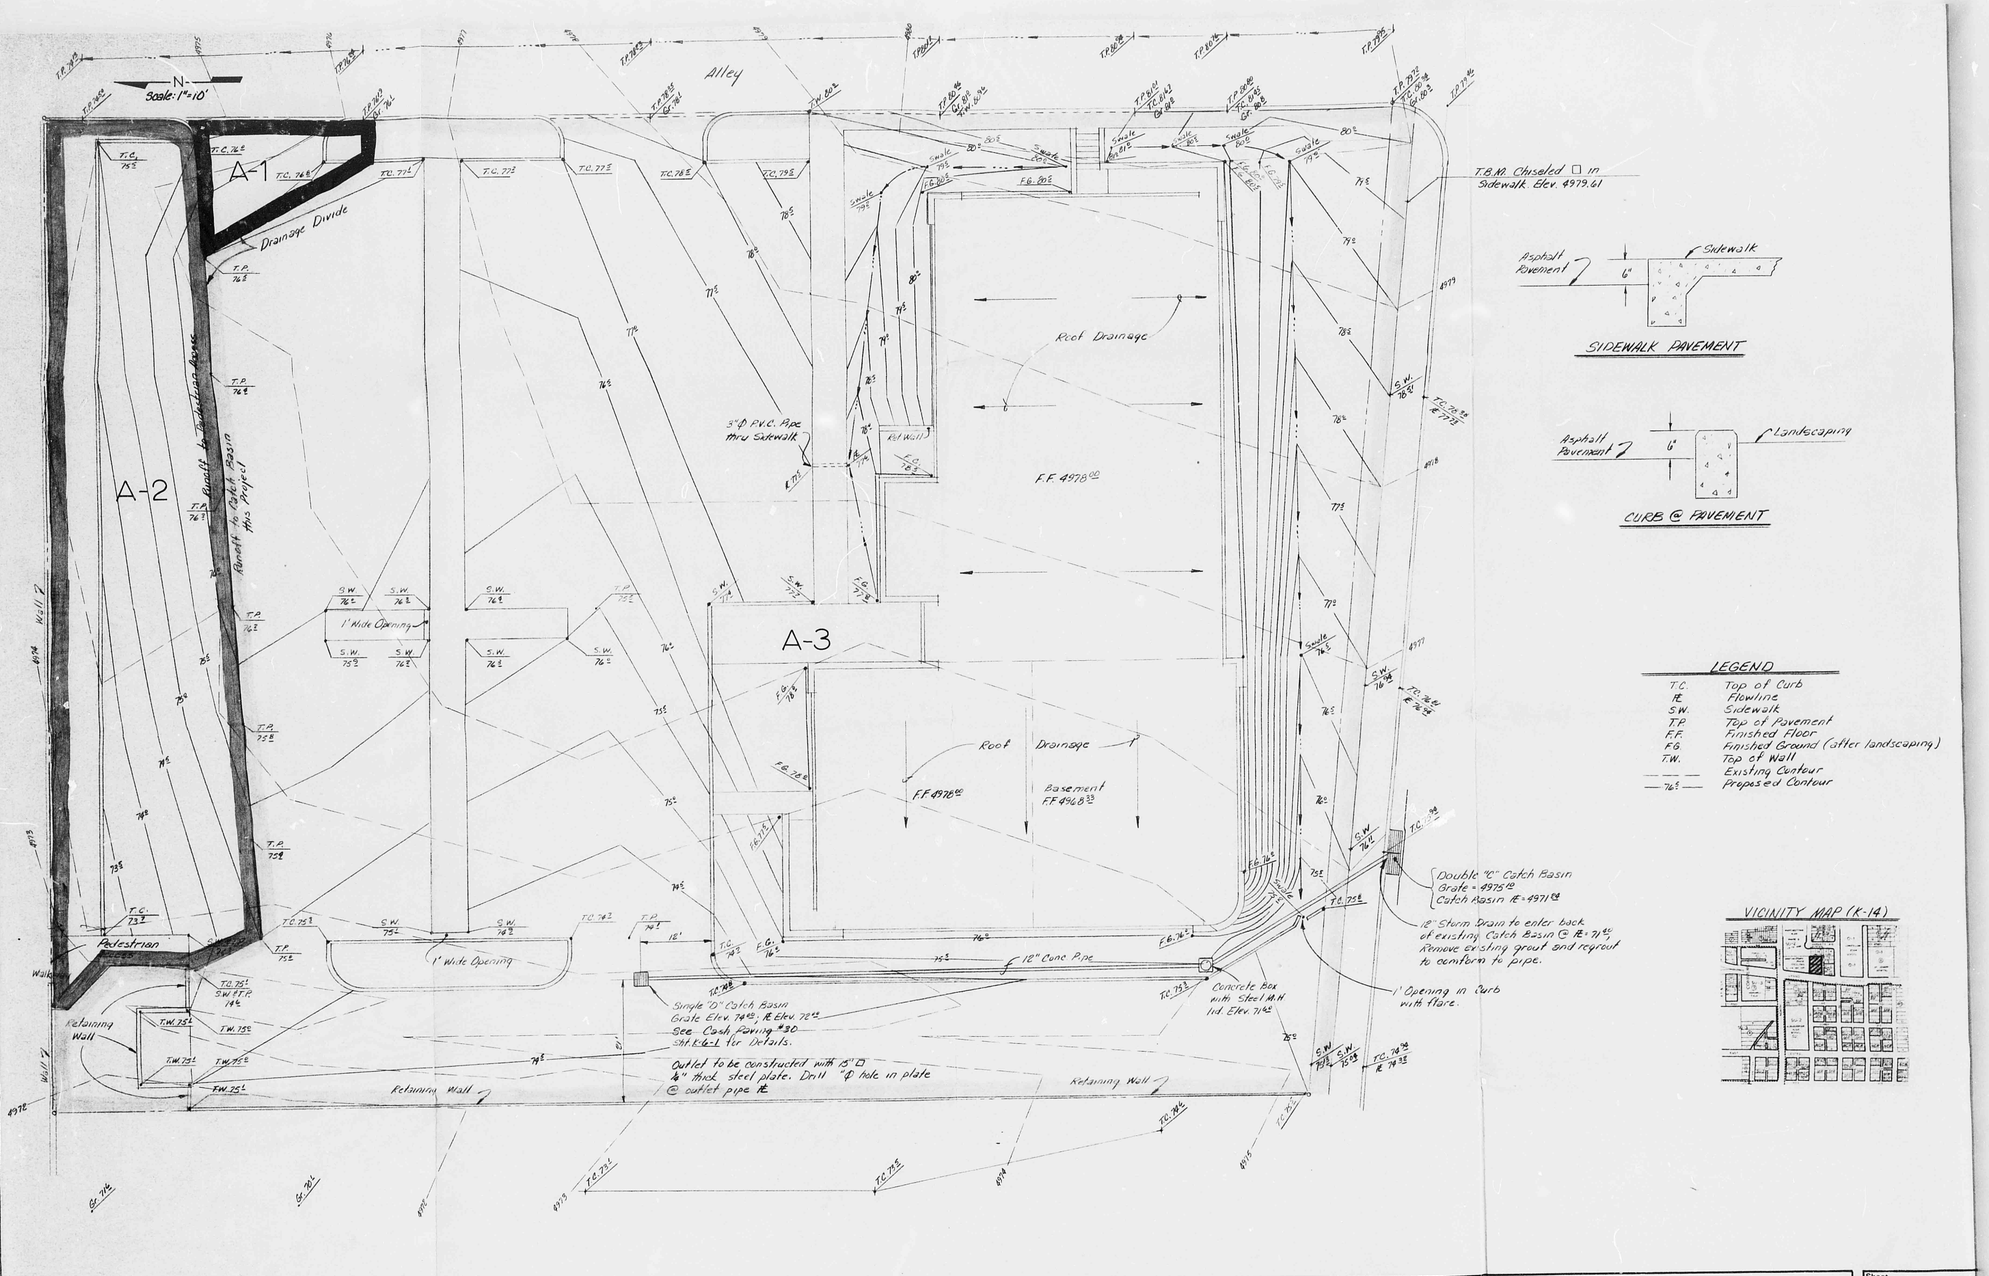

Alan Rex & Associates, Architects 505/344-2614
2709-J PAN AMERICAN FWY., N.E.
ALBUQUERQUE, NEW MEXICO 87107

Architect	Engineer	Job Number	Revisions	Project Title	Sheet
	Grading & Topo	Date / Drawn By / Checked By / Approved By		Sheet Title	PLATE III / Of

CITY OF ALBUQUERQUE

CITY OF ALBUQUERQUE
THIS MICROIMAGE IS THE BEST POSSIBLE REPRODUCTION DUE TO THE POOR QUALITY OF THE ORIGINAL DOCUMENT

D 24 C 20 B 16 A 12 C D

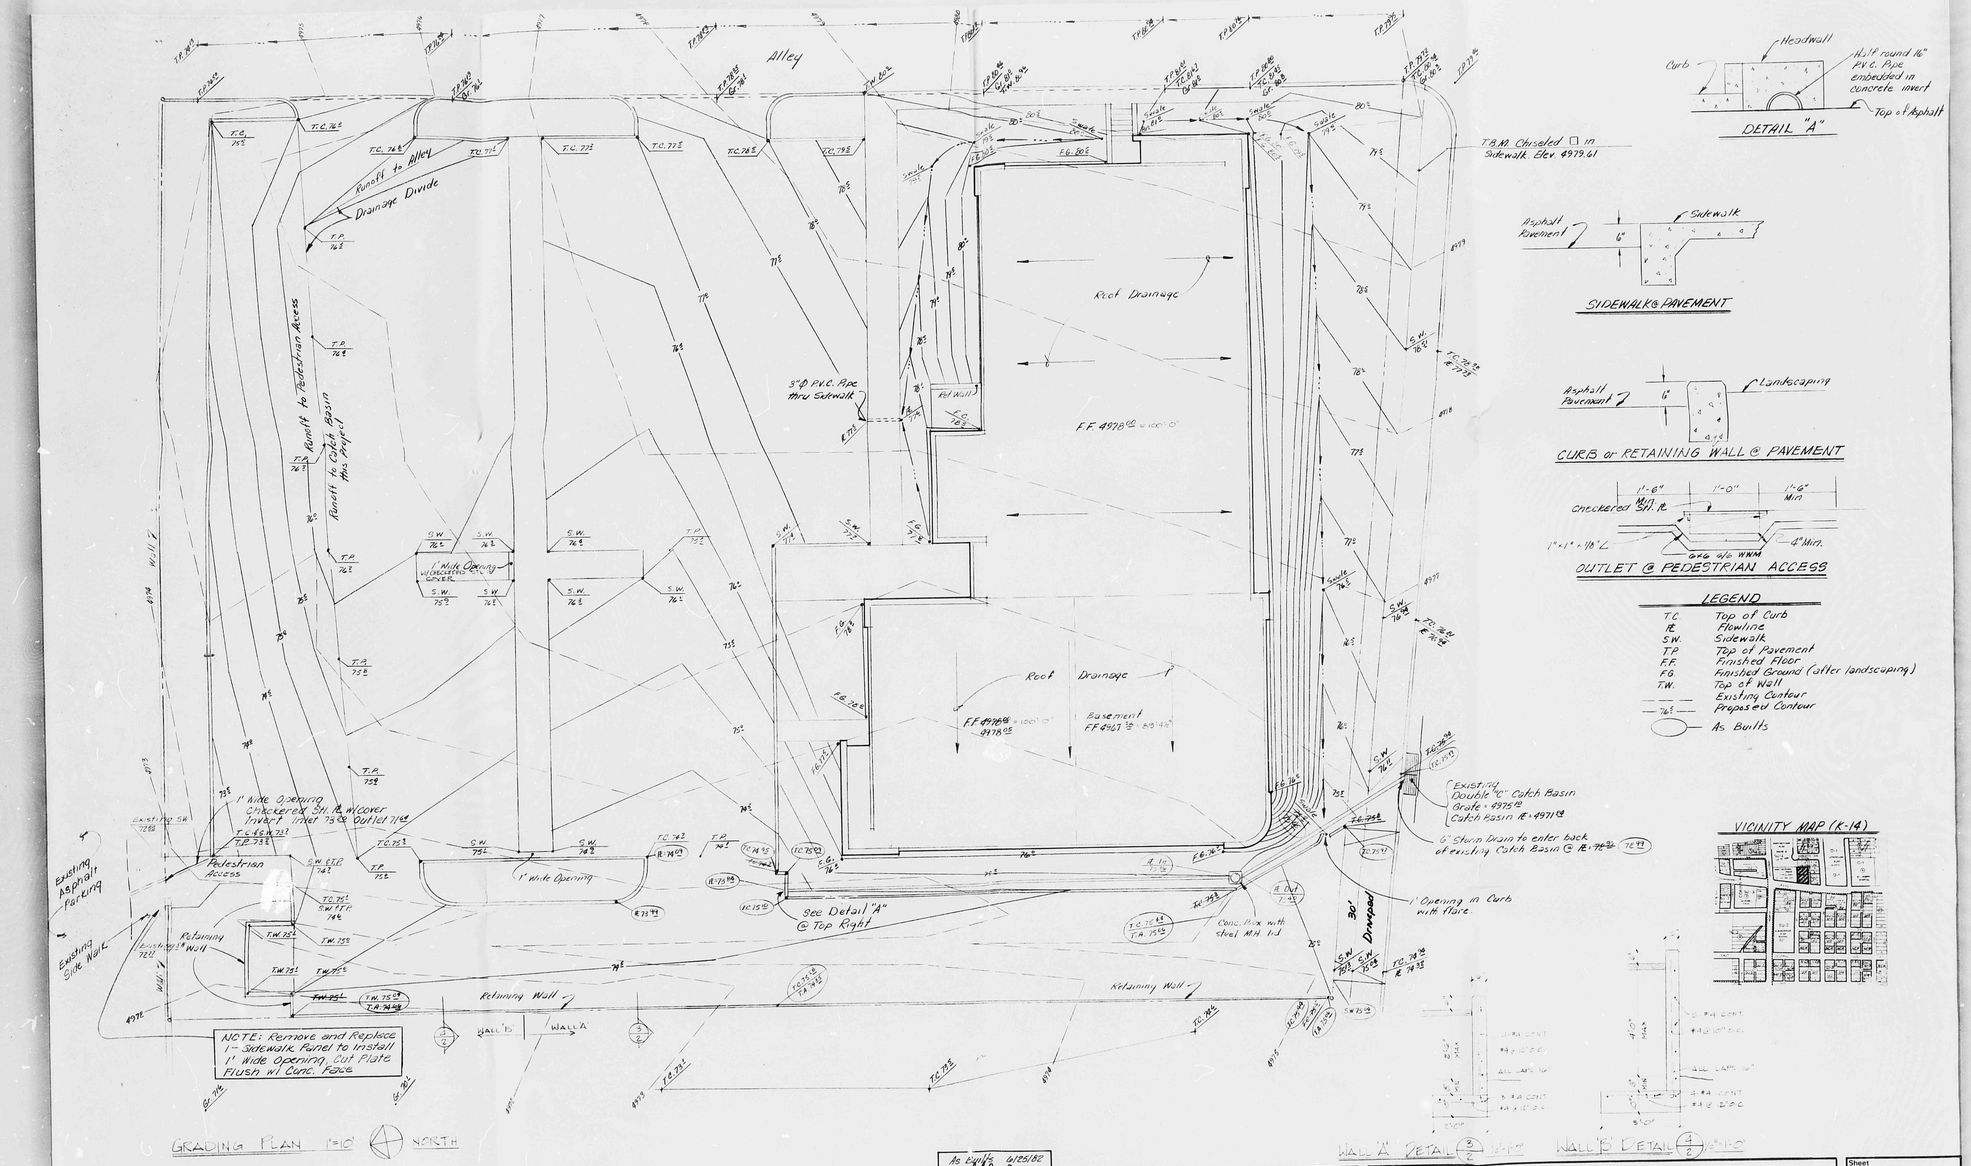

LEGEND

T.C.	Top of Curb
F.E.	Flowline
S.W.	Sidewalk
T.P.	Top of Pavement
F.F.	Finished Floor
F.G.	Finished Ground (after landscaping)
T.W.	Top of Wall
— — —	Existing Contour
—76—	Proposed Contour
◯	As Builts

VICINITY MAP (K-14)

CITY OF ALBUQUERQUE
THIS MICROIMAGE IS THE BEST POSSIBLE REPRODUCTION DUE TO THE POOR QUALITY OF THE ORIGINAL DOCUMENT

Alan Rex & Associates, Architects 505/344-2614
2709-J PAN AMERICAN FWY., N.E.
ALBUQUERQUE, NEW MEXICO 87107

Architect

As Built 6/25/82
Engineer REVISED 1/4/82
Grading & Topo

Job Number 80-23
Date 9 NOV 1981
Drawn By
Checked By
Approved By

Revisions
REV PER ALL #'S

Project Title
405 Partnership Building
405 Grand Avenue, N.E.
Sheet Title
GRADING PLAN

Sheet 2
Of 23

D 24 C 20 B 16 A 12

CITY OF ALBUQUERQUE

C D