

PROJECT TITLE: Barelas Court Townhomes ZONE ATLAS/DRNG. FILE #: K-14 / 1042

CITY ADDRESS: (Book C37, Page 135) 736 Barelas Court, SW

ADDRESS: 5801 Osuna NE. #204 87109 PHONE: 881-5357

**ADDRESS** P.O. Box 1293 **PHONE:** 768-4500

**ADDRESS:** 105 4th St. SW **PHONE:** 843-9639

**ADDRESS:** 145 Eubank NE **PHONE:** 293-1205

**ADDRESS:** 3535 Princeton NE **PHONE:** 884-6234

RECEIVED  
MAR 14 1989  
HYDROLOGY SECTION

DRB NO. 88-430

EPC NO. SD-76-6-112-88-75

**PROJECT NO. 3683 - HYDROLOGY SECTION**

**CHECK TYPE OF APPROVAL SOUGHT:**

           SKETCH PLAT APPROVAL

           PRELIMINARY PLAT APPROVAL

\_\_\_\_\_ CONCEPTUAL GRADING & DRAIN. PLAN \_\_\_\_\_ SITE DEVELOPMENT PLAN APPROVAL

X FINAL PLAT APPROVAL

           **BUILDING PERMIT APPROVAL**

           FOUNDATION PERMIT APPROVAL

           **CERTIFICATE OF OCCUPANCY APPROVAL**

           **ROUGH GRADING PERMIT APPROVAL**

           GRADING/PAVING PERMIT APPROVAL


**OTHER \_\_\_\_\_ (SPECIFY)**

BY: James O'Sonemus

## DRAINAGE INFORMATION SHEET

PROJECT TITLE: Barelas Court ZONE ATLAS/DRNG. FILE #: K-14/D42LEGAL DESCRIPTION: Tract A of the lands of SANCHEZ/CHAVEZ, filed Oct. 19, 1988(Book C37, Page 135)  
CITY ADDRESS: Barelas Court, SWENGINEERING FIRM: AVID Engineering, Inc. CONTACT: James DomenickADDRESS: 5801 Osuna Rd., NE PHONE: 881-5357OWNER: City of Albuquerque CONTACT: Sylvia FettesADDRESS P.O. Box 1293 PHONE: 768-4500ARCHITECT: Design Collaborative CONTACT: Marc SchiffADDRESS: 105 Fourth St., SW PHONE: 843-9639SURVEYOR: Wayjohn Surveying CONTACT: Wayne JohnsonADDRESS: 145 Eubank, NE PHONE: 293-1205CONTRACTOR: S & J Enterprises CONTACT: Ron CarterADDRESS: 3535 Princeton, NE PHONE: 884-6234

PRE-DESIGN MEETING

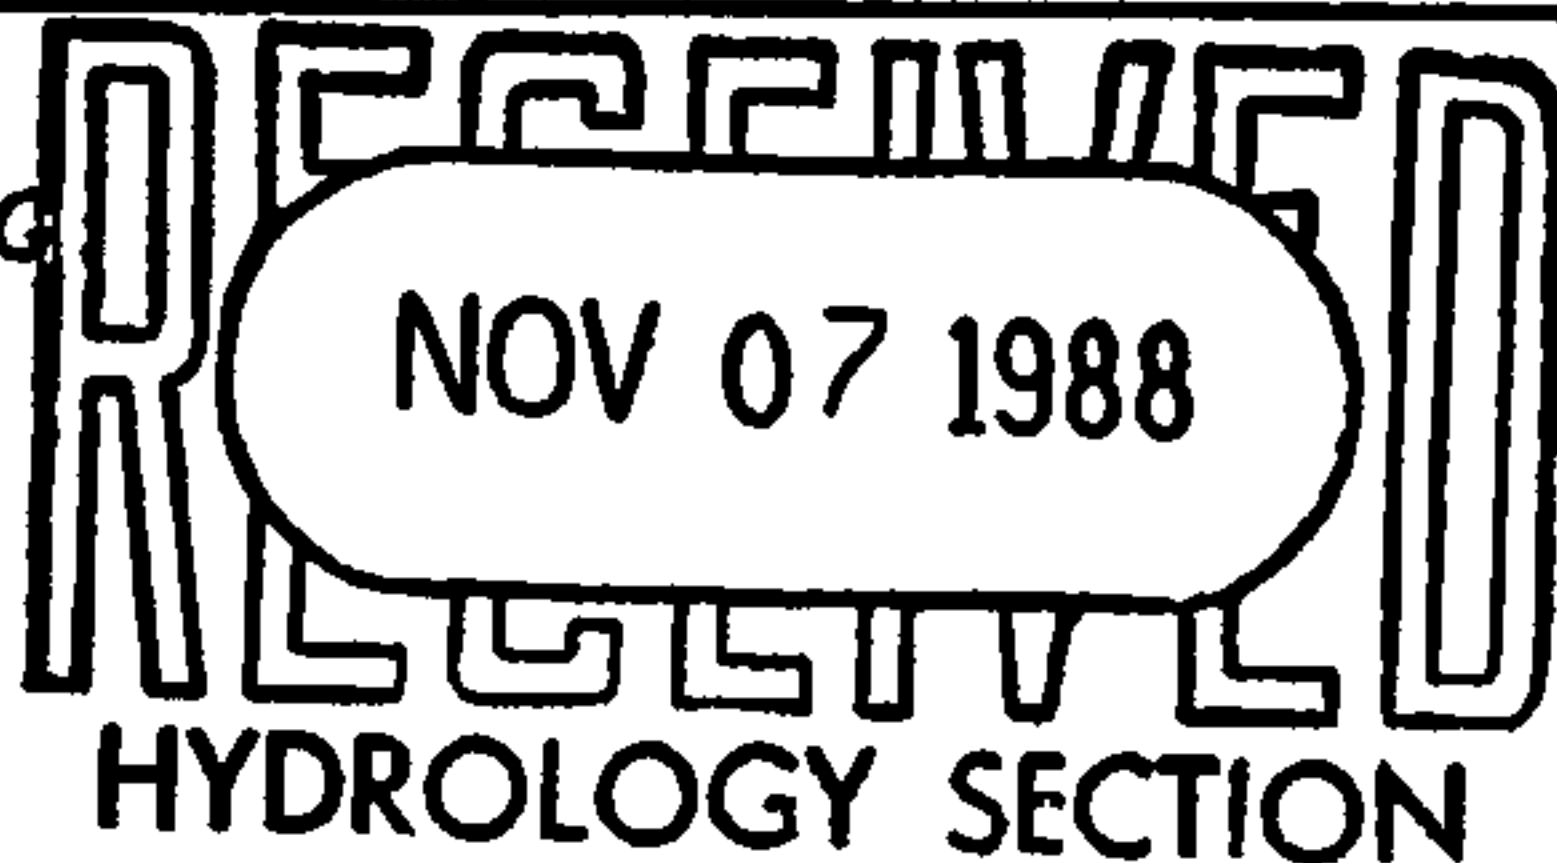☒ YES☐ NO☒ COPY OF CONFERENCE RECAP  
SHEET PROVIDEDDRB NO. 88-430EPC NO. SD-76-6-1/Z-88-75PROJECT NO. None

WP+935

TYPE OF SUBMITTAL:

☒ DRAINAGE REPORT☐ DRAINAGE PLAN☐ CONCEPTUAL GRADING & DRAIN. PLAN☐ GRADING PLAN☐ EROSION CONTROL PLAN☐ ENGINEER'S CERTIFICATION

CHECK TYPE OF APPROVAL SOUGHT:

☐ SKETCH PLAT APPROVAL☒ PRELIMINARY PLAT APPROVAL☒ SITE DEVELOPMENT PLAN APPROVAL☐ FINAL PLAT APPROVAL☐ BUILDING PERMIT APPROVAL☐ FOUNDATION PERMIT APPROVAL☐ CERTIFICATE OF OCCUPANCY APPROVAL☐ ROUGH GRADING PERMIT APPROVAL☐ GRADING/PAVING PERMIT APPROVAL

OTHER \_\_\_\_\_ (SPECIFY)

DATE SUBMITTED: 11/8/88BY: James Domenick

CITY OF ALBUQUERQUE  
MUNICIPAL DEVELOPMENT DEPARTMENT  
ENGINEERING DIVISION/DESIGN HYDROLOGY SECTION

CONFERENCE RECAP

DRAINAGE FILE/ZONE ATLAS PAGE NO.: K14 DATE: 10/5/88  
PLANNING DIVISION NOS: EPC: \_\_\_\_\_ DRB: 88-4-10  
SUBJECT: SL 76-6-1 / Z 14-75  
STREET ADDRESS (IF KNOWN): 1000 S. 10th St. (Rising + 11th)  
SUBDIVISION NAME: Dapper Court (Tract 39A MERGED MAP N +)

APPROVAL REQUESTED:

<input checked="" type="checkbox"/> PRELIMINARY PLAT	_____ FINAL PLAT
<input checked="" type="checkbox"/> SITE DEVELOPMENT PLAN	_____ BUILDING PERMIT
_____ OTHER	_____ ROUGH GRADING

	WHO	REPRESENTING
ATTENDANCE:	<u>Jim Domenich</u>	<u>AVID ENG</u>
	<u>RUAN BACIGALUPE</u>	<u>AVID ENG</u>
	<u>JOE JENKINS</u>	<u>DESIGN CONSULTANTS OF</u>
	<u>FRED J. AGUIRRE</u>	<u>CITY</u>

FINDINGS:

Site Development Plan Approval:

- ALL APPROVED CONCEPTUAL GRADING + DRAINAGE PLAN FOR CITY ENGINEER'S SIGN OFF
- PUNDING NOT REQUIRED FOR THE FOLLOWING REASONS:
  - THIS IS AN IN-USE SITE (Z. 14-75) THE WATER, OR IF NOT, DRAINAGE
  - A STORM DRAIN SYSTEM (S) IS MAINTAINED DOWNSIDE OF THE DEVELOPMENT (18" RCP)
- MAJOR CONCERN THAT MUST BE ADDRESSER ARE OVER-SIDE FLOWS.

Preliminary Plat Approval:

- AN APPROVED DRAINAGE REPORT


The undersigned agrees that the above findings are summarized accurately and are only subject to change if further investigation reveals that they are not reasonable or that they are based on inaccurate information.

SIGNED: [Signature]  
TITLE: [Signature]  
DATE: 10/5/88


SIGNED: [Signature]  
TITLE: [Signature]  
DATE: 10/5/88

\*\*NOTE\*\* PLEASE PROVIDE A COPY OF THIS RECAP WITH THE DRAINAGE SUBMITTAL




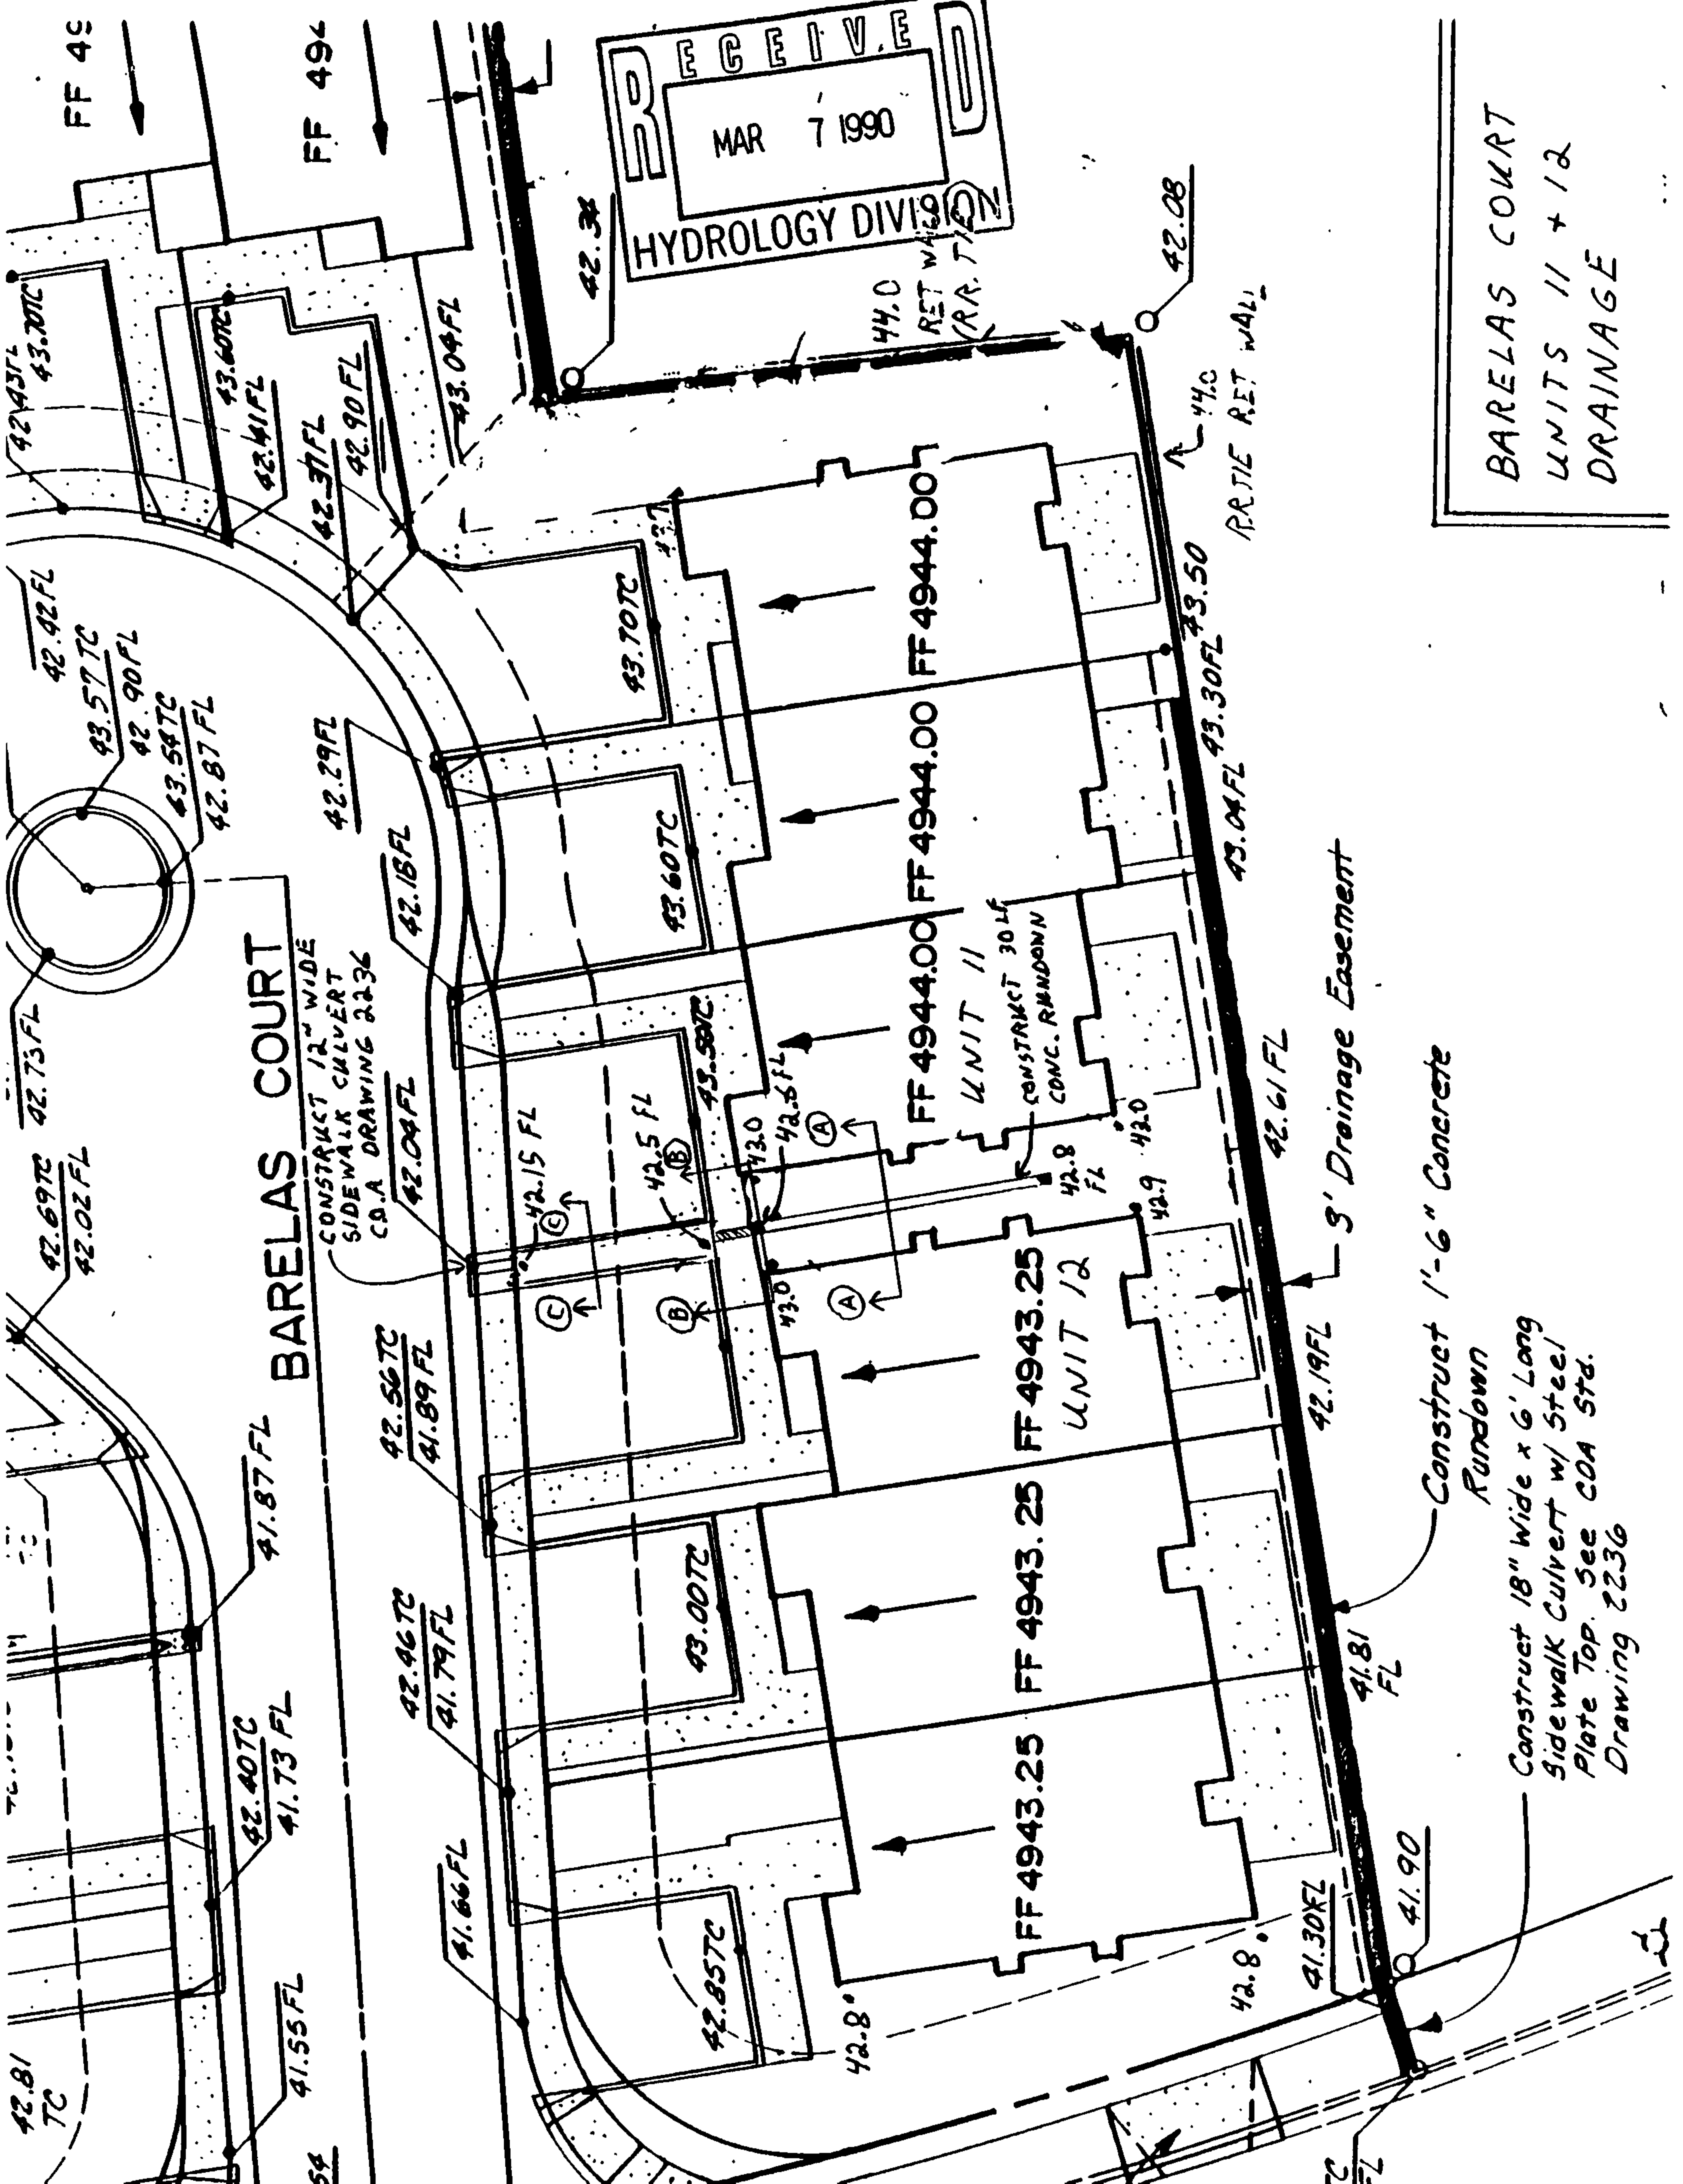

BARELAS COURT  
UNITS 11 + 12  
DRAINAGE

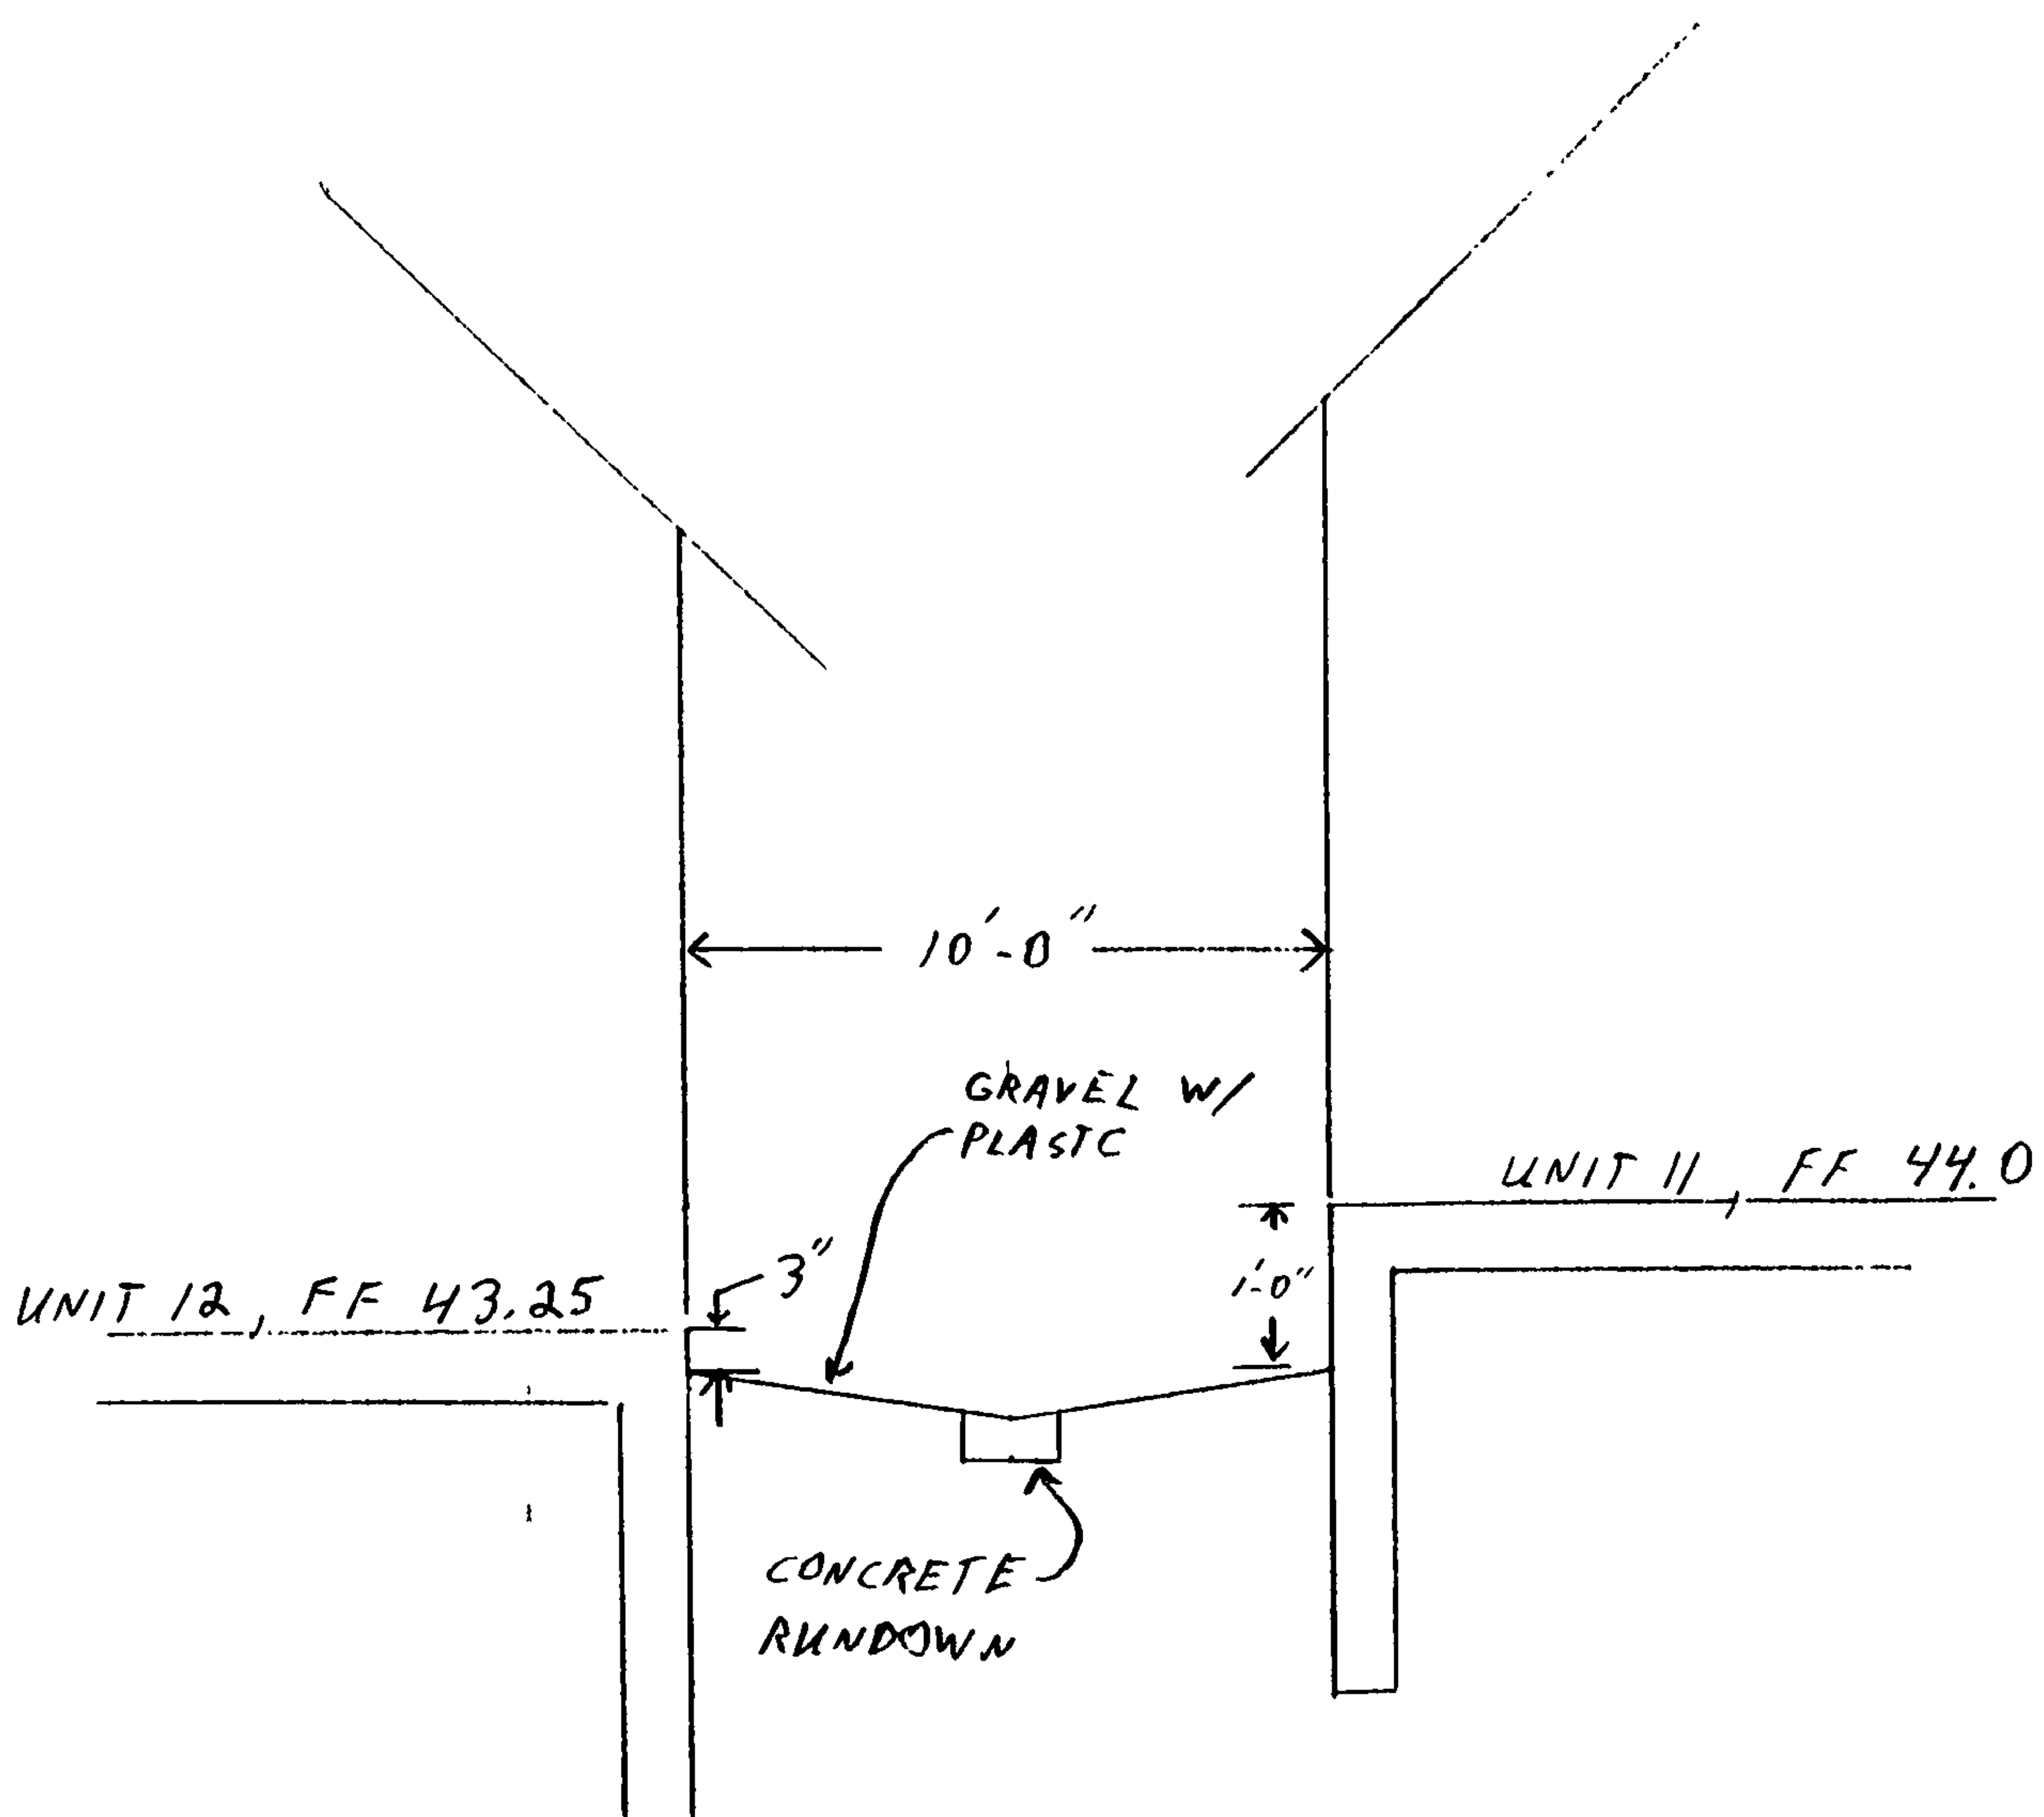

ELEVATION  
(SECTION A-A)



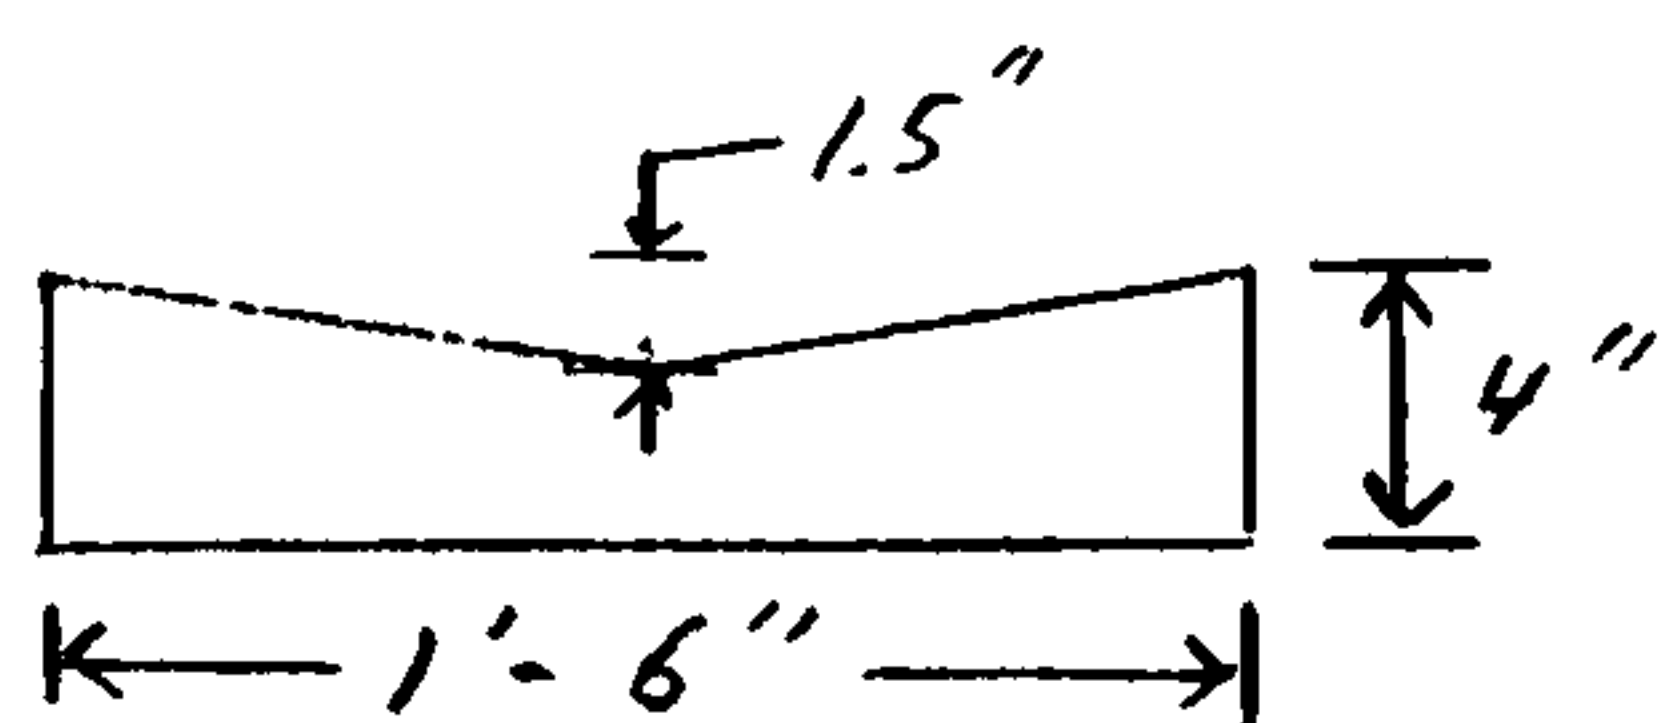


RUNDOWN DETAIL

SCALE: 1" = 5' HOR  
1" = 2' VERT

PROJECT NAME BARELAS COURT SHEET 2  
PROJECT NO. 88008 BY JD  
SUBJECT UNITS 11, 12 - DRAINAGE CH'D

OF 3  
DATE 2/7/90  
DATE

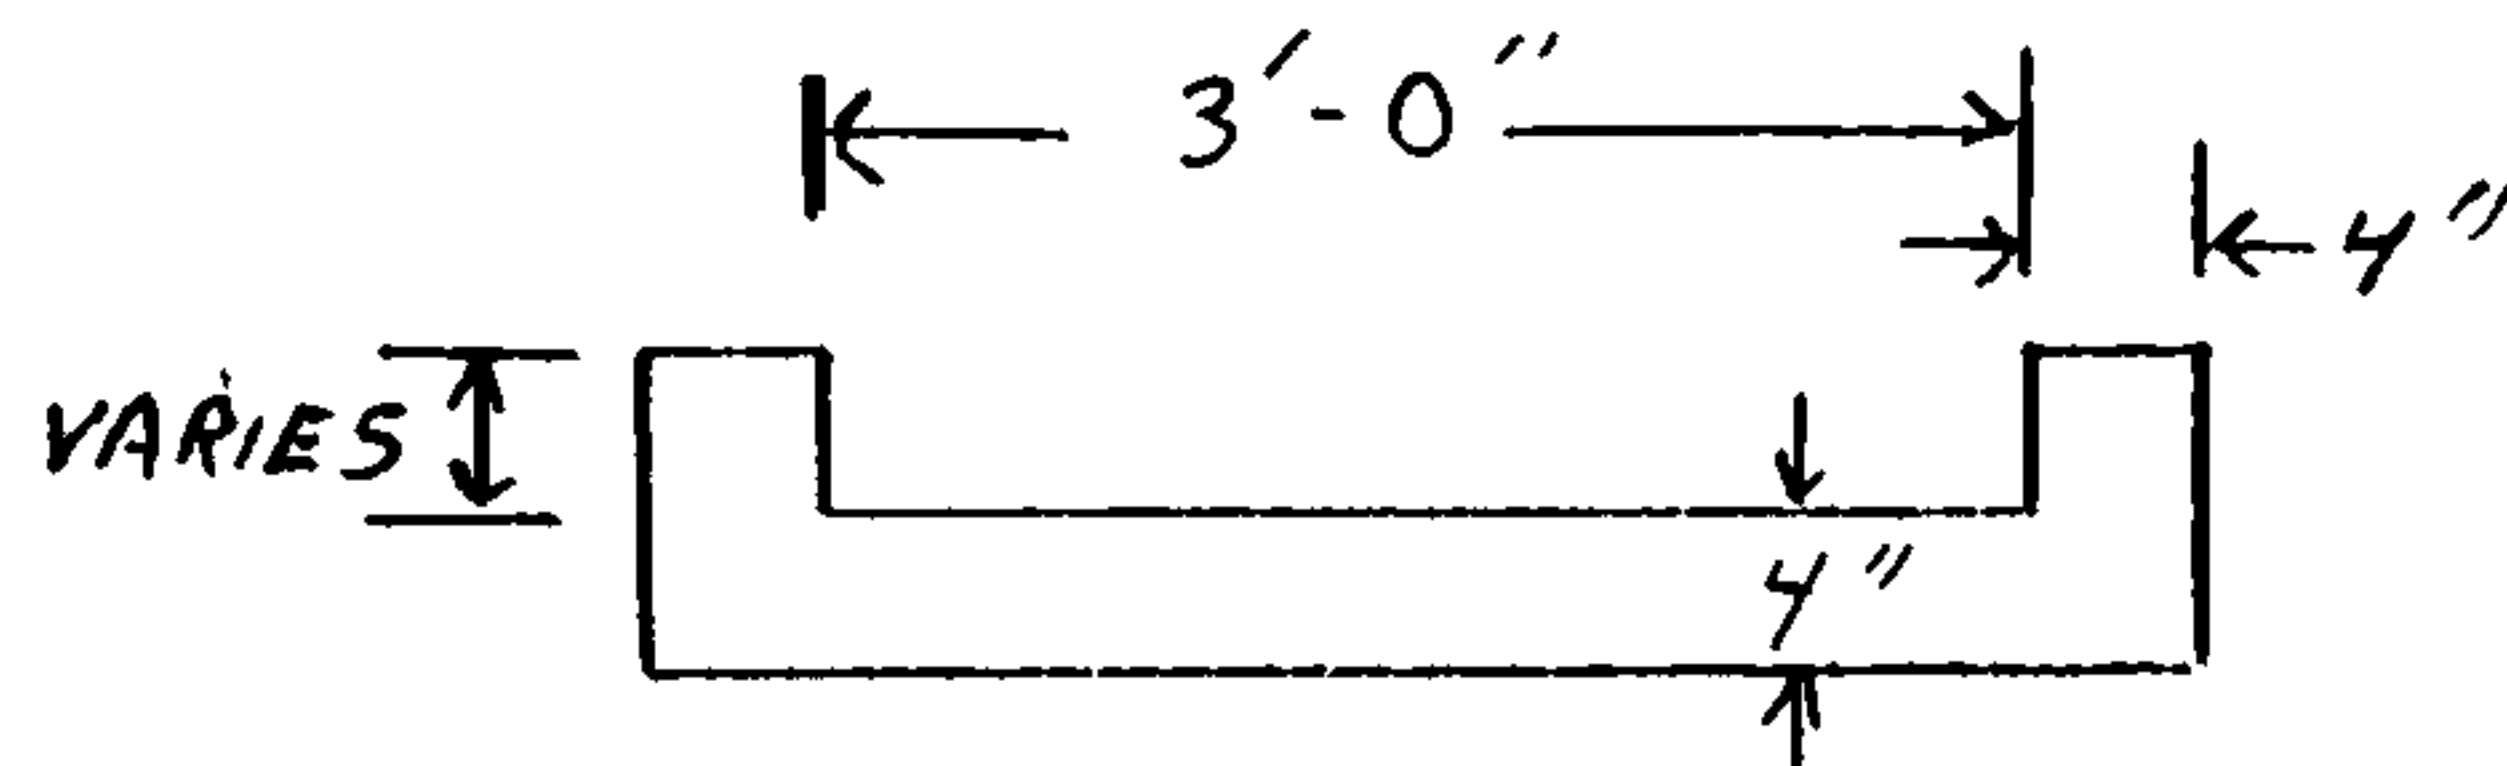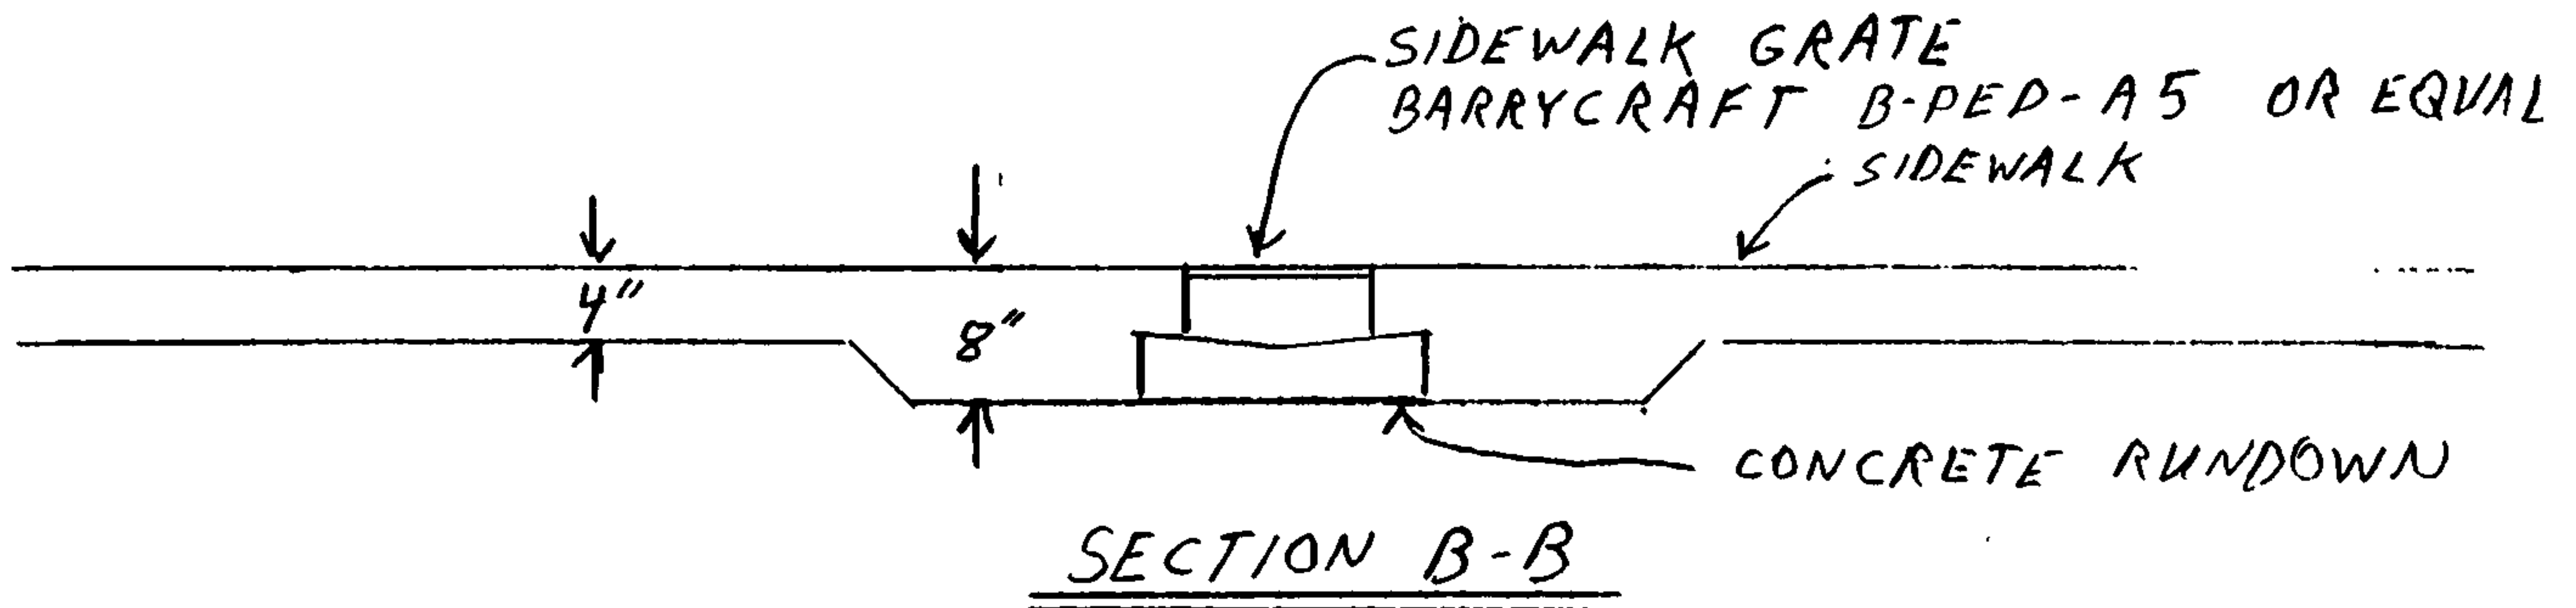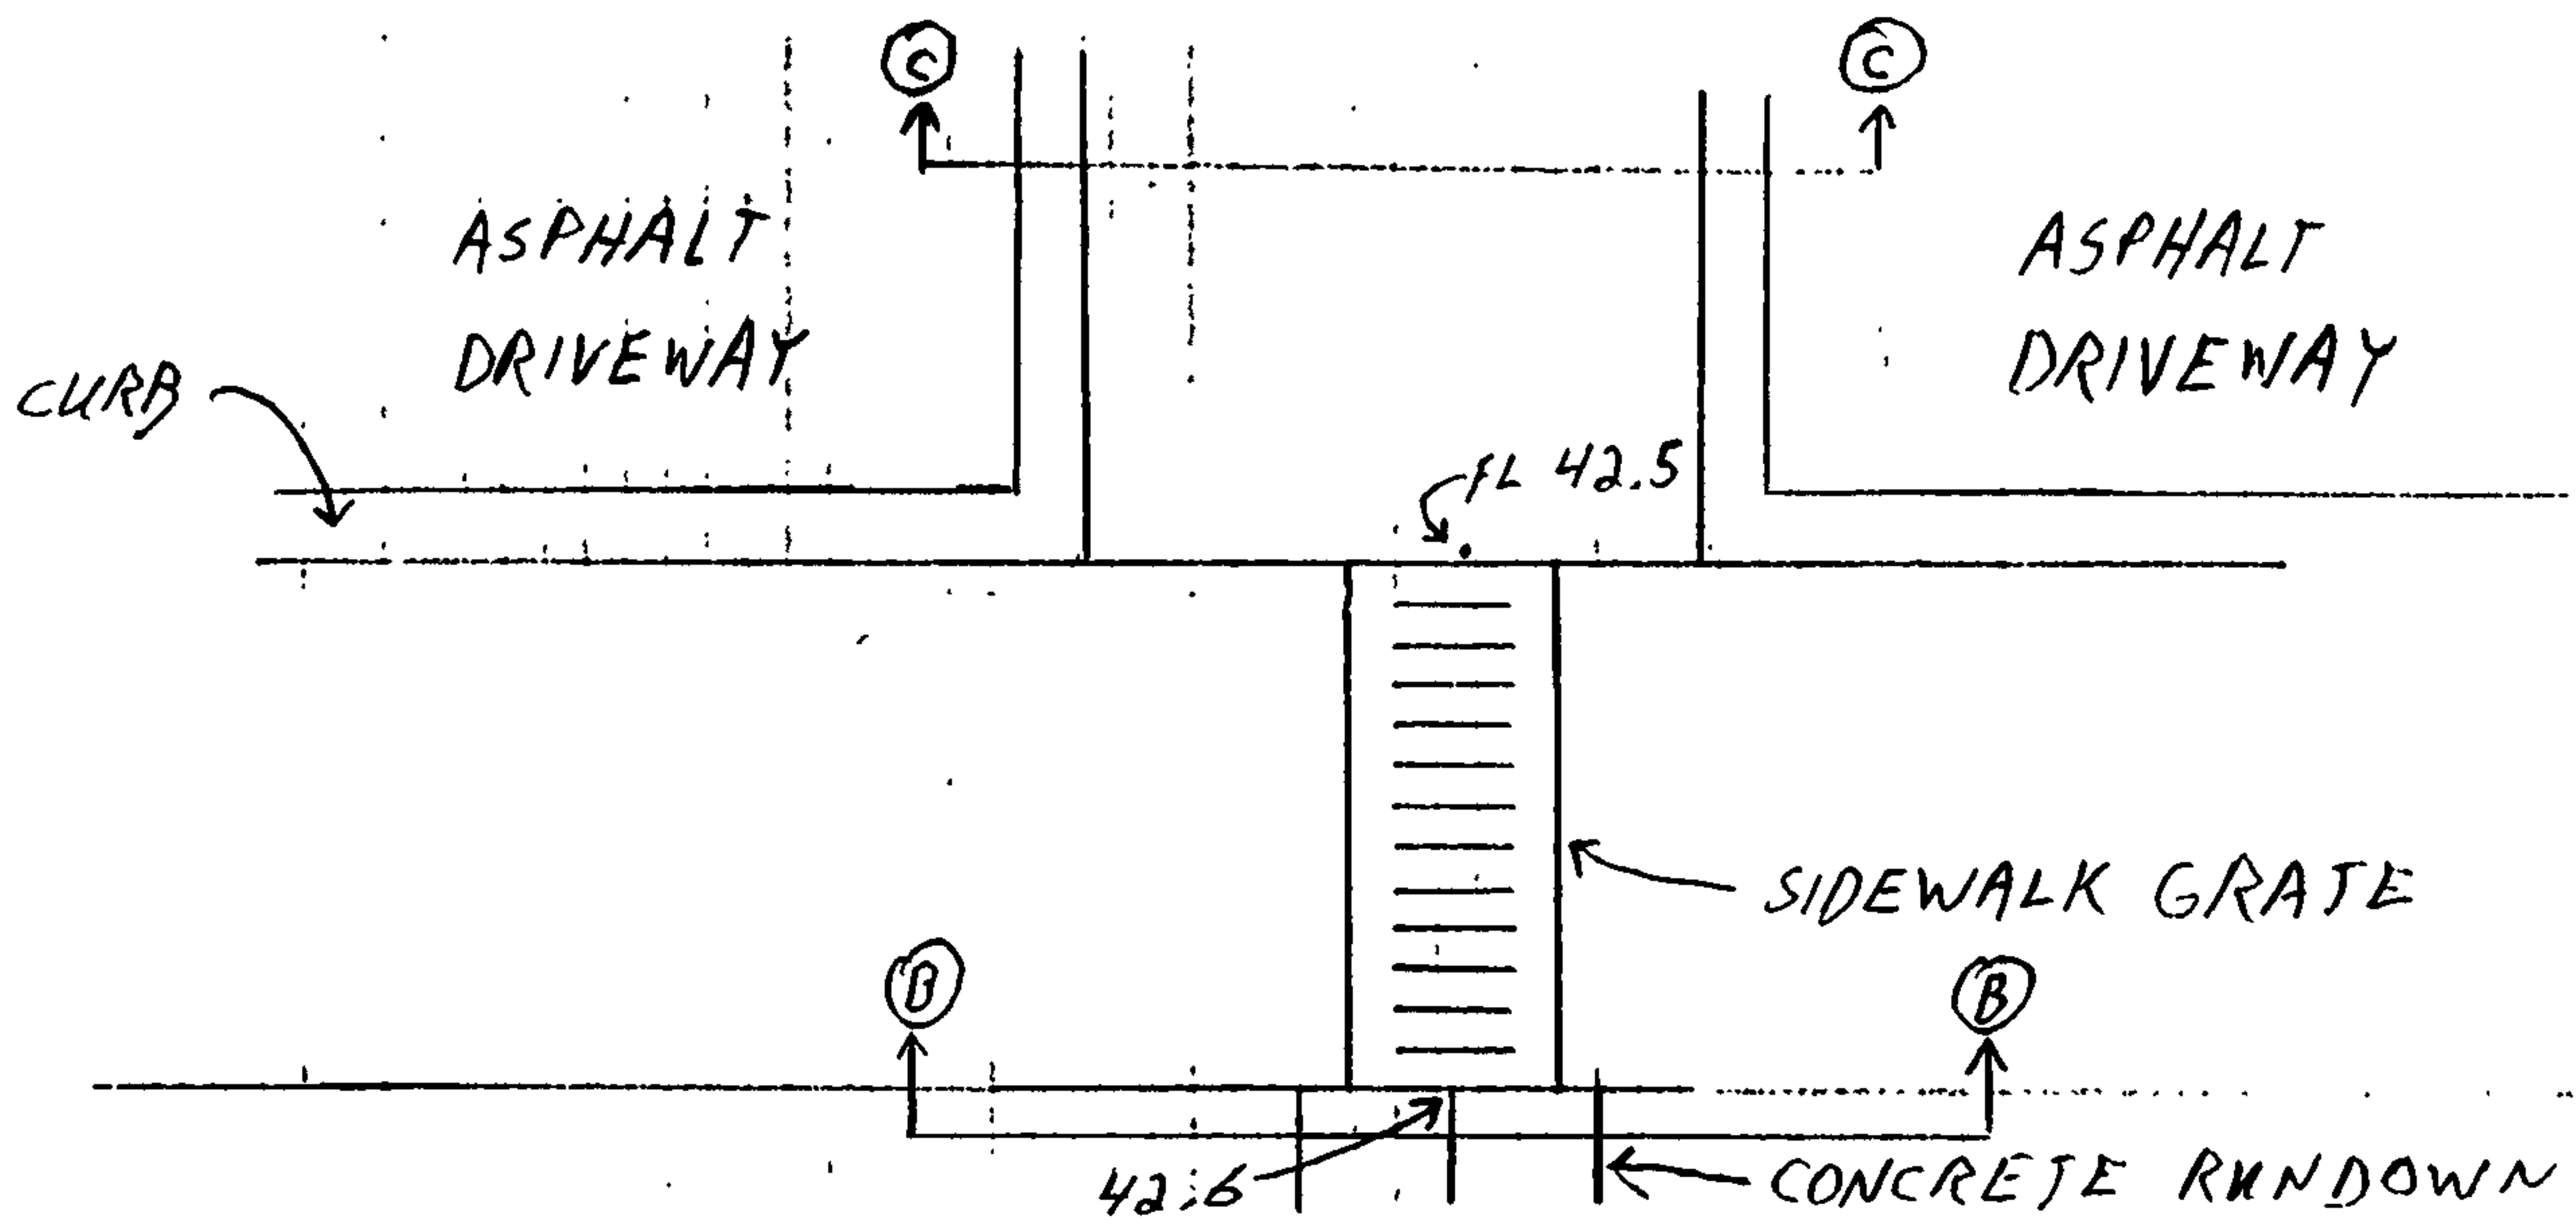

PROJECT NAME BARELAS COURT

PROJECT NO. 88009

SUBJECT UNITS 11 + 12 - DRAINAGE

SHEET 3

BY JD


CHK'D

OF 3


DATE 2/7/91

DATE




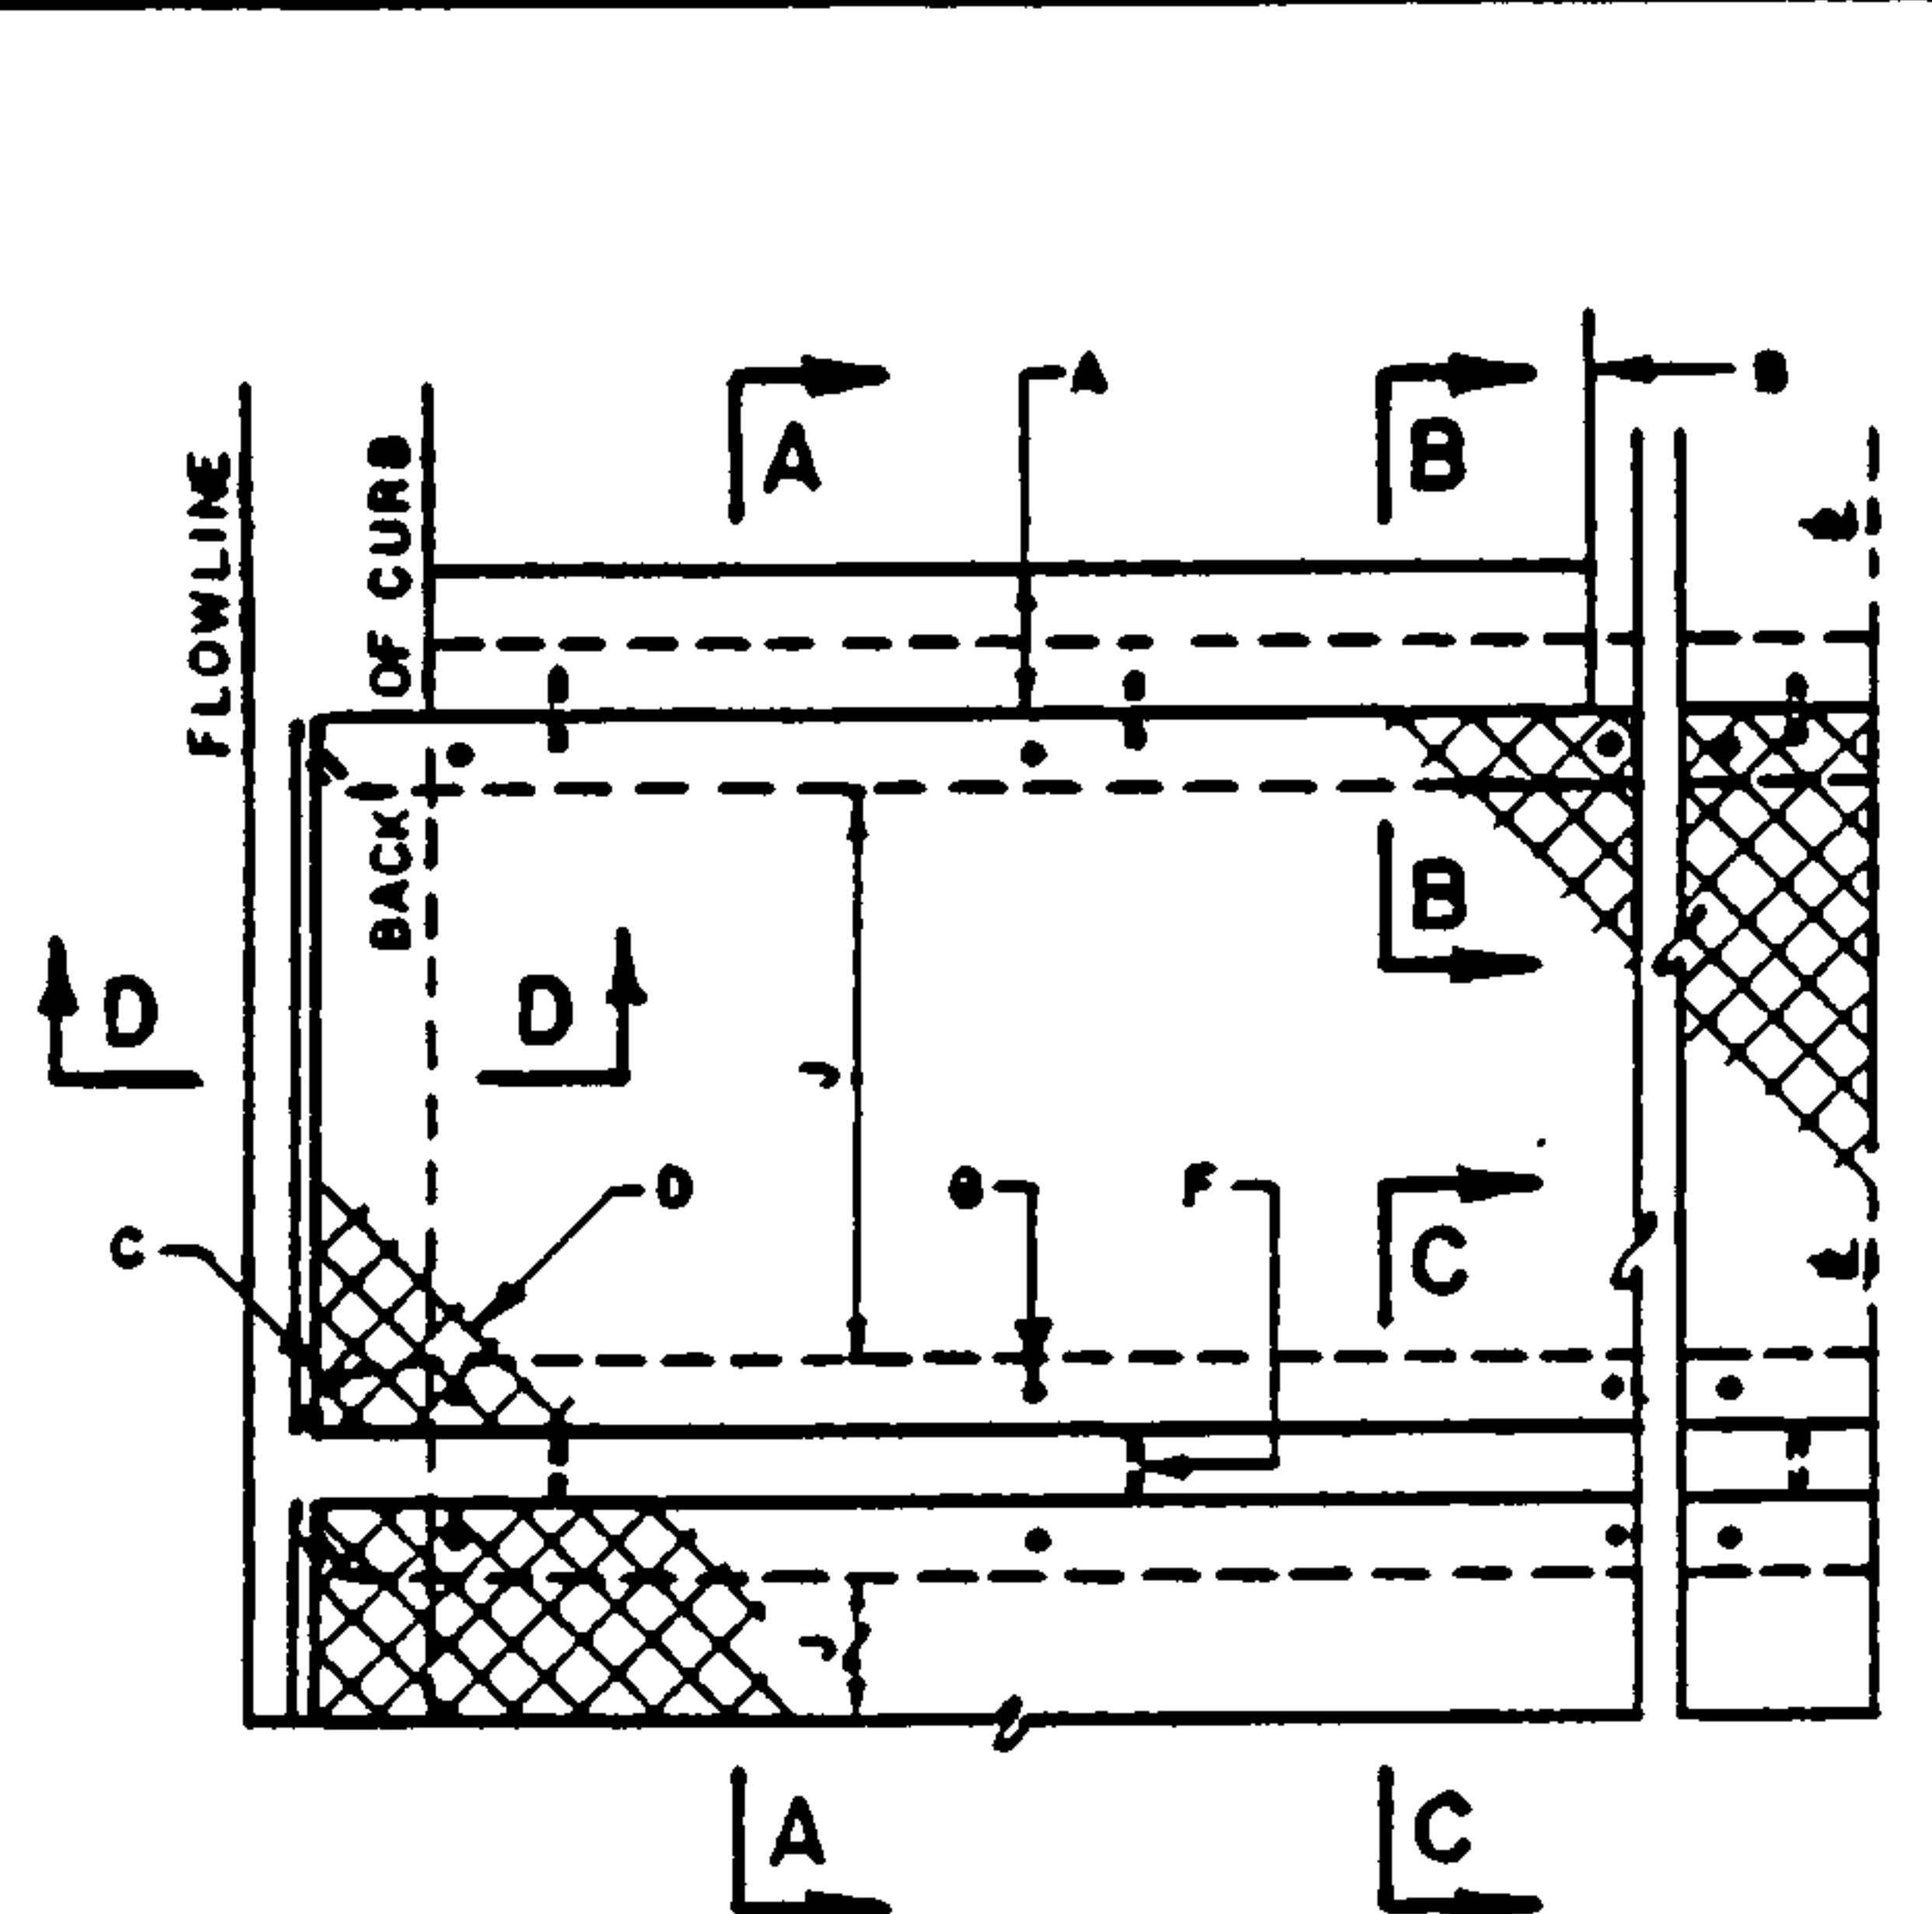


PLAN  
SINGLE AND OR MULTIPLE CULVERT

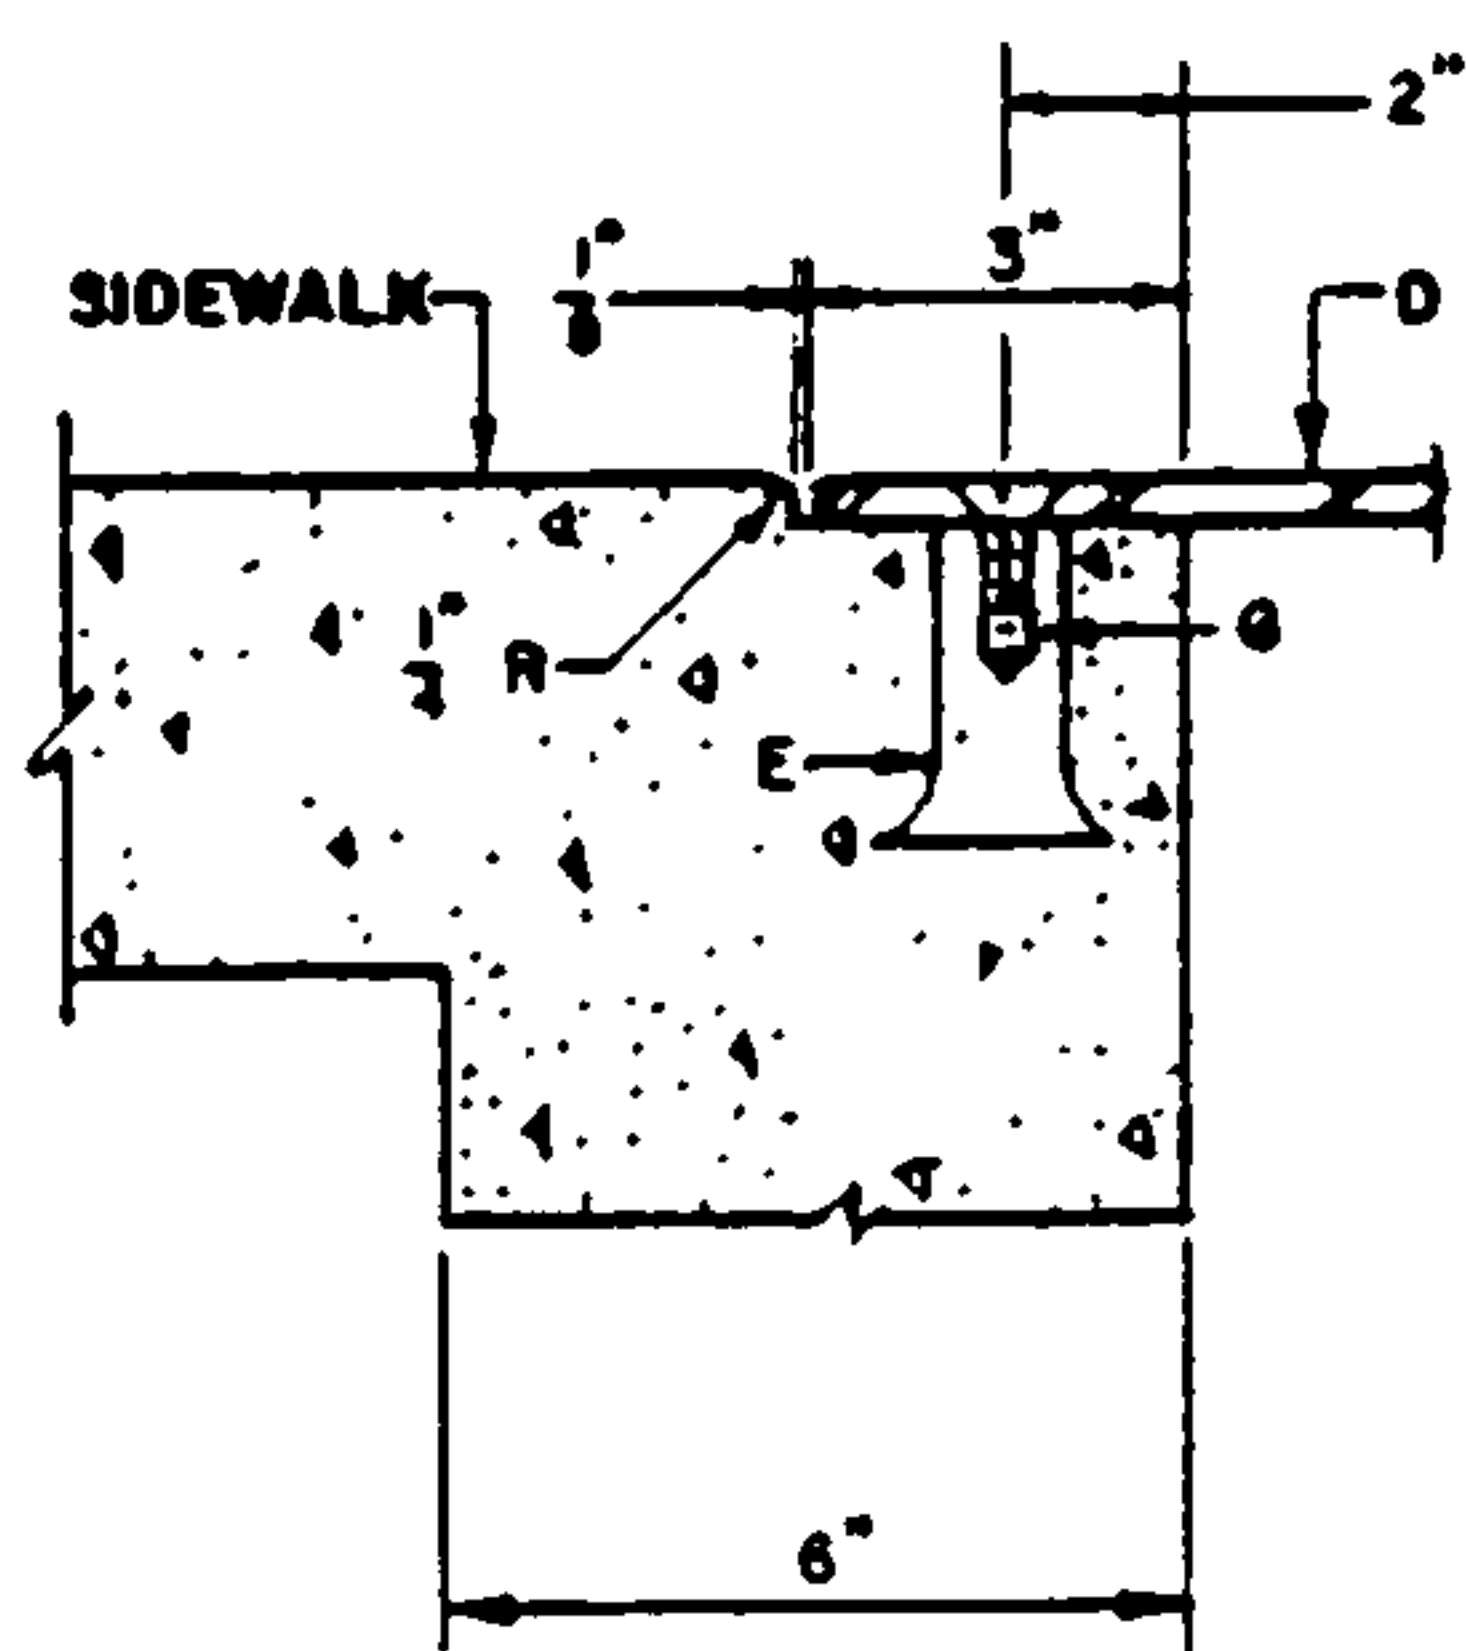


SECTION B-B

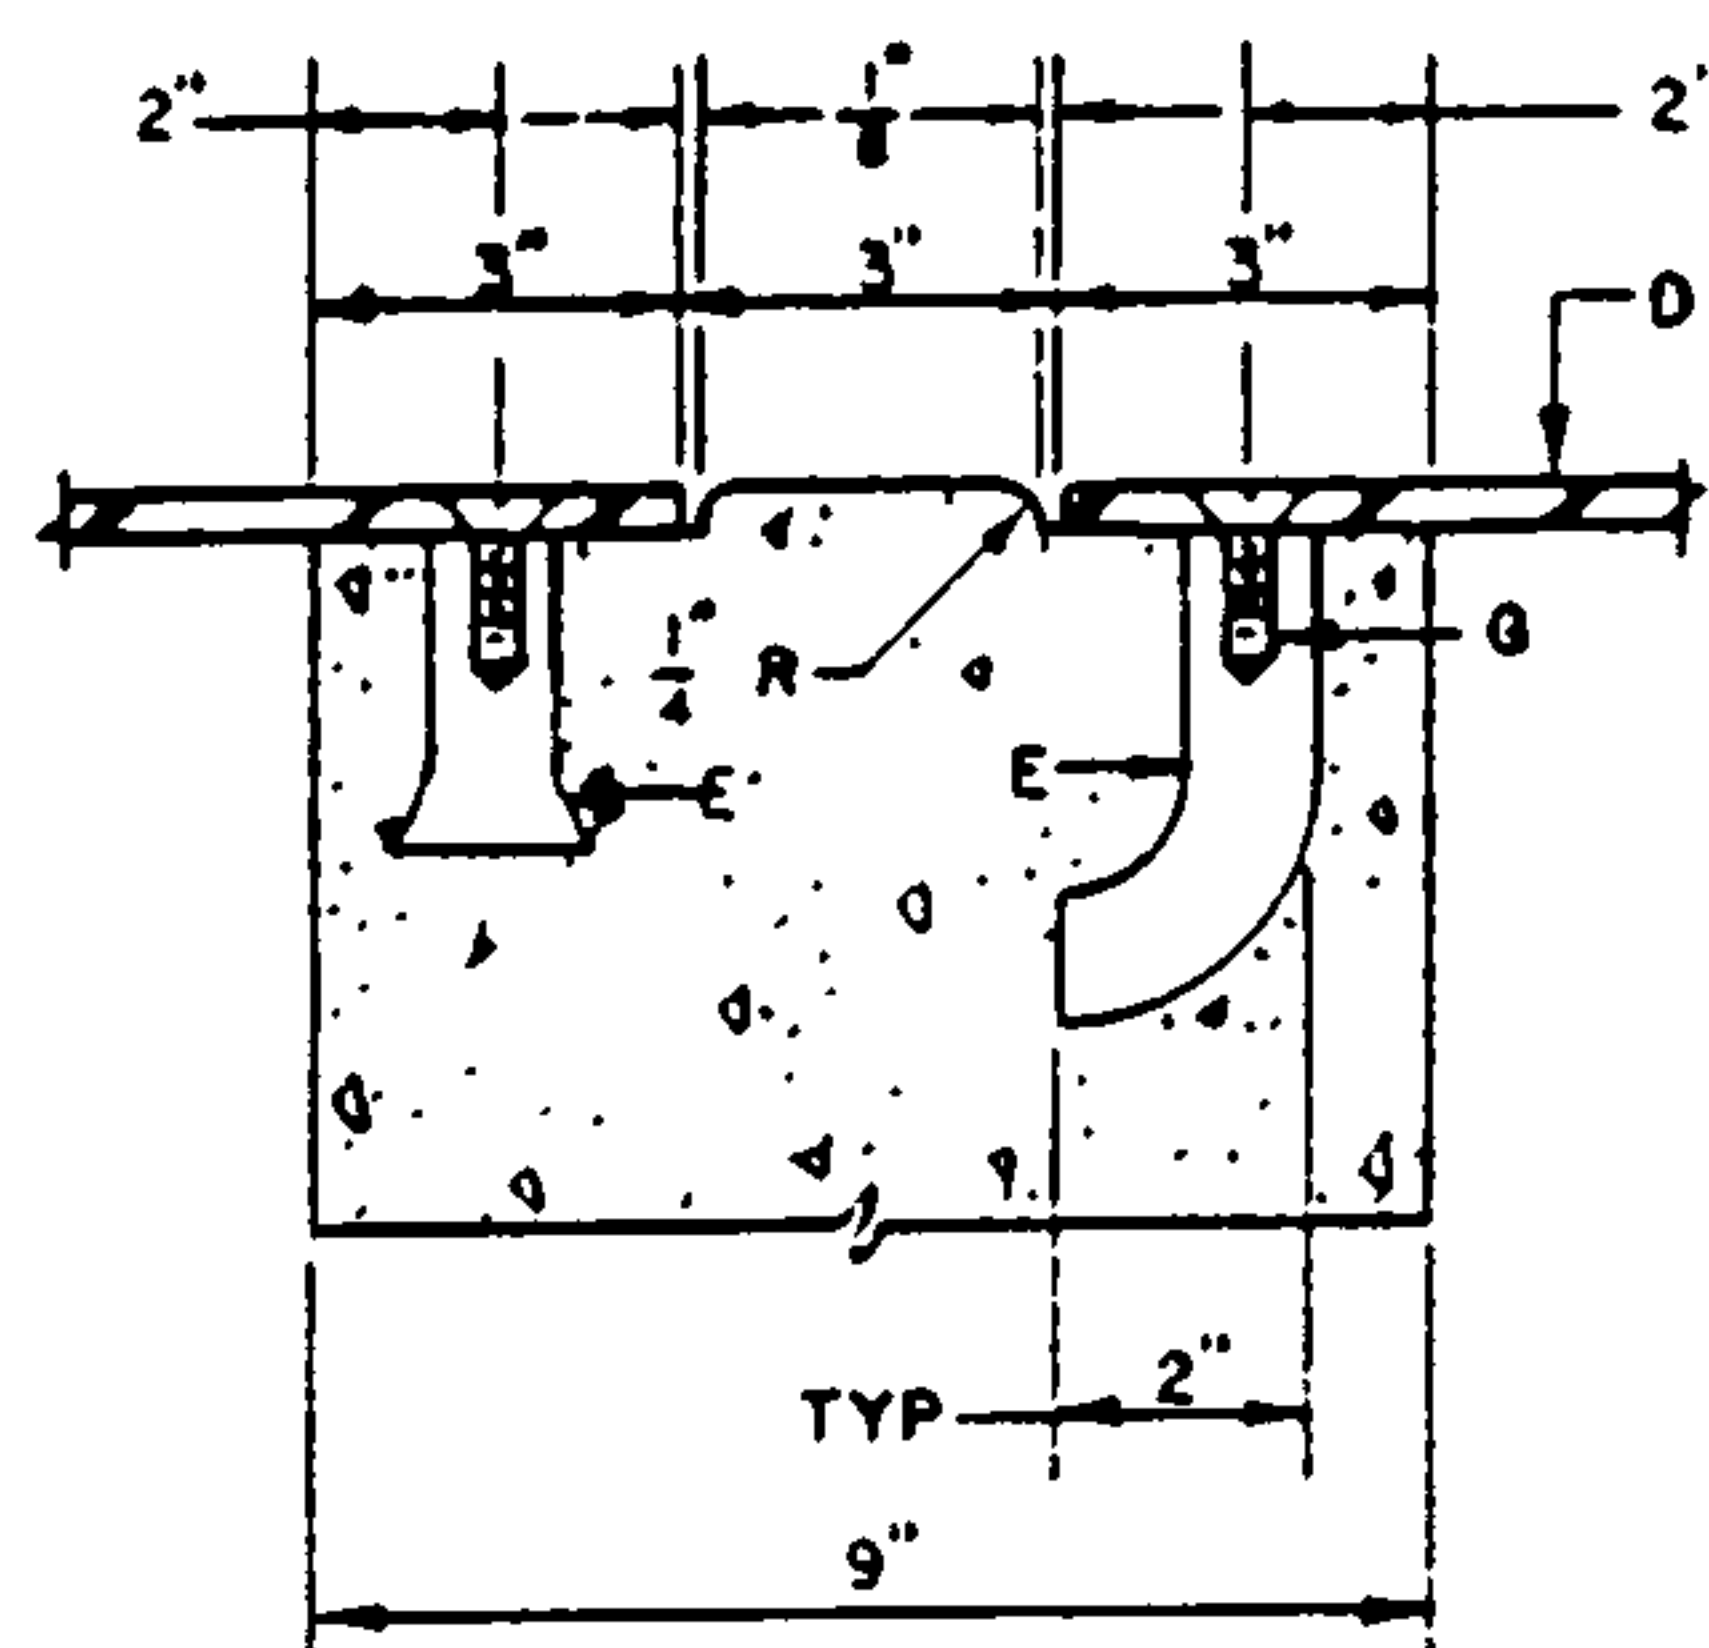


SECTION C-C

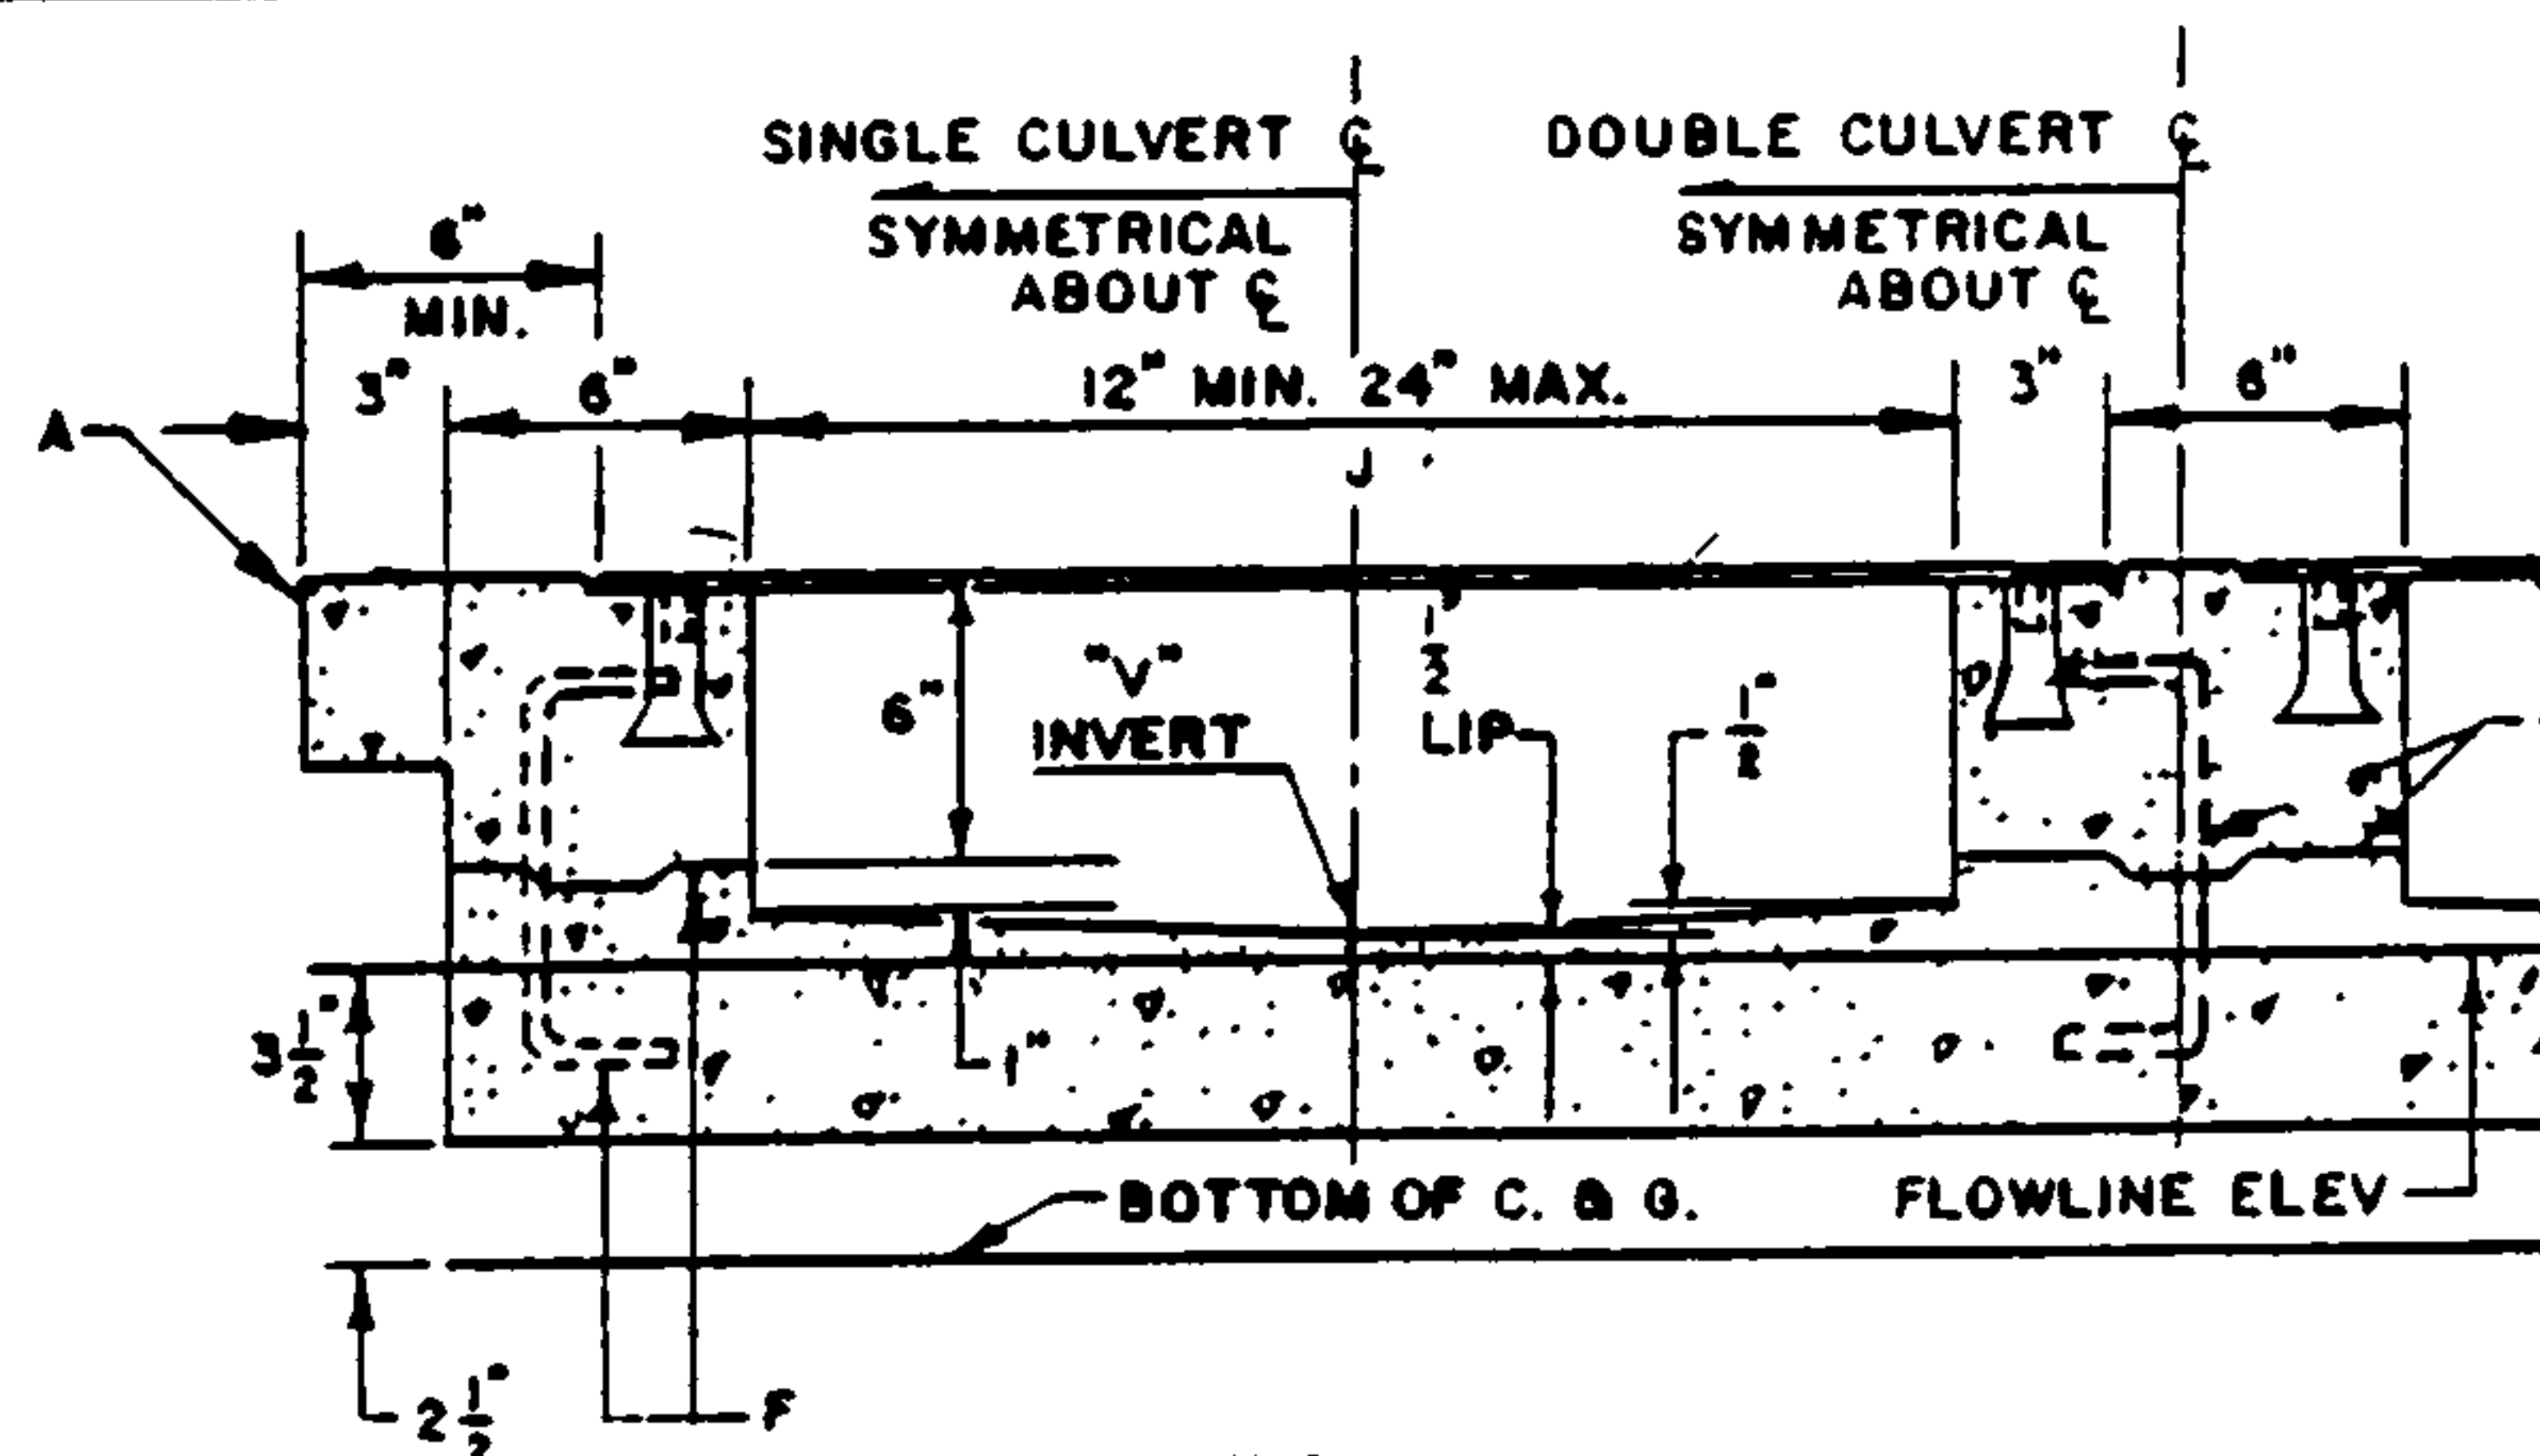

SECTION A-A

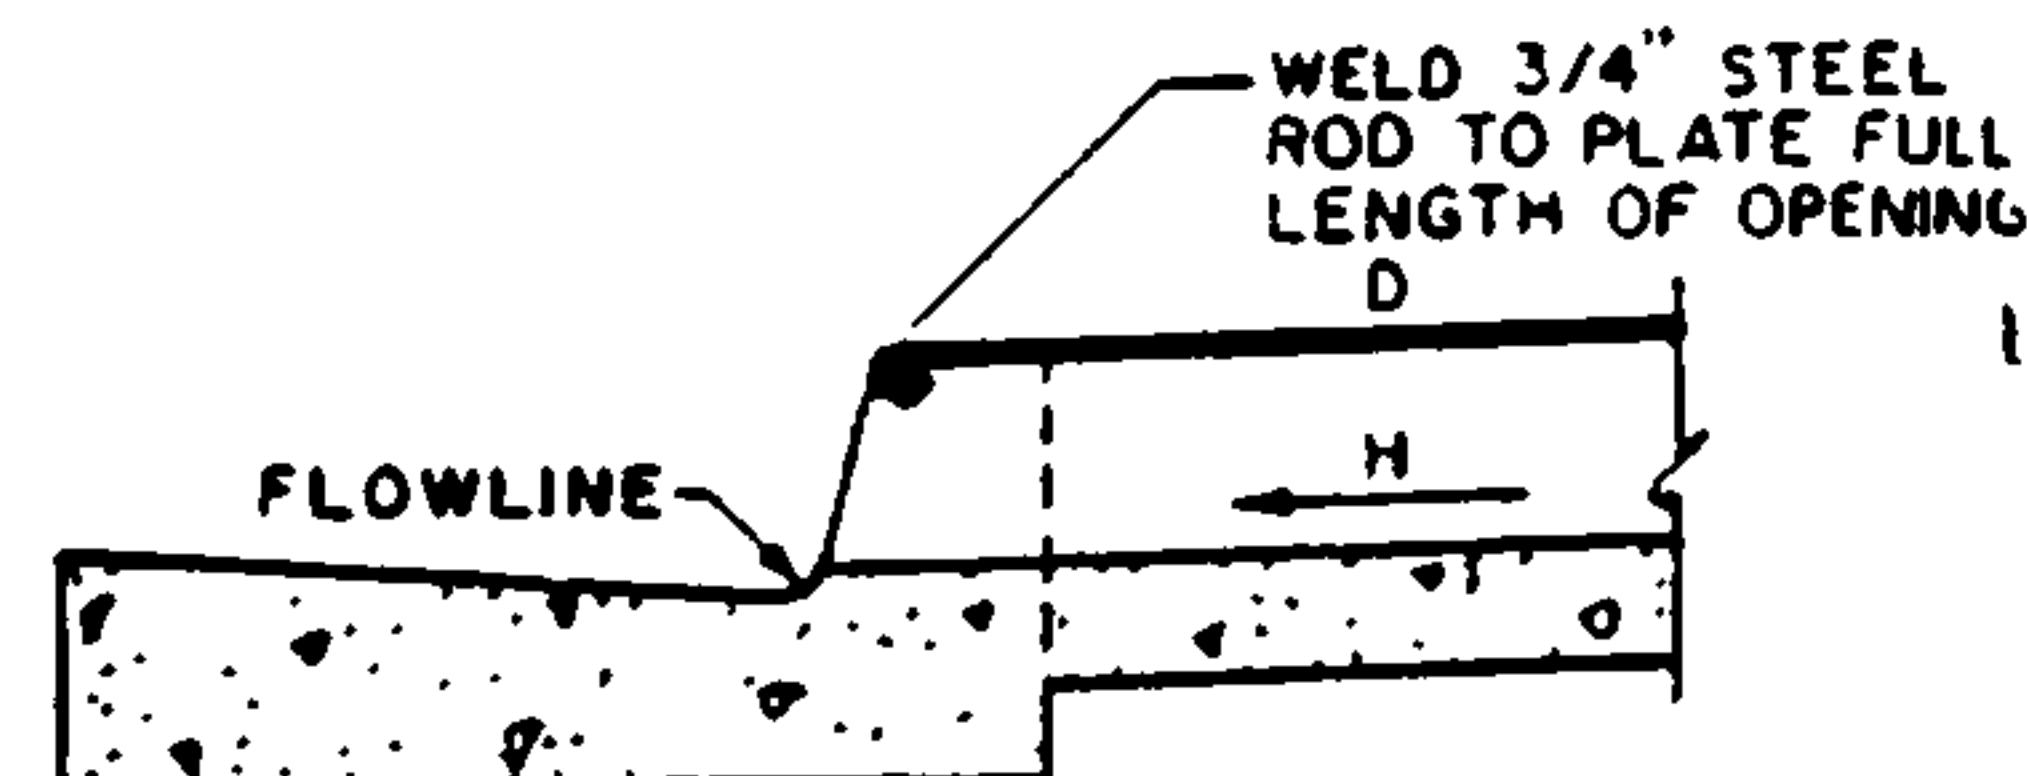

SECTION D-D

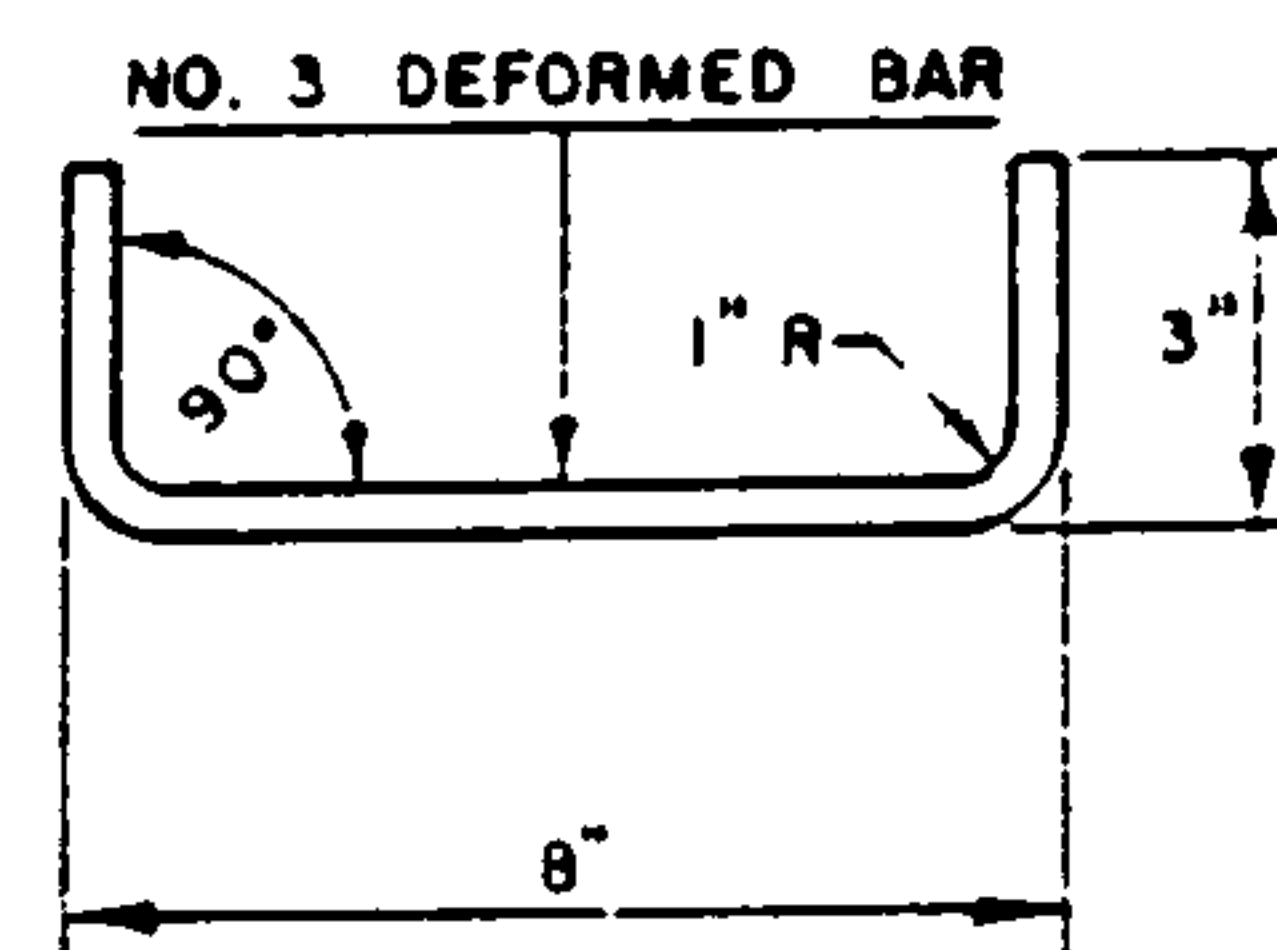

DOWEL DETAIL

## GENERAL NOTES:

1. PLACING OF DRAIN THRU EXIST. SIDEWALK AND CURB & GUTTER REQUIRES THAT ENTIRE SIDEWALK AND C & G STONES BE REMOVED AND REPLACED AS DETAILED HEREIN.
2. BOTTOM SLAB OF CULVERT SHALL BE POURED MONOLITHICALLY WITH NEW GUTTER.
3. THE INVERT SHALL BE TROWELED TO PRODUCE A HARD POLISHED SURFACE OF MAX DENSITY AND SMOOTHNESS. INVERT SHALL BE V-SHAPED TO WITHIN 3° OF OUTLET, THEN WARPED TO PARALLEL FLOWLINE AT OUTLET, UNLESS OTHERWISE SHOWN.
4. ALL EXPOSED CONC. SURFACE SHALL MATCH GRADE, COLOR, FINISH AND SCORING OF ADJACENT CURB AND SIDEWALK.
5. SIDEWALK REPLACED DURING CONSTRUCTION SHALL BE POURED MONOLITHICALLY WITH CULVERT WALLS.
6. IF ROD ANCHORS ARE USED, DRILL & TAP FOR F.H. MACHINE SCREW. ATTACH ANCHORS TO PLATE AND SECURE PLATE IN PLACE PRIOR TO POURING OF WALLS.
7. LENGTH OF EACH PLATE SHALL BE SUCH THAT THE WEIGHT WILL NOT EXCEED 300 LBS. AND SHALL BE STRESS RELIEVED AFTER FABRICATION. CLEAN SURFACE OF PLATE AND FRAMING MEMBERS AND PAINT W/ ONE SHOP COAT RED OXIDE AND TWO FINISH COATS ALUMINUM PAINT (AASHTO M 69).
8. THE CITY WILL NOT ASSUME RESPONSIBILITY FOR MAINTENANCE OF ANY SIDEWALK CULVERT INSTALLED BY OR FOR PRIVATE PROPERTY OWNERS.

## CONSTRUCTION NOTES:

- A. MATCH NEAREST CONTROL JOINT, INSTALL 1/2" EXPANSION JOINT.
- B. EDGE OF SIDEWALK OR SETBACK (VARIABLE).
- C. 3" RADIUS (TYPICAL).
- D. 3/8" CHECKERED STEEL PLATE (PAINT PER NOTE ABOVE).
- E. FOR SECURING PLATE USE 1"x 5" S.S. ROD ANCHOR, "RED HEAD MULTI-SET II SRM-38 ANCHOR" OR APPROVED EQUAL. INSTALL PER MANUFACTURER'S INSTRUCTIONS AT MAX. 24" O.C., A MINIMUM OF 2 PER SIDE AND ONE WITHIN 6" OF EACH END.
- F. CONSTRUCTION JOINT IS OPTIONAL. IF USED, SPACE DOWELS AT 18" O.C. MAX., 1 1/2" MINIMUM FROM FACE OF CONCRETE.
- G. 3/8" - 16 x 1 1/4" COUNTERSUNK, F.H., STAINLESS STEEL, MACHINE SCREW.
- H. SLOPE 1/4" PER FT MIN.
- J. DRAIN WIDTH PER PLAN (12" MIN., 24" MAX.).

CITY OF ALBUQUERQUE

DRAINAGE  
SIDEWALK CULVERT  
WITH STEEL PLATE TOP  
DWG. 2236

AUG 1986

REVISIONS

# Pedestrian – Handicap/Bicycle Trench Grating

## Pedestrian trench grating



Barrycraft's "pedestrian" trench grating (type HH design: see page 3) is a new improved trench grate design for pedestrian traffic. The  $\frac{1}{4}$ " to  $\frac{5}{16}$ " wide slot helps to provide safer grating to walk on in areas where drainage is required.

When specifying or ordering Barrycraft's "pedestrian" grating, please remember to indicate the type of material required. Barrycraft offers you three choices:

Gray cast iron  
Ductile cast iron  
Cast aluminum


The type L1 frame is standard and will be provided with the pedestrian grating.

Applications for Barrycraft's "pedestrian" grating include: sidewalks, terraces, shopping malls, around swimming pools and other areas where appearance and public safety are important.

TABLE: Dimensions in Inches .

Trench Grating Style	Grate Width "A"	Edge Thickness "B"	Trench Width "C"
B-PED-A1	6	$\frac{3}{4}$	4
B-PED-A2	8	$\frac{3}{4}$	6
B-PED-A3	10	$\frac{3}{4}$	8
B-PED-A4	12	$\frac{3}{4}$	10
B-PED-A5	14	$\frac{3}{4}$	12

## Handicap/Bicycle trench grating

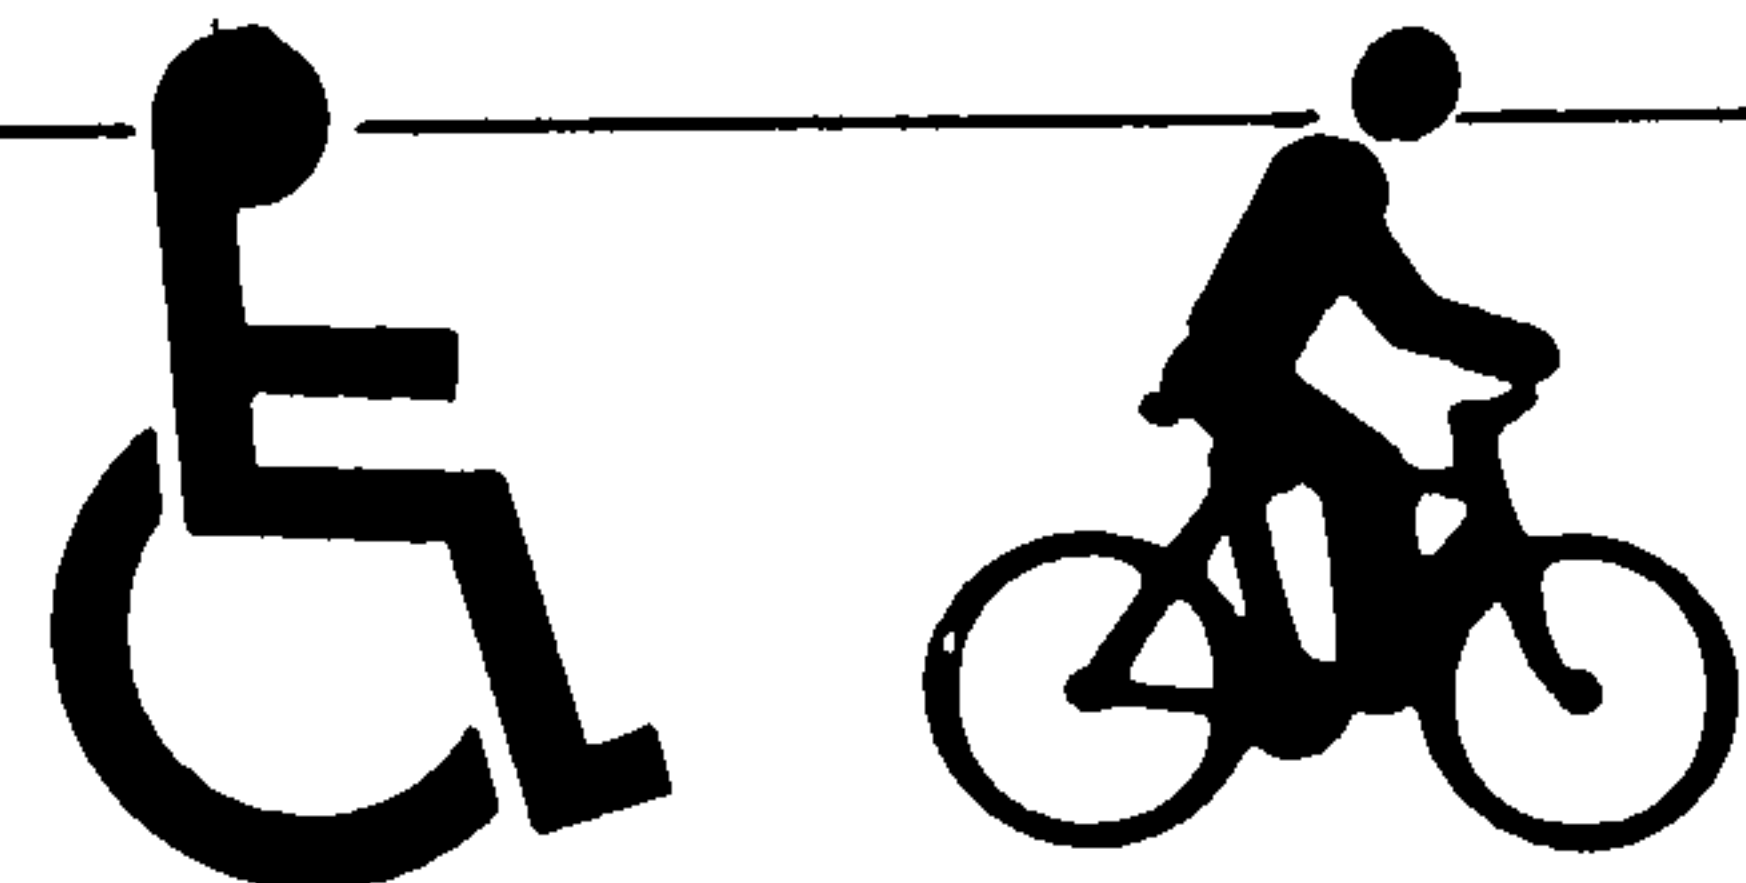

Barrycraft's "handicapped/bicycle" trench grating (type AAA design: see page 3) is designed to help ease handicapped and bicycle traffic safely over trench grating installations.

Barrycraft's "handicapped/bicycle" trench grating's standard diagonal slots 1" wide with a maximum slot length of 9". Grates and frames may be ordered or specified in:

Gray cast iron  
Ductile cast iron  
Cast aluminum

The type L1 frame (see page 3) is standard and will be provided with the handicapped/bicycle grating.

Barrycraft's "handicapped/bicycle" trench grating is particularly suitable in any public area where handicapped and others on small tire traffic have access. Such areas include hospitals, colleges, public sidewalks and shopping malls.

TABLE: Dimensions in Inches

Trench Grating Style	Grate Width "A"	Edge Thickness "B"	Trench Width "C"
B-HCB-A1	6	$\frac{3}{4}$	4
B-HCB-A2	8	$\frac{3}{4}$	6
B-HCB-A3	10	$\frac{3}{4}$	8
B-HCB-A4	12	$\frac{3}{4}$	10
B-HCB-A5	14	$\frac{3}{4}$	12


**Call Us Toll Free:**  
**See Page 20.**  
**Facsimile Machine Available.**



BARELAS COURT TOWNHOMES  
DRAINAGE REPORT

PREPARED FOR


CARTER ELLIOTT CARTER  
4002 SILVER SE  
SUITE 100  
ALBUQUERQUE, NM 87108

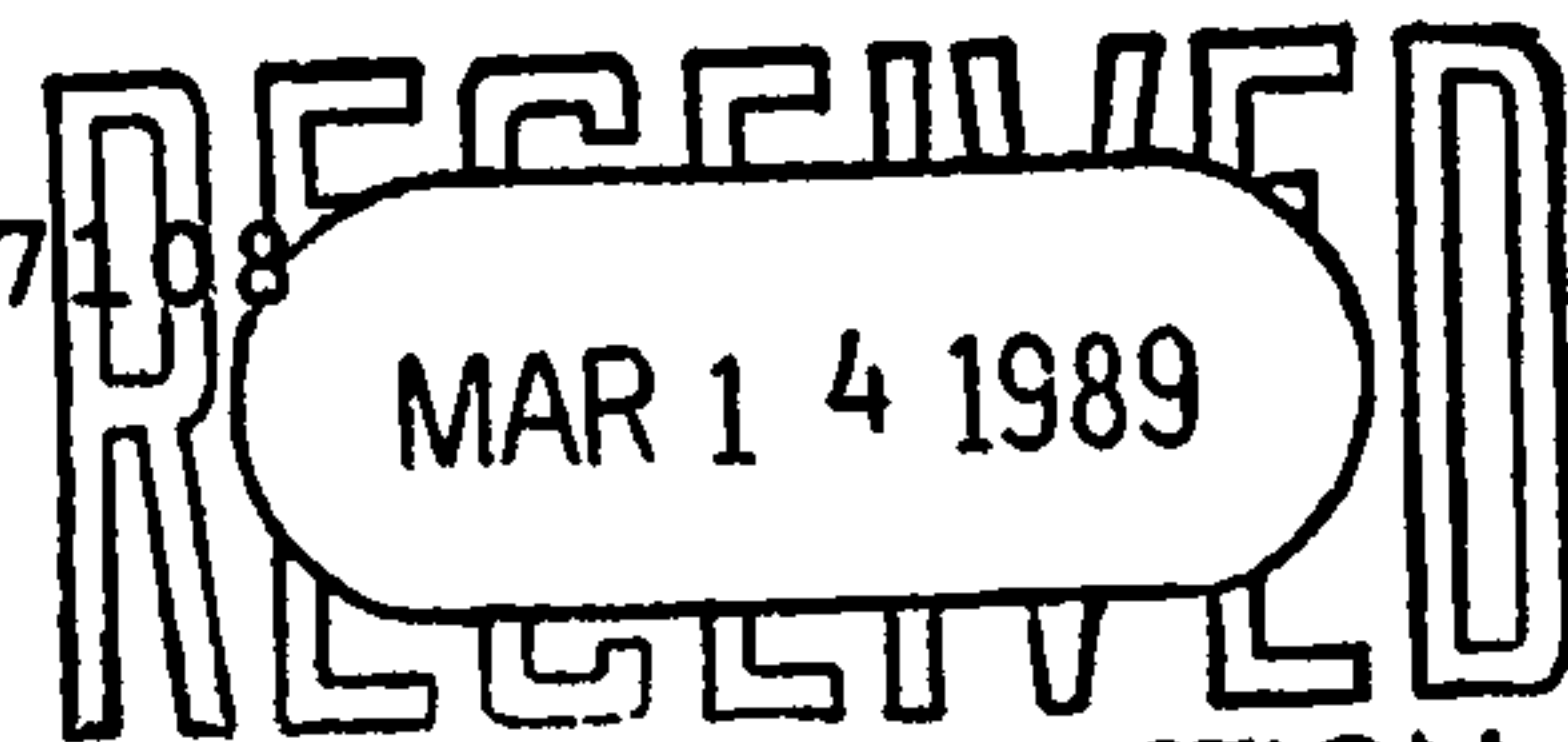

PREPARED BY HYDROLOGY SECTION

AVID ENGINEERING, INC.  
5801 OSUNA NE  
SUITE 204  
ALBUQUERQUE, NM 87109

MARCH 1989

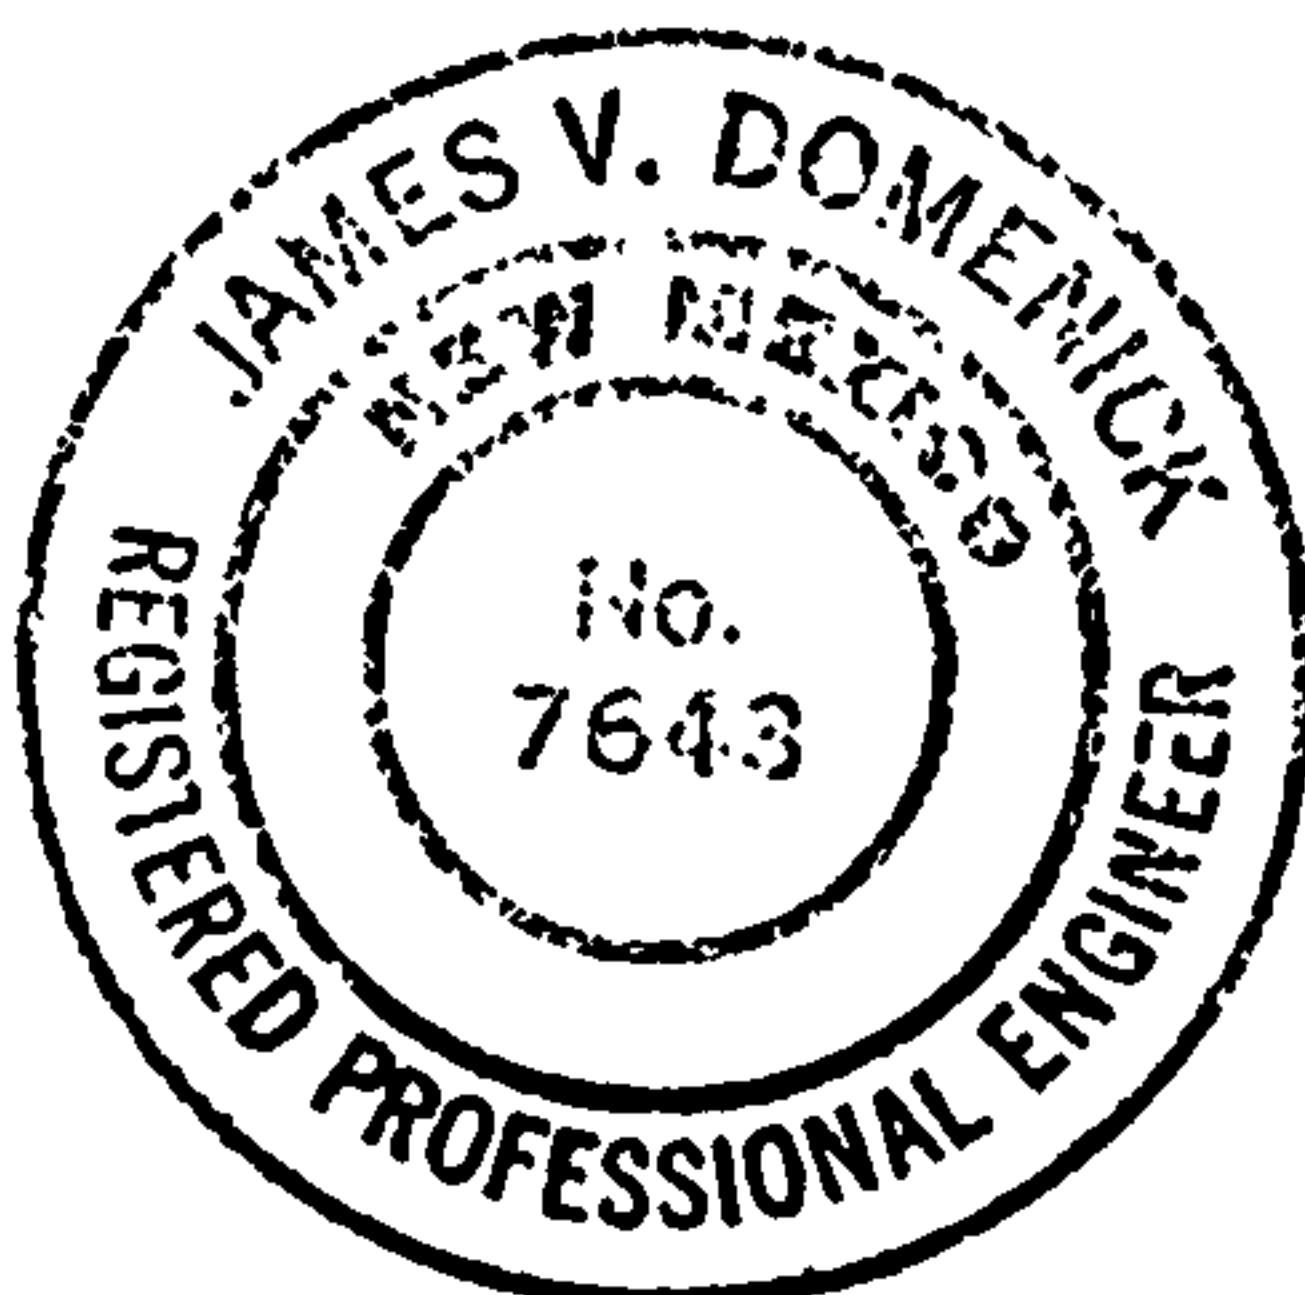

PREPARED UNDER THE DIRECTION OF:

*James V. Domenick* DATE 3/8/89  
James V. Domenick  
N.M.P.E. #7643

## TABLE OF CONTENTS

	<u>PAGE</u>
INTRODUCTION	1
PLANNING HISTORY	1
EXISTING CONDITIONS	1
DRAINAGE PLAN	2
SUMMARY OF RECOMMENDATIONS	3
EXHIBIT I (In pocket in back of report)	
GRADING PLAN (In pocket in back of report)	

**DRAINAGE REPORT  
FOR  
BARELAS COURT TOWNHOMES**

**INTRODUCTION**

This report presents the summary of existing drainage conditions and recommendations for Barelas Court Townhomes, a proposed 14 unit townhome development near 8th Street S.W., and Bridge Street S.W., in Albuquerque, New Mexico. The project site contains approximately 0.94 acres, and is located on the Zone Atlas Sheet K-14 as shown on the vicinity map in Exhibit I.

**PLANNING HISTORY**

The proposed project is to be on land currently owned by the City of Albuquerque and is planned to be a low income housing development administered through the City Human Services Department. The site is currently platted as a single lot known as Lot 39A of the Lands of Sanchez-Chavez, and will be subdivided as shown on Exhibit I. The project has received approval from the Environmental Planning Commission for a Zone Map Amendment from SU-2/TH to SU-2/SU-1 and site plan approval has been delegated to DRB. Sketch plat review has been completed (DRB number 88-430), the public hearing has been held, and the preliminary plat has been submitted to DRB for review and approval.

**EXISTING CONDITIONS**

The project site is in the Albuquerque south valley, immediately east of Eighth Street and approximately 0.25 mile north of Bridge Street SW. This is an "infill" project, as the surrounding area is nearly fully developed. A review of the Federal Emergency Management Agency's flood hazard boundary maps shows the project site to be outside the 100 year flood plain but within the 500 year flood limits. A vicinity map and flood hazard map showing the project location is included with Exhibit I.

There are no arroyos or major drainage courses passing through or near the site. Drainage from Eighth Street is restricted from entering the site by existing curb and gutter, and no runoff currently enters the site from either the north or south adjacent properties. However, a portion of the single residential lot to the east of the project site drains to a low point located approximately at the east boundary of the project. Any runoff from rainfall on the site itself also drains to the same low point, as there is no existing outfall to the street.



The Flood Map on Exhibit I shows the topography of the project site and the site to the east, and indicates the depression in which the site runoff currently ponds. This depression is located partially on each of the two lots. The existing drainage area contributing runoff to the depression is 1.38 acres, which produces a 100-year volume of 1002 cubic feet. This volume would pond to a maximum surface elevation of 4922.2 feet, which is a depth of about 0.6 foot. Exhibit I shows the hydrology calculations and the approximate limits of ponding under existing conditions.

### DRAINAGE PLAN

Exhibit I shows the proposed drainage plan for Barelás Court Townhomes, and includes runoff computations, schematics of proposed improvements, existing elevations, and indications of flow directions. The grading plan shows final spot elevations and the design for proposed drainage improvements. The drainage plan generally will consist of grading the entire site to convey storm runoff to Barelás Court and then to Eighth Street, where it will flow south to the existing storm inlet at the corner of Eighth Street and Marquez Lane. No detention or retention ponds will be constructed, as there is adequate downstream capacity to carry the runoff generated by the development.

Roof drains will direct most runoff to the front of each building and discharge to the driveway and/or street. The front lots and driveways will also discharge to Barelás Court, which will have a minimum slope of 0.5% toward Eighth Street. The back lots of the buildings will be graded to carry runoff between the buildings and to the street, or to an 18" concrete rundown located along the back lot-line of some units. Where rundowns are used, they will discharge to the street through a standard under-sidewalk drain. The 100-year peak discharge from the development into Eighth Street will be 2.8 cfs.

The elevation of the eastern end of the site will have to be raised approximately 2.33 feet in order to maintain a positive grade in Barelás Court to Eighth Street. This will require construction of approximately 100 feet of 2.33 foot high retaining wall along the eastern edge of the subdivision, as shown on the Grading Plan. This wall will have a minor effect on the offsite runoff which formerly discharged to the low spot on the project site. The wall will cause this runoff to remain on the site to the east instead of combining with runoff from the project site and ponding on both lots. Calculations shown in Exhibit I indicate the 100-year runoff volume from the site will be 408 cubic feet, and we propose that this water simply be left to pond temporarily and infiltrate behind the retaining wall.

The maximum depth will be less than 0.5 feet, and the calculated water surface elevation is 4922.3 feet, which is 0.1 foot higher than under pre-development conditions. The area where this runoff will pond contains no permanent structures, and is shown on Exhibit I. The area subject to ponding will be slightly larger than that under current conditions.

#### **SUMMARY OF RECOMMENDATIONS**

The drainage plan for Barelac Court Townhomes proposes to convey all runoff from the development to Eighth Street and then to an existing storm sewer inlet to the south. The peak discharge generated by the development is 2.8 cfs, which is less than the downstream capacity. A retaining wall on the east side of the site will prevent runoff from an adjacent site from entering the development, and this runoff will be retained on a vacant portion of the residential lot.

FILE COPY



# City of Albuquerque

P.O. BOX 1293 ALBUQUERQUE, NEW MEXICO 87103

April 11, 1989

James Domenick, P.E.  
AVID Engineering, Inc.  
5801 Osuna Road, NE Suite 204  
Albuquerque, New Mexico 87109

RE: REVISED DRAINAGE PLAN/REPORT SUBMITTAL OF BARELAS COURT  
TOWNHOUSES (K-14/D42) REVISION DATED MARCH 13, 1989 RECEIVED  
MARCH 14, 1989

Dear Mr. Domenick:

Based on the information provided on your resubmittal of March 14, 1989,  
the referenced drainage plan is approved conditionally for Final Plat.

Please be advised that prior to final sign-off of the plat, we will need  
the following information.

- ✓ 1. Plat must indicate the easements required for the proposed concrete  
channel.
2. Culvert construction will need to be coordinated through the work  
order process.
- ✓ 3. Proposed concrete channels and sidewalk culverts must be made part  
of the infrastructure listing.

If I can be of further assistance, please feel free to call me at  
768-2650.

Cordially,

*Bernie J. Montoya*  
Bernie J. Montoya, C.E.  
Engineering Assistant


xc: Sylvia Fettes, Legal Dept.

BJM/bsj  
(WP+935)



March 6, 1990

Mr. Fred Aquirre  
Public Works Department  
City of Albuquerque  
P.O. Box 1293  
Albuquerque, NM 87103

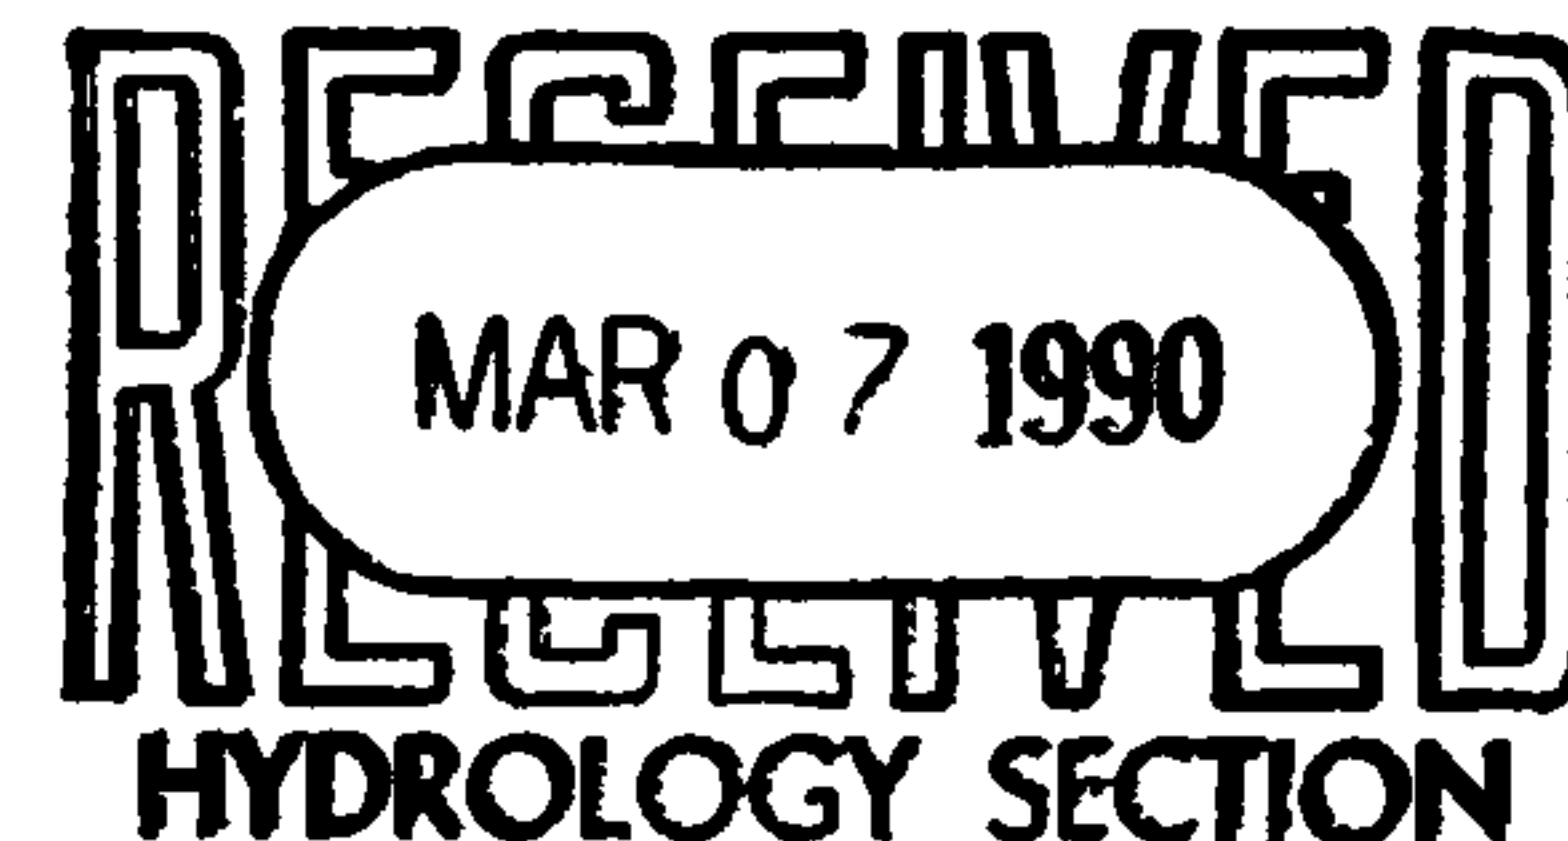

RE: BARELAS COURT TOWNHOMES.  
PROJECT 3683.  
REQUEST FOR APPROVAL OF AMENDED GRADING PLAN.

Dear Fred:

This letter is to request approval of an amended grading plan for the Barelas Court Townhomes project, which is currently under construction. The grading plan was originally approved on April 11, 1989. The owner is trying to obtain FHA mortgage approval for the townhouse units, and that agency has requested some additional improvements over and above those in the approved grading plan.

The additional improvements consist of concrete rundowns on the private portion of the development. The design is such that they cannot drain to the street over the drivepad or the sidewalk, so we would have to drain them to the street under the sidewalk through a standard city sidewalk culvert. The original drainage plan called for this runoff to drain to the street, so there is no change to the flow rates or discharge locations. The attached drawings show the locations of the two proposed sidewalk culverts within the City right-of-way.

We request your approval of this amended grading plan in order to obtain the sidewalk building permit needed to construct the culverts. Please call me if you have questions about the change or need any additional information for your review. I look forward to hearing from you soon.

Sincerely,

A handwritten signature in black ink, appearing to read "James V. Domenick".

James V. Domenick, P.E.  
Principal

xc: Ron Carter

Enclosure

FILE COPY



# City of Albuquerque

P.O. BOX 1293 ALBUQUERQUE, NEW MEXICO 87103

November 28, 1988

KEN SCHULTZ  
MAYOR

James Domenick, P.E.  
AVID Engineering, Inc.  
5801 Osuna Road, NE Suite 204  
Albuquerque, NM 87109

RE: DRAINAGE REPORT SUBMITTAL OF BARELAS COURT TOWNHOUSES, RECEIVED  
NOVEMBER 7, 1988, FOR PRELIMINARY PLAT AND SITE DEVELOPMENT  
PLAN APPROVALS. (K-14/D42)

Dear Mr. Domenick:

I have reviewed the above referenced submittal dated 11/7/88 and have the following comments to be addressed prior to approval;

1. The rear yards for lots 6, 7, 10, & 13 must be provided an outfall for surface drainage, either between the buildings or with drainage easements across adjacent lots. For lots 5 thru 8 I recommend providing space between lots 5 & 6 and 7 & 8, or else provide drainage easements and concrete gutters around the corners. For lots 9 thru 14, I recommend that drainage easements be provided along the south property line with a concrete gutter built along the rear lot line sloping east to west, and direct the runoff into 8th Street through a sidewalk culvert.
2. Provide the existing condition hydrology for the area draining to the low spot prior to it's backfilling.

Incorporating the above comments will provide for a much more flexible design of the roofs and rear yard treatments. Past experience and complaints have shown the need for providing outfalls for townhouse rear yards.

If you have any questions call me at 768-2650.

Cordially,

Roger A. Green, P.E.  
C.E./ Hydrology Section

xc: Marc Schiff, Architect


RAG/(WP+935)

AN EQUAL OPPORTUNITY EMPLOYER

# AVID

ENGINEERING, INC.

Civil • Structural • Transportation

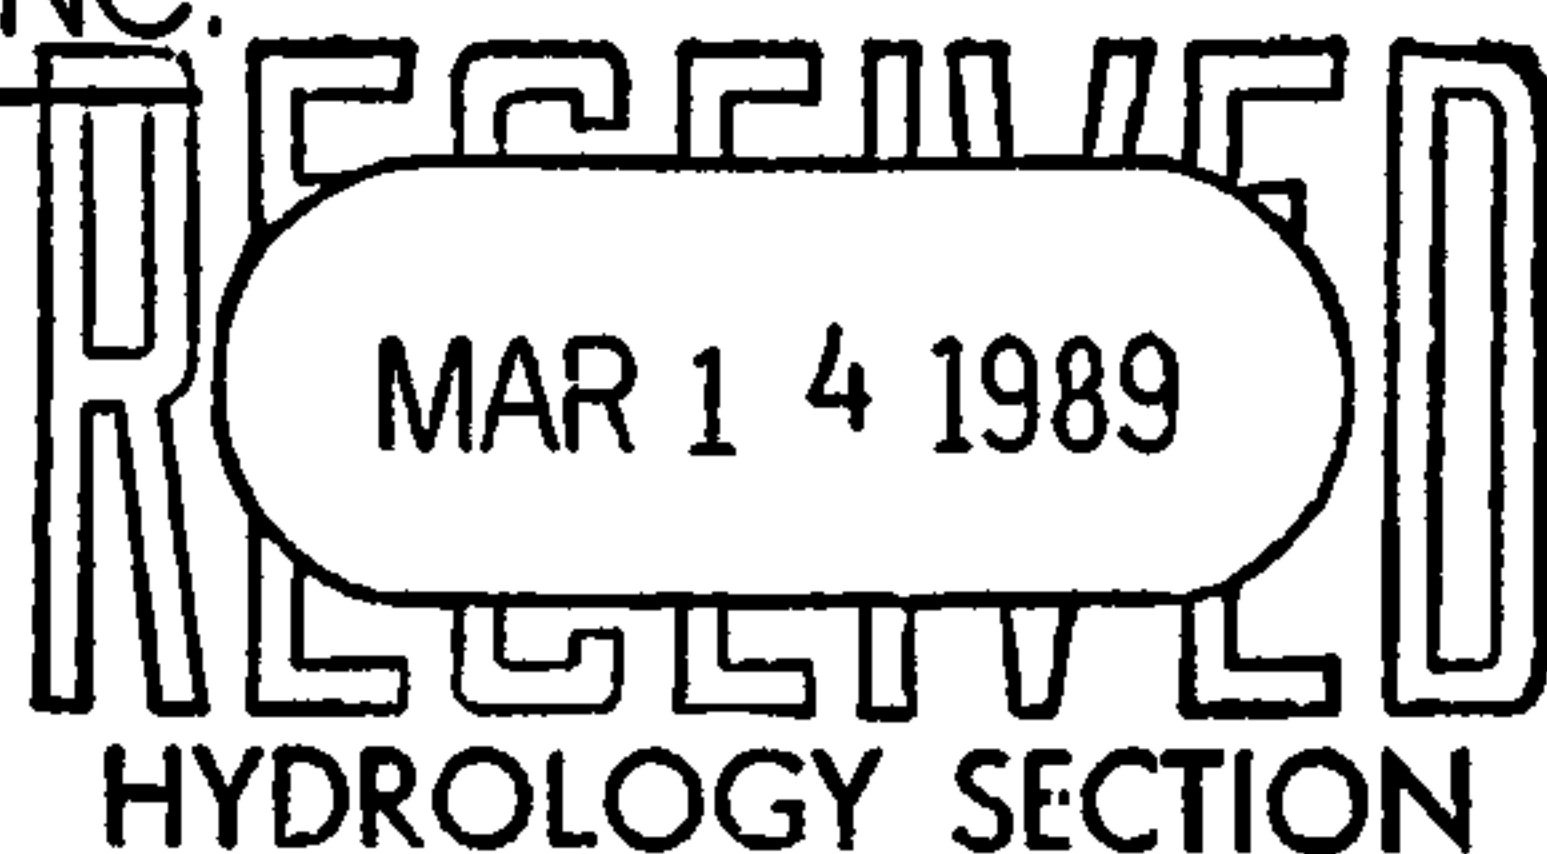

March 8, 1989

Mr. Fred Aguirre  
City of Albuquerque  
P.O. Box 1293  
Albuquerque, NM 87103

Re: Barelac Court Townhomes  
Project No. 3683  
Resubmittal of Drainage Report

Dear Fred:

We submitted the Preliminary Drainage Report for the referenced project on November 7, 1988. Mr. Roger Green of the Hydrology Section sent us a letter on November 28, 1988, requesting revisions which we have now incorporated into the Final Drainage Report. Enclosed for your review and final plat approval are two (2) copies of the Drainage Report, a Drainage Information sheet, and a copy of the conference recap sheet.

Please call me if you have questions or need any additional information.

Sincerely,

A handwritten signature in cursive script that reads "James V. Domenick". The signature is written in black ink and is positioned above the printed name and title.

James V. Domenick, P.E.  
Principal

/kc

Enclosure

xc: Ron Carter  
Marc Schiff  
Greg Olson




MAR 7 1990


HYDROLOGY DIVISION



BARELAS COURT  
UNIT #9 - DRAINAGE

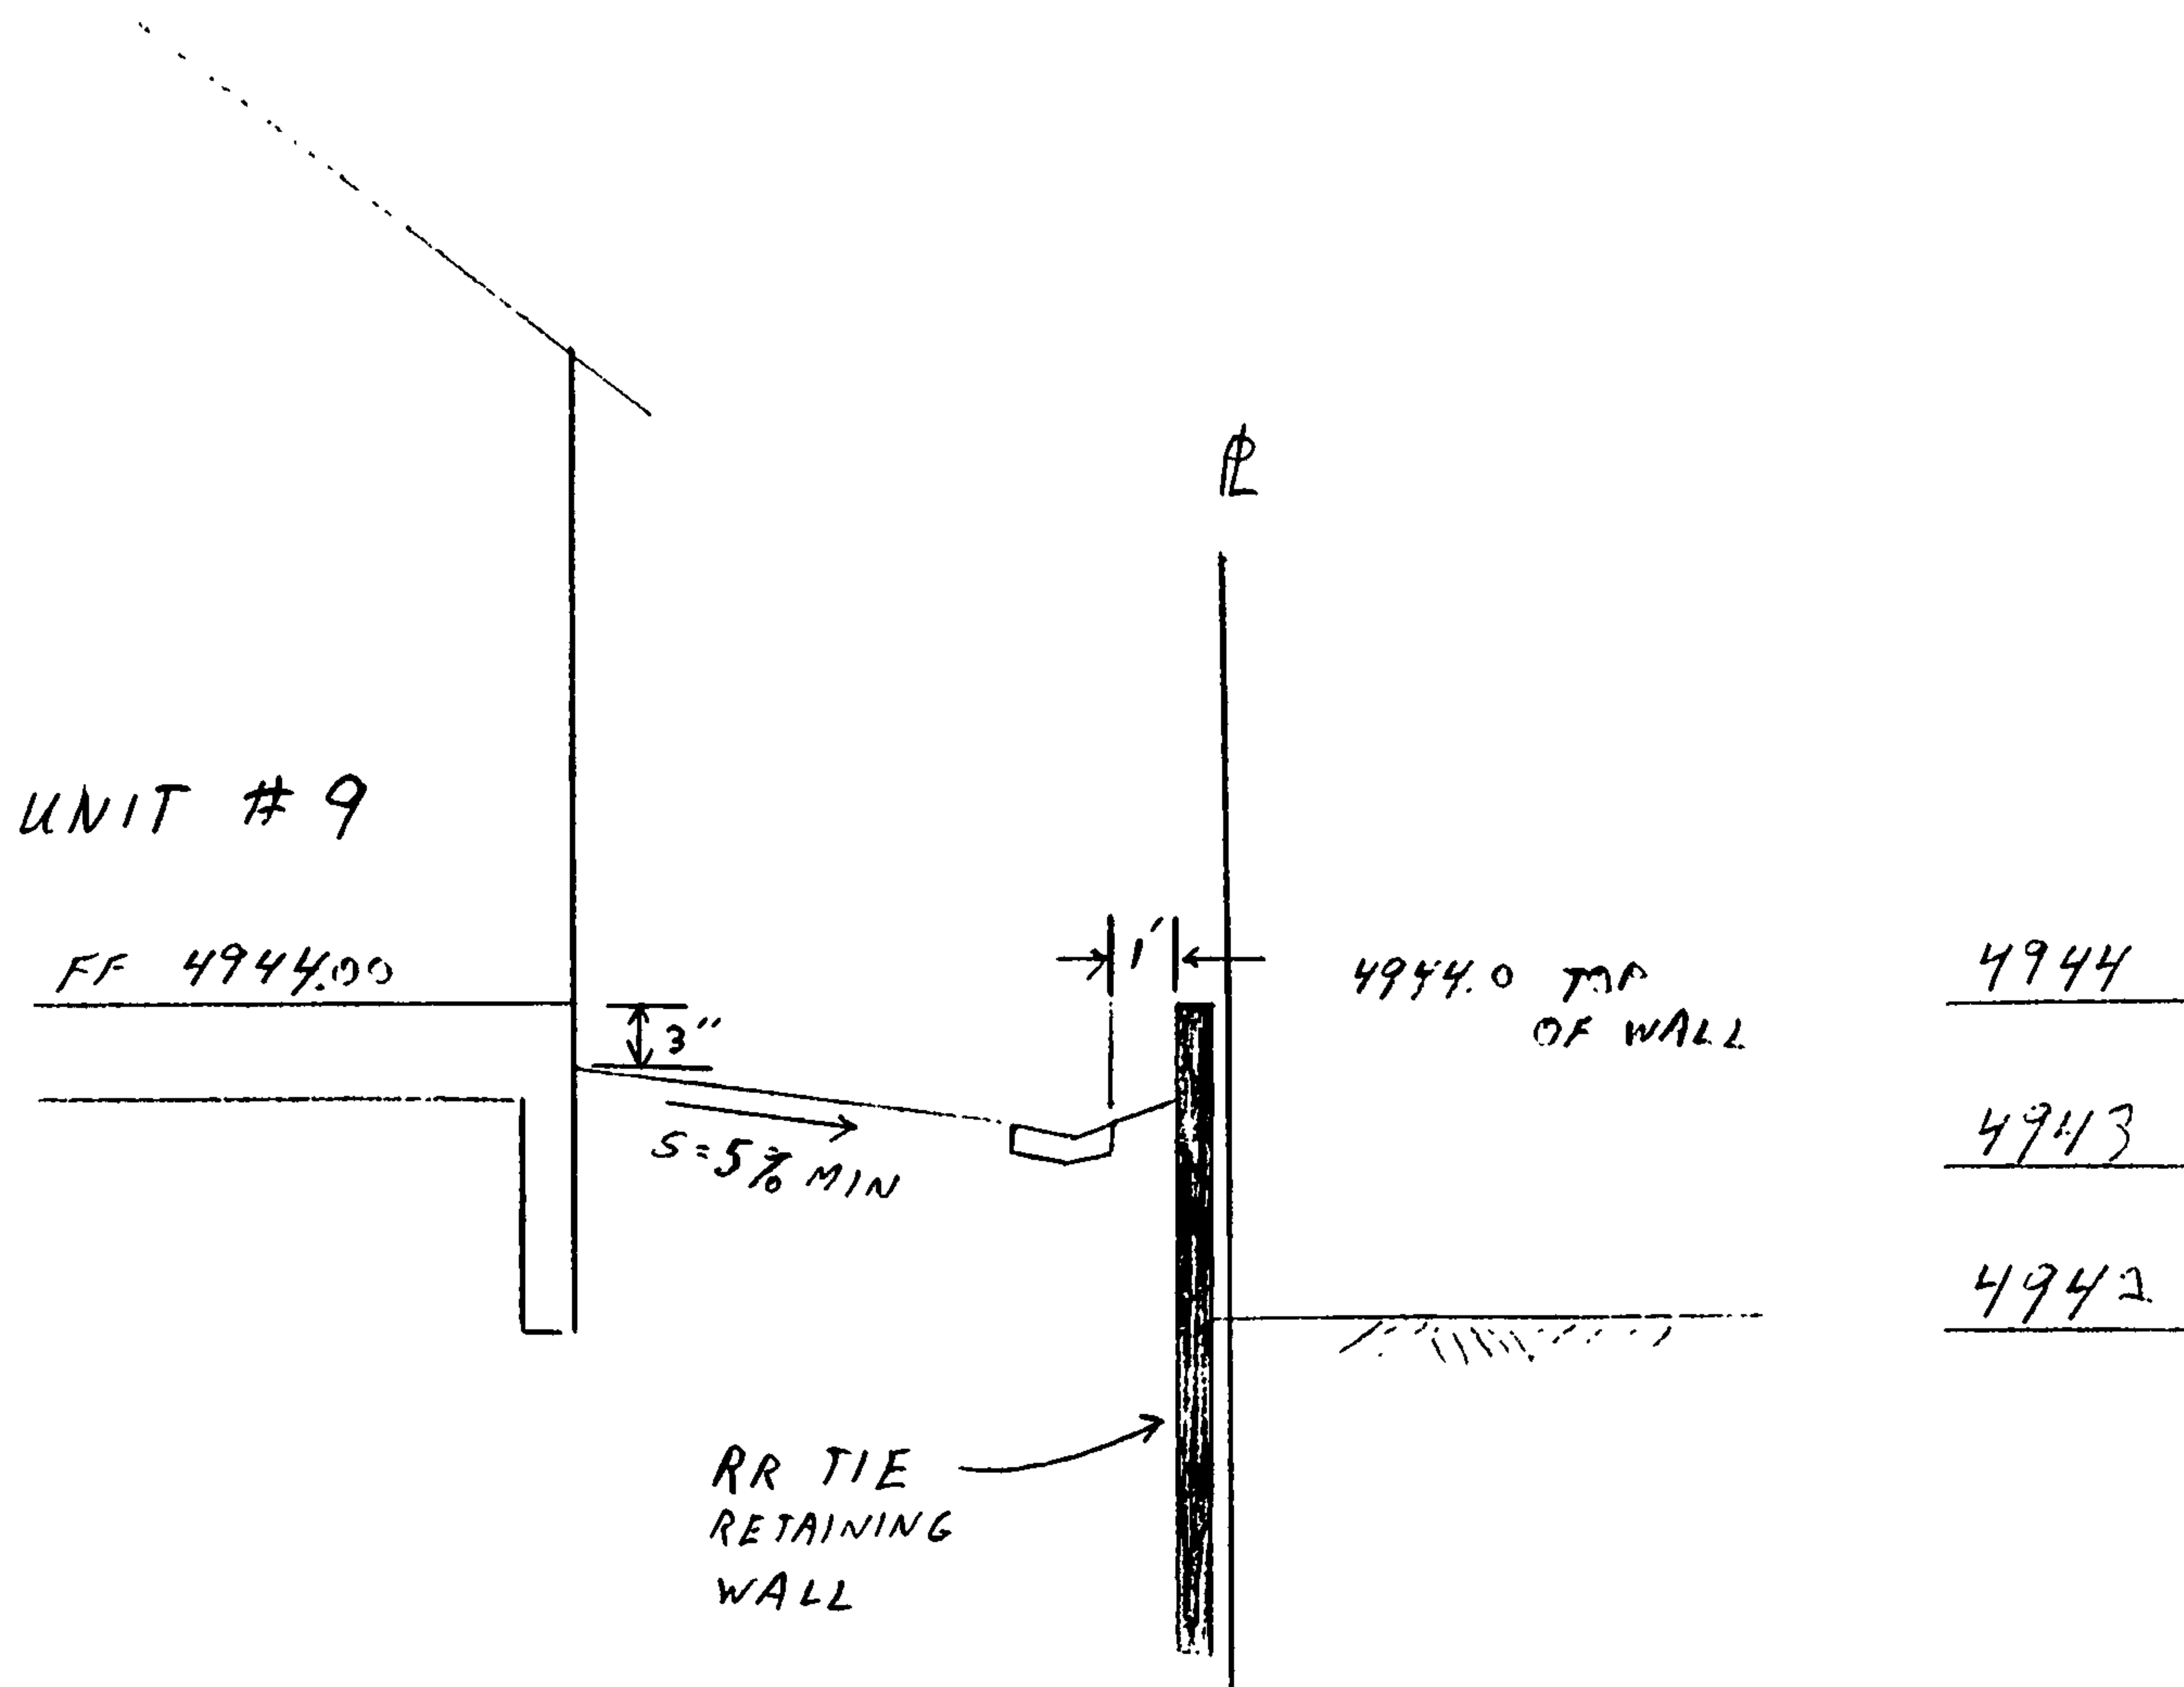

SECTION A-A

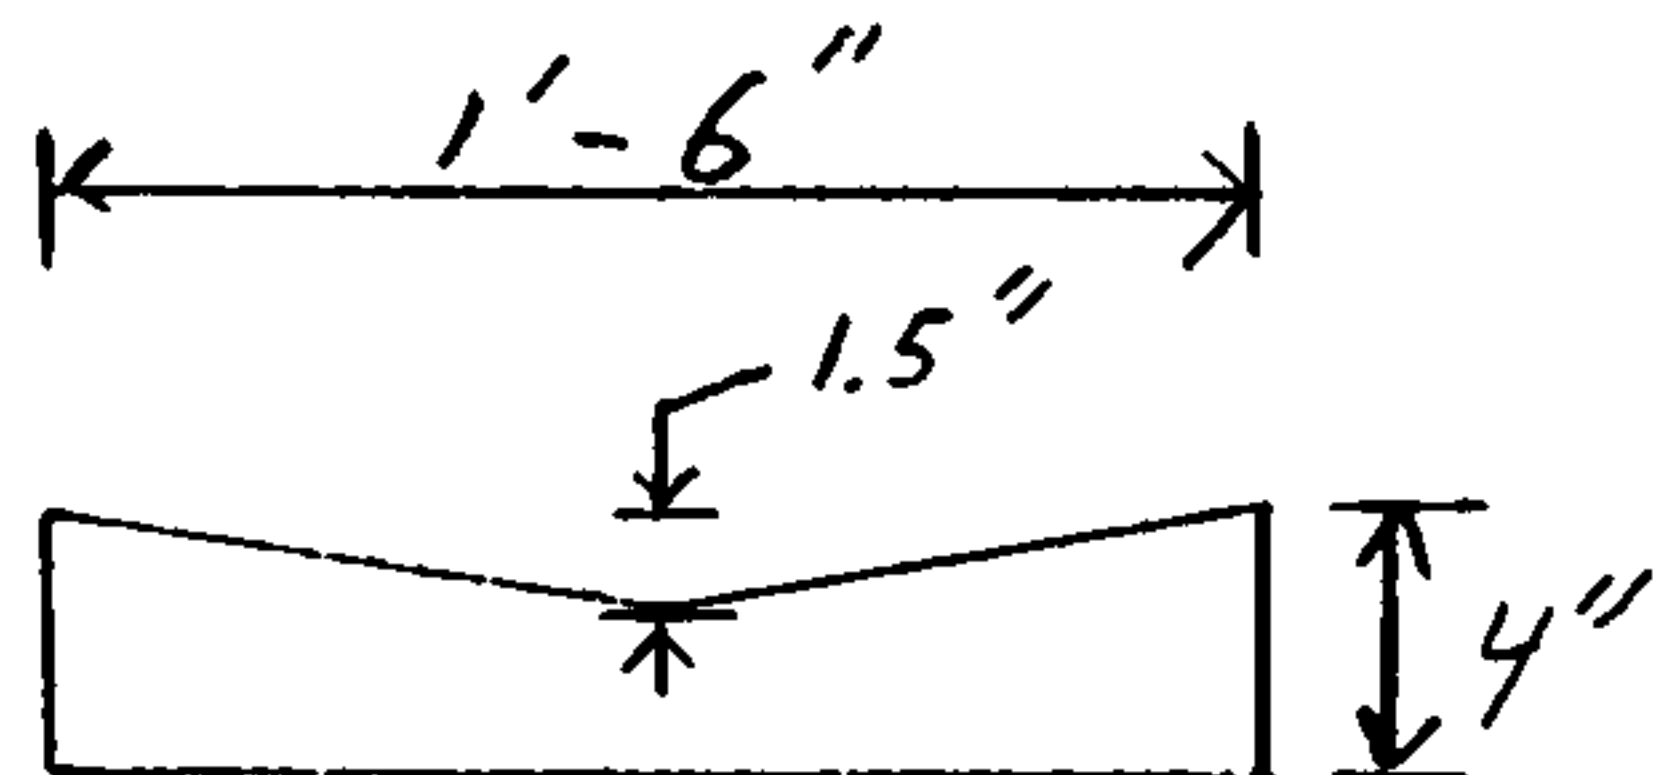


RUNDOWN DETAIL

SCALE: 1' = 5' HOR  
1" = 2' VERT

PROJECT NAME BARELAS COURT  
PROJECT NO 88008  
SUBJECT UNIT #9 DRAINAGE

SHEET 2  
BY J.D.  
CDD

OF  
DATE 2/5/93  
DATE

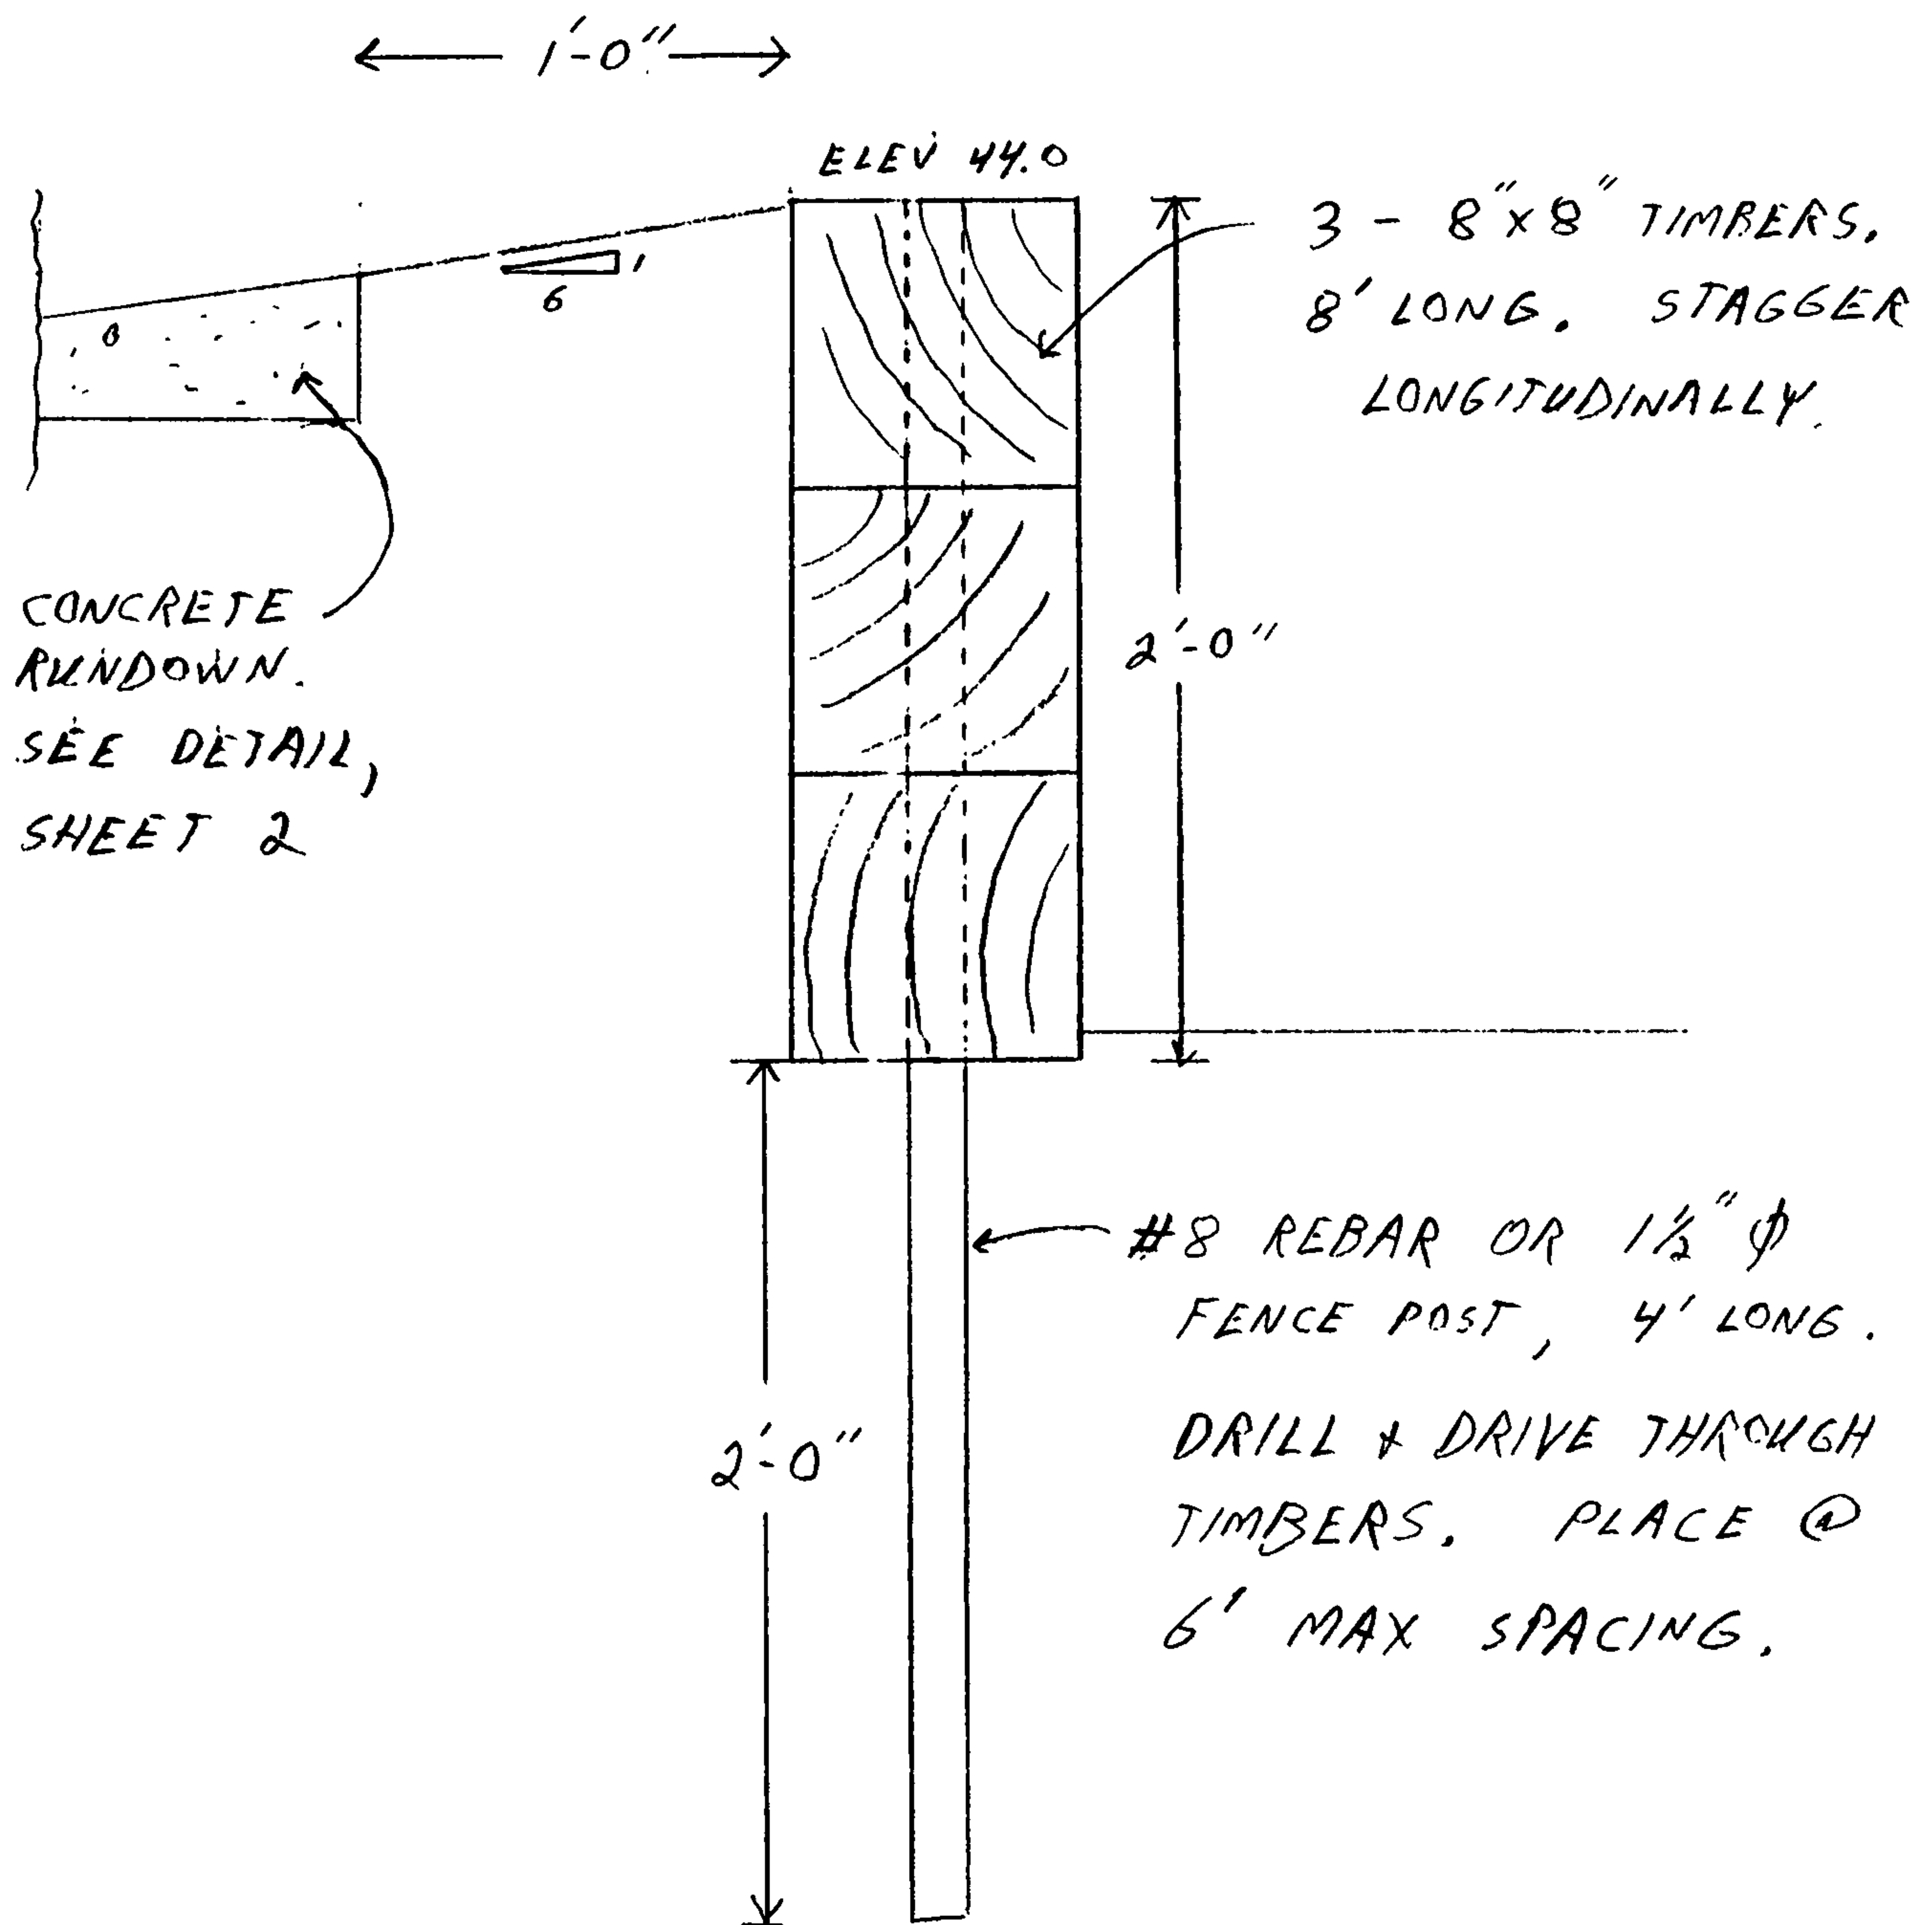

PROJECT NAME BARELAS COURT  
PROJECT NO. 88009  
SUBJECT UNIT #9 DRAINAGE

SHEET 3  
BY JD  
CDD

OF 3  
DATE 2/7/94  
DATE



EIGHTH STREET

Remove Existing  
Driveway & Construct  
Curb & Gutter &  
Sidewalk, Match  
Grade w/ Existing  
Sidewalk And C&G

Remove Existing  
Sidewalk And C&G.  
Construct New  
Valley Gutter

MAR 7 1990  
HYDROLOGY DIVISION


BARELAS COURT  
(NEW)


CONSTRUCT 12" WIDE  
SIDEWALK CULVERT.  
COA. DWG 2236

60 LF CONCRETE  
S=0.005


Construct 18" Wide x  
4' Long Sidewalk Culvert  
w/ Steel Top. See COA  
5th Drawing 2236

BARELAS COURT  
DRAINAGE  
UNITS 1, 2, + 3

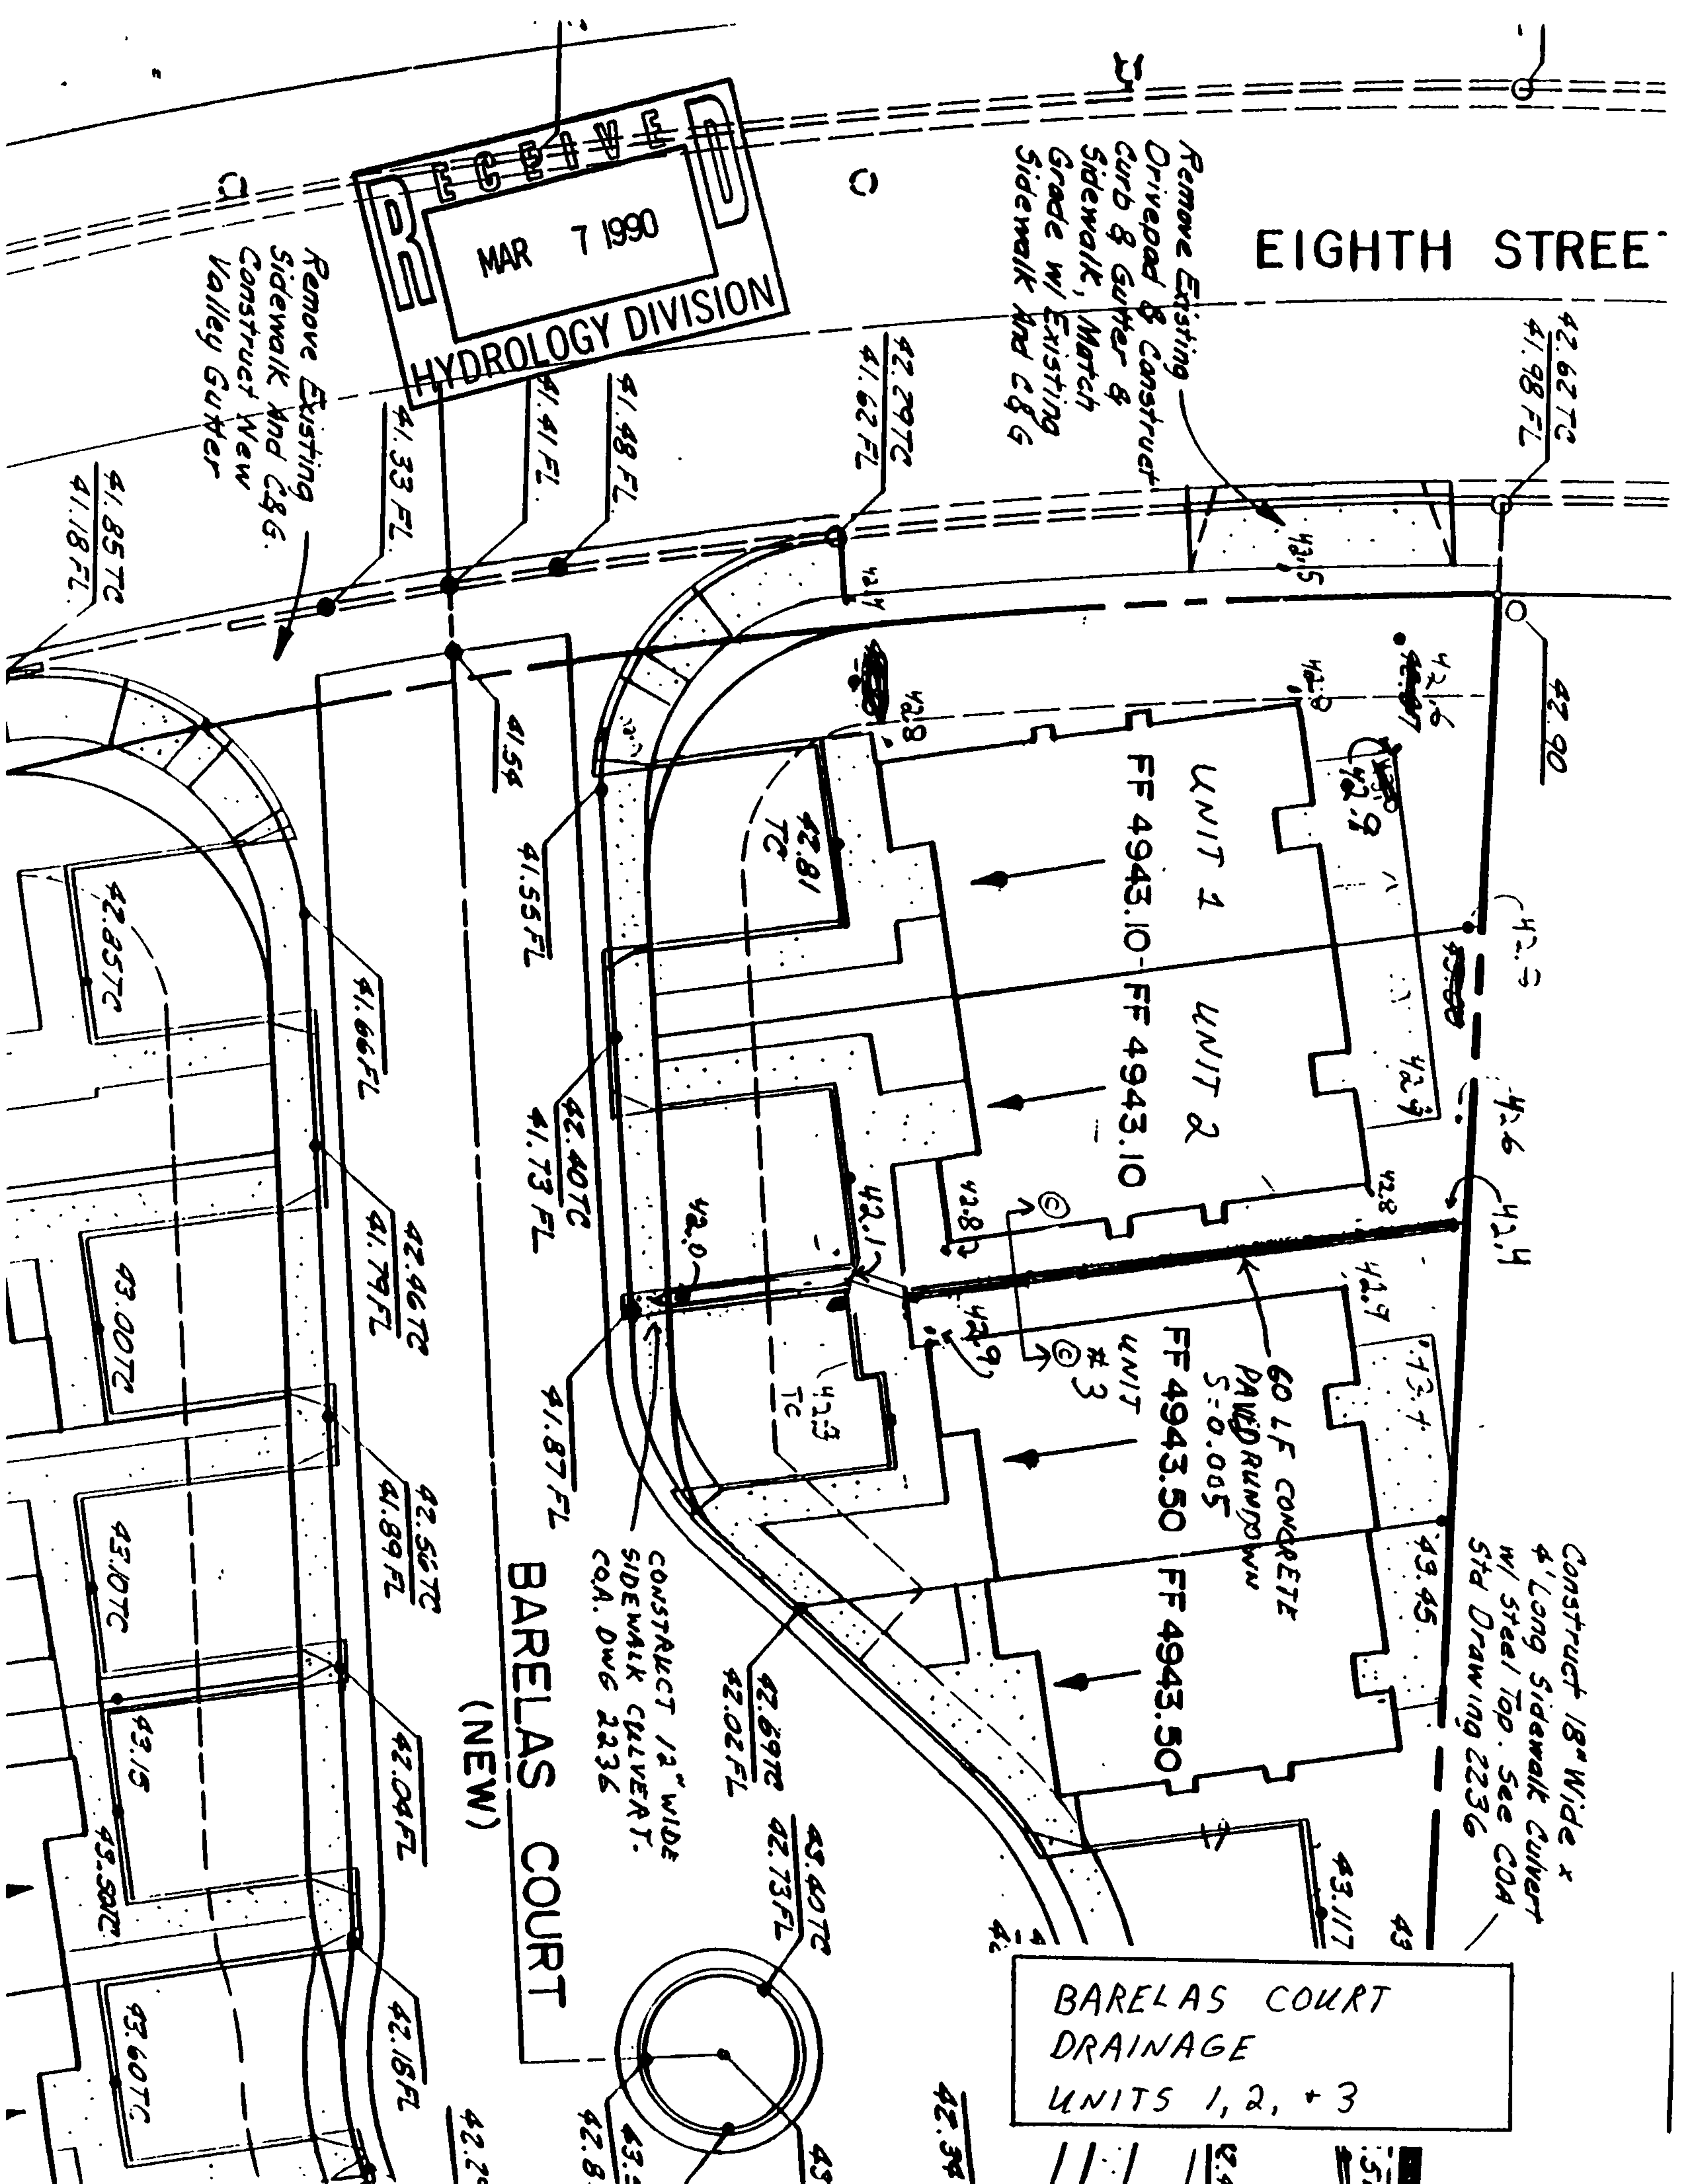

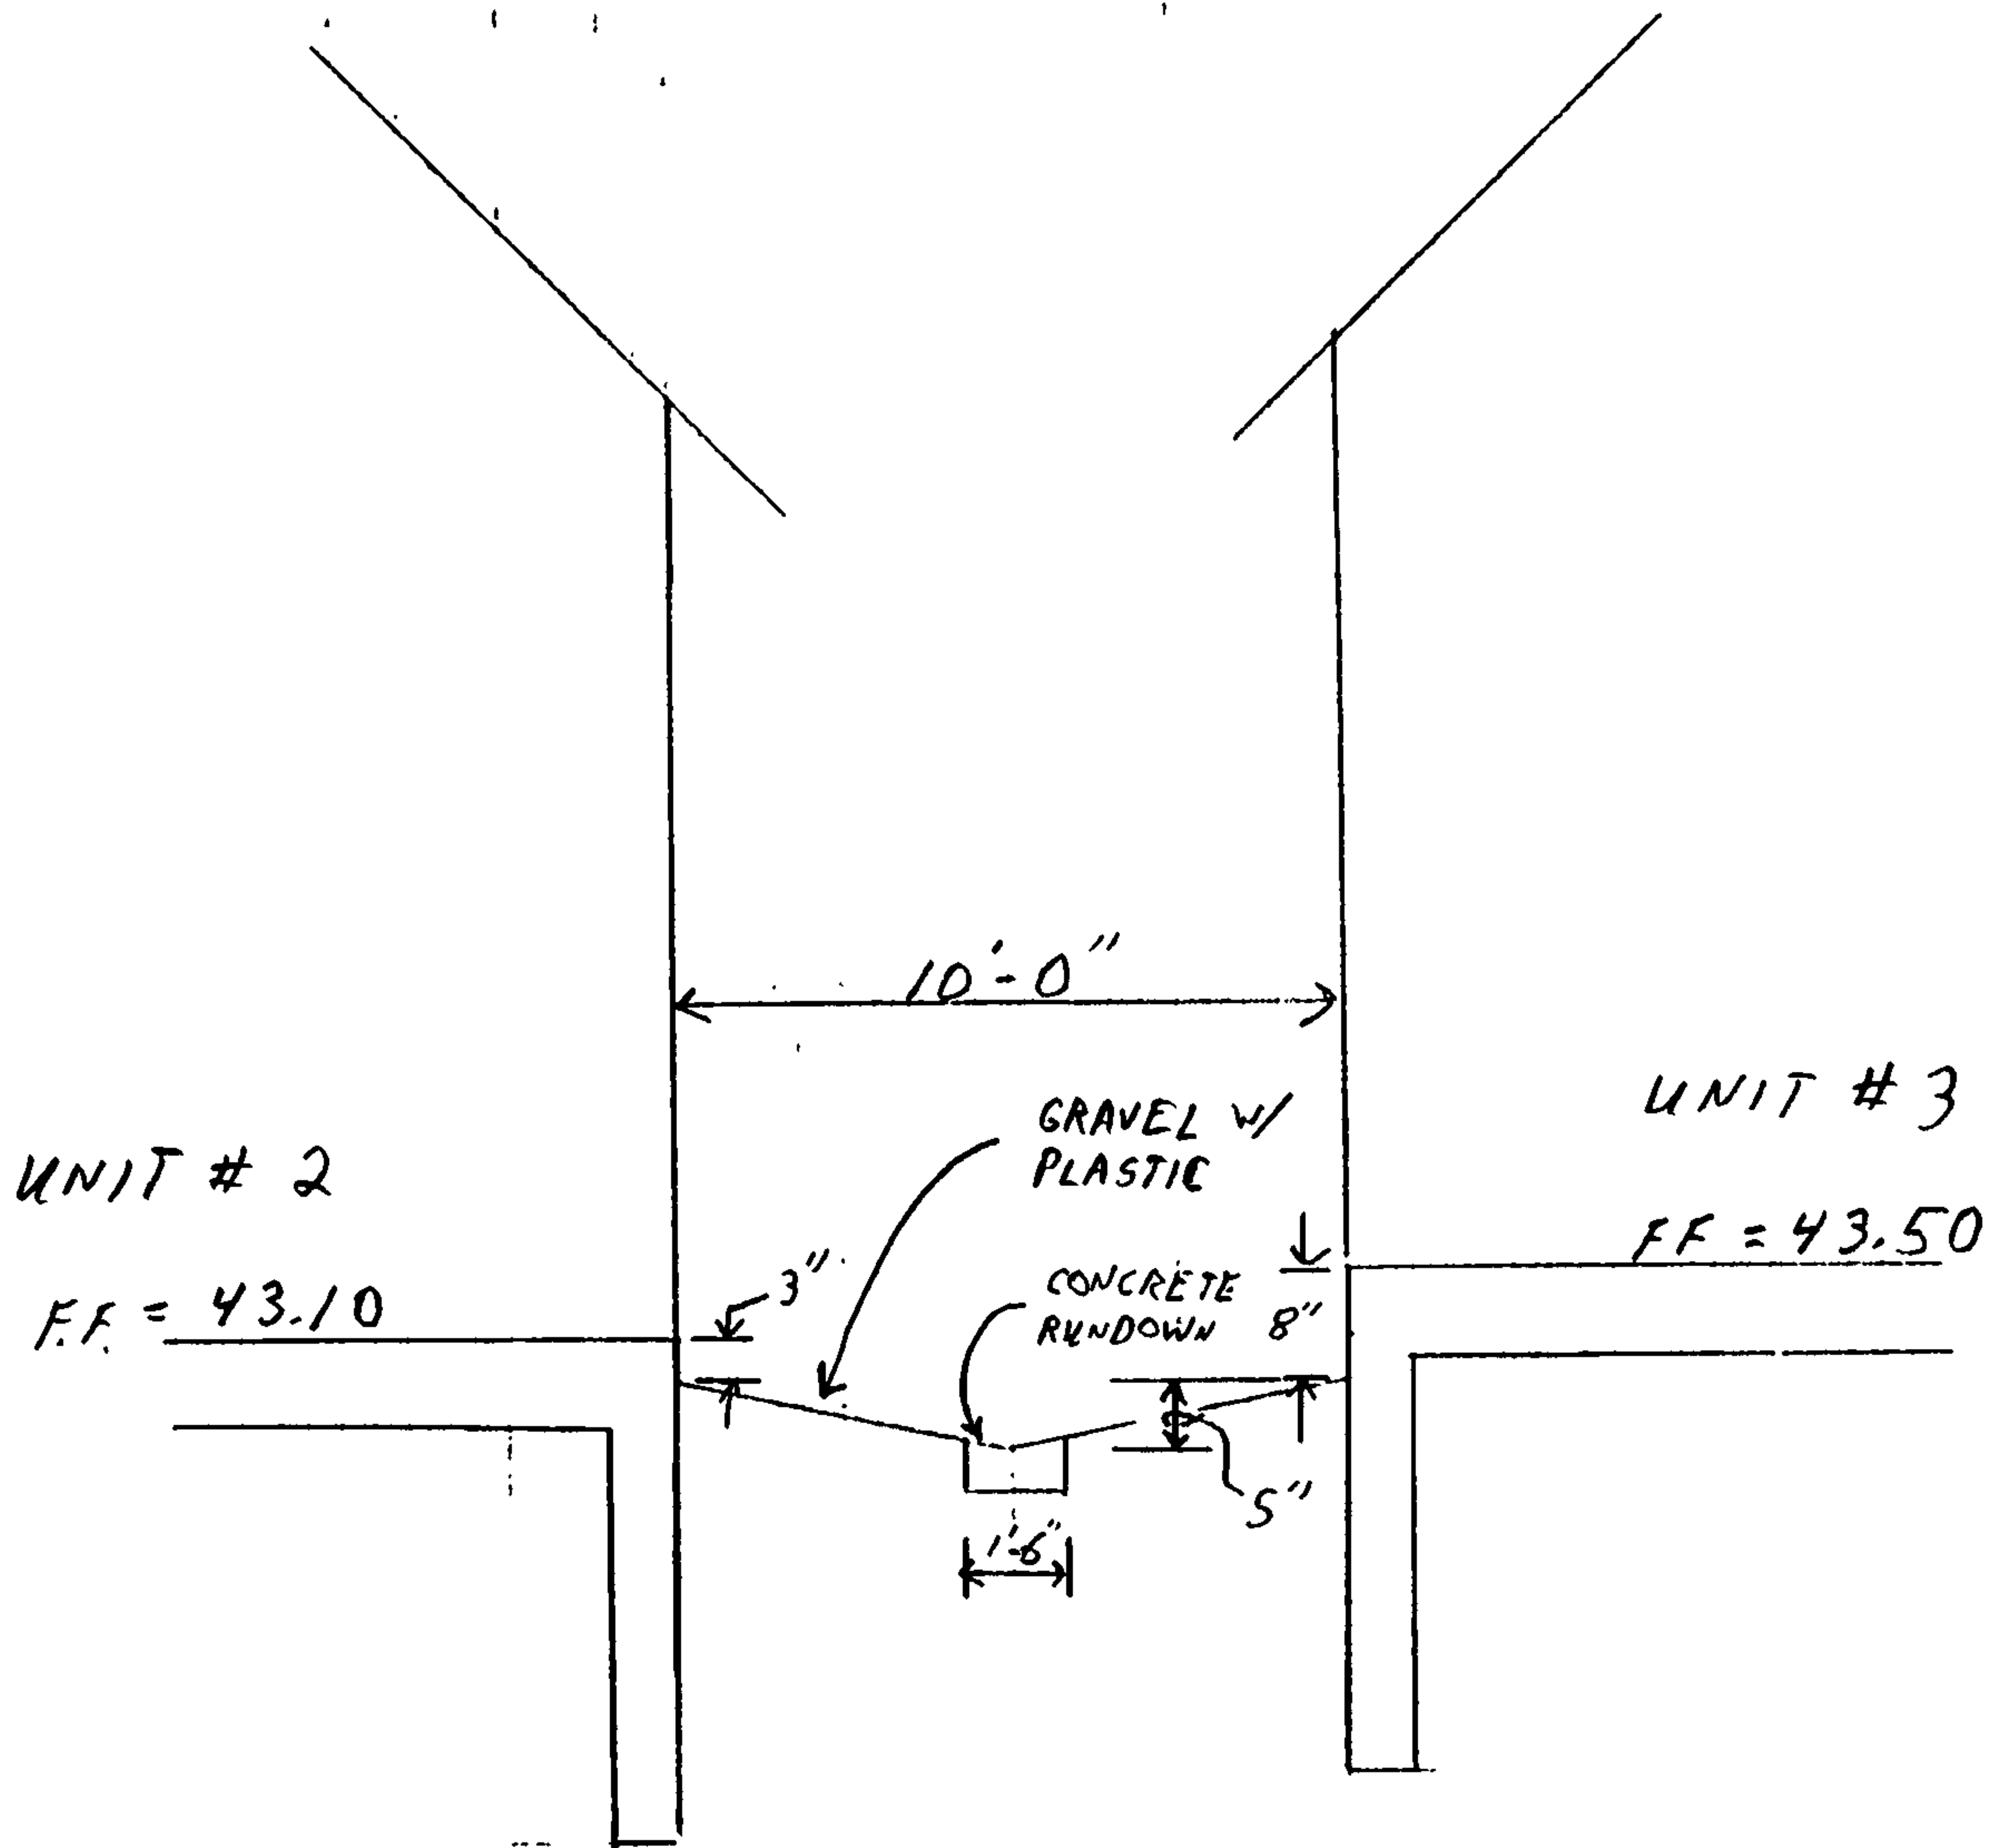

ELEVATION  
(SECTION C-C)


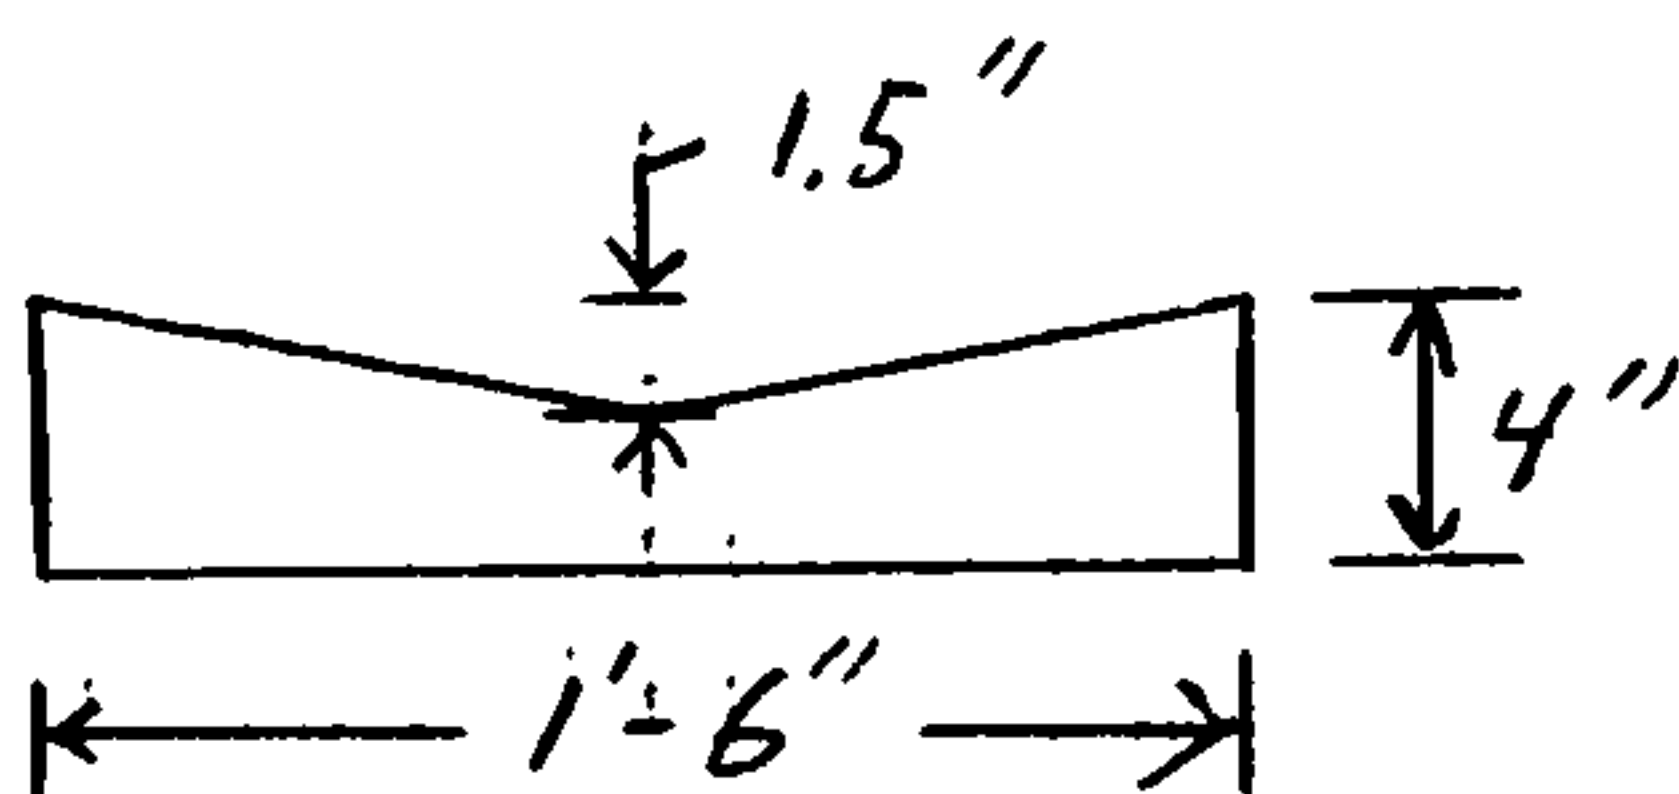


RUNDOWN DETAIL

SCALE: 1" = 5' HOR  
1" = 2' VERT

PROJECT NAME BARELAS COURT SHEET 2  
PROJECT NO. 88009 BY JD  
SUBJECT UNITS 1, 2, + 3 - DRAINAGE CDD

OF 3  
DATE 2/5/90  
DATE

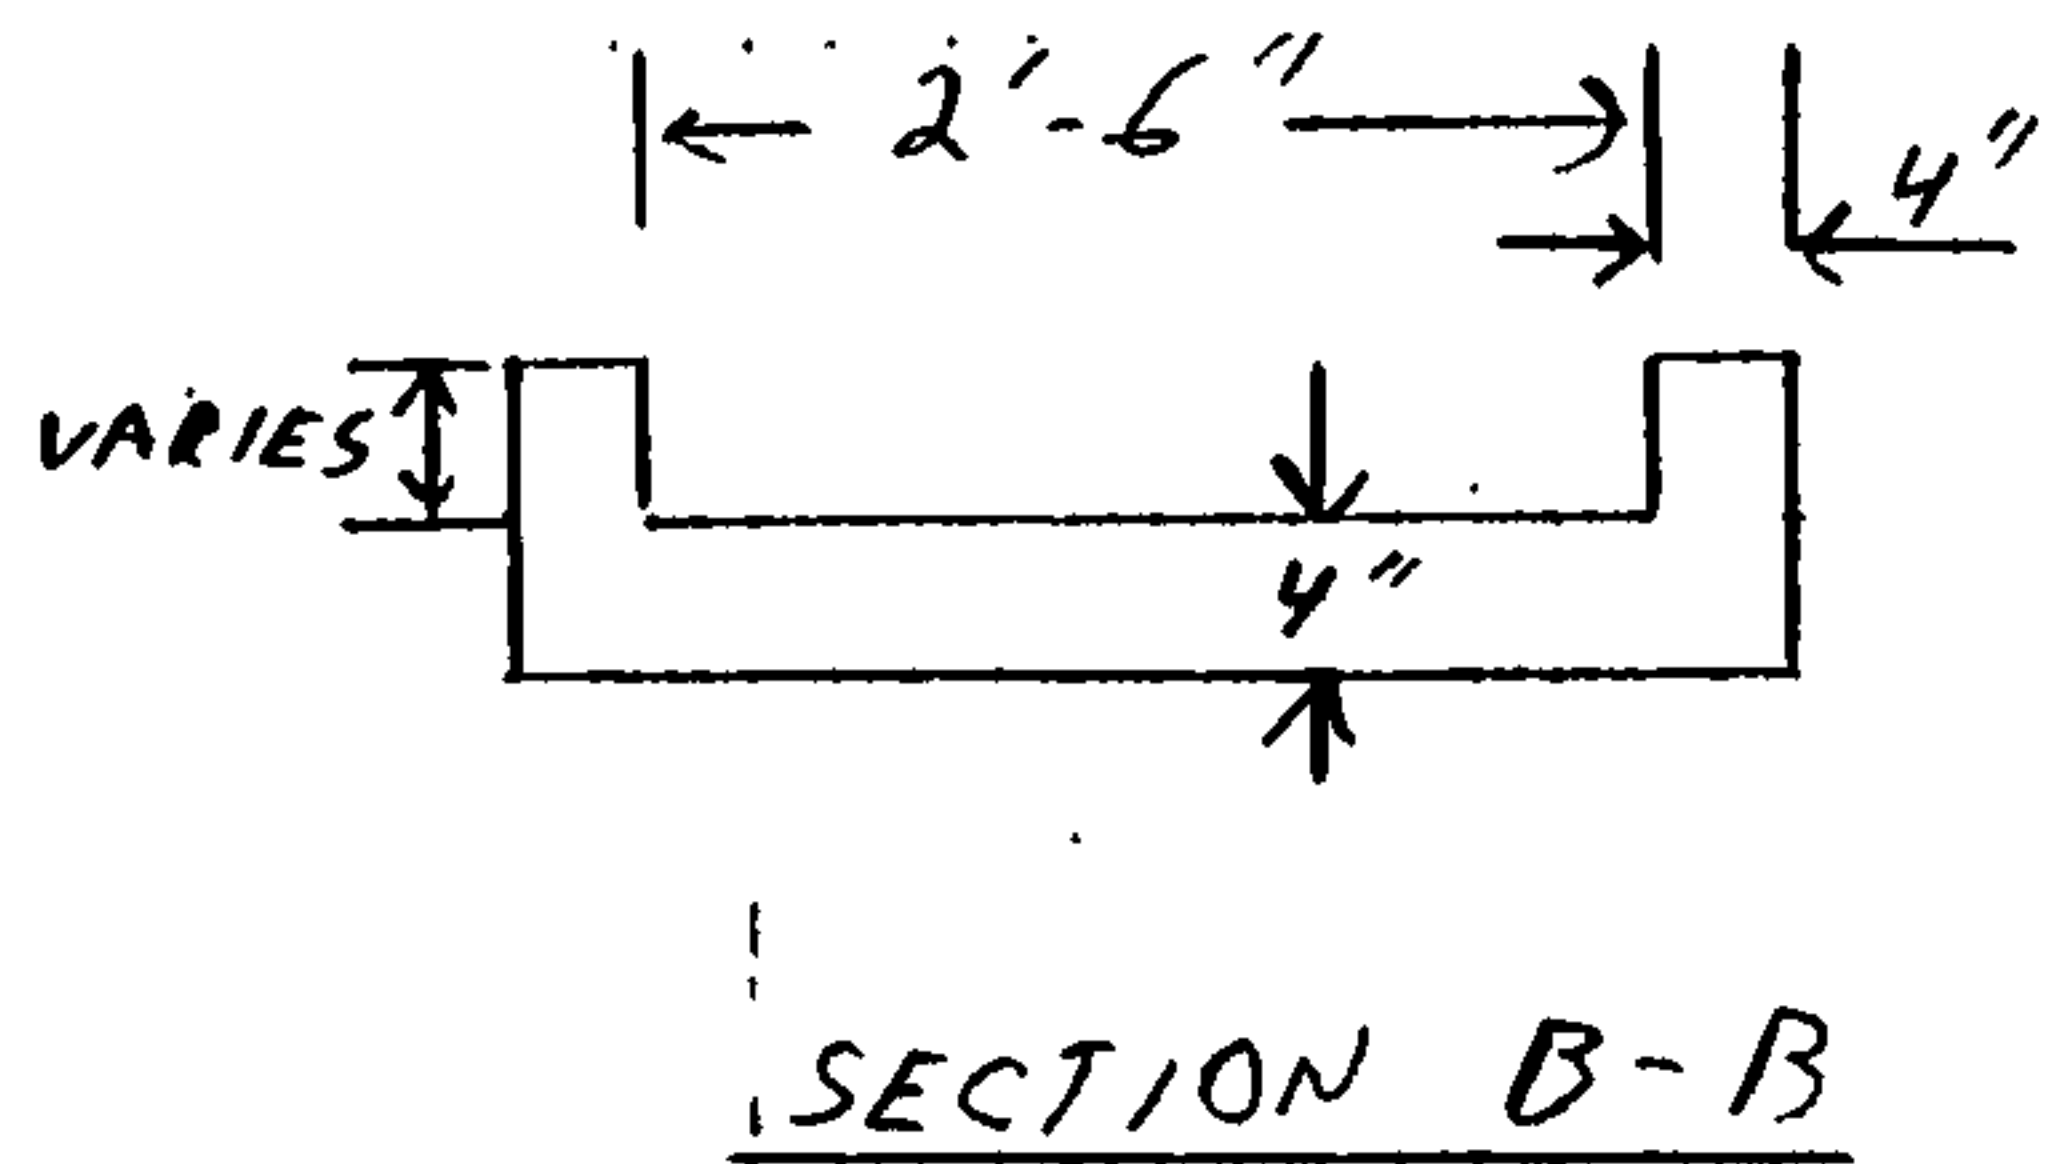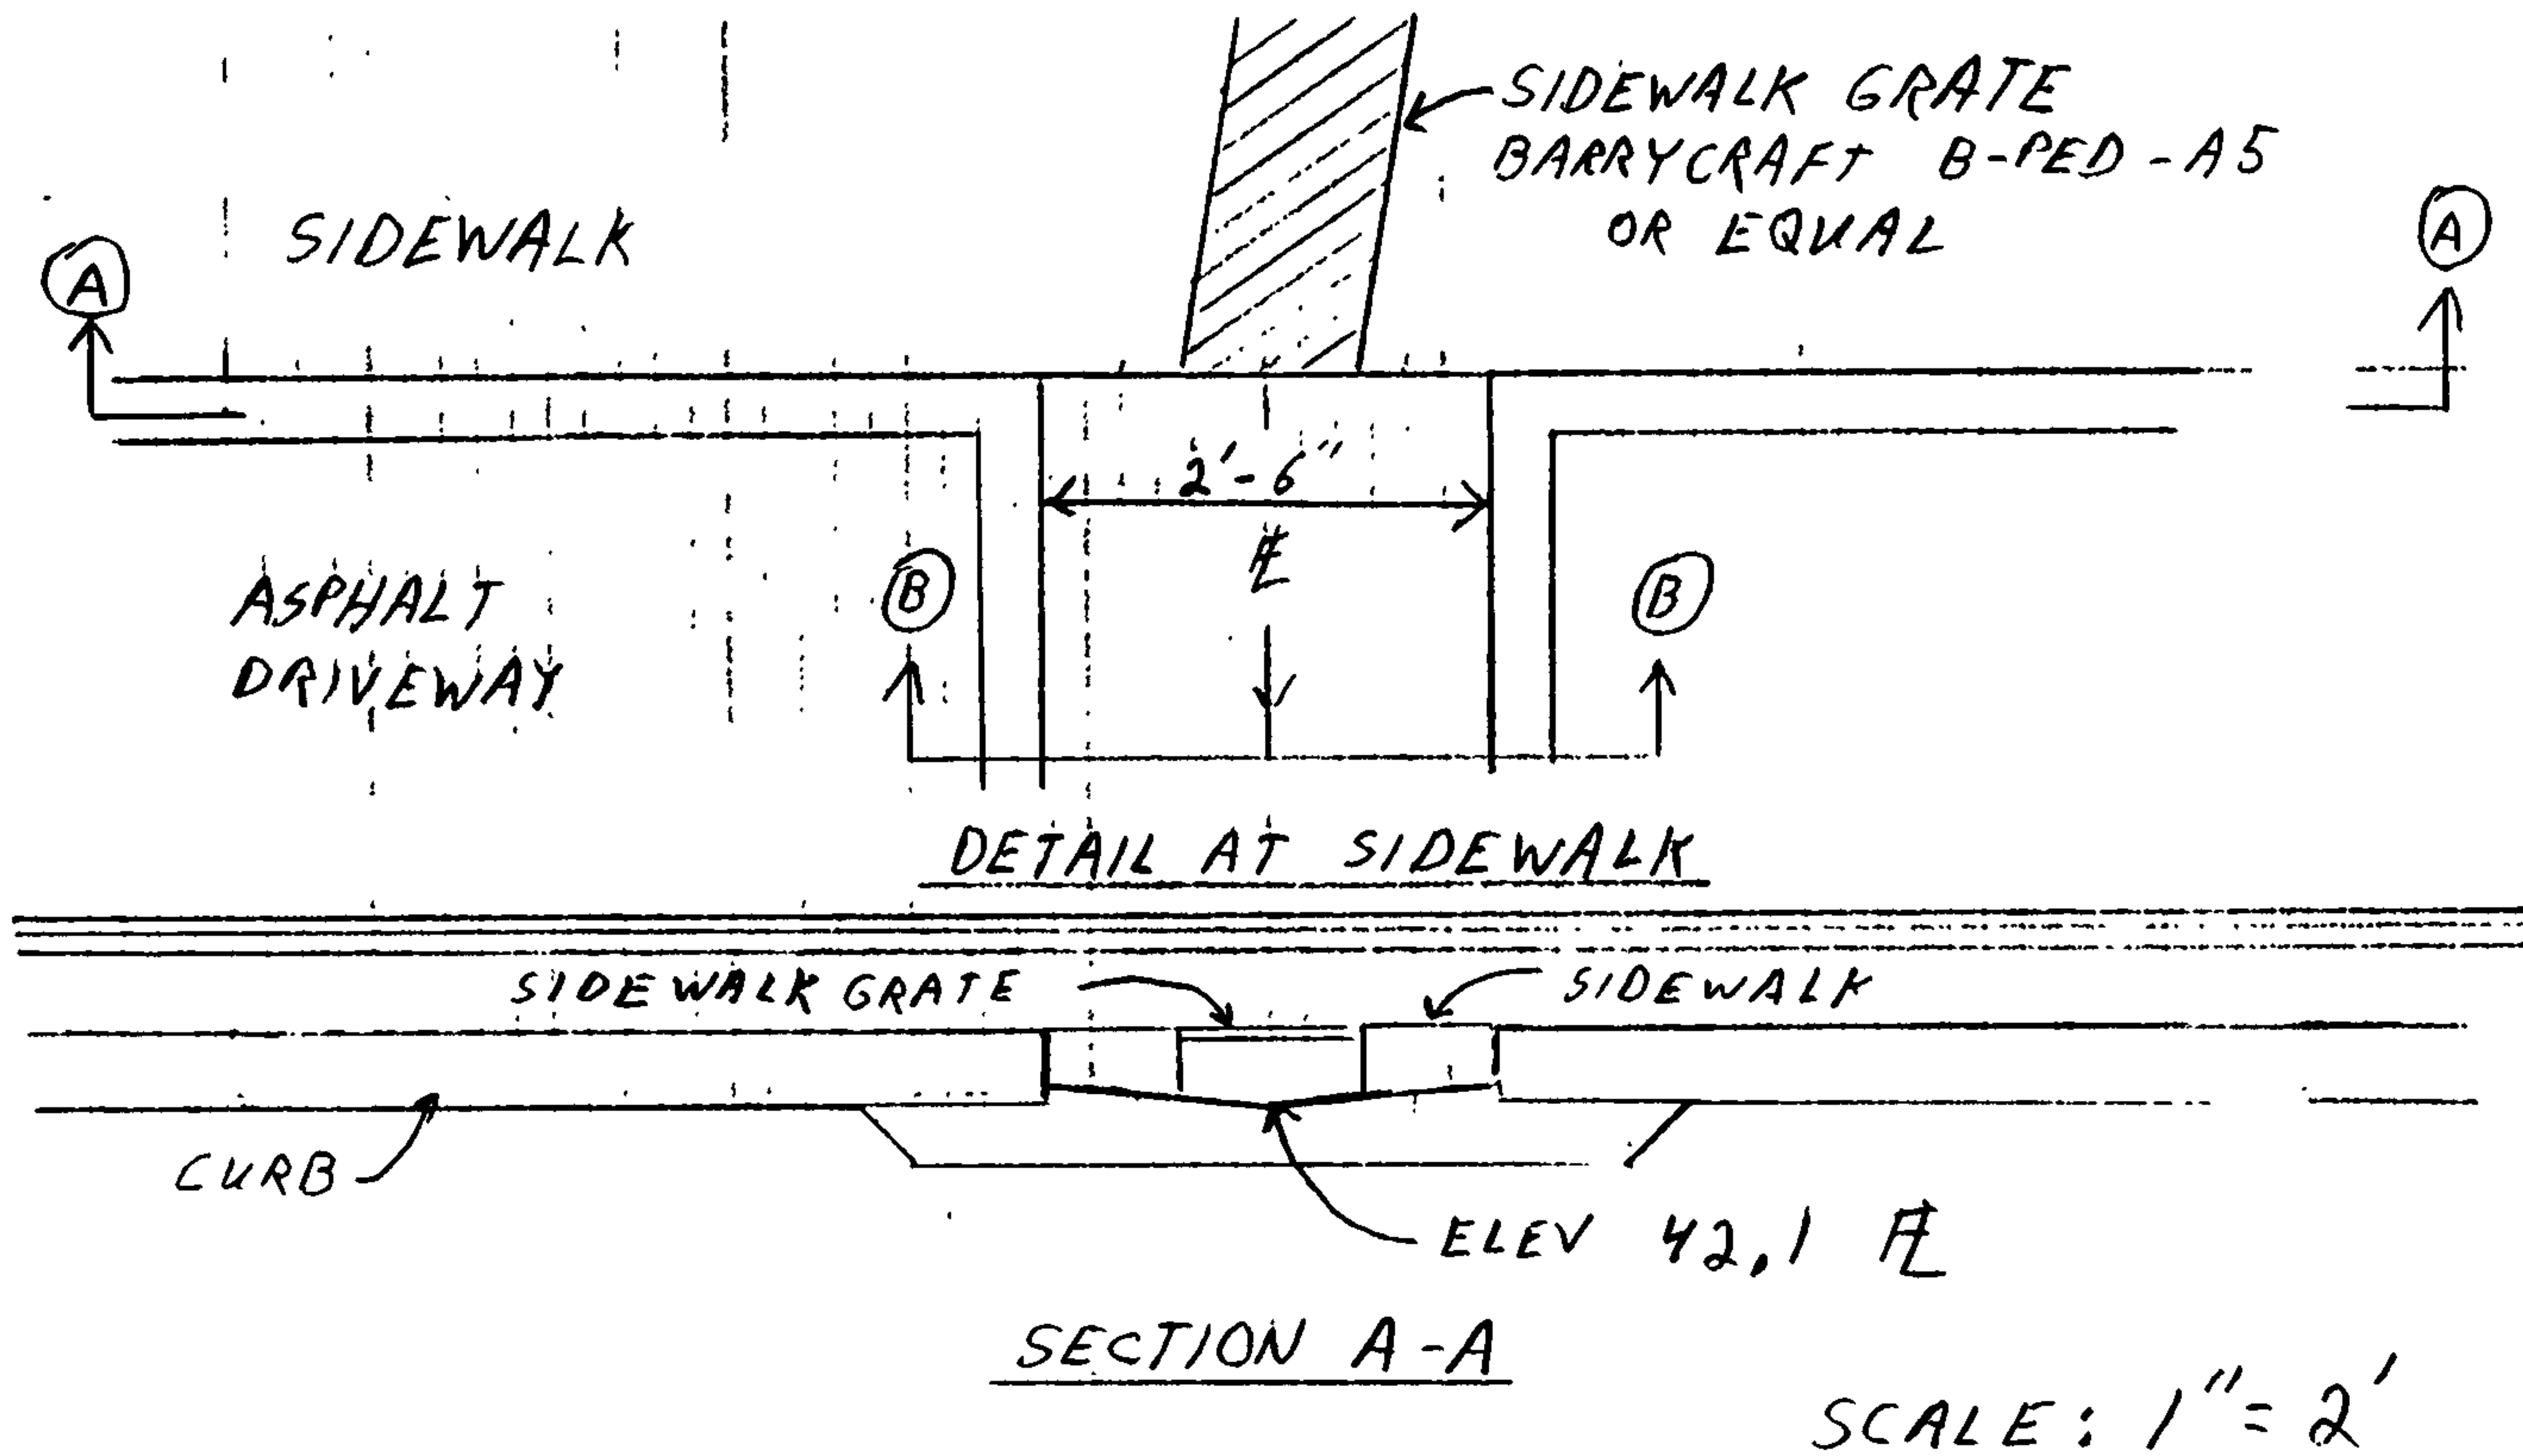

PROJECT NAME BARELAS COURT

PROJECT NO. 88009

SUBJECT UNITS 1, 2, + 3 - DRAINAGE

SHEET 3

BY JD


CH'D

OF 3


DATE 2/5/90

DATE




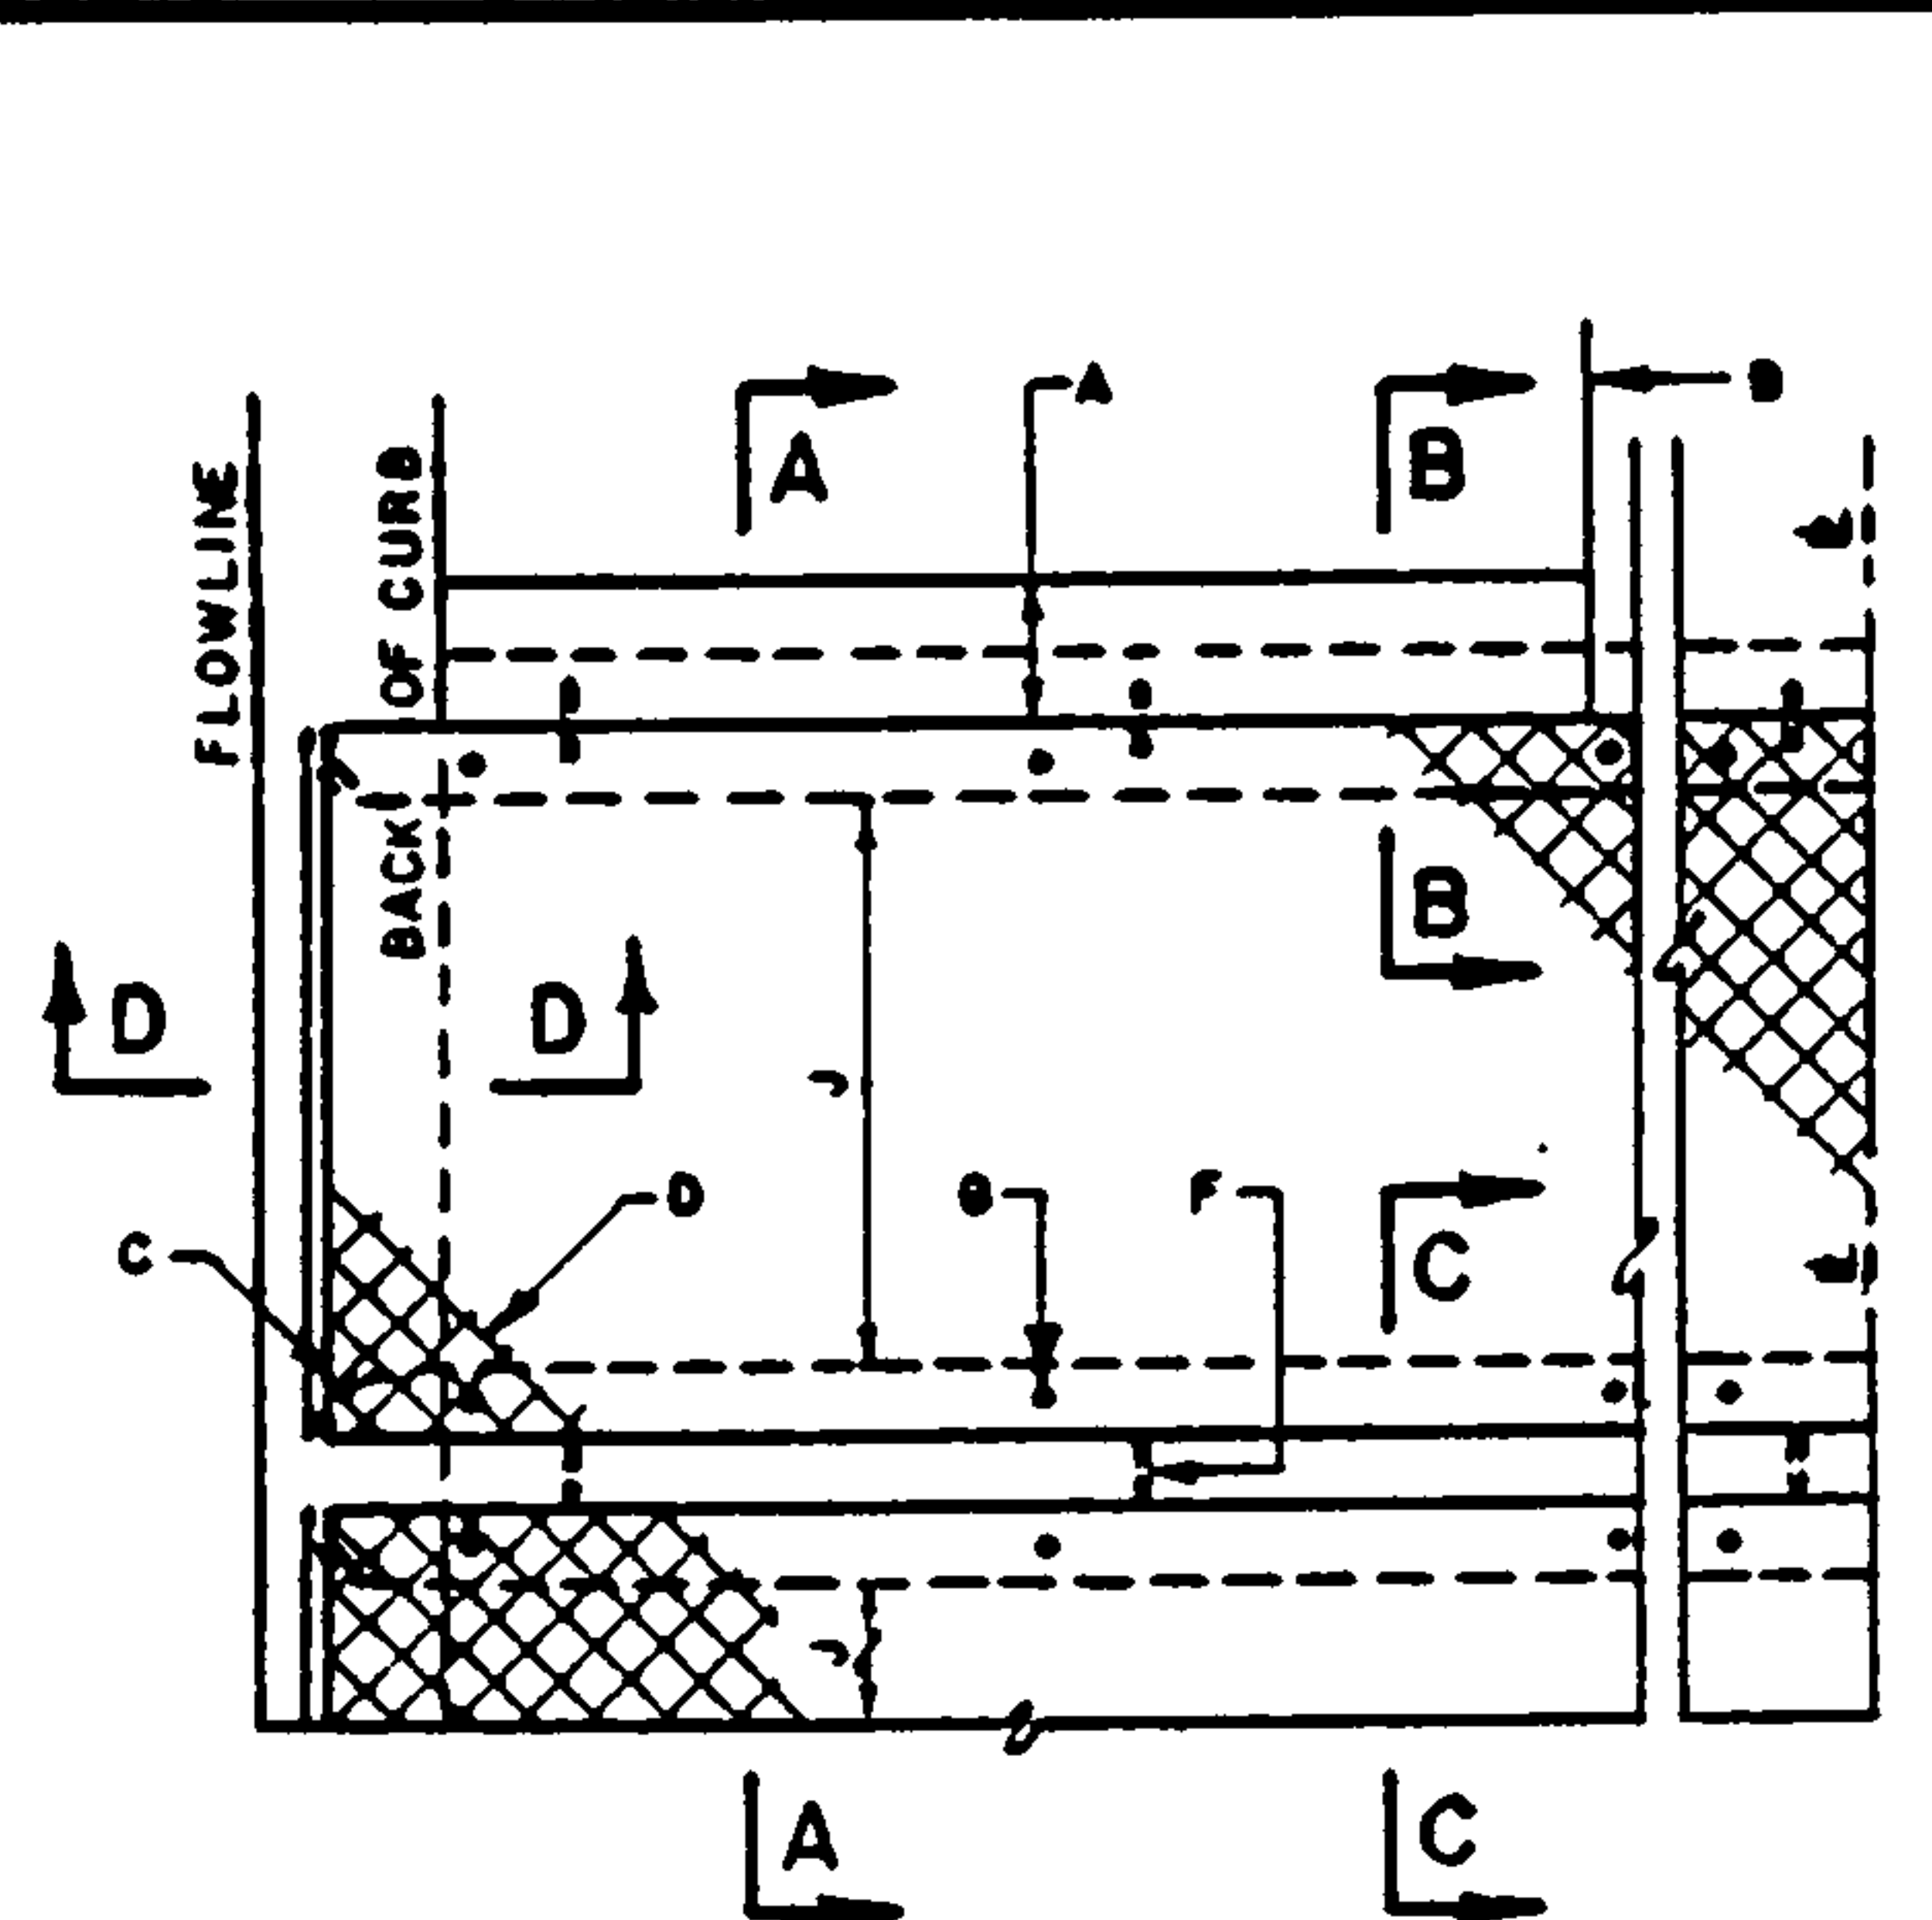


PLAN  
SINGLE AND OR MULTIPLE CULVERT

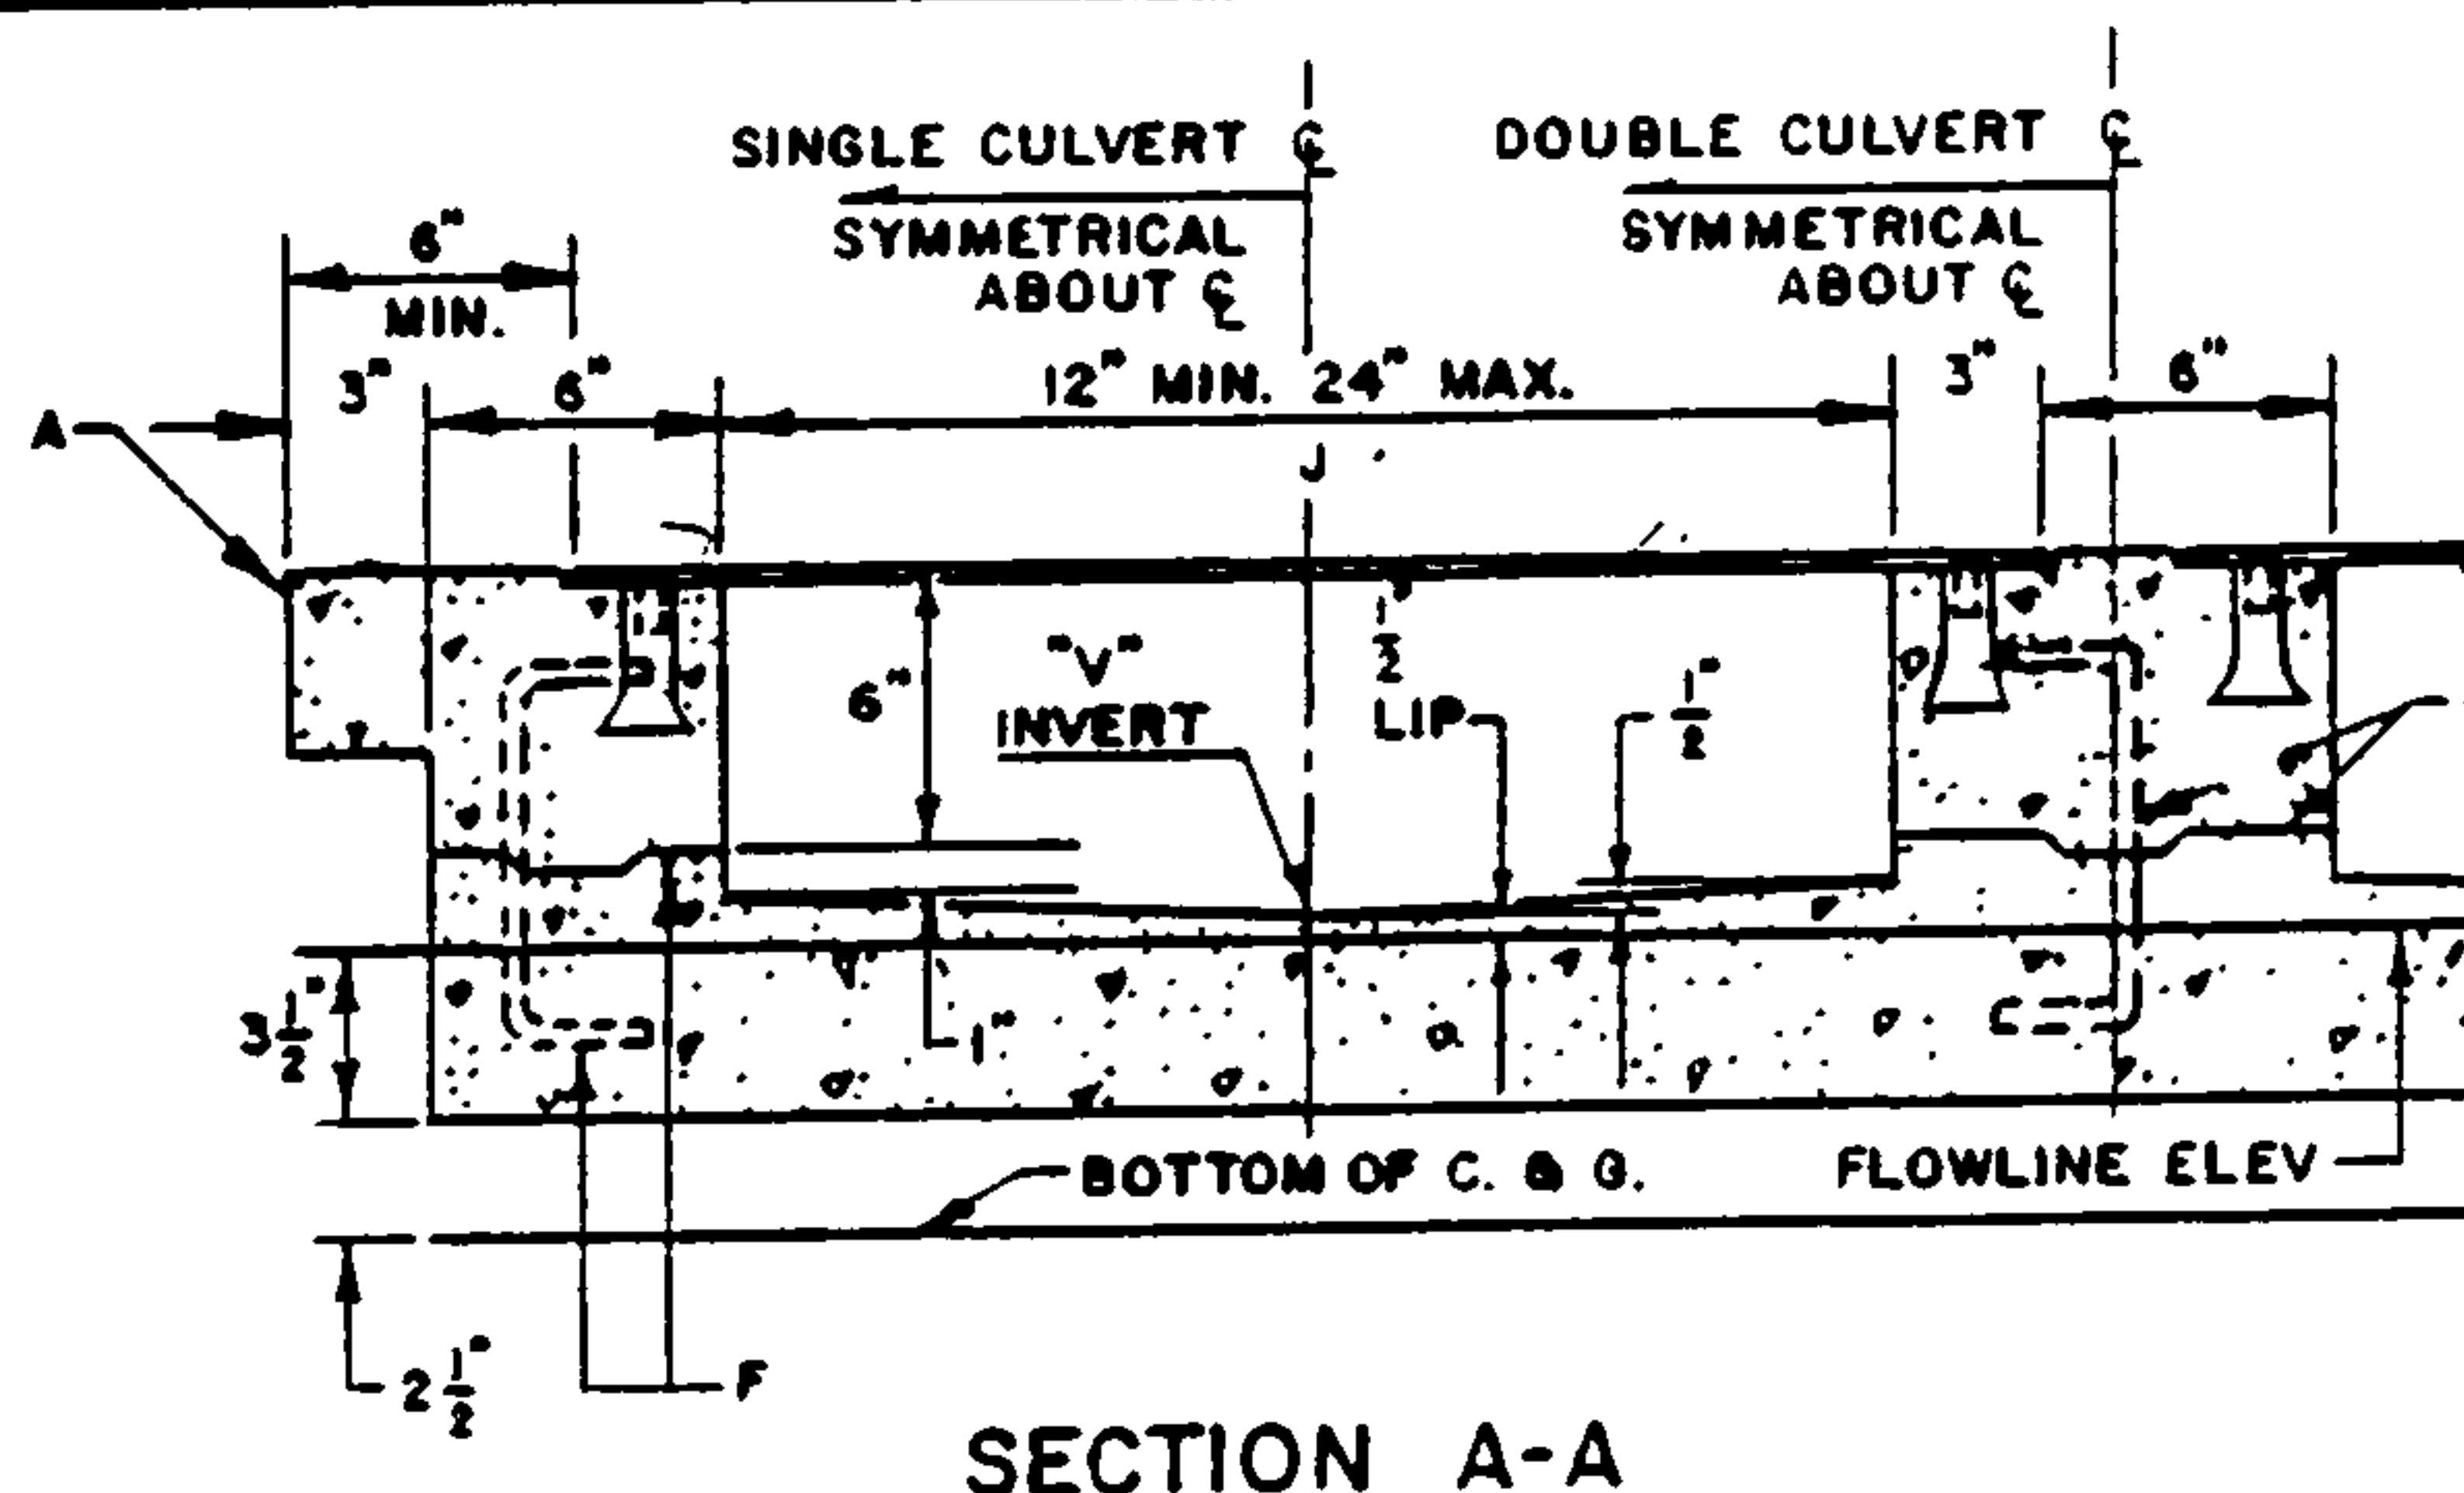


SECTION A-A

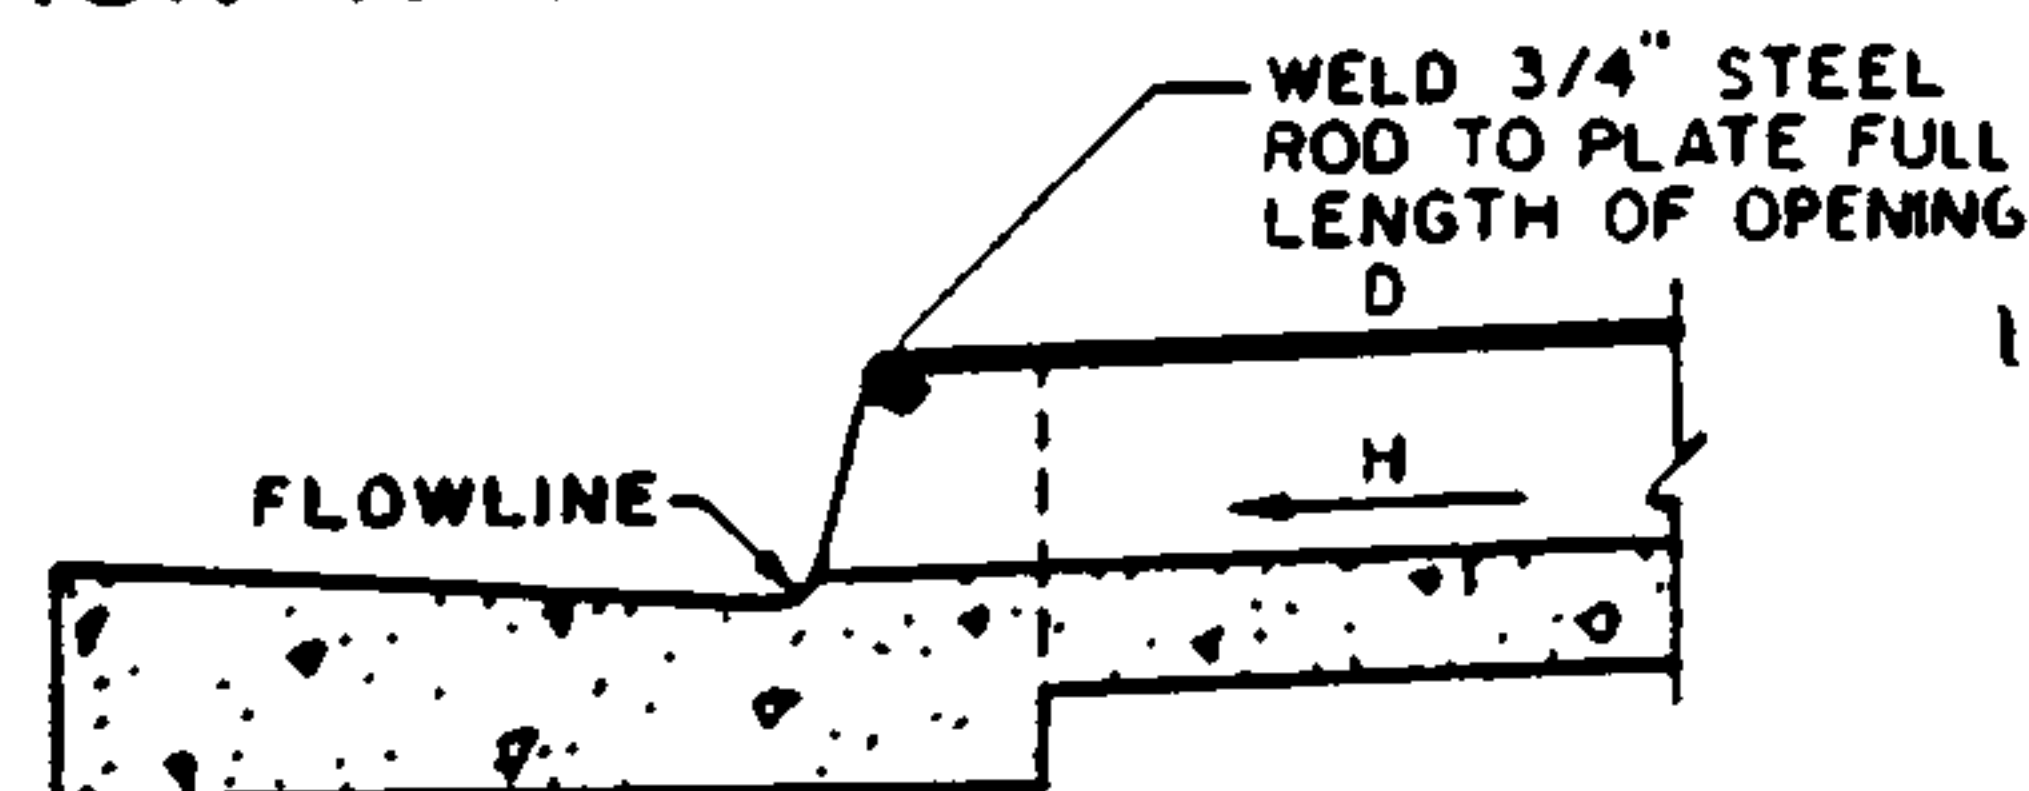


SECTION D-D

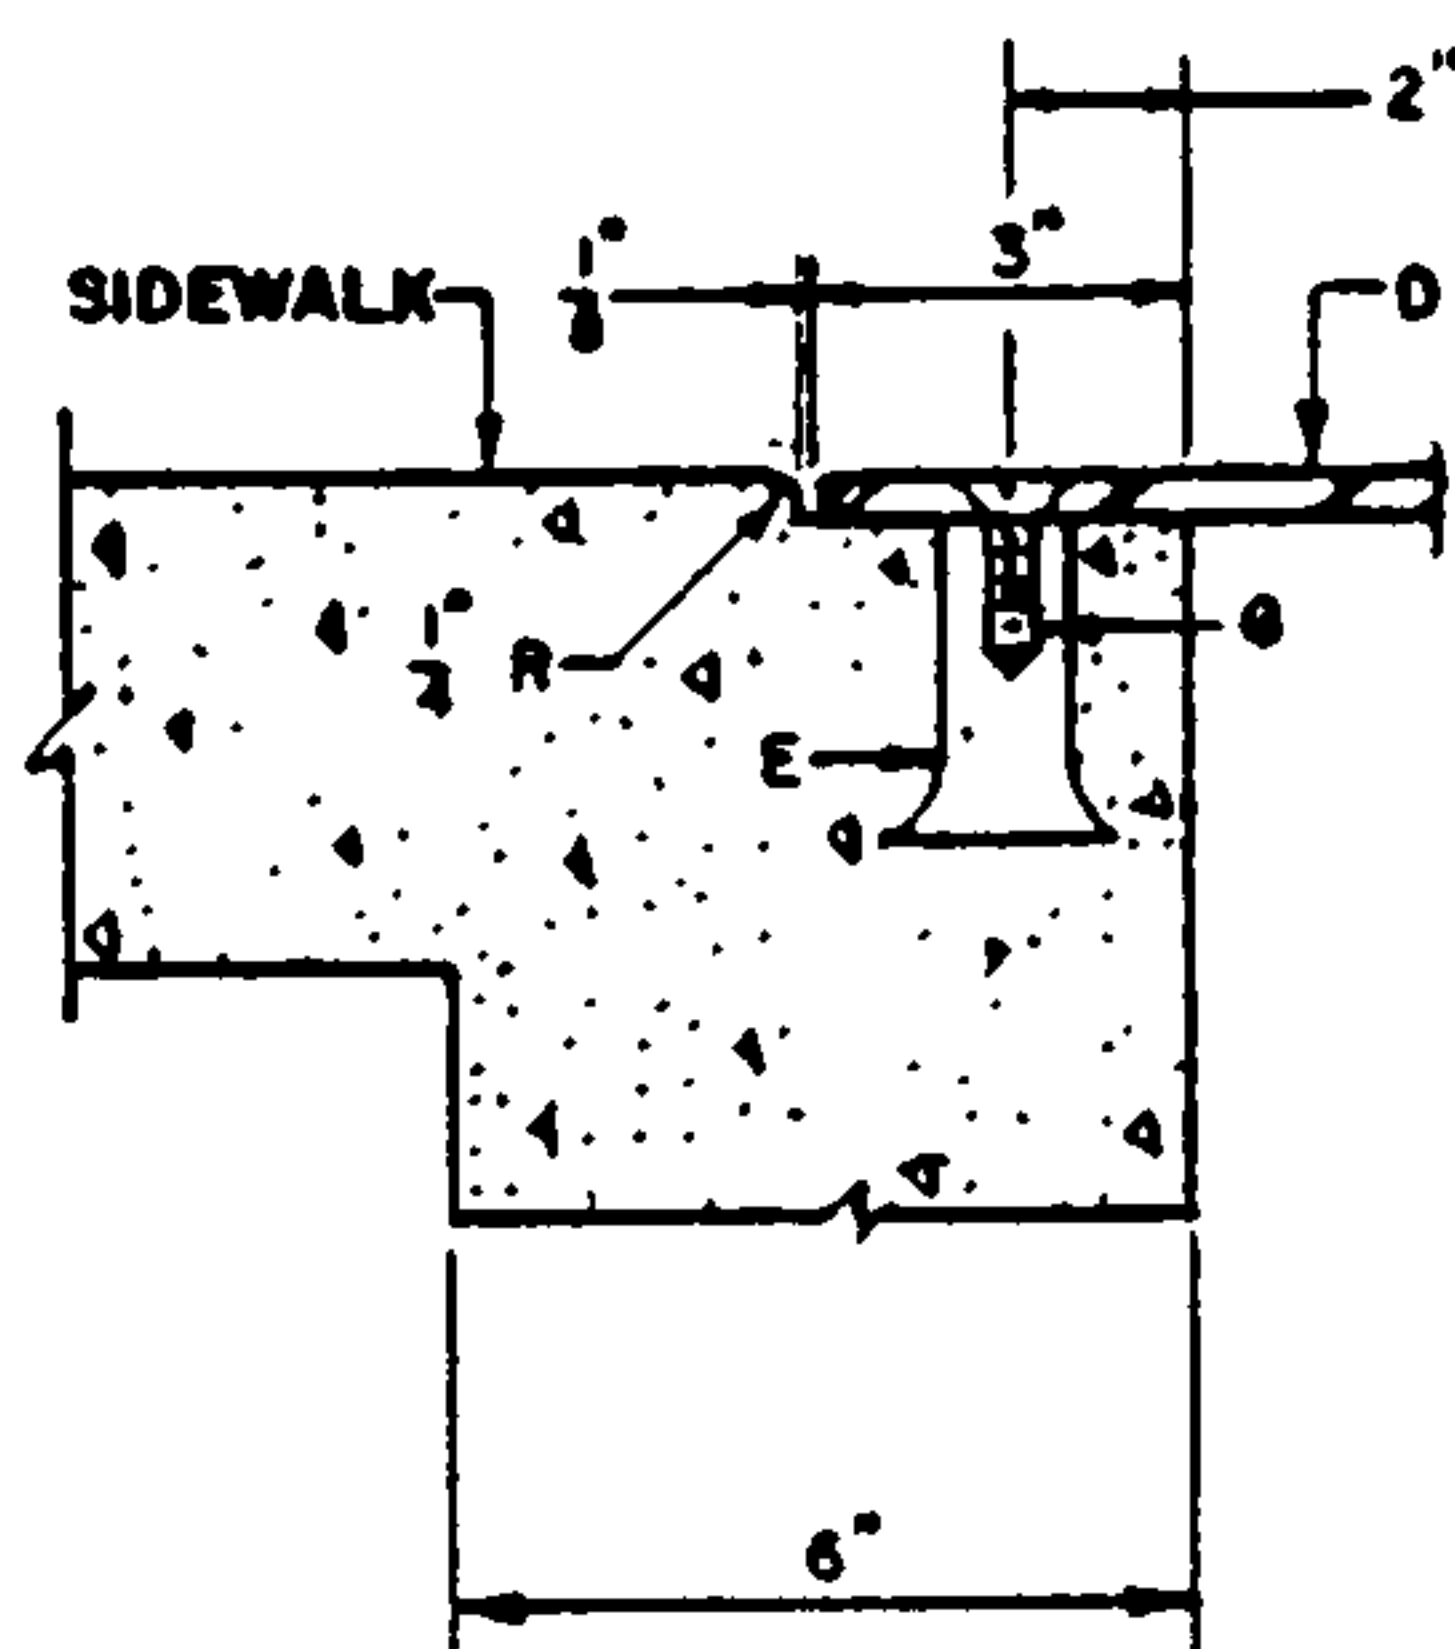

SECTION B-B

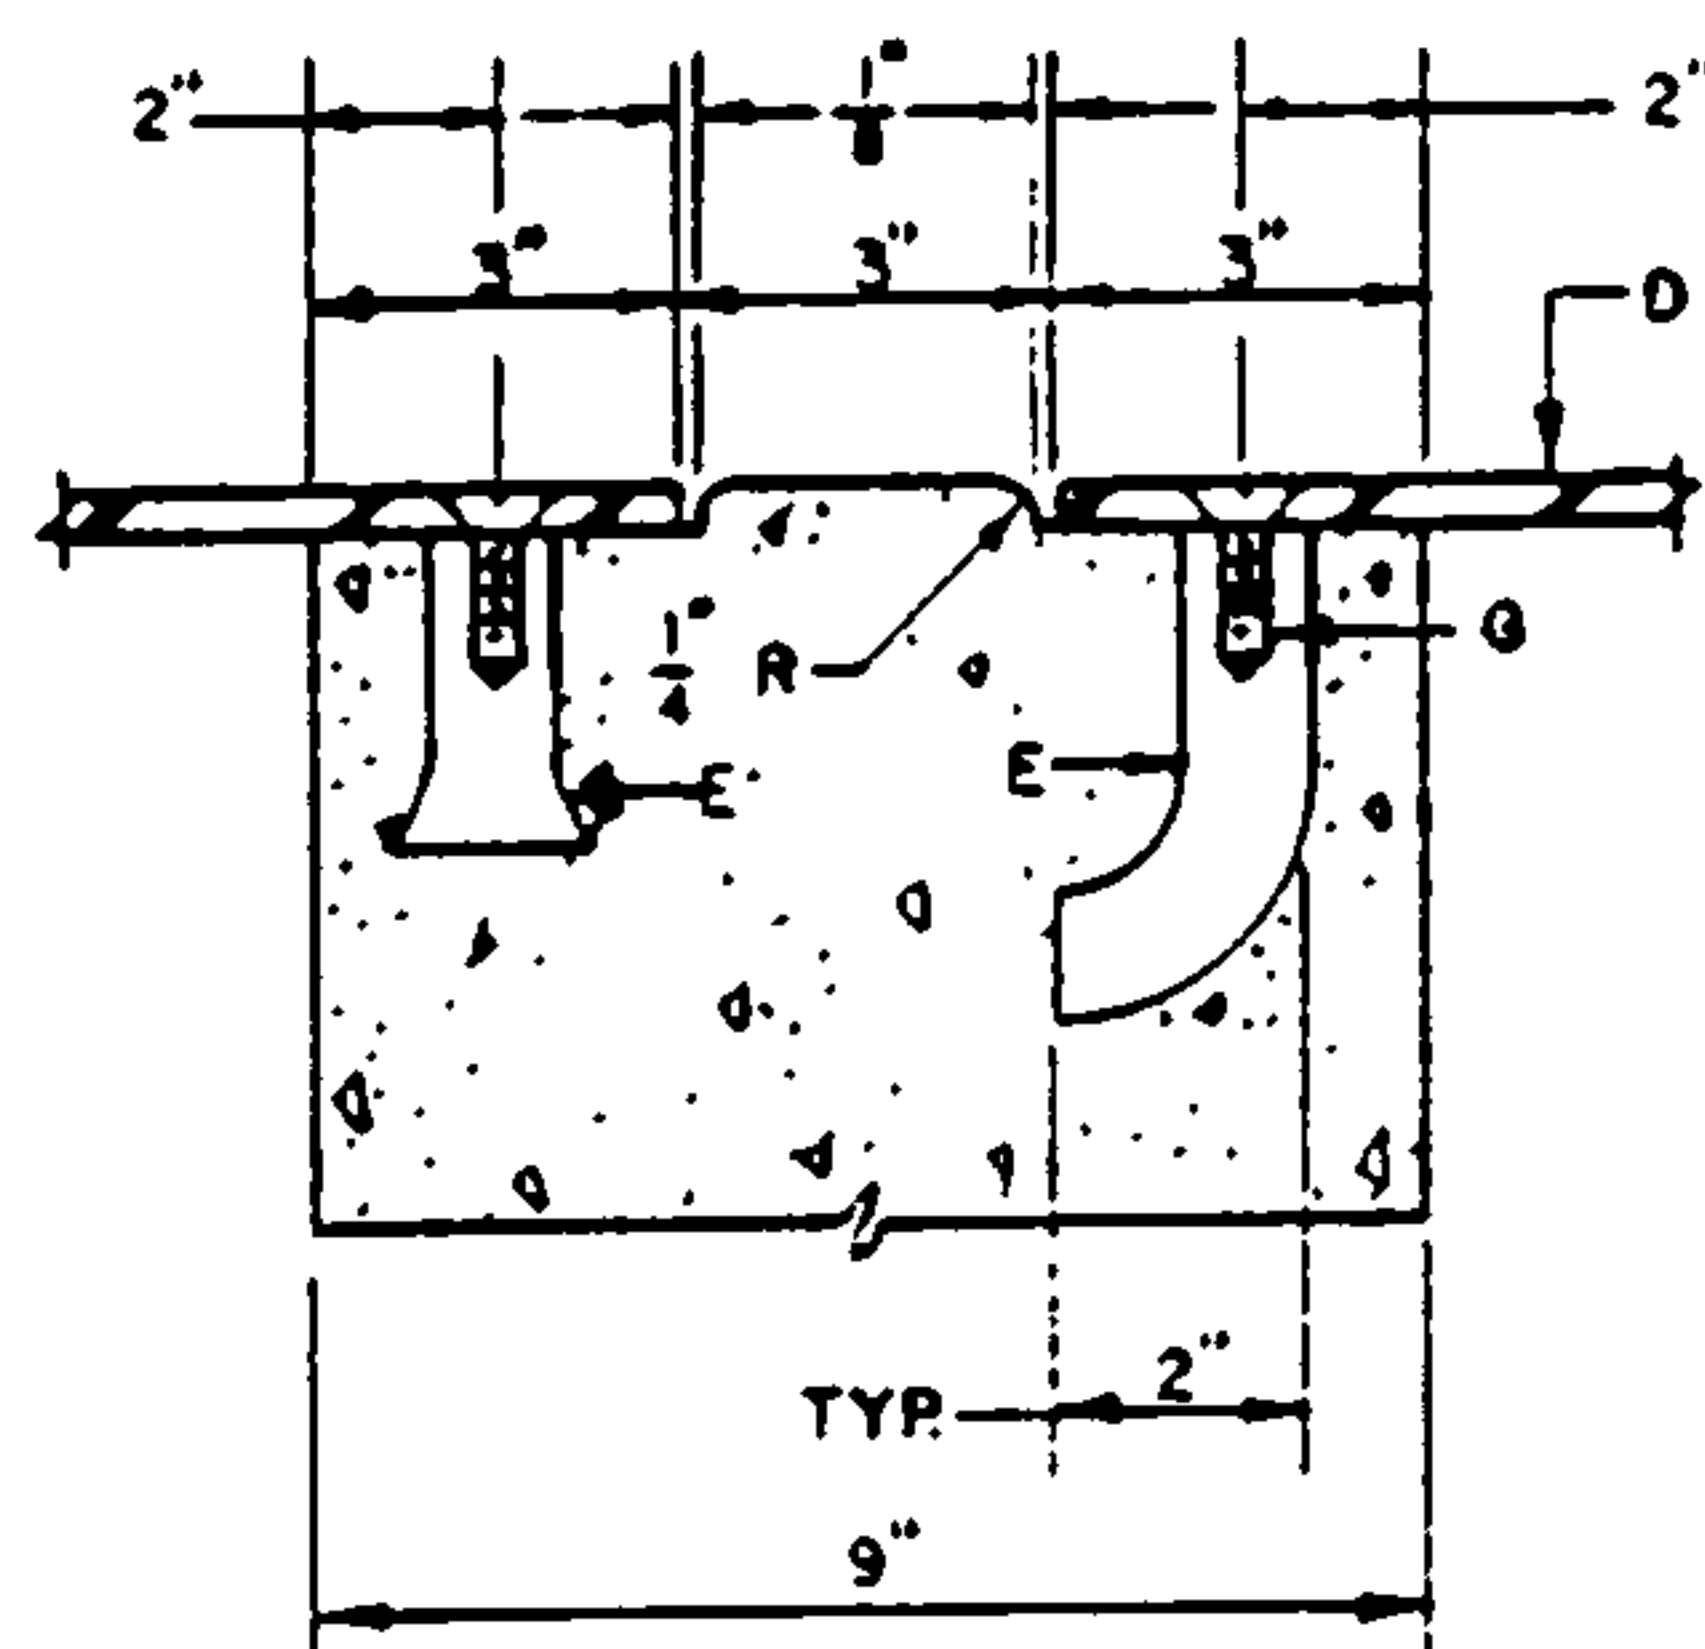

SECTION C-C

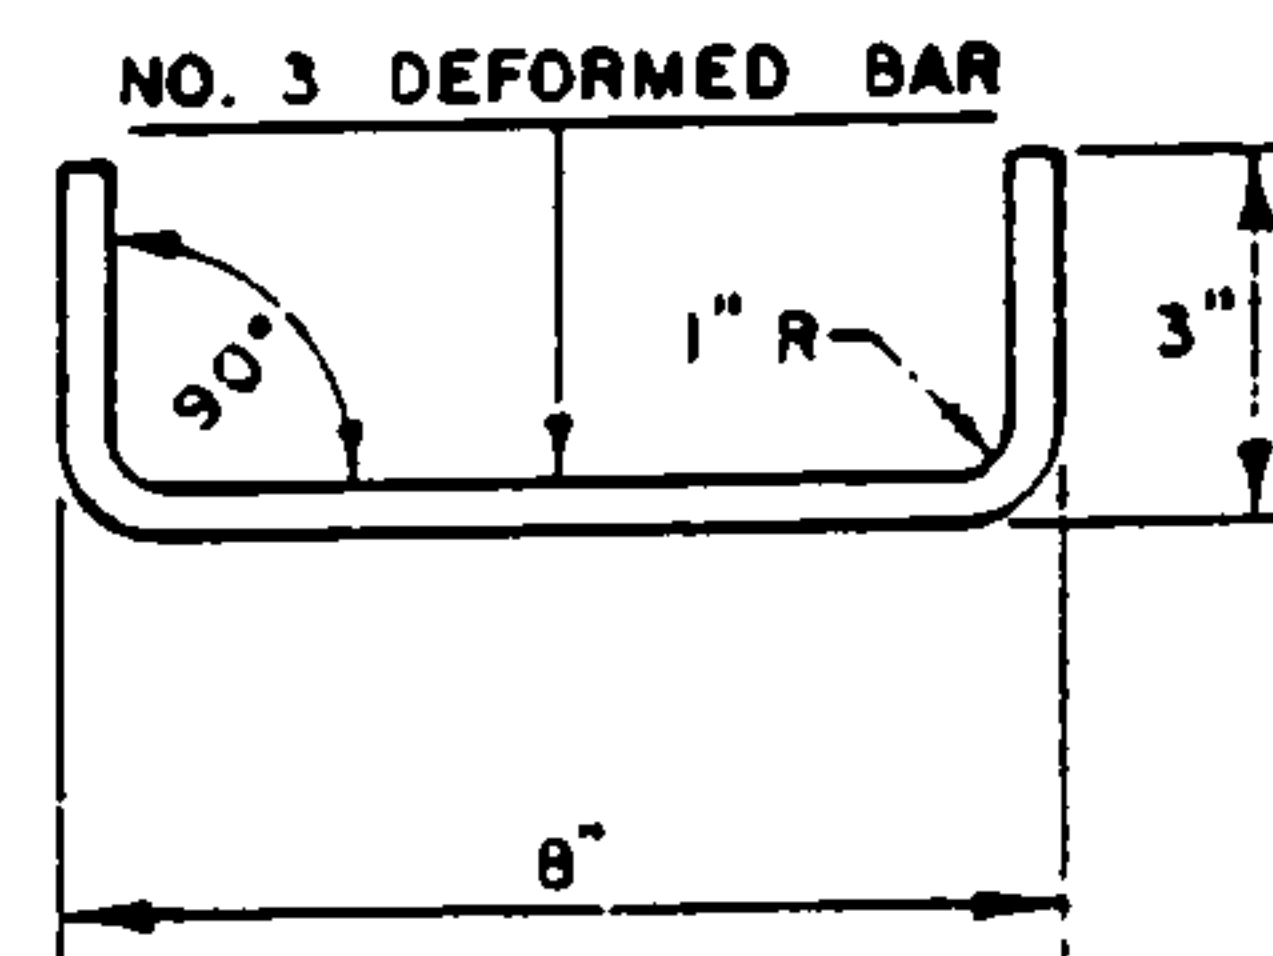

DOWEL DETAIL

## GENERAL NOTES:

1. PLACING OF DRAIN THRU EXIST. SIDEWALK AND CURB & GUTTER REQUIRES THAT ENTIRE SIDEWALK AND C & G STONES BE REMOVED AND REPLACED AS DETAILED HEREIN.
2. BOTTOM SLAB OF CULVERT SHALL BE POURED MONOLITHICALLY WITH NEW GUTTER.
3. THE INVERT SHALL BE TROWELED TO PRODUCE A HARD POLISHED SURFACE OF MAX DENSITY AND SMOOTHNESS. INVERT SHALL BE V-SHAPED TO WITHIN 3° OF OUTLET, THEN WARPED TO PARALLEL FLOWLINE AT OUTLET, UNLESS OTHERWISE SHOWN.
4. ALL EXPOSED CONC. SURFACE SHALL MATCH GRADE, COLOR, FINISH AND SCORING OF ADJACENT CURB AND SIDEWALK.
5. SIDEWALK REPLACED DURING CONSTRUCTION SHALL BE POURED MONOLITHICALLY WITH CULVERT WALLS.
6. IF ROD ANCHORS ARE USED, DRILL & TAP FOR F.H. MACHINE SCREW. ATTACH ANCHORS TO PLATE AND SECURE PLATE IN PLACE PRIOR TO POURING OF WALLS.
7. LENGTH OF EACH PLATE SHALL BE SUCH THAT THE WEIGHT WILL NOT EXCEED 300 LBS. AND SHALL BE STRESS RELIEVED AFTER FABRICATION. CLEAN SURFACE OF PLATE AND FRAMING MEMBERS AND PAINT W/ ONE SHOP COAT RED OXIDE AND TWO FINISH COATS ALUMINUM PAINT (AASHTO M 69).
8. THE CITY WILL NOT ASSUME RESPONSIBILITY FOR MAINTENANCE OF ANY SIDEWALK CULVERT INSTALLED BY OR FOR PRIVATE PROPERTY OWNERS.

## CONSTRUCTION NOTES:

- A. MATCH NEAREST CONTROL JOINT, INSTALL 1/2" EXPANSION JOINT.
- B. EDGE OF SIDEWALK OR SETBACK (VARIABLE).
- C. 3" RADIUS (TYPICAL).
- D. 3/8" CHECKERED STEEL PLATE (PAINT PER NOTE 1 ABOVE).
- E. FOR SECURING PLATE USE 1" X 5" S.S. ROD ANCHOR, "RED HEAD MULTI-SET II SRM-38 ANCHOR" OR APPROVED EQUAL. INSTALL PER MANUFACTURER'S INSTRUCTIONS AT MAX. 24" O.C., A MINIMUM OF 2 PER SIDE AND ONE WITHIN 6" OF EACH END.
- F. CONSTRUCTION JOINT IS OPTIONAL. IF USED, SPACE DOWELS AT 18" O.C. MAX., 1 1/2" MINIMUM FROM FACE OF CONCRETE.
- G. 3/8" - 16 X 1 1/4" COUNTERSUNK, F.H., STAINLESS STEEL, MACHINE SCREW.
- H. SLOPE 1/4" PER FT MIN.
- I. DRAIN WIDTH PER PLAN (12" MIN., 24" MAX).

CITY OF ALBUQUERQUE

DRAINAGE  
SIDEWALK CULVERT  
WITH STEEL PLATE TOP  
DWG. 2236

AUG 1986

REVISIONS

# Pedestrian – Handicap/Bicycle Trench Grating

## Pedestrian trench grating



Barrycraft's "pedestrian" trench grating (type HH design: see page 3) is a new improved trench grate design for pedestrian traffic. The  $\frac{1}{4}$ " to  $\frac{5}{16}$ " wide slot helps to provide safer grating to walk on in areas where drainage is required.

When specifying or ordering Barrycraft's "pedestrian" grating, please remember to indicate the type of material required. Barrycraft offers you three choices:

Gray cast iron  
Ductile cast iron  
Cast aluminum


The type L1 frame is standard and will be provided with the pedestrian grating.

Applications for Barrycraft's "pedestrian" grating include: sidewalks, terraces, shopping malls, around swimming pools and other areas where appearance and public safety are important.

TABLE: Dimensions in inches .

Trench Grating Style	Grate Width "A"	Edge Thickness "B"	Trench Width "C"
B-PED-A1	6	$\frac{3}{4}$	4
B-PED-A2	8	$\frac{3}{4}$	6
B-PED-A3	10	$\frac{3}{4}$	8
B-PED-A4	12	$\frac{3}{4}$	10
B-PED-A5	14	$\frac{3}{4}$	12

## Handicap/Bicycle trench grating

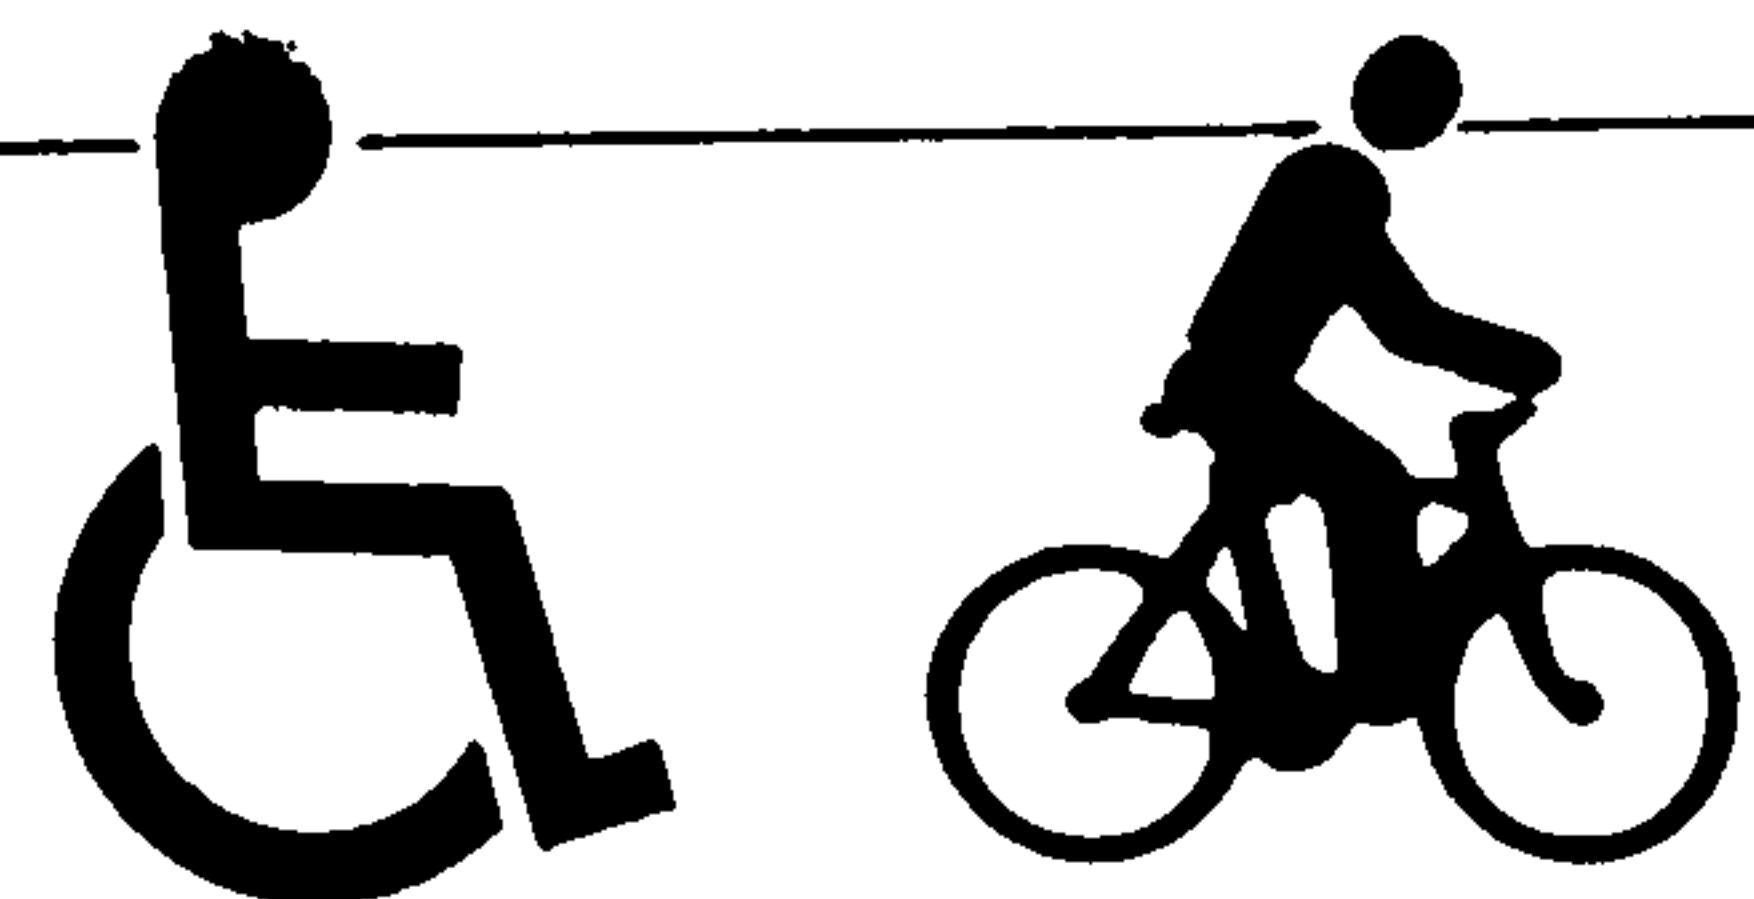

Barrycraft's "handicapped/bicycle" trench grating (type AAA design: see page 3) is designed to help ease handicapped and bicycle traffic safely over trench grating installations.

Barrycraft's "handicapped/bicycle" trench grating's standard diagonal slots 1" wide with a maximum slot length of 9". Grates and frames may be ordered or specified in:

Gray cast iron  
Ductile cast iron  
Cast aluminum

The type L1 frame (see page 3) is standard and will be provided with the handicapped/bicycle grating.

Barrycraft's "handicapped/bicycle" trench grating is particularly suitable in any public area where handicapped and others on small tire traffic have access. Such areas include hospitals, colleges, public sidewalks and shopping malls.

TABLE: Dimensions in inches

Trench Grating Style	Grate Width "A"	Edge Thickness "B"	Trench Width "C"
B-HCB-A1	6	$\frac{3}{4}$	4
B-HCB-A2	8	$\frac{3}{4}$	6
B-HCB-A3	10	$\frac{3}{4}$	8
B-HCB-A4	12	$\frac{3}{4}$	10
B-HCB-A5	14	$\frac{3}{4}$	12

**Call Us Toll Free:**  
**See Page 20.**  
**Facsimile Machine**  
**Available.**