

# CITY OF ALBUQUERQUE



August 15, 2017

Mike Balaskovits, PE  
Bohannon-Huston  
7500 Jefferson St NE Courtyard I  
Albuquerque, NM 87109

**Re: Innovate Albuquerque  
101 Broadway Blvd. NE  
Request Permanent C.O. - Accepted  
Engineer's Stamp dated: 5-20-16 (K14D108)  
Certification dated: 8-14-17**

Dear Mr. Balaskovits,

Based on the Certification received 8/14/2017, Hydrology has no objection to the issuance of a Certificate of Occupancy for building #2017 27878. This letter serves as a "green tag" from Hydrology for a Certificate of Occupancy to be issued by the Building and Safety Division.

If you have any questions, you can contact me at 924-3986 or Totten Elliott at 924-3982.

Sincerely,

James D. Hughes, P.E.  
Principal Engineer, Planning Dept.  
Development and Review Services

TE/JDH

C: email      Serna, Yvette; Fox, Debi; Tena, Victoria; Sandoval, Darlene M.



# City of Albuquerque

Planning Department

Development & Building Services Division

## DRAINAGE AND TRANSPORTATION INFORMATION SHEET (REV 09/2015)

**Project Title:** INNOVATE ABQ **Building Permit #:** \_\_\_\_\_ **City Drainage #:** K14/D108  
**DRB#:** \_\_\_\_\_ **EPC#:** \_\_\_\_\_ **Work Order#:** \_\_\_\_\_  
**Legal Description:** Tract "A" Lands of the First Baptist Church  
**City Address:** 101 Broadway Blvd. NE

**Engineering Firm:** Bohannon Huston, Inc **Contact:** Mike Balaskovits or Matt Satches  
**Address:** 7500 Jefferson St. NE 87109  
**Phone#:** 505-823-1000 **Fax#:** 505-798-7988 **E-mail:** mbalaskovits@bhinc.com

**Owner:** \_\_\_\_\_ **Contact:** \_\_\_\_\_  
**Address:** \_\_\_\_\_  
**Phone#:** \_\_\_\_\_ **Fax#:** \_\_\_\_\_ **E-mail:** \_\_\_\_\_

**Architect:** Dekker / Perich / Sabatini **Contact:** Miriam Hicks  
**Address:** 7601 Jefferson St NE, Suite 100 87109  
**Phone#:** 505-761-9700 **Fax#:** 505-761-4222 **E-mail:** miriamh@dpsdesign.org

**Other Contact:** \_\_\_\_\_ **Contact:** \_\_\_\_\_  
**Address:** \_\_\_\_\_  
**Phone#:** \_\_\_\_\_ **Fax#:** \_\_\_\_\_ **E-mail:** \_\_\_\_\_

Check all that Apply:

### DEPARTMENT:

☒ HYDROLOGY/ DRAINAGE  
☐ TRAFFIC/ TRANSPORTATION  
☐ MS4/ EROSION & SEDIMENT CONTROL

### TYPE OF SUBMITTAL:

☐ ENGINEER/ ARCHITECT CERTIFICATION  
  
☐ CONCEPTUAL G & D PLAN  
☐ GRADING PLAN  
☐ DRAINAGE MASTER PLAN  
☐ DRAINAGE REPORT  
☐ CLOMR/LOMR  
  
☐ TRAFFIC CIRCULATION LAYOUT (TCL)  
☐ TRAFFIC IMPACT STUDY (TIS)  
☐ EROSION & SEDIMENT CONTROL PLAN (ESC)  
  
☐ OTHER (SPECIFY) \_\_\_\_\_

### CHECK TYPE OF APPROVAL/ACCEPTANCE SOUGHT:

☐ BUILDING PERMIT APPROVAL  
☒ CERTIFICATE OF OCCUPANCY  
  
☐ PRELIMINARY PLAT APPROVAL  
☐ SITE PLAN FOR SUB'D APPROVAL  
☐ SITE PLAN FOR BLDG. PERMIT APPROVAL  
☐ FINAL PLAT APPROVAL  
☐ SIA/ RELEASE OF FINANCIAL GUARANTEE  
☐ FOUNDATION PERMIT APPROVAL  
☐ GRADING PERMIT APPROVAL  
☐ SO-19 APPROVAL  
☐ PAVING PERMIT APPROVAL  
☒ GRADING/ PAD CERTIFICATION  
☐ WORK ORDER APPROVAL  
☐ CLOMR/LOMR  
  
☐ PRE-DESIGN MEETING  
☐ OTHER (SPECIFY) \_\_\_\_\_

IS THIS A RESUBMITTAL?: ☐ Yes ☒ No

**DATE SUBMITTED:** 8-14-2017 **By:** Michael Balaskovits, PE

COA STAFF: \_\_\_\_\_ ELECTRONIC SUBMITTAL RECEIVED: \_\_\_\_\_




# DRAINAGE CERTIFICATION

I, MICHAEL BALASKOVITS, NMPE 18187, OF THE FIRM BOHANNAN HUSTON INC., HEREBY CERTIFY THAT THIS PROJECT HAS BEEN GRADED AND WILL DRAIN IN SUBSTANTIAL COMPLIANCE WITH AND IN ACCORDANCE WITH THE DESIGN INTENT OF THE APPROVED PLAN DATED 8/8/2016. THE RECORD INFORMATION EDITED ONTO THE ORIGINAL DESIGN DOCUMENT HAS BEEN OBTAINED BY BRIAN MARTINEZ, NMPS 18374, OF THE FIRM CARTESIAN SURVEYS INC. I FURTHER CERTIFY THAT I HAVE PERSONALLY VISITED THE PROJECT SITE ON 8/14/2017 AND HAVE DETERMINED BY VISUAL INSPECTION THAT THE SURVEY DATA PROVIDED IS REPRESENTATIVE OF ACTUAL SITE CONDITIONS AND IS TRUE AND CORRECT TO THE BEST OF MY KNOWLEDGE AND BELIEF. THIS CERTIFICATION IS SUBMITTED IN SUPPORT OF A REQUEST FOR A TEMPORARY CERTIFICATE OF OCCUPANCY. UPON FURTHER ASBUILT INFORMATION A REQUEST FOR PERMANENT CERTIFICATE OF OCCUPANCY WILL BE REQUESTED.

THE RECORD INFORMATION PRESENTED HEREON IS NOT NECESSARILY COMPLETE AND INTENDED ONLY TO VERIFY SUBSTANTIAL COMPLIANCE OF THE GRADING AND DRAINAGE ASPECTS OF THIS PROJECT. THOSE RELYING ON THIS RECORD DOCUMENT ARE ADVISED TO OBTAIN INDEPENDENT VERIFICATION OF ITS ACCURACY BEFORE USING IT FOR ANY OTHER PURPOSES.

MICHAEL BALASKOVITS, NMPE 18187  
8/14/2017

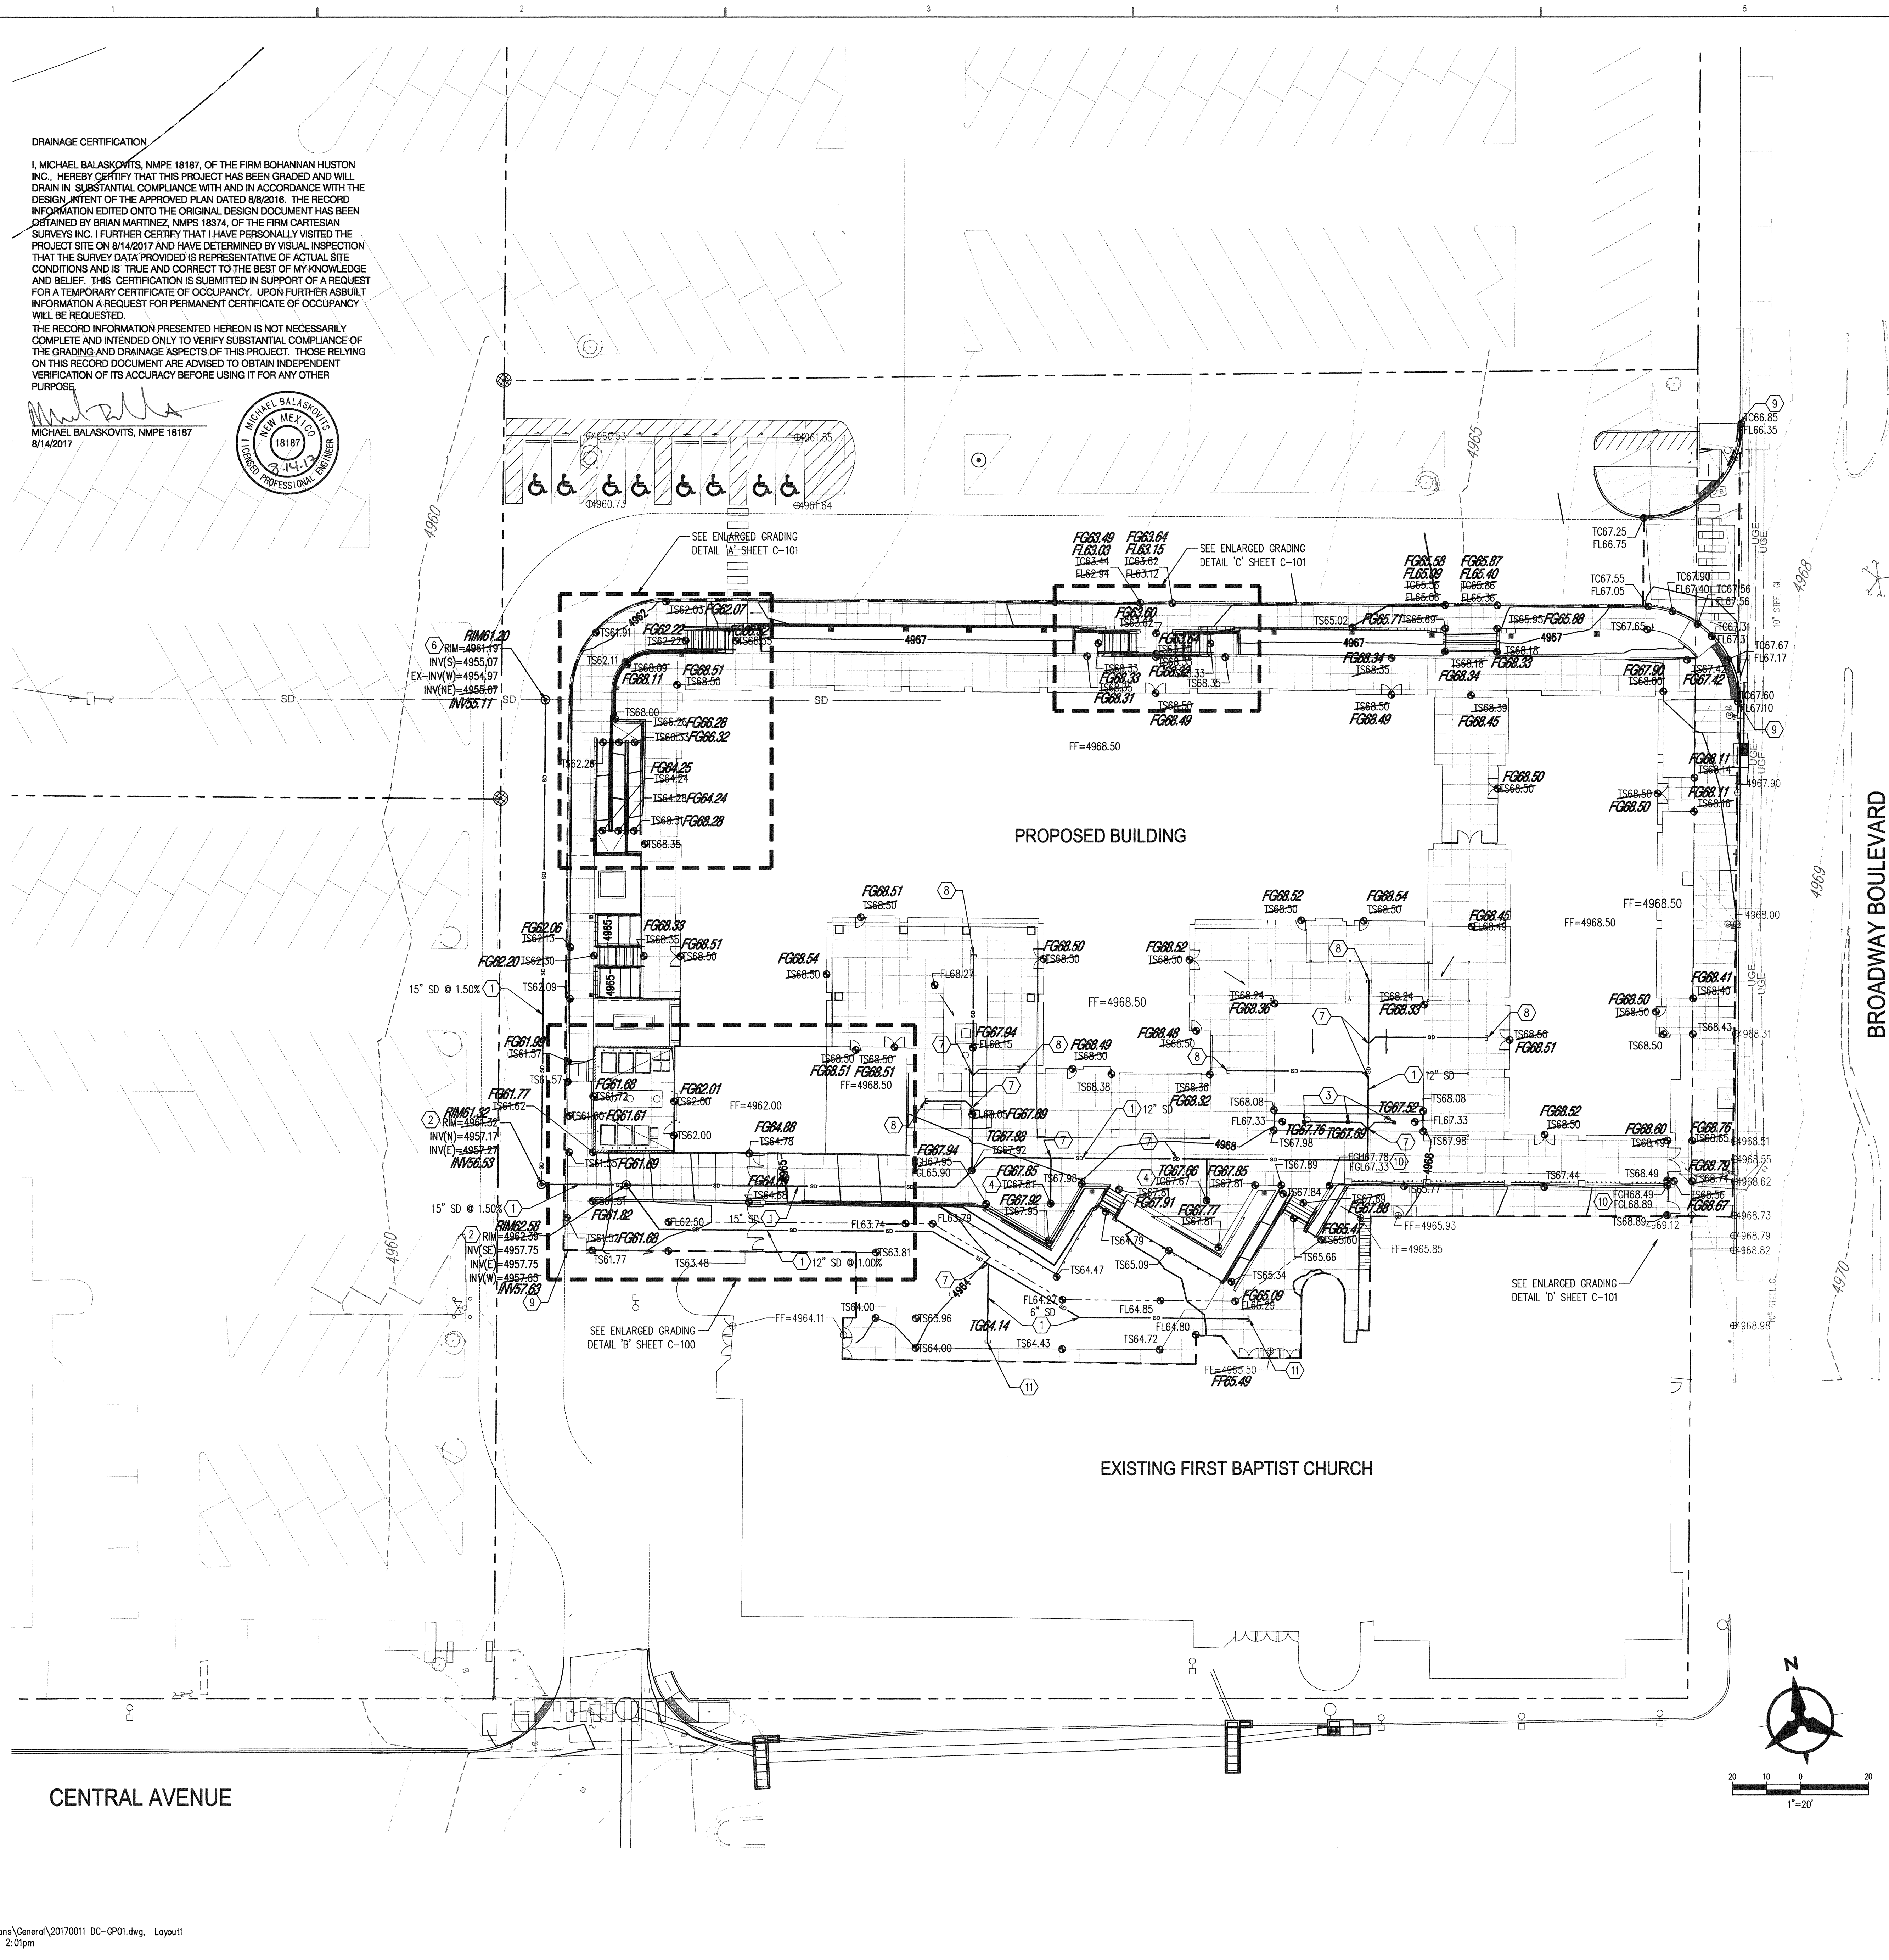

## GRADING KEYNOTES

1. HDPE (N12 WT. OR APPROVED EQUAL) STORM DRAIN PIPE.
2. STORM DRAIN MANHOLE PER COA STD DWG 2102.
3. NEW 12" NYLOPLAST DOME GRATE INLET. FG-67.75
4. NEW 24" NYLOPLAST INLET OR APPROVED EQUAL. CONTRACTOR TO PROVIDE PEDESTRIAN RATED GRATE
5. NOT USED
6. CONSTRUCT NEW MANHOLE PER COA STANDARD DRAWING 2102. TO CONNECT EXISTING SD TO NEW 15" LINE
7. STORM DRAIN FITTING PER MANUFACTURERS RECOMMENDATIONS.
8. ROOF DRAIN. STUB TO WITHIN 5' OF BUILDING. SEE STRUCTURAL AND PLUMBING PLANS FOR INVERT AND SIZE.
9. MATCH EXISTINGS.
10. RETAINING WALL. SEE STRUCTURAL SHEETS FOR ADDITIONAL DETAILS
11. CONNECT TO EXISTING ROOF DRAIN. CONTRACTOR TO FIELD VERIFY INVERT AND NOTIFY ENGINEER OF ANY DISCREPANCIES

## GENERAL NOTES

- A. ALL WORK DETAILED ON THESE PLANS AND PERFORMED UNDER THIS CONTRACT SHALL BE CONSTRUCTED IN ACCORDANCE WITH THE PROJECT SPECIFICATIONS AND THE PROJECT GEOTECHNICAL REPORT, WHERE APPLICABLE, CITY OF ALBUQUERQUE PUBLIC WORKS STANDARDS SHALL APPLY.
- B. THE CONTRACTOR SHALL ABIDE BY ALL LOCAL, STATE, AND FEDERAL LAWS, RULES AND REGULATIONS WHICH APPLY TO THE CONSTRUCTION OF THESE IMPROVEMENTS, INCLUDING EPA REQUIREMENTS WITH RESPECT TO STORM WATER DISCHARGE.
- C. PRIOR TO CONSTRUCTION, THE CONTRACTOR SHALL FIELD VERIFY THE HORIZONTAL AND VERTICAL LOCATIONS OF ALL POTENTIAL OBSTRUCTIONS INCLUDING ALL UNDERGROUND UTILITIES. SHOULD A CONFLICT EXIST, THE CONTRACTOR SHALL NOTIFY THE CONSTRUCTION OBSERVER OR ENGINEER SO THAT THE CONFLICT CAN BE RESOLVED WITH A MINIMUM AMOUNT OF DELAY.
- D. TWO (2) WORKING DAYS PRIOR TO ANY EXCAVATION, THE CONTRACTOR SHALL CONTACT LINE LOCATING SERVICE FOR LOCATION OF EXISTING UTILITIES.
- E. ALL ELECTRICAL, TELEPHONE, CABLE TV, GAS AND OTHER UTILITY LINES, CABLES, AND APPURTENANCES ENCOUNTERED DURING CONSTRUCTION THAT REQUIRE RELOCATION, SHALL BE COORDINATED WITH THAT UTILITY. THE CONTRACTOR SHALL BE RESPONSIBLE FOR COORDINATION OF ALL NECESSARY UTILITY ADJUSTMENTS. NO ADDITIONAL COMPENSATION WILL BE ALLOWED FOR DELAYS OR INCONVENIENCES CAUSED BY UTILITY COMPANY WORK CREWS. THE CONTRACTOR MAY BE REQUIRED TO RESCHEDULE HIS ACTIVITIES TO ALLOW UTILITY CREWS TO PERFORM THEIR REQUIRED WORK.
- F. THE CONTRACTOR IS RESPONSIBLE FOR PROTECTING ALL EXISTING UTILITY LINES WITHIN THE CONSTRUCTION AREA. ANY DAMAGE TO EXISTING FACILITIES CAUSED BY CONSTRUCTION ACTIVITY SHALL BE REPAIRED OR REPLACED AT THE CONTRACTOR'S EXPENSE AND APPROVED BY THE CONSTRUCTION OBSERVER.
- G. CONSTRUCTION ACTIVITY SHALL BE LIMITED TO THE PROPERTY AND/OR PROJECT LIMITS. ANY DAMAGE TO ADJACENT PROPERTIES RESULTING FROM THE CONSTRUCTION PROCESS SHALL BE REPAIRED OR REPLACED AT THE CONTRACTOR'S EXPENSE.
- H. OVERNIGHT PARKING OF CONSTRUCTION EQUIPMENT SHALL NOT OBSTRUCT DRIVEWAYS OR DESIGNATED TRAFFIC LANES. THE CONTRACTOR SHALL NOT STORE ANY EQUIPMENT OR MATERIAL WITHIN THE PUBLIC RIGHT-OF-WAY.
- I. THE CONTRACTOR SHALL OBTAIN ALL THE NECESSARY PERMITS FOR THE PROJECT PRIOR TO COMMENCING CONSTRUCTION (I.E., BARRICADING, TOPSOIL DISTURBANCE, EXCAVATION PERMITS, EPA STORM WATER PERMITS, ETC.).
- J. ALL PROPERTY CORNERS DESTROYED DURING CONSTRUCTION SHALL BE REPLACED AT THE CONTRACTOR'S EXPENSE. ALL PROPERTY CORNERS MUST BE RESET BY A REGISTERED LAND SURVEYOR.
- K. THE CONTRACTOR SHALL PREPARE A CONSTRUCTION TRAFFIC CONTROL AND SIGNING PLAN AND OBTAIN APPROVAL OF SUCH PLAN FROM THE CITY OF ALBUQUERQUE, TRAFFIC ENGINEERING DEPARTMENT, PRIOR TO BEGINNING ANY CONSTRUCTION WORK ON OR ADJACENT TO EXISTING STREETS.
- L. ALL BARRICADES AND CONSTRUCTION SIGNING SHALL CONFORM TO APPLICABLE SECTIONS OF THE "MANUAL ON UNIFORM TRAFFIC CONTROL DEVICES" (MUTCD), US DEPARTMENT OF TRANSPORTATION, LATEST EDITION.
- M. THE CONTRACTOR SHALL MAINTAIN ALL CONSTRUCTION BARRICADES AND SIGNING AT ALL TIMES. THE CONTRACTOR SHALL VERIFY THE PROPER LOCATION OF ALL BARRICADE AT THE END AND BEGINNING OF EACH DAY.
- N. THE CONTRACTOR SHALL TAKE ALL STEPS NECESSARY TO CONFORM WITH EPA REQUIREMENTS, INCLUDING COMPLIANCE WITH NPDES PHASE 2 REQUIREMENTS.
- O. EXCEPT AS PROVIDED HEREIN, GRADING SHALL BE PERFORMED AT THE ELEVATIONS AND IN ACCORDANCE WITH THE DETAILS SHOWN ON THIS PLAN.
- P. THE COST FOR REQUIRED CONSTRUCTION DUST AND EROSION CONTROL MEASURES SHALL BE INCIDENTAL TO THE PROJECT COST.
- Q. ALL WORK RELATIVE TO FOUNDATION CONSTRUCTION, SITE PREPARATION, AND PAVEMENT INSTALLATION, AS SHOWN ON THIS PLAN, SHALL BE CONSTRUCTED IN ACCORDANCE WITH THE "GEOTECHNICAL INVESTIGATION". ALL OTHER WORK SHALL, UNLESS OTHERWISE STATED OR PROVIDED FOR HEREON, BE CONSTRUCTED IN ACCORDANCE WITH THE PROJECT, (FIRST PRIORITY) SPECIFICATIONS, AND/OR THE CITY OF ALBUQUERQUE (COA) STANDARD SPECIFICATIONS FOR PUBLIC WORKS (SECOND PRIORITY).
- R. EARTH SLOPES SHALL NOT EXCEED 3 HORIZONTAL TO 1 VERTICAL UNLESS SHOWN OTHERWISE.
- S. IT IS THE INTENT OF THESE PLANS THAT THIS CONTRACTOR SHALL NOT PERFORM ANY WORK OUTSIDE OF THE PROPERTY BOUNDARIES EXCEPT AS REQUIRED BY THIS PLAN.
- T. THE CONTRACTOR IS TO ENSURE THAT NO SOIL ERODES FROM THE SITE ONTO ADJACENT PROPERTY OR PUBLIC RIGHT-OF-WAY.
- U. A DISPOSAL SITE FOR ANY & ALL EXCESS EXCAVATION MATERIAL, AND UNSUITABLE MATERIAL AND/OR A BORROW SITE CONTAINING ACCEPTABLE FILL MATERIAL SHALL BE OBTAINED BY THE CONTRACTOR IN COMPLIANCE WITH APPLICABLE ENVIRONMENTAL REGULATIONS AND APPROVED BY THE OBSERVER. ALL COSTS INCURRED IN OBTAINING A DISPOSAL OR BORROW SITE AND HAIL TO OR FROM SHALL BE CONSIDERED INCIDENTAL TO THE PROJECT AND NO SEPARATE MEASUREMENT OR PAYMENT SHALL BE MADE.
- V. PAVING AND ROADWAY GRADES SHALL BE +/- 0.1' FROM PLAN ELEVATIONS. PAD ELEVATION SHALL BE +/- 0.05' FROM BUILDING PLAN ELEVATION.
- W. ALL PROPOSED CONTOURS REFLECT TOP OF PAVEMENT ELEVATIONS IN THE PARKING AREA AND MUST BE ADJUSTED FOR MEDANS AND ISLANDS.
- X. VERIFY ALL ELEVATIONS SHOWN ON PLAN FROM BASIS OF ELEVATION CONTROL STATION PRIOR TO BEGINNING CONSTRUCTION.

## GRADING LEGEND

--- PROPERTY LINE	--- PROPOSED CURB & GUTTER
--- PROJECT LIMITS OF GRADING	--- DIRECTION OF FLOW
--- EXISTING INDEX CONTOUR	--- WATER BLOCK/GRADE BREAK
--- EXISTING INTERMEDIATE CONTOUR	--- PROPOSED STORM DRAIN LINE
--- EXISTING GROUND SPOT ELEVATION	--- PROPOSED STORM DRAIN MANHOLE
--- PROPOSED INDEX CONTOUR	--- PROPOSED STORM DRAIN INLETS
--- PROPOSED INTERMEDIATE CONTOUR	--- PROPOSED RETAINING WALL
--- PROPOSED FLOW LINE	--- EASEMENT
--- PROPOSED FINISHED GRADE SPOT ELEVATION	--- PROPOSED WATER HARVESTING AREAS (FIRST FLUSH REQUIREMENT)
TS=TOP OF CURB, FL=FLOW LINE, TS=TOP OF SIDEWALK, FG=TOP OF GRATE, FGH=FINISH GROUND HIGH, FGL=FINISH GROUND LOW	

**DEKKER PERICH SABATINI**

7601 JEFFERSON NE, SUITE 100  
ALBUQUERQUE, NM 87109

505.761.9700 / DPSDESIGN.ORG

ARCHITECT

**BUILDING PERMIT SET**

ENGINEER



PROJECT

**LOBO RAINFOREST**  
101 Broadway Blvd. NE  
ALBUQUERQUE, NM 87102

**100% CONSTRUCTION DOCUMENTS**




REVISIONS	
1	11/17/2016 ASB 08

DRAWN BY: MHS  
REVIEWED BY: MJB  
DATE: 11/17/2016  
PROJECT NO.: 16-0044  
DRAWING NAME: GRADING PLAN

SHEET NO.


**C100**  
OF



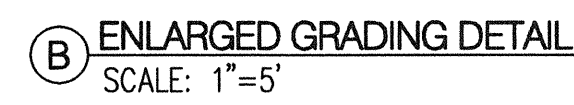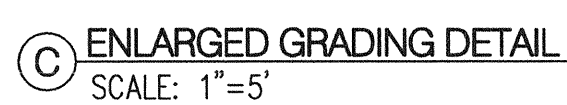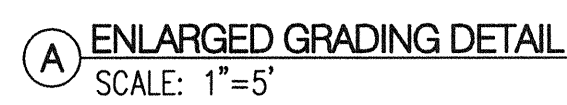




THE RECORD INFORMATION PRESENTED HEREON IS NOT NECESSARILY COMPLETE AND INTENDED ONLY TO VERIFY SUBSTANTIAL COMPLIANCE OF THE GRADING AND DRAINAGE ASPECTS OF THIS PROJECT. THOSE RELYING ON THIS RECORD DOCUMENT ARE ADVISED TO OBTAIN INDEPENDENT VERIFICATION OF ITS ACCURACY BEFORE USING IT FOR ANY OTHER PURPOSE.

  
MICHAEL BALASKOVITS, NMPE 18187  
8/14/2017



REFER TO SHEET C100 FOR AS-BUILT INFORMATION

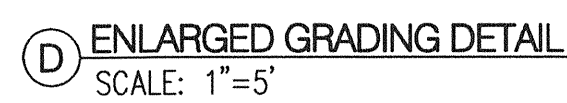

PROPERTY LINE

PROJECT LIMITS OF GRADING

EXISTING INDEX CONTOUR  
5025

EXISTING INTERMEDIATE CONTOUR  
5024

EXISTING GROUND SPOT ELEVATION  
5025.25

PROPOSED INDEX CONTOUR  
5025

PROPOSED INTERMEDIATE CONTOUR  
5024

PROPOSED FLOW LINE

PROPOSED CURB & GUTTER  
S=2.0%

DIRECTION OF FLOW

WATER BLOCK/GRADE BREAK

PROPOSED STORM DRAIN LINE

PROPOSED STORM DRAIN MANHOLE

PROPOSED STORM DRAIN INLETS

PROPOSED RETAINING WALL

EASEMENT

PROPOSED FINISHED GRADE SPOT ELEVATION  
66.75

TO-Top of CURB, F1=Flow LINE, TS=To-Top of SIDEWALK TO-Top of GRATE, FISH-Finish Ground HIGH, FGL-Finish Ground LOW

PROPOSED WATER HARVESTING AREAS (FIRST FLUSH REQUIREMENT)