HYDROLOGY ONE PLAN NO DOCUMENTS K17/D17

1 PLAN FOR WALGREEN'S ON CENTRAL

K-17—D17

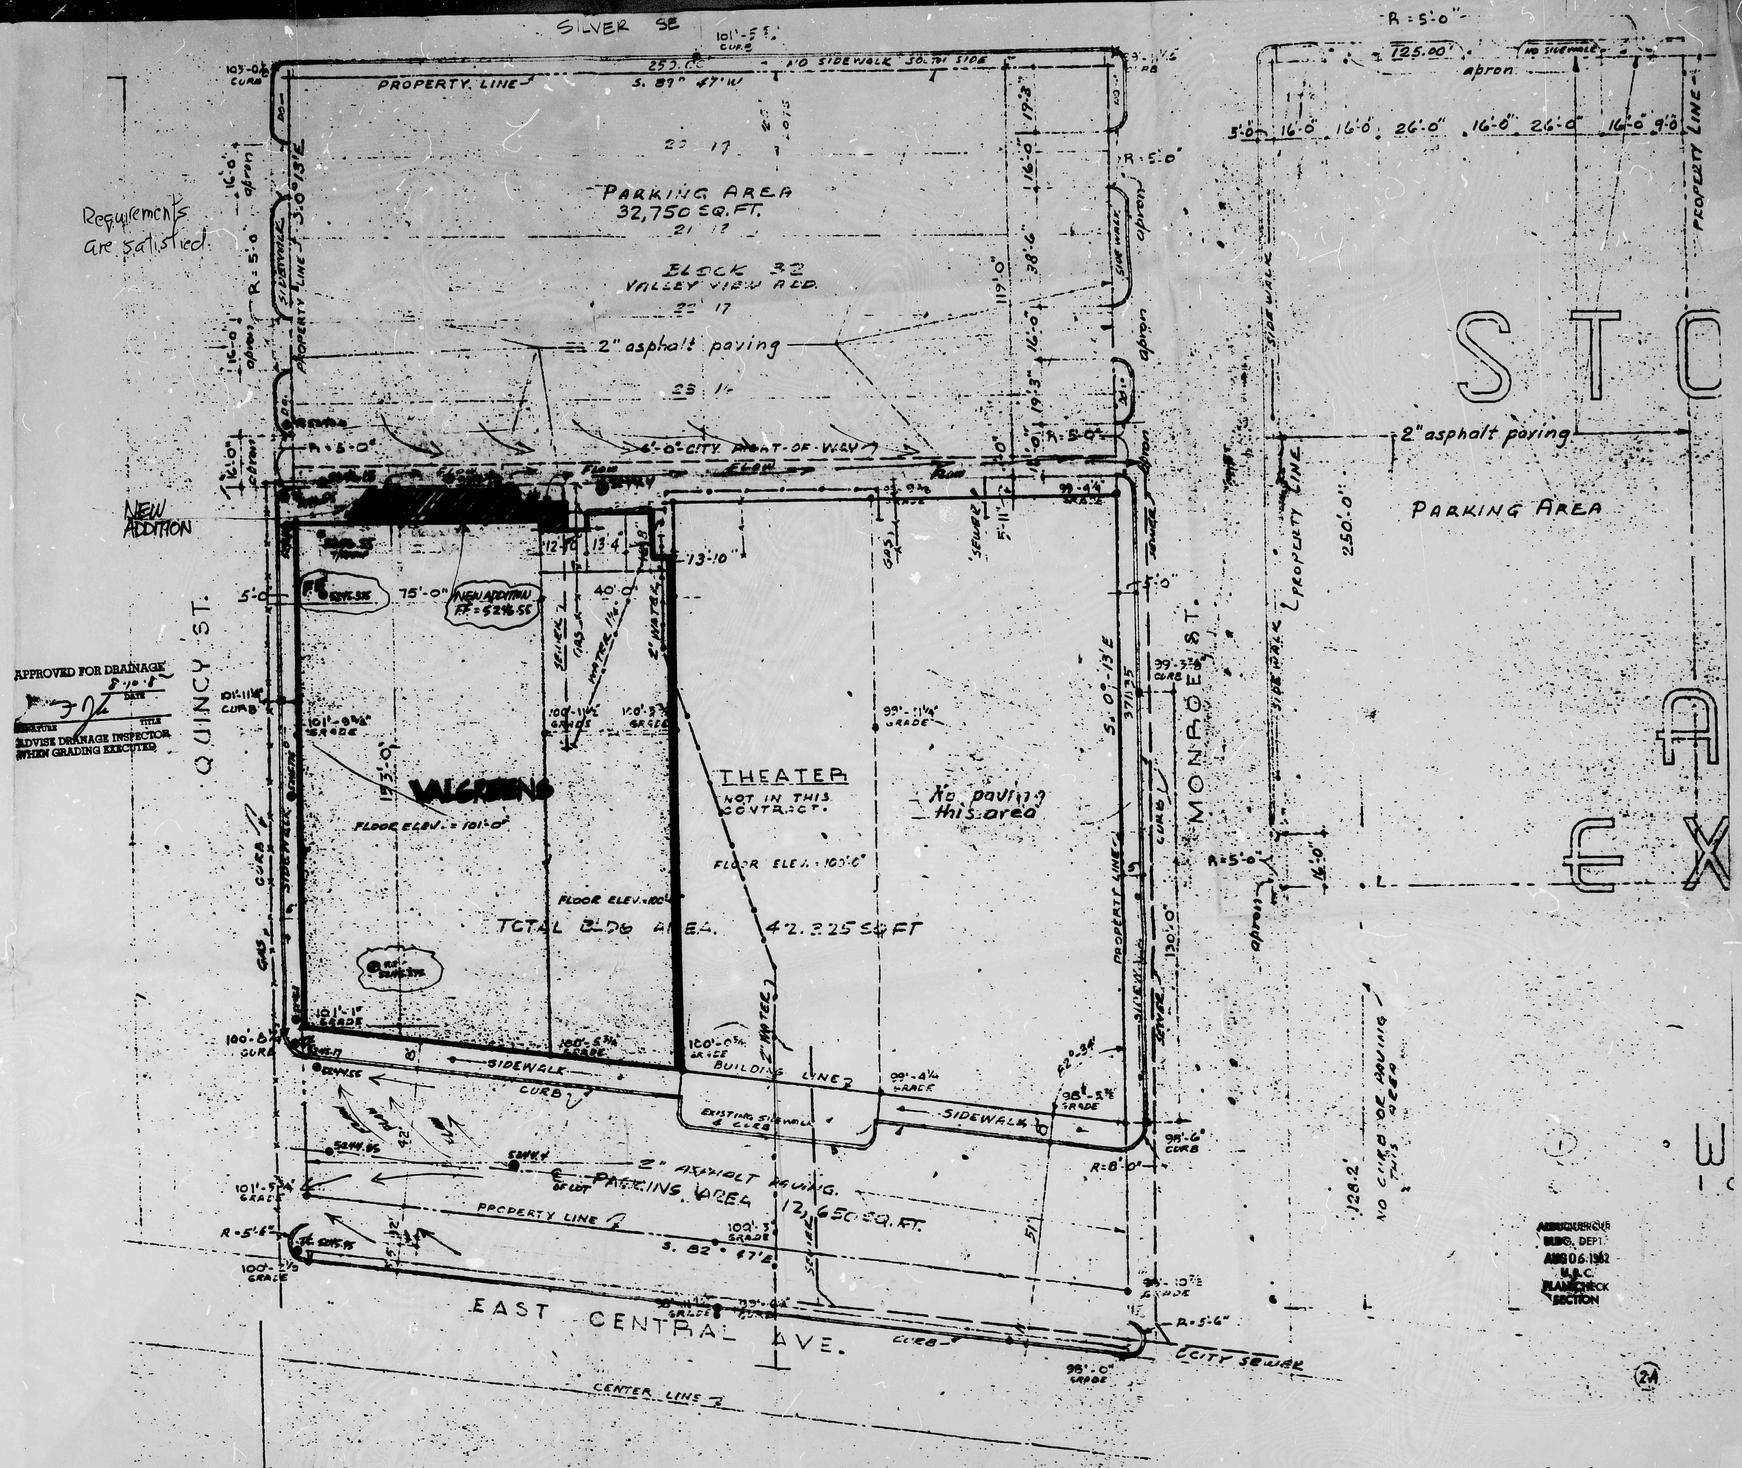

Requirements are satisfied

APPROVED FOR DRAINAGE
8-10-8
DATE
SIGNATURE TITLE
ADVISE DRAINAGE INSPECTOR WHEN GRADING EXECUTED

ALBUQUERQUE BLDG. DEPT. AUG 06 1962 U.B.C. PLANCHECK SECTION

4820 CENTRAL SE

PLOT PLAN

SCALE: 1" = 20'-0"

TOTAL SQ. FT. AREA 87,725.

* BENCHMARK IN MEDIAN OF CENTRAL & WASHINGTON MSL ELEV. 5244.95
SLD-1929 ABQ #5 K-17

K17-D17