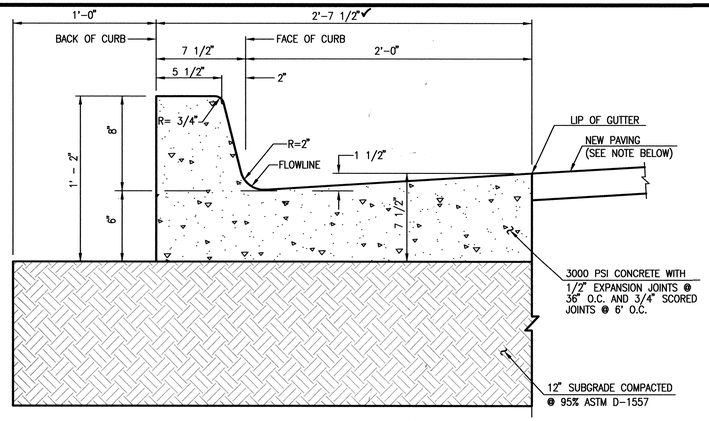

D1 TYPICAL CURB & GUTTER SECTION

SCALE: 1" = 0'-6"

NOTE: NEW PAVING SHALL BE CONCRETE OR ASPHALT PER PAVING PLAN, SHEET 3

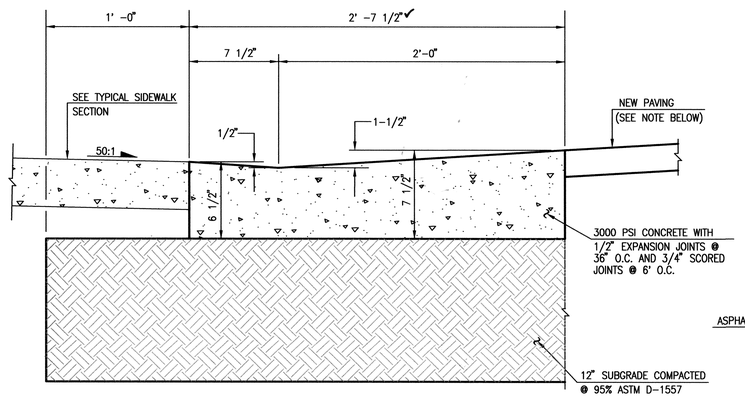

C1 TYPICAL CURB & GUTTER AT ACCESS RAMP/DRIVEPAD

SCALE: 1" = 1' = 0'-6"

NOTE: NEW PAVING SHALL BE CONCRETE OR ASPHALT PER PAVING PLAN, SHEET 3

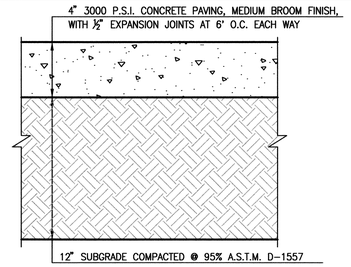

D3 TYPICAL 4" CONCRETE SIDEWALK SECTION

SCALE: 1" = 6"

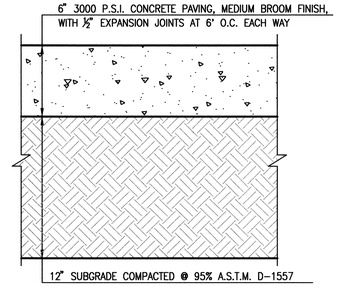

C3 TYPICAL 6" CONCRETE PAVEMENT SECTION

SCALE: 1" = 6"

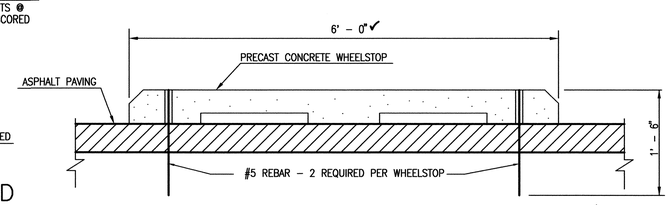

B3 WHEEL STOP SECTION

SCALE: 1" = 1'-0"

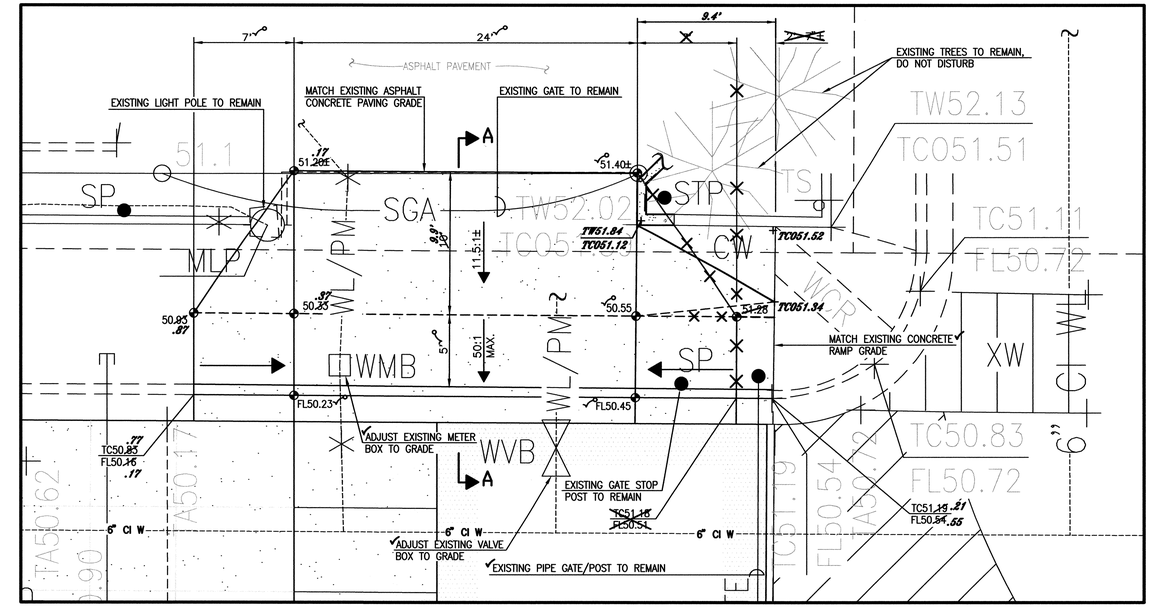

C4 TYPICAL DRIVEPAD DETAIL

SCALE: 1" = 5'-0"

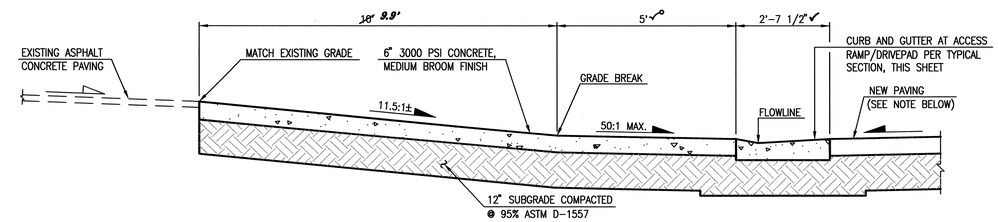

SECTION A -A

SCALE: 1" = 2'-0"

NOTE: NEW PAVING SHALL BE CONCRETE OR ASPHALT PER PAVING PLAN, SHEET 3

RECORD INFORMATION LEGEND

~~CONSTRUCT~~	RECORD INFORMATION (VERIFIED BY ENGINEER)
✓	AS-CONSTRUCTED = AS-DESIGNED (VERIFIED BY ENGINEER)
36' 42"	RECORD INFORMATION (VERIFIED BY ENGINEER)
+25.2	RECORD INFORMATION (VERIFIED BY ENGINEER)
⊕ 28,98.42	RECORD INFORMATION (VERIFIED BY ENGINEER)
✓	AS-CONSTRUCTED = AS-DESIGNED (VERIFIED BY AS-BUILT SURVEY)
32' 31.8	RECORD INFORMATION FROM AS-BUILT SURVEY
+26.9	RECORD INFORMATION FROM AS-BUILT SURVEY
⊕ 31,25.22	RECORD INFORMATION FROM AS-BUILT SURVEY

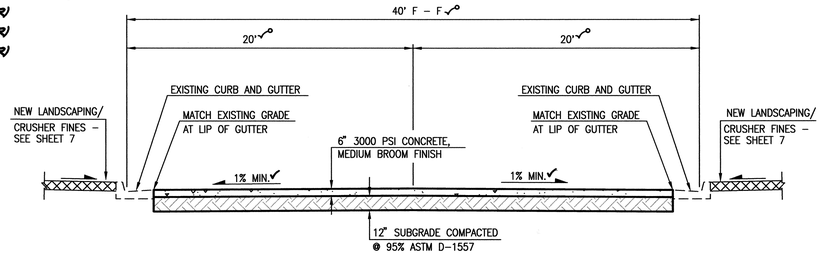

SECTION B -B

SCALE: 1" = 5'-0"

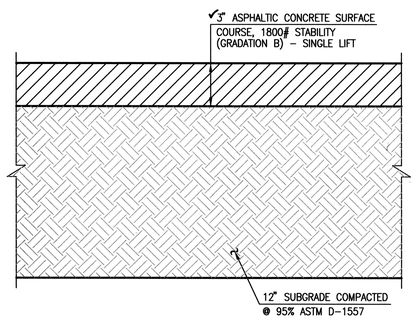

A1 TYPICAL 3" ASPHALT PAVING SECTION

SCALE: 1" = 0' - 5"

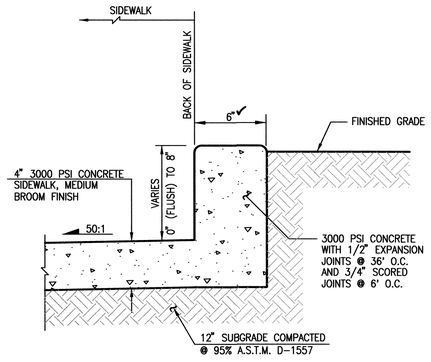

A2 INTEGRAL HEADER CURB SECTION

SCALE: 1" = 0'-6"

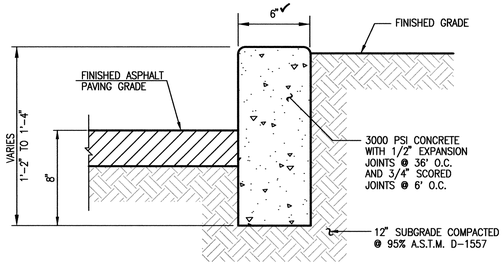

A3 HEADER CURB SECTION

SCALE: 1" = 0'-6"

RECORD DRAWING

FOR CERTIFICATION, SEE SHEET 1

08-01-2011

JEFFREY G. MORTENSEN NEW MEXICO 8547 REGISTERED PROFESSIONAL ENGINEER

01-22-2012

HIGH MESA Consulting Group

6010-B MIDWAY PARK BLVD. NE • ALBUQUERQUE, NEW MEXICO 87109

PHONE: 505.345.4250 • FAX: 505.345.4254 • www.highmesacg.com

PAVING SECTIONS AND DETAILS
COAL AVENUE PEDESTRIAN MALL
HIGHLAND HIGH SCHOOL

DESIGNED BY J.G.M./J.D.S.

DRAWN BY C.L.T./J.Y.R.

APPROVED BY J.G.M.

NO.	DATE	BY	
2	12/11	B.E.E.	RECORD DRAWING AND CERTIFICATION

JOB NO. 2010.180.5

DATE 08-2011

SHEET 4 OF 8

File Path: E:\DATA\2010.180.5\ENG\R-2\ | Plot Date: 12-21-2011
File Name: 101805_SH4_R2.DWG | Plot Time: 3:21 pm