HYDROLOGY K18/D13 1 PLAN

K18/D13

1 Plan

JOHN VANDER POL, ARCHITECT A.I.A.
10832 Prospect Ave. N.E.
Albuquerque, N.M. 87112 Suite K
298-7323

STATE OF NEW MEXICO
JOHN VANDER POL
1108
REGISTERED ARCHITECT

Engineer's stamp required see Amafca 1972-2 and the subdivision ordinance

DRAINAGE PLAN SCALE 1"=20'-0"
& REVISED SITE PLAN

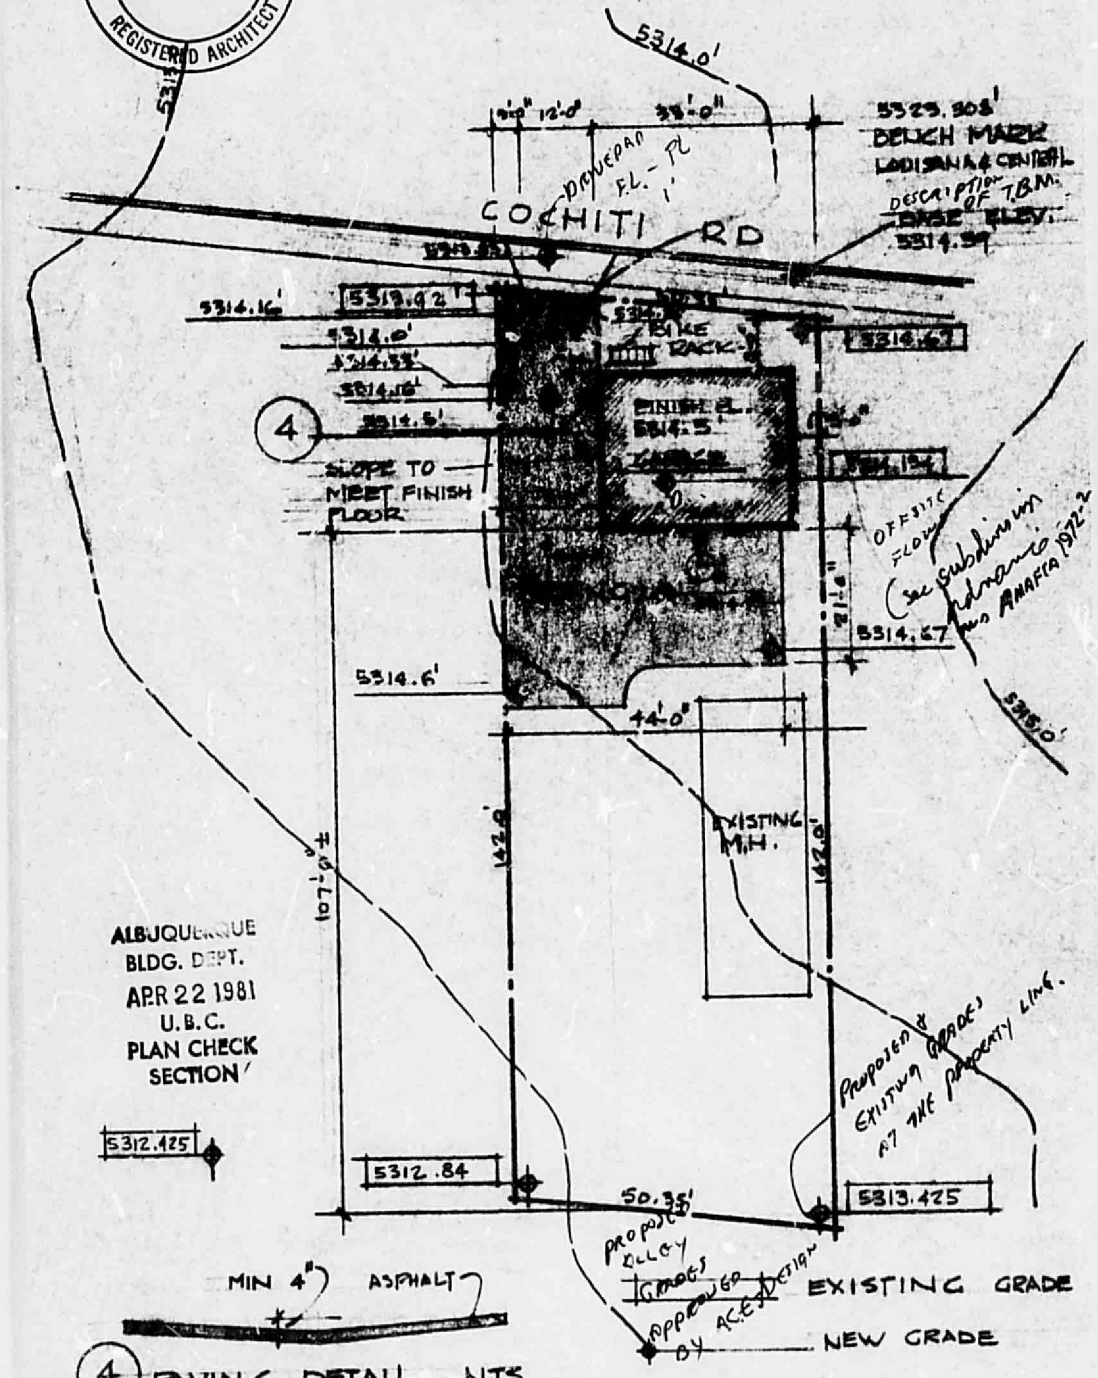

ALBUQUERQUE
BLDG. DEPT.
APR 22 1981
U.B.C.
PLAN CHECK
SECTION

5312.425

4 PAVING DETAIL NTS

GARAGE AT 6422 COCHITI RD S.E.
SITE & DRAINAGE PLAN