


# CITY OF ALBUQUERQUE

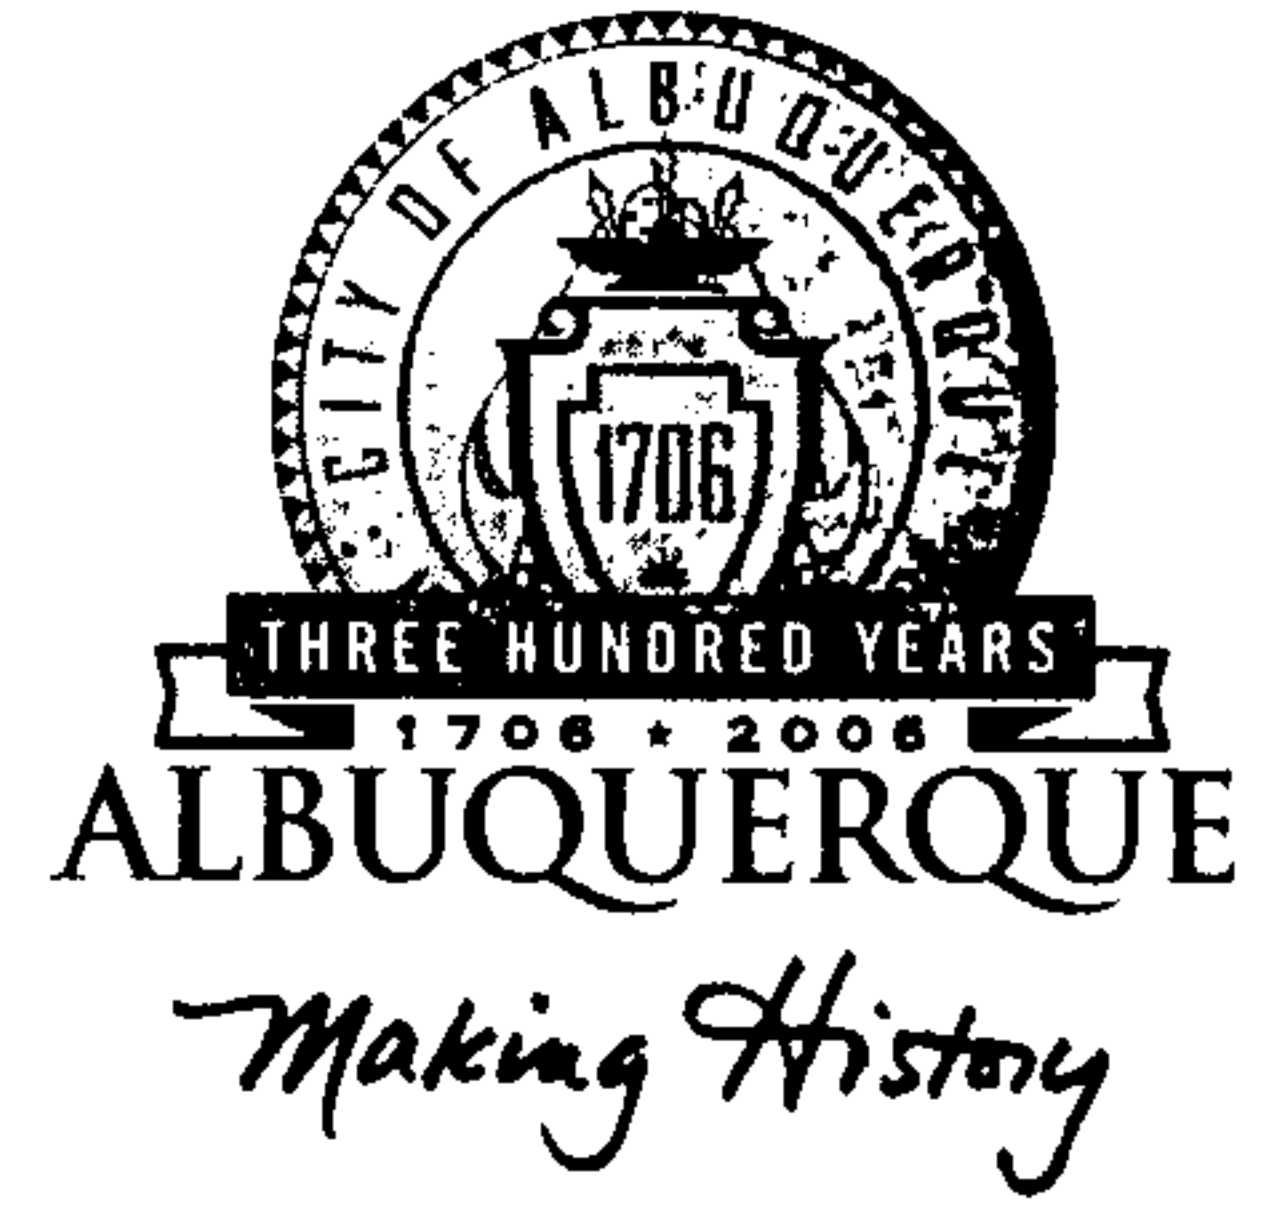

January 10 2004

Mr. Levi Valdez, P.E.  
12800 San Juan NE  
Albuquerque, NM 87123

**Re: CENTRAL TRAILER SUPPLY, INC.**  
**115 Utah NE**  
**Approval of Permanent Certificate of Occupancy (C.O.)**  
**Engineer's Stamp dated 08/23/2004 (K-19/D131)**  
**Certification dated 01/10/2005**

P.O. Box 1293

Dear Mr. Valdez,

Albuquerque

Based upon the information provided in your submittal received 01/10/2005, the above referenced certification is approved for release of Permanent Certificate of Occupancy by Hydrology.

New Mexico 87103

If you have any questions, you can contact me at 924-3982.

[www.cabq.gov](http://www.cabq.gov)

Sincerely,

Arlene V. Portillo  
Plan Checker, Planning Dept. - Hydrology  
Development and Building Services

C: Phyllis Villanueva  
George Rodriguez  
File

# DRAINAGE AND TRANSPORTATION INFORMATION SHEET

(REV. 1/28/2003rd)

PROJECT TITLE: CENTRAL TRAILER SUPPLY, INC. ZONE MAP/DRG. FILE #: K-19/D131  
 DRB #: \_\_\_\_\_ EPC#: \_\_\_\_\_ WORK ORDER#: \_\_\_\_\_

LEGAL DESCRIPTION: LOTS 42 THRU 47, BLOCK 4, MESA VERDE ADDITION  
 CITY ADDRESS: 115 UTAH N.E., ALBUQUERQUE, NEW MEXICO

ENGINEERING FIRM: LEVI J. VALDEZ, P.E.  
GEORGE T. RODRIGUEZ - CONSULT.  
 ADDRESS: 12800 SAN JUAN N.E.  
 CITY, STATE: ALBUQUERQUE, NEW MEXICO

CONTACT: LEVI VALDEZ  
 PHONE: (505) 610-0593  
 ZIP CODE: 87123

OWNER: CENTRAL TRAILER SUPPLY, INC.  
 ADDRESS: 115 UTAH N.E.  
 CITY, STATE: ALBUQUERQUE, NEW MEXICO

CONTACT: LOWELL SHARP  
 PHONE: 266-5687  
 ZIP CODE: 87108

ARCHITECT: F.J.A. DESIGN GROUP  
 ADDRESS: 1428 LAFAYETTE N.E.  
 CITY, STATE: ALBUQUERQUE, NEW MEXICO

CONTACT: FRED ARAGON  
 PHONE: 265-9612  
 ZIP CODE: 87106

SURVEYOR: WAY JOHN SURVEYING CO  
 ADDRESS: LOUISIANA N.E.  
 CITY, STATE: ALBUQUERQUE, NEW MEXICO

CONTACT: THOMAS JOHNSON  
 PHONE: (505) 255-2052  
 ZIP CODE: 87108

CONTRACTOR: RON MILLER CONSTRUCTION CO., INC.  
 ADDRESS: P.O. BOX 14901  
 CITY, STATE: ALBUQUERQUE, NEW MEXICO

CONTACT: RON MILLER  
 PHONE: 269-2300  
 ZIP CODE: 87191

## CHECK TYPE OF SUBMITTAL:


- ☐ DRAINAGE REPORT
- ☐ DRAINAGE PLAN 1<sup>st</sup> SUBMITTAL, *REQUIRES TCL or equal*
- ☐ DRAINAGE PLAN RESUBMITTAL
- ☐ CONCEPTUAL GRADING & DRAINAGE PLAN
- ☐ GRADING PLAN
- ☒ EROSION CONTROL PLAN
- ☒ ENGINEER'S CERTIFICATION (HYDROLOGY)
- ☐ CLOMR/LOMR
- ☐ TRAFFIC CIRCULATION LAYOUT (TCL)
- ☐ ENGINEERS CERTIFICATION (TCL)
- ☐ ENGINEERS CERTIFICATION (DRB APPR. SITE PLAN)
- ☐ OTHER

## CHECK TYPE OF APPROVAL SOUGHT:

- ☐ SIA / FINANCIAL GUARANTEE RELEASE
- ☐ PRELIMINARY PLAT APPROVAL
- ☐ S. DEV. PLAN FOR SUB'D. APPROVAL
- ☐ S. DEV. PLAN FOR BLDG. PERMIT APPROVAL
- ☐ SECTOR PLAN APPROVAL
- ☐ FINAL PLAT APPROVAL
- ☐ FOUNDATION PERMIT APPROVAL
- ☒ BUILDING PERMIT APPROVAL
- ☒ CERTIFICATE OF OCCUPANCY (PERM.)
- ☐ CERTIFICATE OF OCCUPANCY (TEMP.)
- ☐ GRADING PERMIT APPROVAL
- ☐ PAVING PERMIT APPROVAL
- ☐ WORK ORDER APPROVAL
- ☐ OTHER (SPECIFY)

## WAS A PRE-DESIGN CONFERENCE ATTENDED:

- ☒ YES
- ☐ NO
- ☐ COPY PROVIDED

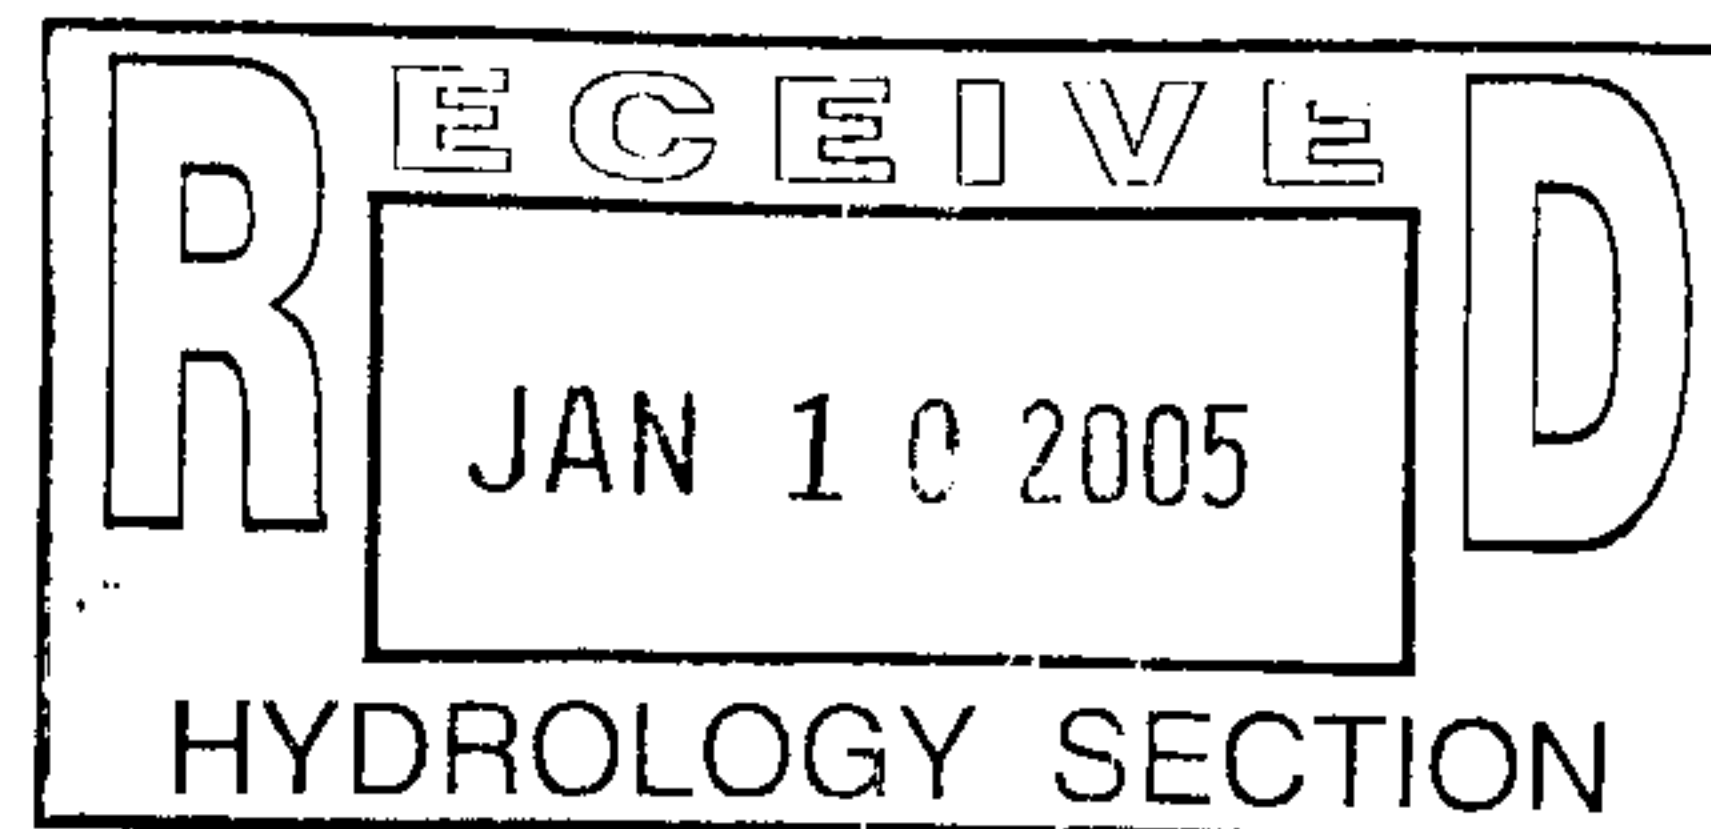


DATE SUBMITTED: 01-10-05 BY: GEORGE T. RODRIGUEZ

Requests for approvals of Site Development Plans and/or Subdivision Plats shall be accompanied by a drainage submittal. The particular nature, location and scope of the proposed development defines the degree of drainage detail. One or more of the following levels of submittal may be required based on the following:

1. **Conceptual Grading and Drainage Plan:** Required for approval of Site Development Plans greater than five (5) acres and Sector Plans.
2. **Drainage Plans:** Required for building permits, grading permits, paving permits and site plans less than five (5) acres.
3. **Drainage Report:** Required for subdivisions containing more than ten (10) lots or constituting five (5) acres or more.

# CITY OF ALBUQUERQUE

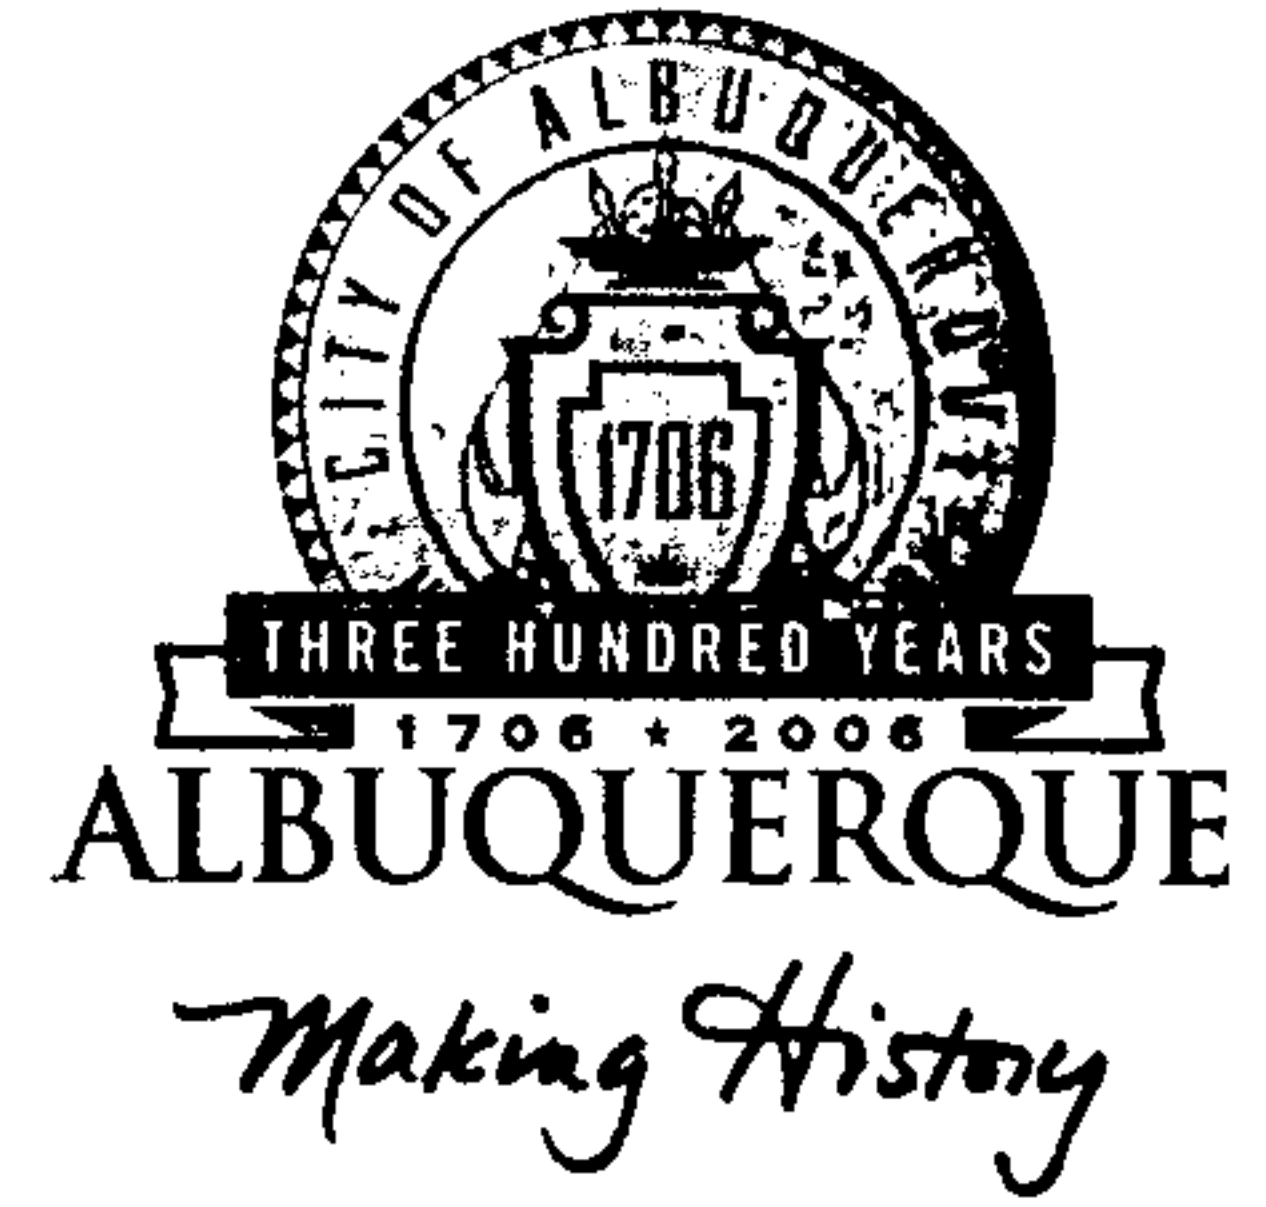

**Planning Department  
Transportation Development Services Section**

January 10, 2005

Levi J. Valdez, P.E.  
12800 San Juan NE  
Albuquerque, NM 87123

Re: Certification Submittal for Final Building Certificate of Occupancy for  
Central Trailer Supply Inc., [K-19 / D131]  
115 Utah NE  
Engineer's Stamp Dated 01/10/05

Dear Mr. Levi:

P.O. Box 1293

The TCL / Letter of Certification submitted on January 10, 2005 is sufficient for acceptance by this office for final Certificate of Occupancy (C.O.). Notification has been made to the Building and Safety Section.

Albuquerque

Sincerely,

New Mexico 87103

Nilo E. Salgado-Fernandez, P.E.  
Senior Traffic Engineer  
Development and Building Services  
Planning Department

[www.cabq.gov](http://www.cabq.gov)

c: Engineer  
Hydrology file  
CO Clerk



# DRAINAGE AND TRANSPORTATION INFORMATION SHEET

(REV. 1/28/2003rd)

PROJECT TITLE: CENTRAL TRAILER SUPPLY, INC. ZONE MAP/DRG. FILE #: K-19/D131  
 DRB #: \_\_\_\_\_ EPC#: \_\_\_\_\_ WORK ORDER#: \_\_\_\_\_

LEGAL DESCRIPTION: LOTS 42 THRU 47, BLOCK 4, MESA VERDE ADDITION  
 CITY ADDRESS: 115 UTAH N.E., ALBUQUERQUE, NEW MEXICO

ENGINEERING FIRM: LEVI J. VALDEZ, P.E.  
GEORGE T. RODRIGUEZ - CONSULT.  
 ADDRESS: 12800 SAN JUAN N.E.  
 CITY, STATE: ALBUQUERQUE, NEW MEXICO

CONTACT: LEVI VALDEZ  
 PHONE: (505) 610-0593  
 ZIP CODE: 87123

OWNER: CENTRAL TRAILER SUPPLY, INC.  
 ADDRESS: 115 UTAH N.E.  
 CITY, STATE: ALBUQUERQUE, NEW MEXICO

CONTACT: LOWELL SHARP  
 PHONE: 266-5687  
 ZIP CODE: 87108

ARCHITECT: F.J.A. DESIGN GROUP  
 ADDRESS: 1428 LAFAYETTE N.E.  
 CITY, STATE: ALBUQUERQUE, NEW MEXICO

CONTACT: FRED ARAGON  
 PHONE: 265-9612  
 ZIP CODE: 87106

SURVEYOR: WAY JOHN SURVEYING CO  
 ADDRESS: LOUISIANA N.E.  
 CITY, STATE: ALBUQUERQUE, NEW MEXICO

CONTACT: THOMAS JOHNSON  
 PHONE: (505) 255-2052  
 ZIP CODE: 87108

CONTRACTOR: RON MILLER CONSTRUCTION CO., INC.  
 ADDRESS: P.O. BOX 14901  
 CITY, STATE: ALBUQUERQUE, NEW MEXICO

CONTACT: RON MILLER  
 PHONE: 269-2300  
 ZIP CODE: 87191

**CHECK TYPE OF SUBMITTAL:**


- ☐ DRAINAGE REPORT
- ☐ DRAINAGE PLAN 1" SUBMITTAL, *REQUIRES TCL or equal*
- ☐ DRAINAGE PLAN RESUBMITTAL
- ☐ CONCEPTUAL GRADING & DRAINAGE PLAN
- ☐ GRADING PLAN
- ☐ EROSION CONTROL PLAN
- ☐ ENGINEER'S CERTIFICATION (HYDROLOGY)
- ☐ CLOMR/LOMR
- ☒ TRAFFIC CIRCULATION LAYOUT (TCL)
- ☒ ENGINEERS CERTIFICATION (TCL)
- ☐ ENGINEERS CERTIFICATION (DRB APPR. SITE PLAN)
- ☐ OTHER

**CHECK TYPE OF APPROVAL SOUGHT:**

- ☐ SIA / FINANCIAL GUARANTEE RELEASE
- ☐ PRELIMINARY PLAT APPROVAL
- ☐ S. DEV. PLAN FOR SUB'D. APPROVAL
- ☐ S. DEV. PLAN FOR BLDG. PERMIT APPROVAL
- ☐ SECTOR PLAN APPROVAL
- ☐ FINAL PLAT APPROVAL
- ☐ FOUNDATION PERMIT APPROVAL
- ☐ BUILDING PERMIT APPROVAL
- ☒ CERTIFICATE OF OCCUPANCY (PERM.)
- ☐ CERTIFICATE OF OCCUPANCY (TEMP.)
- ☐ GRADING PERMIT APPROVAL
- ☐ PAVING PERMIT APPROVAL
- ☐ WORK ORDER APPROVAL
- ☐ OTHER (SPECIFY)

**WAS A PRE-DESIGN CONFERENCE ATTENDED:**

- ☒ YES
- ☐ NO
- ☐ COPY PROVIDED

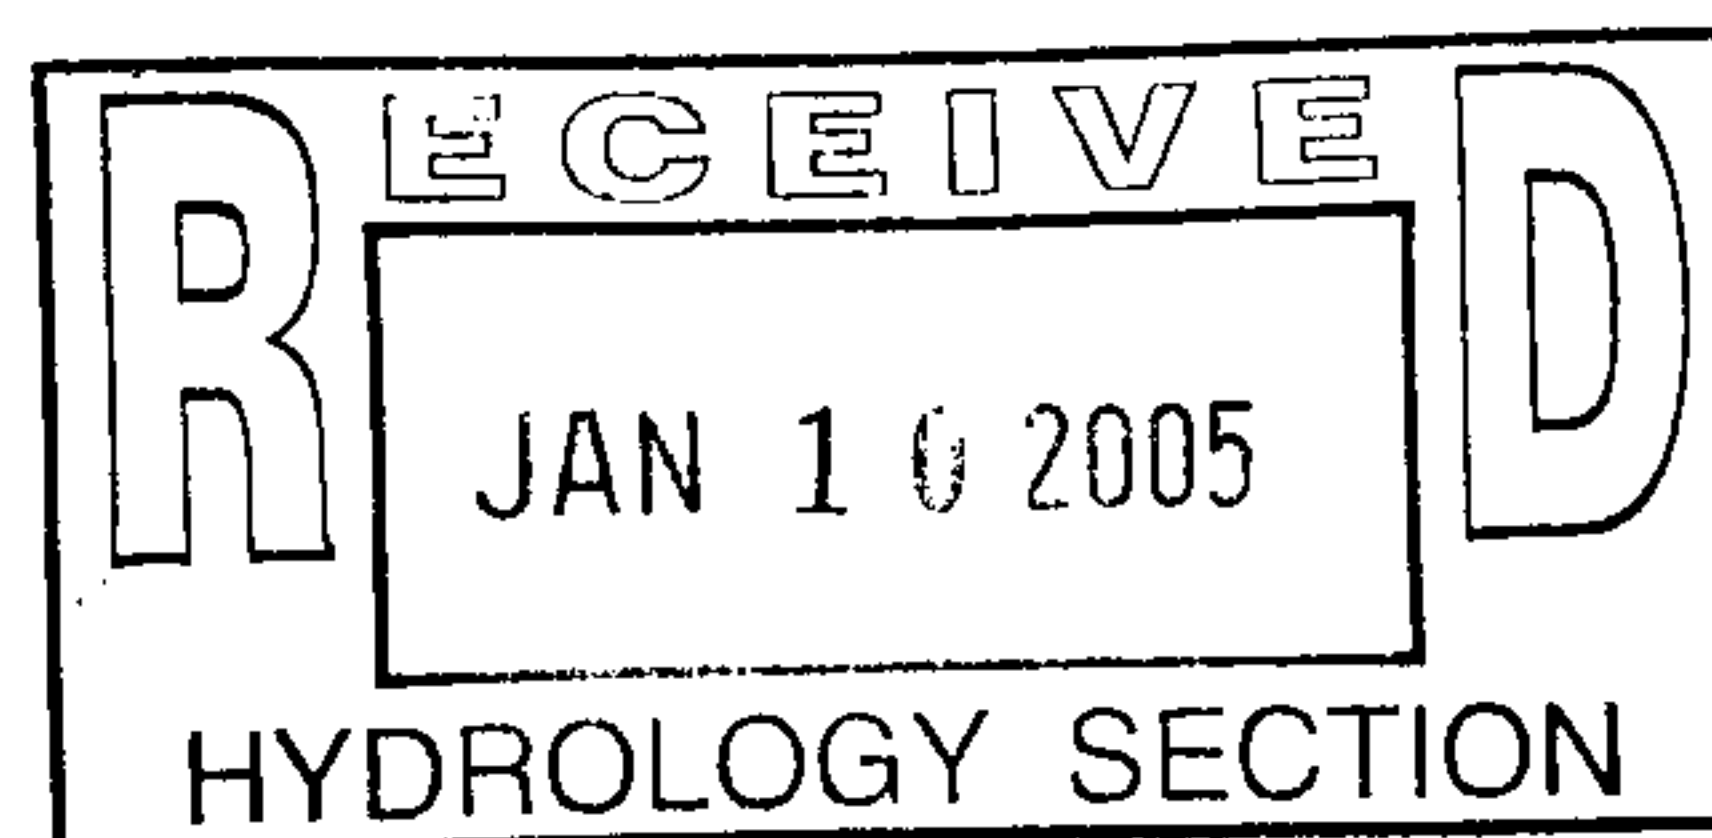

DATE SUBMITTED: 01-10-05 BY: GEORGE T. RODRIGUEZ


Requests for approvals of Site Development Plans and/or Subdivision Plats shall be accompanied by a drainage submittal. The particular nature, location and scope of the proposed development defines the degree of drainage detail. One or more of the following levels of submittal may be required based on the following:

1. **Conceptual Grading and Drainage Plan:** Required for approval of Site Development Plans greater than five (5) acres and Sector Plans.
2. **Drainage Plans:** Required for building permits, grading permits, paving permits and site plans less than five (5) acres.
3. **Drainage Report:** Required for subdivisions containing more than ten (10) lots or constituting five (5) acres or more.





K-19/D131

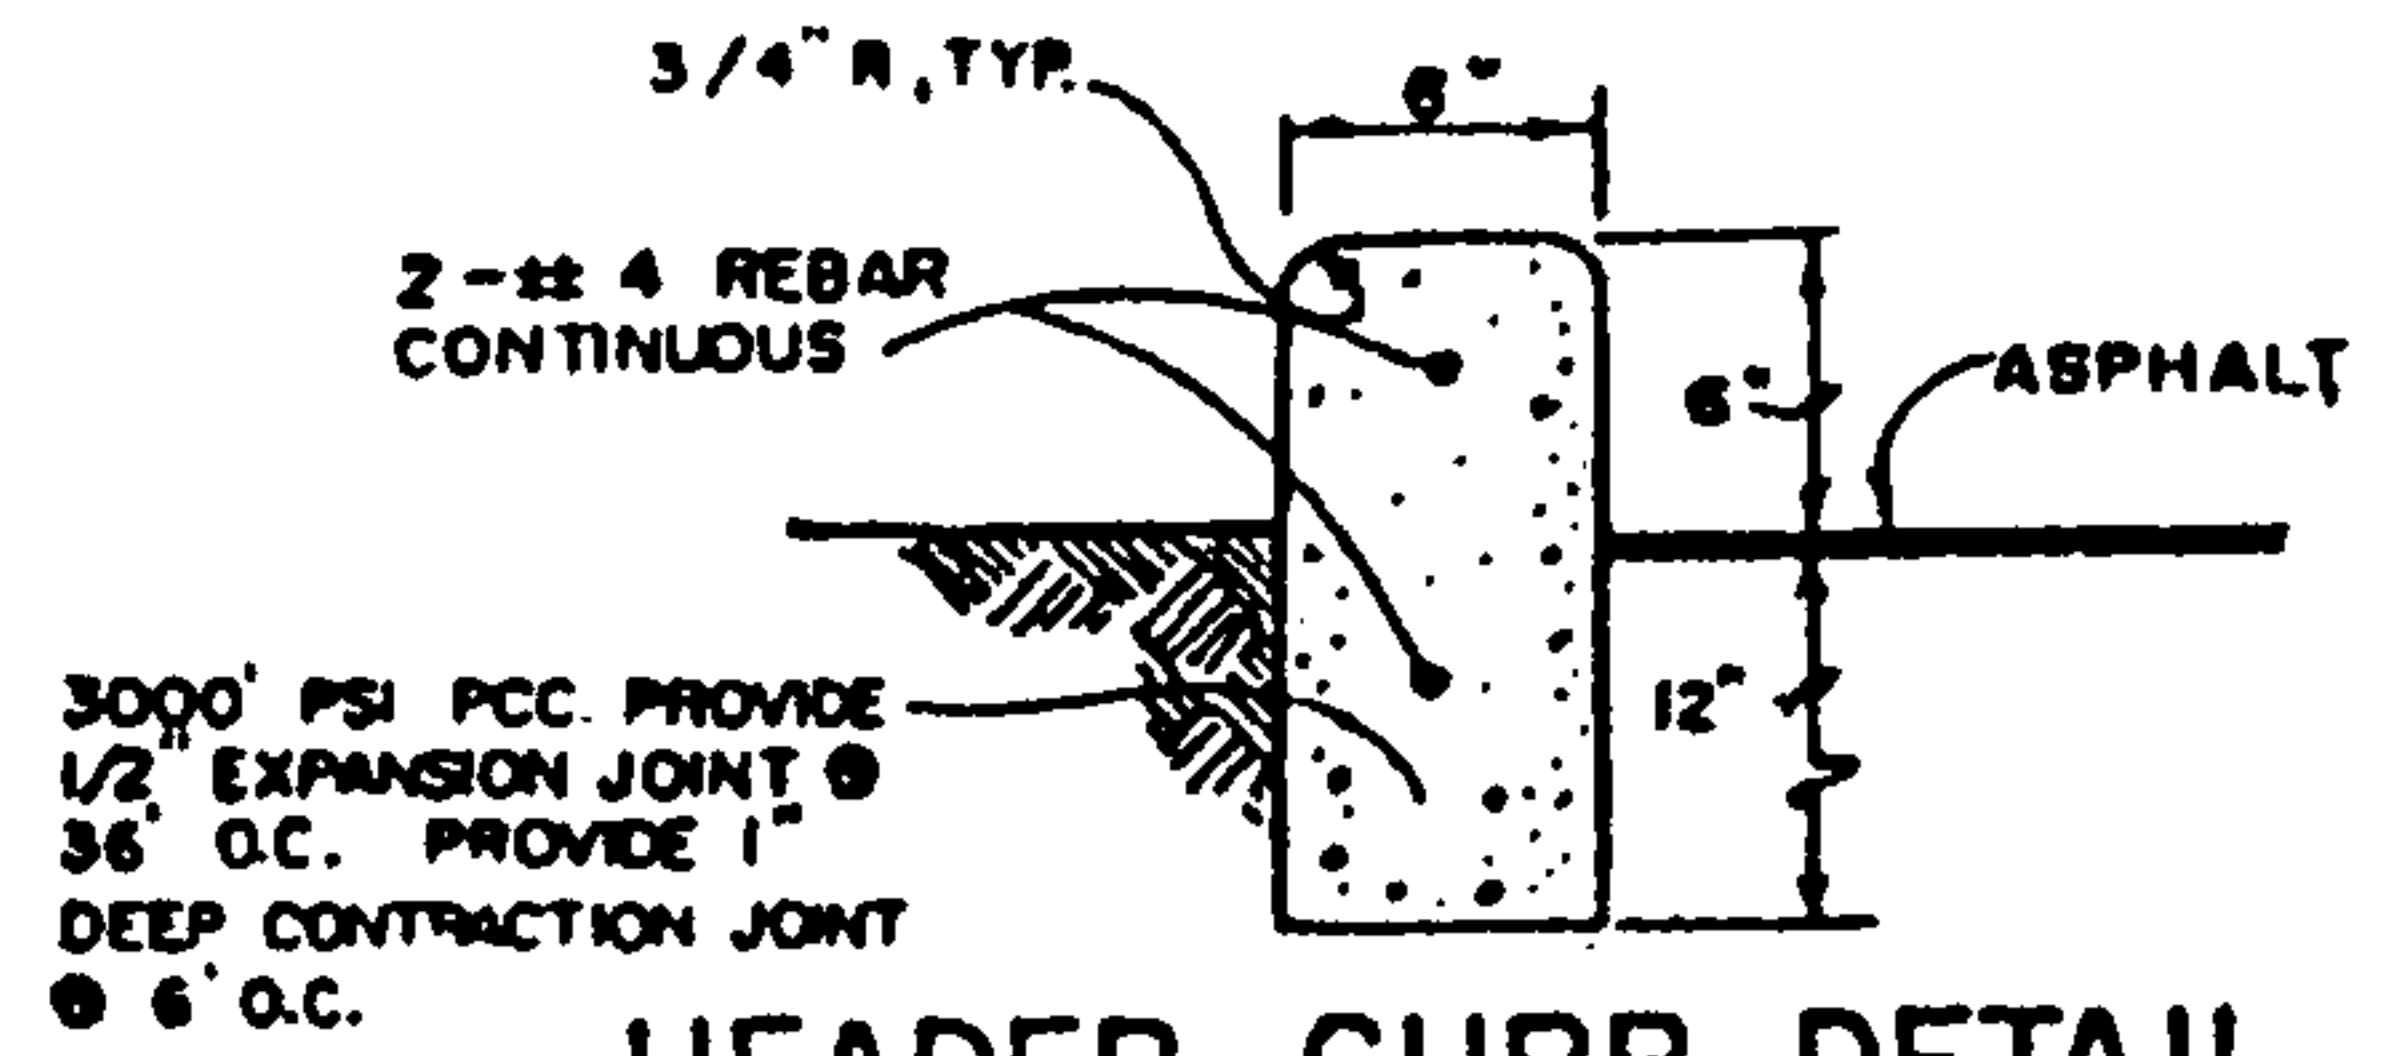

HEADER CURB DETAIL (A)  
SCALE: 1"=1'-0"


\* THIS DRAWING IS A PARTIAL OF THE APPROVED T.C.L. ON FILE (NEEDED FOR PERMANENT C.O.)

NORTH  
SCALE: 1"=10'

TRAFFIC CIRCULATION LAYOUT  
APPROVED  
*WDL*  
Signed  
10/12  
Date

RECEIVED  
OCT 12 2004  
HYDROLOGY SECTION

RECEIVED  
JAN 10 2005  
HYDROLOGY SECTION

 

NOTES:

- ① → PROVIDE NEW 6' CONCRETE SIDEWALK. ✓ DONE
- ② → PROVIDE NEW 25' CONCRETE CURB CUT AND DRIVEPAD & CURB-GUTTER. ✓ DONE
- ③ → PROVIDE NEW 6' CONCRETE SIDEWALK, CURB & GUTTER. ✓ DONE
- (A) → PROVIDE HEADER CURB (SEE DETAIL) ✓ DONE
- ⓧ → REMOVE EXISTING ASPHALT FOR LANDSCAPE AREA. (REMAINED AS EXISTING ASPHALT)

LEVI J. VALDEZ  
NEW MEXICO  
5693  
REGISTERED PROFESSIONAL ENGINEER  
10-08-04  
01-07-05  
01-10-05


REMOVE EXISTING ASPHALT & CONCRETE WITHIN R/W & PROVIDE NEW DRIVEPAD, SIDEWALK, C & G  
PER C.O.A. STANDARD DRAWING REQ.

ALBUQUERQUE  
BUILDING & SAFETY  
OCT 08 2004  
IBC  
PLAN CHECK SECTION

115 UTAH STREET N.E.

\* ADDENDUM NO. 1  
(DRIVE & SIDEWALKS)

# CITY OF ALBUQUERQUE

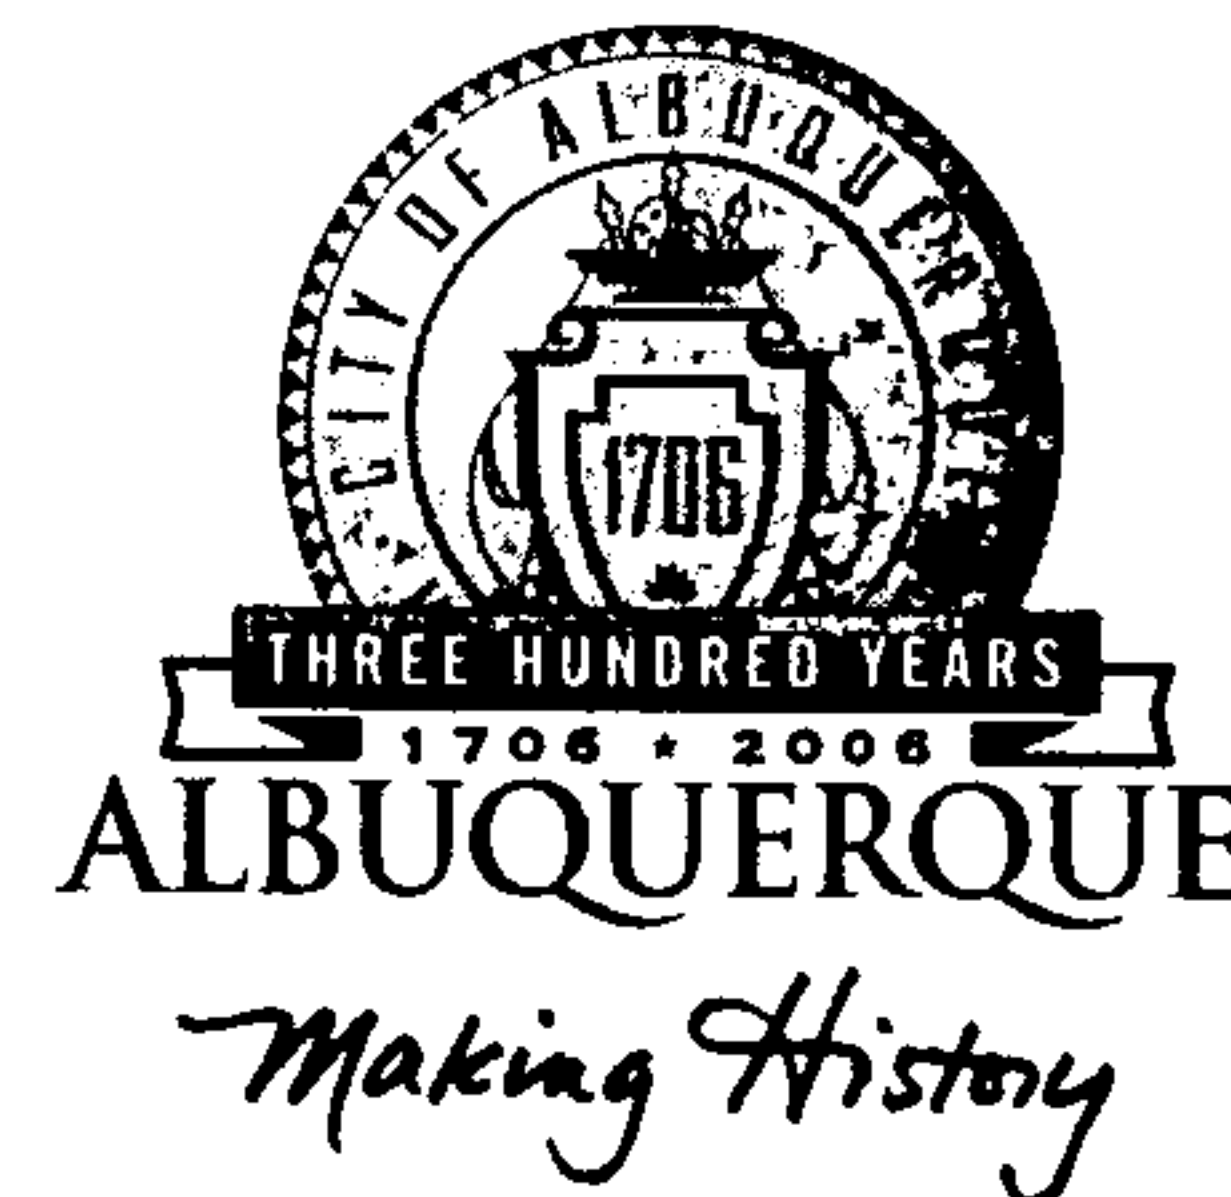

January 7, 2004

Mr. Levi Valdez, P.E.  
12800 San Juan NE  
Albuquerque, NM 87123

**Re: CENTRAL TRAILER SUPPLY, INC.**  
**115 Utah NE**  
**Approval of Temporary Certificate of Occupancy (C.O.)**  
**Engineer's Stamp dated 08/23/2004 (K-19/D131)**  
**Certification dated 01/07/2005**

P.O. Box 1293

Dear Mr. Valdez,

Albuquerque

Based upon the information provided in your submittal received 01/07/2005, the above referenced certification is approved for release of 30-day Temporary Certificate of Occupancy by Hydrology.

New Mexico 87103

Upon acceptance of the required SO-19, please resubmit an updated Certification for Permanent C.O..

If you have any questions, you can contact me at 924-3982.

[www.cabq.gov](http://www.cabq.gov)

Sincerely,


*Arlene V. Portillo* 1/5/05

Arlene V. Portillo  
Plan Checker, Planning Dept. - Hydrology  
Development and Building Services

C: Phyllis Villanueva  
George Rodriguez  
File



# CITY OF ALBUQUERQUE

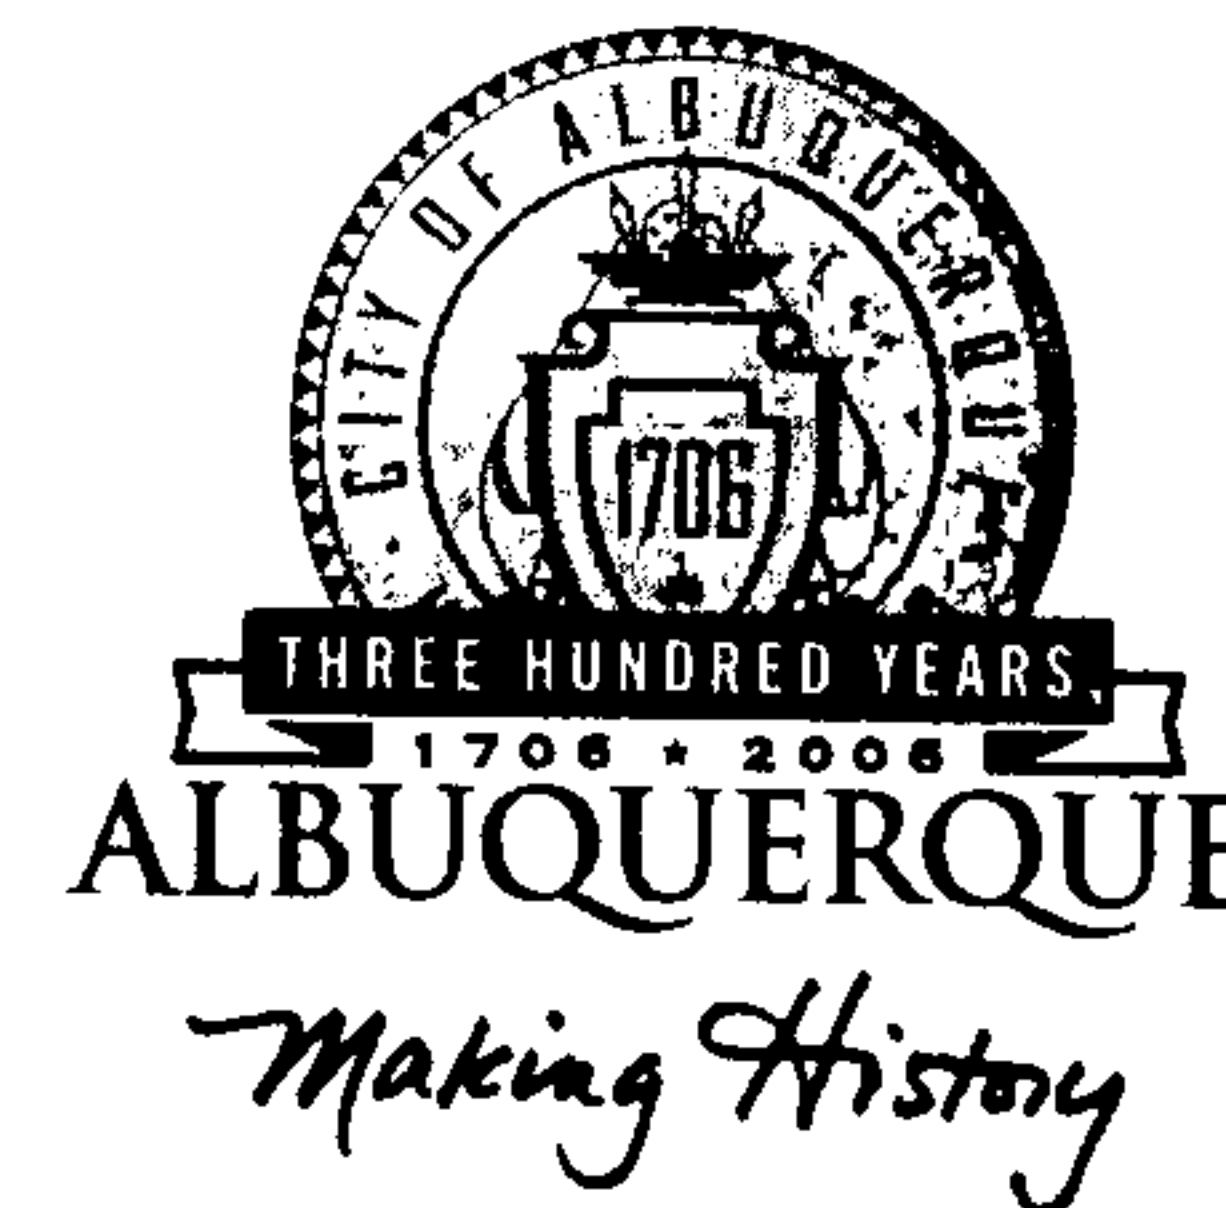

October 12, 2004

Levi Valdez, P.E.  
George T. Rodriguez Development Consultants  
12800 San Juan NE  
Albuquerque, NM 87123

Re: Central Trailer Supply Inc, 115 Utah St, Traffic Circulation Layout  
Engineer's Stamp dated 8-23-04 (K19-D131)

Dear Mr. Valdez,

The TCL submittal received 10-12-04 is approved for Building Permit. The plan is stamped and signed as approved. A copy of this plan will be needed for each of the building permit plans. Please keep the original to be used for certification of the site for final C.O. for Transportation.

If a temporary CO is needed, a copy of the original TCL that was stamped as approved by the City will be needed. This plan must include a statement that identifies the outstanding items that need to be constructed or the items that have not been built in "substantial compliance," as well as the signed and dated stamp of a NM registered architect or engineer. Submit this TCL with a completed Drainage and Transportation Information Sheet to Hydrology at the Development Services Center of Plaza Del Sol Building.

When the site is completed and a final C.O. is requested, use the original City stamped approved TCL for certification. A NM registered architect or engineer must stamp, sign, and date the certification TCL along with indicating that the development was built in "substantial compliance" with the TCL. Submit this certification TCL with a completed Drainage and Transportation Information Sheet to Hydrology at the Development Services Center of Plaza Del Sol Building.

Once verification of certification is completed and approved, notification will be made to Building Safety to issue Final C.O. To confirm that a final C.O. has been issued, call Building Safety at 924-3306.

Sincerely,

Kristal D. Metro  
Engineering Associate, Planning Dept.  
Development and Building Services

cc: file

P.O. Box 1293


Albuquerque

New Mexico 87103

www.cabq.gov



# CITY OF ALBUQUERQUE

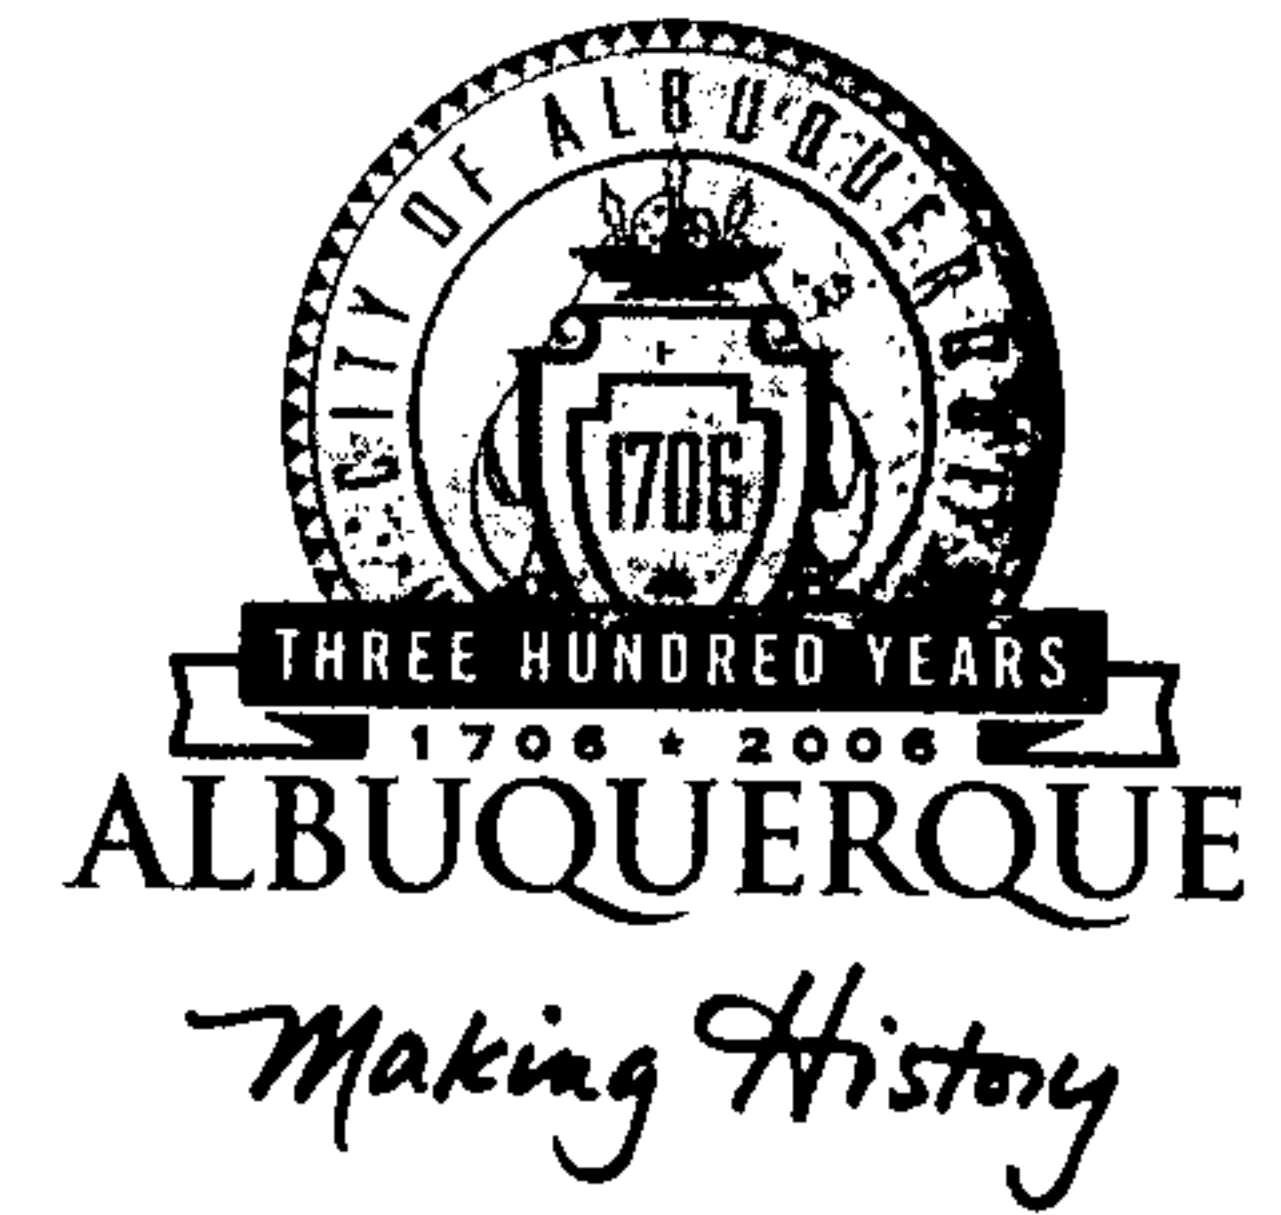

October 6, 2004

Levi Valdez, P.E.  
George T. Rodriguez Development Consultants  
12800 San Juan NE  
Albuquerque, NM 87123

**Re: Central Trailer Supply, 115 Utah St NE, Grading and Drainage Plan  
Engineer's Stamp dated 8-23-04 (K19-D131)**

Dear Mr. Valdez,

Based upon the information provided in your submittal received 8-25-04, the above referenced plan is approved for Building Permit. Please attach a copy of this approved plan to the construction sets prior to sign-off by Hydrology.

P.O. Box 1293

A separate permit (SO#19) is required for construction within City Right of Way. A copy of this approval letter must be on hand when applying for the excavation permit. Prior to Certificate of Occupancy release, Engineer Certification per the DPM checklist will be required.

Albuquerque

If you have any questions, you can contact me at 924-3981.

New Mexico 87103


Sincerely,

Kristal D. Metro  
Engineering Associate, Planning Dept.  
Development and Building Services

[www.cabq.gov](http://www.cabq.gov)

C: Matt Cline, Arroyo Maintenance  
Pam Lujan, Excavation Permits  
File

# CITY OF ALBUQUERQUE

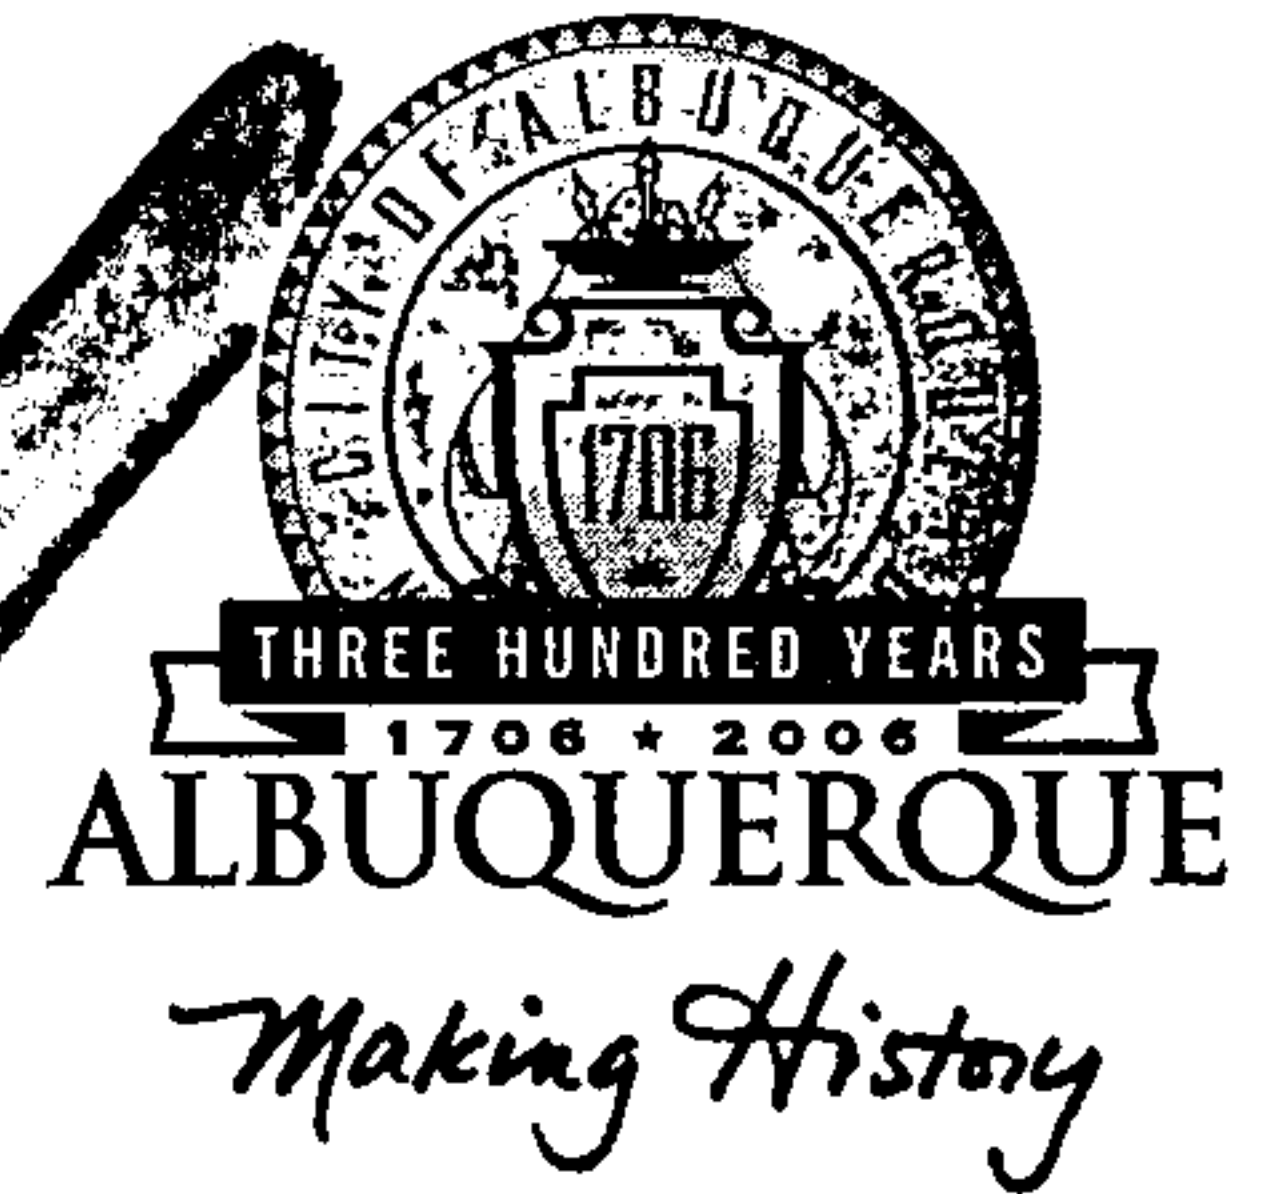

August 30, 2004

Levi Valdez, P.E.  
George T. Rodriguez Development Consultants  
12800 San Juan NE  
Albuquerque, NM 87123

Re: Central Trailer Supply Inc, 115 Utah St. Traffic Circulation Layout  
Engineer's Stamp dated 8-23-04 (K19-D131)

Dear Mr. Valdez,

The TCL submittal received 8-25-04 is approved for Building Permit. The plan is stamped and signed as approved. A copy of this plan will be needed for each of the building permit plans. Please keep the original to be used for certification of the site for final C.O. for Transportation.

If a temporary CO is needed, a copy of the original TCL that was stamped as approved by the City will be needed. This plan must include a statement that identifies the outstanding items that need to be constructed or the items that have not been built in "substantial compliance," as well as the signed and dated stamp of a NM registered architect or engineer. Submit this TCL with a completed Drainage and Transportation Information Sheet to Hydrology at the Development Services Center of Plaza Del Sol Building.

When the site is completed and a final C.O. is requested, use the original City stamped approved TCL for certification. A NM registered architect or engineer must stamp, sign, and date the certification TCL along with indicating that the development was built in "substantial compliance" with the TCL. Submit this certification TCL with a completed Drainage and Transportation Information Sheet to Hydrology at the Development Services Center of Plaza Del Sol Building.

Once verification of certification is completed and approved, notification will be made to Building Safety to issue Final C.O. To confirm that a final C.O. has been issued, call Building Safety at 924-3306.

Sincerely,

Kristal D. Metro  
Engineering Associate, Planning Dept.  
Development and Building Services

cc: file

P.O. Box 1293

Albuquerque

New Mexico 87103

www.cabq.gov



# DRAINAGE AND TRANSPORTATION INFORMATION SHEET

(REV. 1/28/2003rd)

PROJECT TITLE: CENTRAL TRAILER SUPPLY, INC. ZONE MAP/DRG. FILE #: K-19/D131  
 DRB #: \_\_\_\_\_ EPC#: \_\_\_\_\_ WORK ORDER#: \_\_\_\_\_

LEGAL DESCRIPTION: LOTS 42 THRU 47, BLOCK 4, MESA VERDE ADDITION  
 CITY ADDRESS: 115 UTAH N.E., ALBUQUERQUE, NEW MEXICO

ENGINEERING FIRM: LEVI J. VALDEZ, P.E.  
GEORGE T. RODRIGUEZ - CONSULT.  
 ADDRESS: 12800 SAN JUAN N.E.  
 CITY, STATE: ALBUQUERQUE, NEW MEXICO

CONTACT: LEVI VALDEZ  
GEORGE T. RODRIGUEZ  
 PHONE: (505) 610-0593  
 ZIP CODE: 87123

OWNER: CENTRAL TRAILER SUPPLY, INC.  
 ADDRESS: 115 UTAH N.E.  
 CITY, STATE: ALBUQUERQUE, NEW MEXICO

CONTACT: LOWELL SHARP  
 PHONE: 266-5687  
 ZIP CODE: 87108

ARCHITECT: F.J.A. DESIGN GROUP  
 ADDRESS: 1428 LAFAYETTE N.E.  
 CITY, STATE: ALBUQUERQUE, NEW MEXICO

CONTACT: FRED ARAGON  
 PHONE: 265-9612  
 ZIP CODE: 87106

SURVEYOR: WAY JOHN SURVEYING CO  
 ADDRESS: LOUISIANA N.E.  
 CITY, STATE: ALBUQUERQUE, NEW MEXICO

CONTACT: THOMAS JOHNSON  
 PHONE: (505) 255-2052  
 ZIP CODE: 87108

CONTRACTOR: RON MILLER CONSTRUCTION CO., INC.  
 ADDRESS: P.O. BOX 1490  
 CITY, STATE: ALBUQUERQUE, NEW MEXICO

CONTACT: RON MILLER  
 PHONE: 269-2300  
 ZIP CODE: 87191

## CHECK TYPE OF SUBMITTAL:

- ☐ DRAINAGE REPORT
- ☐ DRAINAGE PLAN 1<sup>st</sup> SUBMITTAL, *REQUIRES TCL or equal*
- ☐ DRAINAGE PLAN RESUBMITTAL
- ☐ CONCEPTUAL GRADING & DRAINAGE PLAN
- ☐ GRADING PLAN
- ☐ EROSION CONTROL PLAN
- ☐ ENGINEER'S CERTIFICATION (HYDROLOGY)
- ☐ CLOMR/LOMR
- ☒ TRAFFIC CIRCULATION LAYOUT (TCL)
- ☒ ENGINEERS CERTIFICATION (TCL)
- ☐ ENGINEERS CERTIFICATION (DRB APPR. SITE PLAN)
- ☐ OTHER


## CHECK TYPE OF APPROVAL SOUGHT:

- ☐ SIA / FINANCIAL GUARANTEE RELEASE
- ☐ PRELIMINARY PLAT APPROVAL
- ☐ S. DEV. PLAN FOR SUB'D. APPROVAL
- ☐ S. DEV. PLAN FOR BLDG. PERMIT APPROVAL
- ☐ SECTOR PLAN APPROVAL
- ☐ FINAL PLAT APPROVAL
- ☐ FOUNDATION PERMIT APPROVAL
- ☐ BUILDING PERMIT APPROVAL
- ☒ CERTIFICATE OF OCCUPANCY (PERM.)
- ☐ CERTIFICATE OF OCCUPANCY (TEMP.)
- ☐ GRADING PERMIT APPROVAL
- ☐ PAVING PERMIT APPROVAL
- ☐ WORK ORDER APPROVAL
- ☐ OTHER (SPECIFY)

WAS A PRE-DESIGN CONFERENCE ATTENDED:

- ☒ YES
- ☐ NO
- ☐ COPY PROVIDED

*1/7/05 : Talked w/ Phyllis V.  
 + approved a Verral-Co.  
 (Temp). Nils will process a written  
 (Perm). C.D. on Monday 1-10-05  
 Arlene*

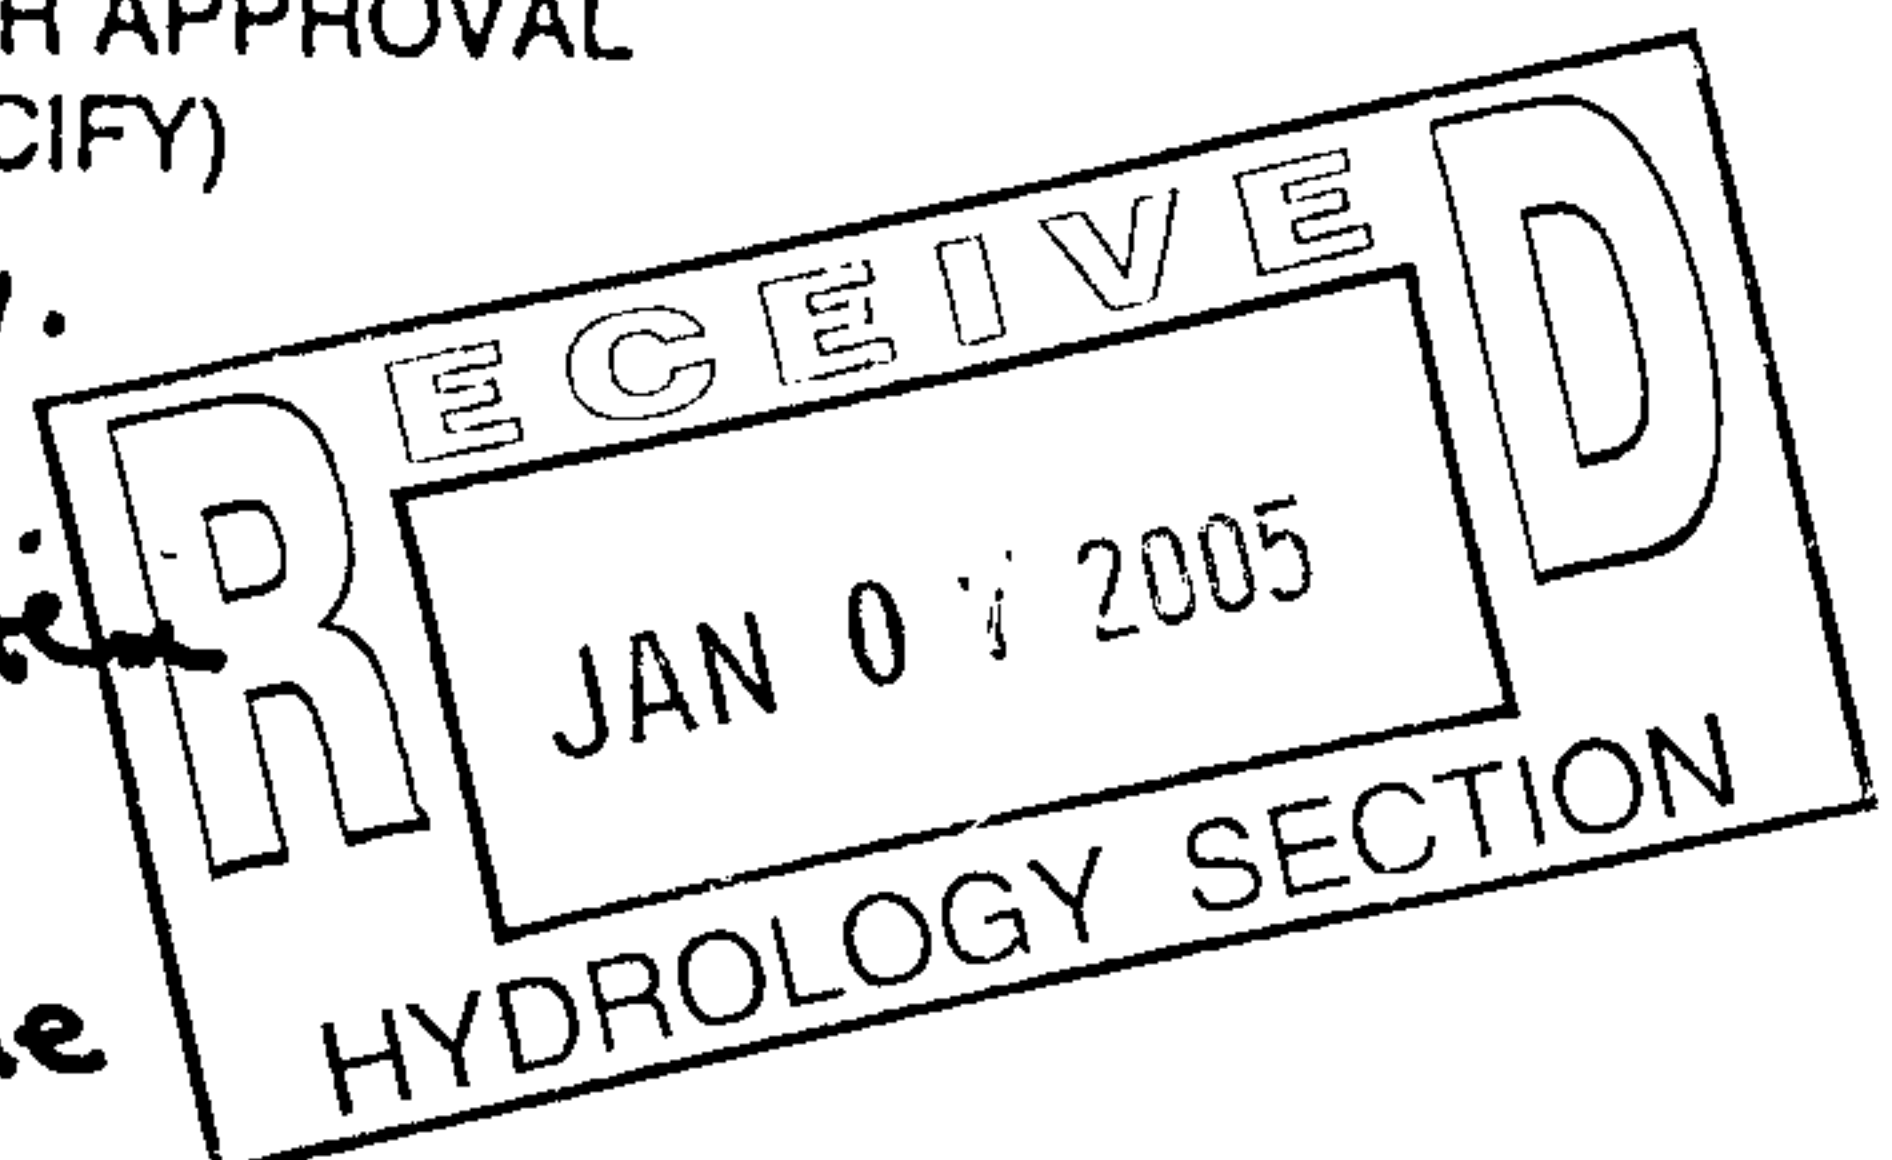

DATE SUBMITTED: 01-07-05 BY: GEORGE T. RODRIGUEZ

Requests for approvals of Site Development Plans and/or Subdivision Plats shall be accompanied by a drainage submittal. The particular nature, location and scope of the proposed development defines the degree of drainage detail. One or more of the following levels of submittal may be required based on the following:

1. **Conceptual Grading and Drainage Plan:** Required for approval of Site Development Plans greater than five (5) acres and Sector Plans.
2. **Drainage Plans:** Required for building permits, grading permits, paving permits and site plans less than five (5) acres.
3. **Drainage Report:** Required for subdivisions containing more than ten (10) lots or constituting five (5) acres or more.

**Plan Submittal Date: 08-23-04**

I, LEVI J. VALDEZ, NMPE 5693, OF THE FIRM  
, HEREBY CERTIFY THAT THIS PROJECT HAS IS IN  
SUBSTANTIAL COMPLIANCE WITH AND IN ACCORDANCE WITH THE  
DESIGN INTENT OF THE APPROVED PLAN DATED 08-23-04. THE  
RECORD INFORMATION EDITED ONTO THE ORIGINAL DESIGN DOCUMENT  
HAS BEEN OBTAINED BY FRED J. ARAGON OF THE FIRM  
FJA DESIGN GROUP, I FURTHER CERTIFY THAT I HAVE PERSONALLY  
VISITED THE PROJECT SITE ON 01-05-05 AND HAVE DETERMINED  
BY VISUAL INSPECTION THAT THE SURVEY DATA PROVIDED IS  
REPRESENTATIVE OF ACTUAL SITE CONDITIONS AND IS TRUE AND  
CORRECT TO THE BEST OF MY KNOWLEDGE AND BELIEF. THIS  
CERTIFICATION IS SUBMITTED IN SUPPORT OF A REQUEST FOR  
PERMANENT CERTIFICATE OF OCCUPANCY.

THE RECORD INFORMATION PRESENTED HEREON IS NOT NECESSARILY COMPLETE AND INTENDED ONLY TO VERIFY SUBSTANTIAL COMPLIANCE OF THE TRAFFIC LAYOUT ASPECTS OF THIS PROJECT. THOSE RELYING ON THE RECORD DOCUMENT ARE ADVISED TO OBTAIN INDEPENDENT VERIFICATION OF ITS ACCURACY BEFORE USING IT FOR ANY OTHER PURPOSE.

*Levi J. Valdez*  
Signature of Engineer

01-07-05

Date \_\_\_\_\_

ENGINEER'S STAMP

