HYDROLOGY K23/D15 2 PLANS

K23/D15

2 Plans

CITY OF ALBUQUERQUE

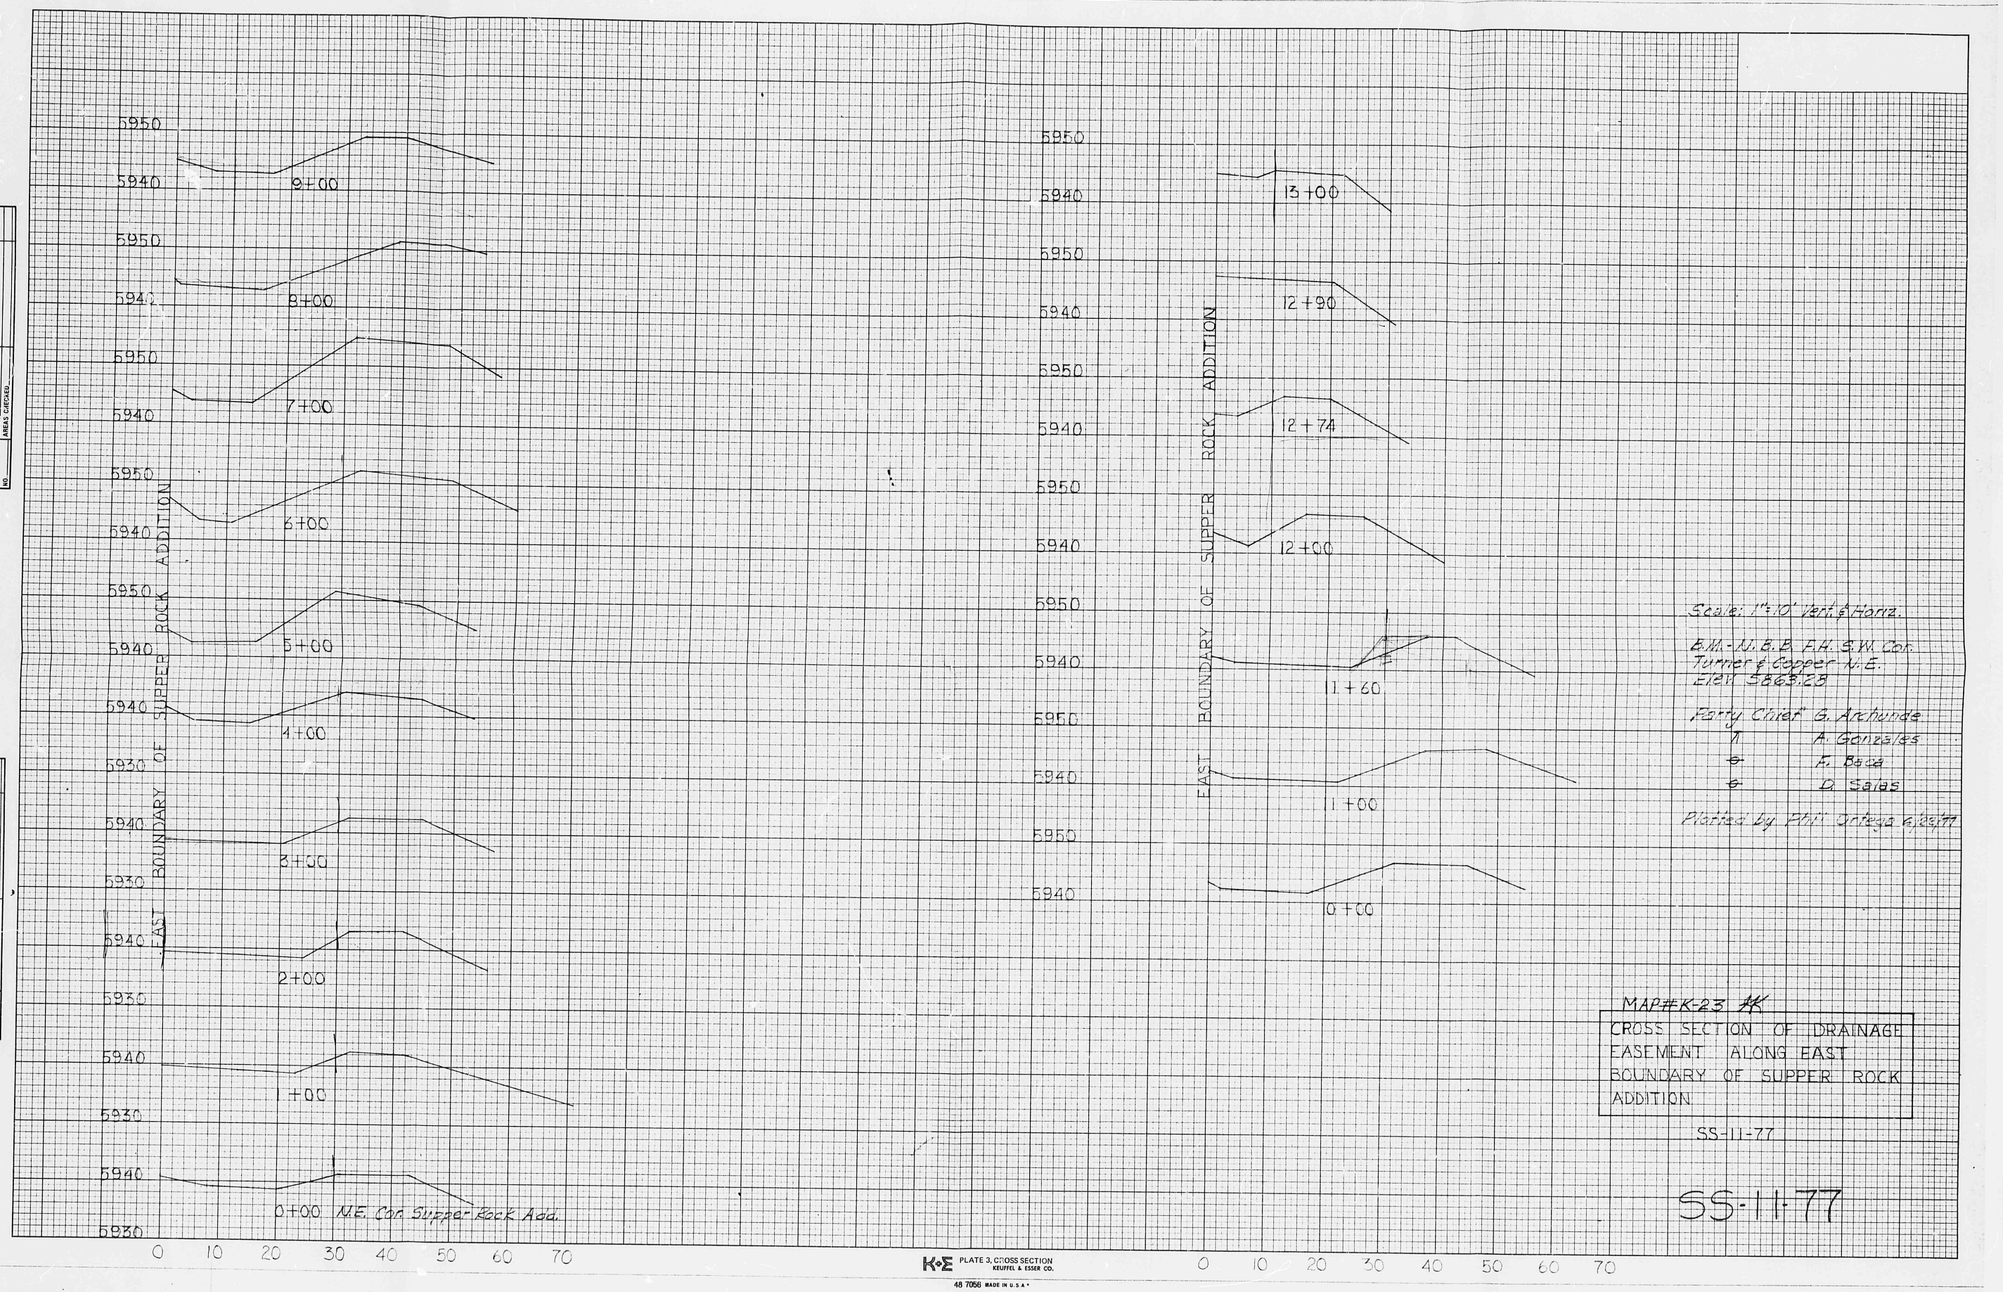

Scale: 1"=10' Vert & Horiz.

B.M.-N.G.B. F.H. S.W. Cor. Turner & Copper N.E. Elev 5863.23

Party Chief G. Archunde
A. Gonzales
A. Baca
D. Salas

Plotted by PFC Ortega 6.29.77

MAP#K-23 AK

CROSS SECTION OF DRAINAGE EASEMENT ALONG EAST BOUNDARY OF SUPPER ROCK ADDITION

SS-11-77

SS-11-77

FINAL SURVEY
NOTE BOOK
NO.
SURVEYED
PLOTTED
TEMPLATE
AREAS
AREAS CHECKED
BY
DATE

ORIGINAL SURVEY
NOTE BOOK
NO.
SURVEYED
PLOTTED
TEMPLATE
AREAS
AREAS CHECKED
BY
DATE

K+E PLATE 3, CROSS SECTION KEUFFEL & ESSER CO.
48 7056 MADE IN U.S.A.

CITY OF ALBUQUERQUE
THIS MICROIMAGE IS THE BEST POSSIBLE REPRODUCTION DUE TO THE POOR QUALITY OF THE ORIGINAL DOCUMENT

D 24 C 20 B 16 A 12 CITY OF ALBUQUERQUE C D

McINTIRE & QUIROS SOUTHWEST

B.M.

Scale: 1" = 50'

UNPLATTED

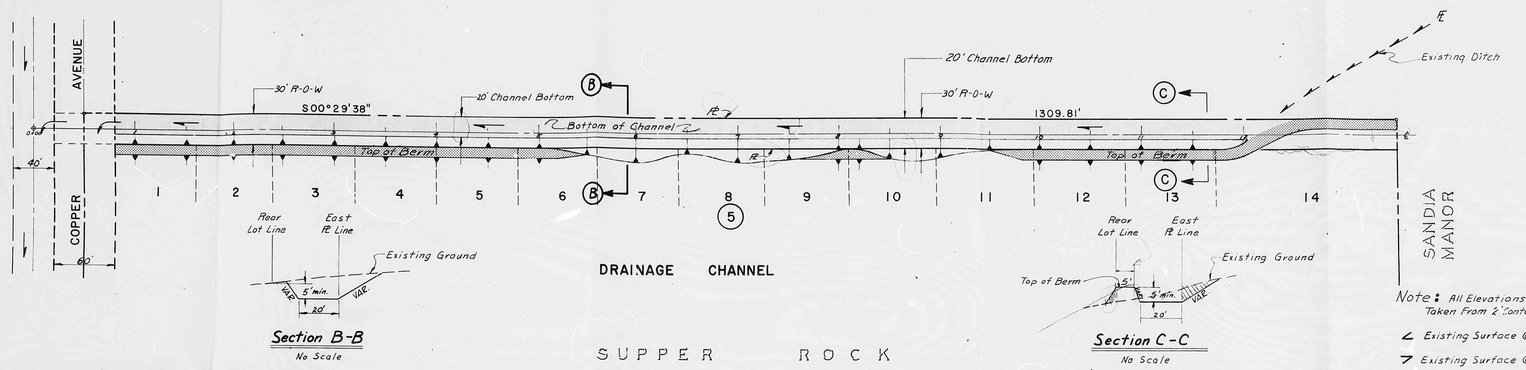

Section B-B
No Scale

Section C-C
No Scale

Note: All Elevations Shown Have Been Taken From 2' Contour Interval Topo.

∠ Existing Surface @ East ℄

7 Existing Surface @ Rear Lot Lines

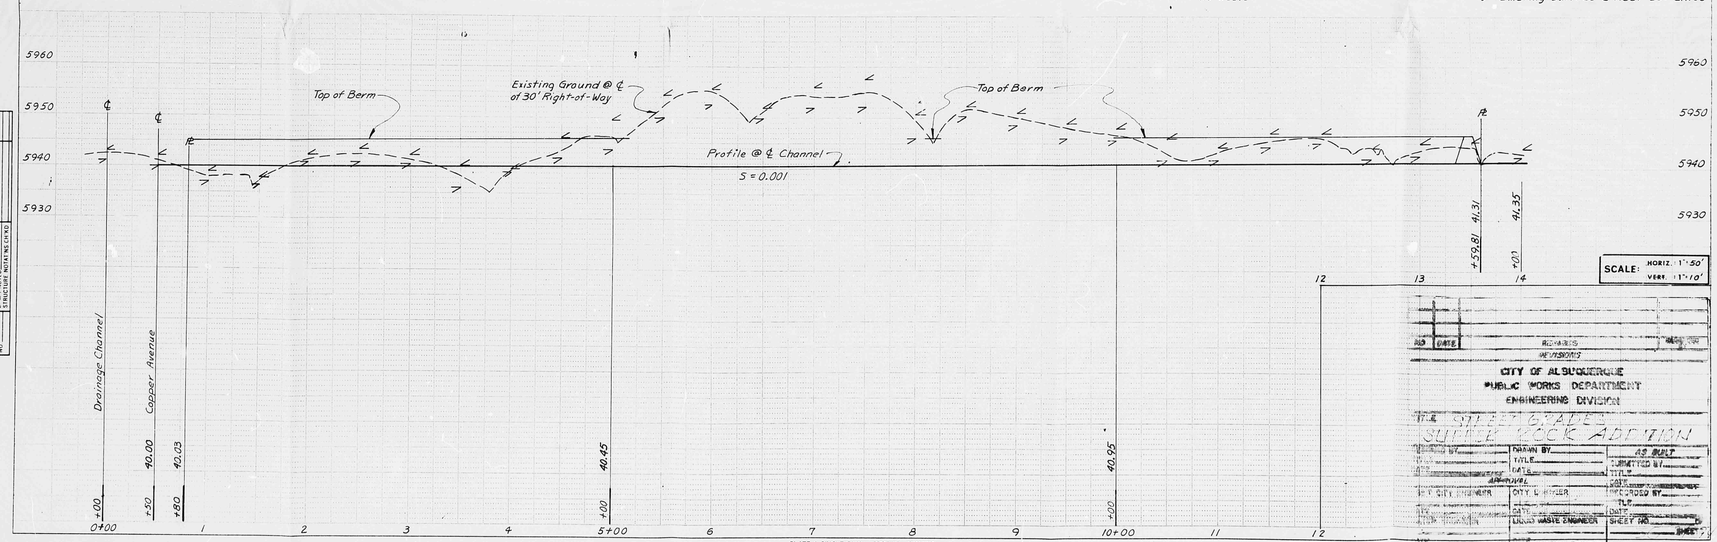

SCALE: HORIZ. 1" = 50'
VERT. 1" = 10'

NO	DATE	REVISIONS	BY

REVISIONS

CITY OF ALBUQUERQUE
PUBLIC WORKS DEPARTMENT
ENGINEERING DIVISION

TITLE: STREET GRADES
SUPPER ROCK ADDITION

DRAWN BY		AS BUILT
TITLE		SUBMITTED BY
DATE		TITLE
APPROVAL		DATE
CITY ENGINEER	CITY ENGINEER	RECORDED BY
DATE		TITLE
		SHEET NO.

DRAWING: 5-21-74 JAK Sheet ___ of ___

PLAN: SUBMITTED ___ DATE ___ CHECKED ___ DATE ___ SUPERVISED ___ DATE ___ NOTE BOOK ___ NO. ___ SCALE: HORIZ. 1" = 2' VERT. 1" = 2' BY CHARLES BRUNING CO. CHICAGO

PROFILE: SUBMITTED ___ DATE ___ CHECKED ___ DATE ___ SUPERVISED ___ DATE ___ NOTE BOOK ___ NO. ___ SCALE: HORIZ. 1" = 50' VERT. 1" = 10' BY CHARLES BRUNING CO. CHICAGO

PLATE 1 SINGLE PLAN - PROFILE - DOTTED
CHARLES BRUNING COMPANY
MADE IN U.S.A.

8T-6-0002

CITY OF ALBUQUERQUE
THIS MICROIMAGE IS THE BEST POSSIBLE REPRODUCTION DUE TO THE POOR QUALITY OF THE ORIGINAL DOCUMENT

D 24 C 20 B 16 A 12 | CITY OF ALBUQUERQUE C D