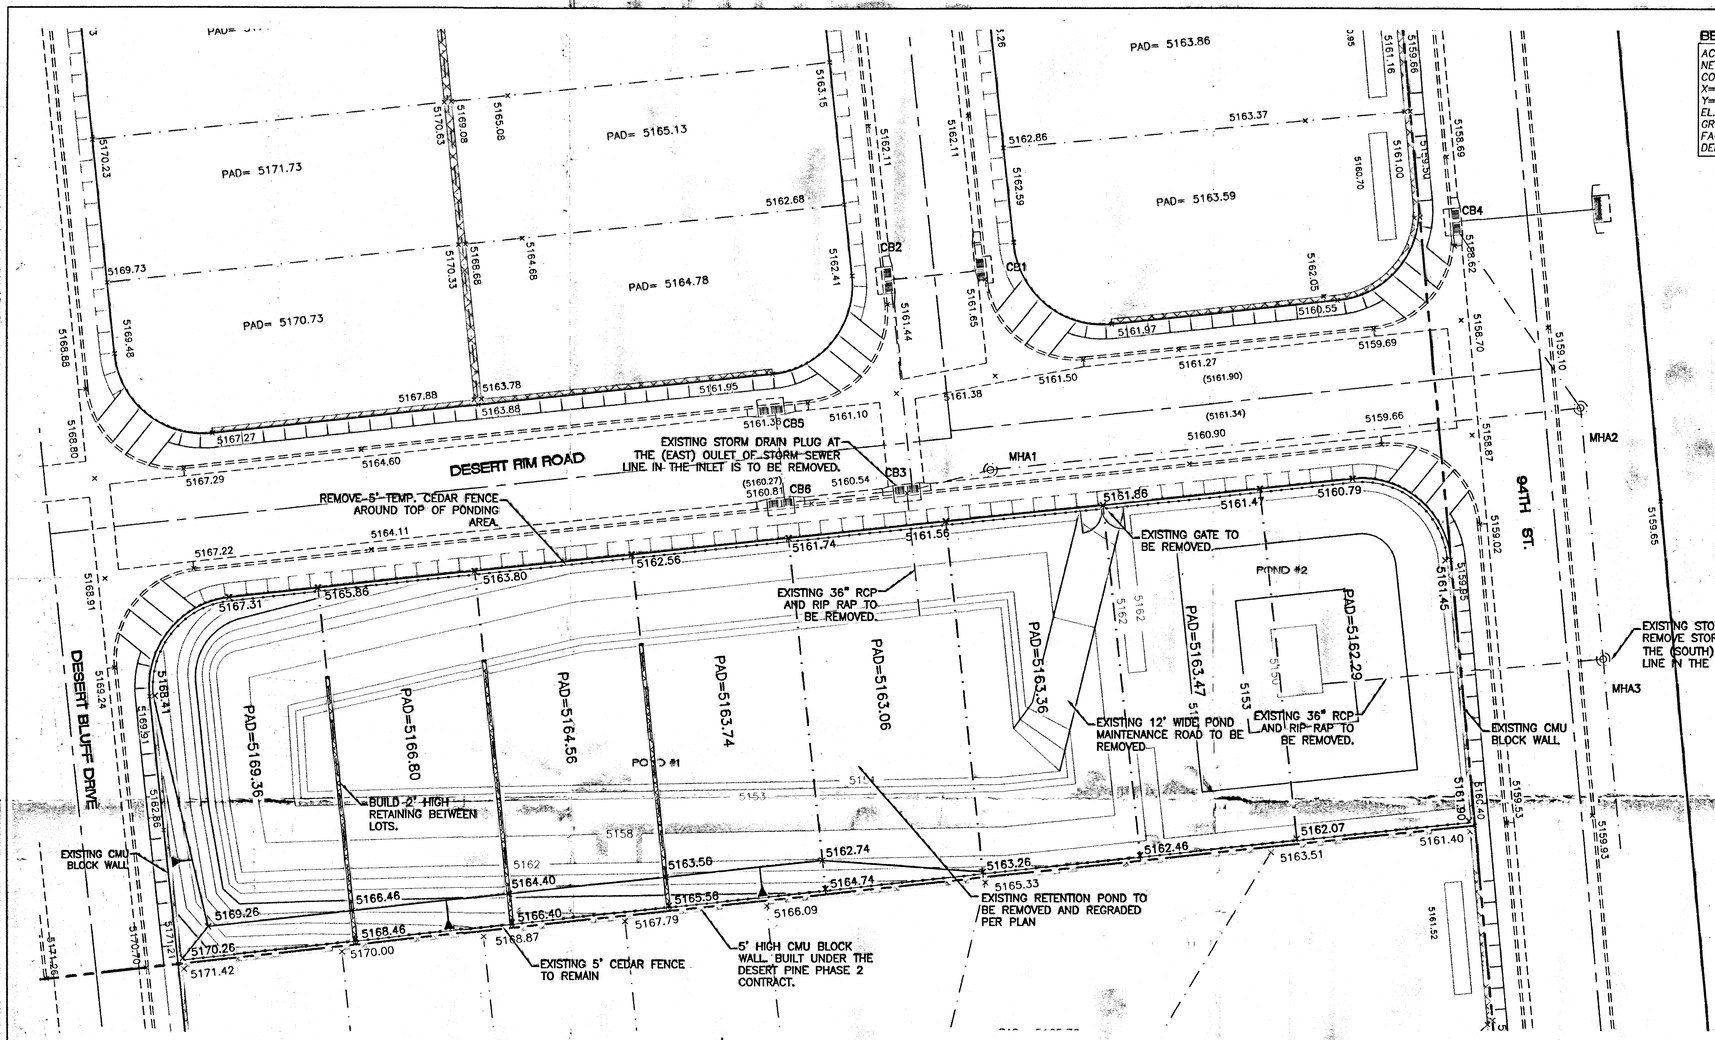

BENCHMARK

ACS MONUMENT "7-L9"
NEW MEXICO STATE PLANE
COORDINATES (CENTRAL ZONE)
X=352,978.14
Y=1,478,346.71
EL.=5175.735
GRID TO GROUND SCALE
FACTOR=0.99967727
DELTA ALPHA ANGLE=-00°16'56"

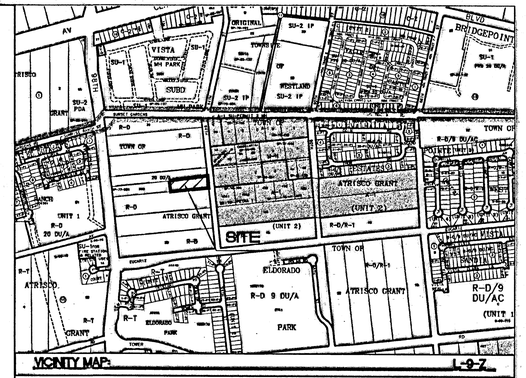

VICINITY MAP: L-9-Z

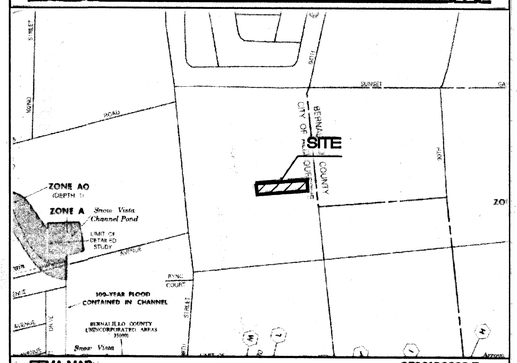

FEMA MAP: 35001C0328 D

LEGAL DESCRIPTION:

Proposed Desert Pine Subdivision, Comprising of Lot 36-A and all of Lots 37, 38 and 39, Unit 2

NOTES:

1. ALL SPOT ELEVATIONS REPRESENT THE FLOWLINE ELEVATION UNLESS OTHERWISE NOTED.

NOTICE TO CONTRACTORS

1. AN EXCAVATION/CONSTRUCTION PERMIT WILL BE REQUIRED BEFORE BEGINNING ANY WORK WITHIN CITY RIGHT-OF-WAY.
2. ALL WORK DETAILED ON THESE PLANS TO BE PERFORMED, EXCEPT AS OTHERWISE STATED OR PROVIDED HERON, SHALL BE CONSTRUCTED IN ACCORDANCE WITH CITY OF ALBUQUERQUE INTERIM STANDARD SPECIFICATIONS FOR PUBLIC WORKS CONSTRUCTION, 1985.
3. TWO WORKING DAYS PRIOR TO ANY EXCAVATION, CONTRACTOR MUST CONTACT LINE LOCATING SERVICE, 765-1234, FOR LOCATION OF EXISTING UTILITIES.
4. PRIOR TO CONSTRUCTION, THE CONTRACTOR SHALL EXCAVATE AND VERIFY THE HORIZONTAL AND VERTICAL LOCATIONS OF ALL CONSTRUCTIONS. SHOULD A CONFLICT EXIST, THE CONTRACTOR SHALL NOTIFY THE ENGINEER SO THAT THE CONFLICT CAN BE RESOLVED WITH A MINIMUM AMOUNT OF DELAY.
5. BACKFILL COMPACTION SHALL BE ACCORDING TO TRAFFIC/STREET USE.
6. MAINTENANCE OF THESE FACILITIES SHALL BE THE RESPONSIBILITY OF THE OWNER OF THE PROPERTY SERVED.
7. WORK ON ARTERIAL STREETS SHALL BE PERFORMED ON A 24-HOUR BASIS.

APPROVAL	NAME	DATE
INSPECTOR		

RECEIVED JUN 18 2002 HYDROLOGY SECTION

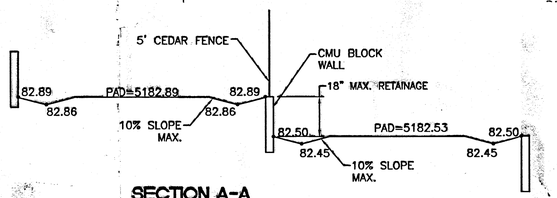

SECTION A-A
TYPICAL SIDE YARD GRADING
NTS

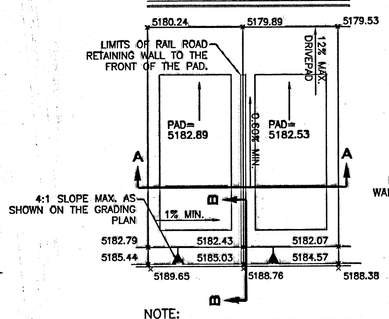

NOTE:
SPOT ELEVATION ON THIS DETAIL IS REPRESENTATIVE ONLY. SEE PLAN FOR EXACT ELEVATIONS

TYPICAL LOT GRADING
NTS

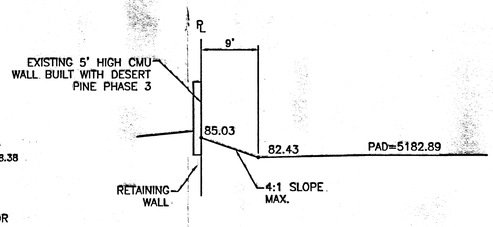

SECTION B-B
NTS

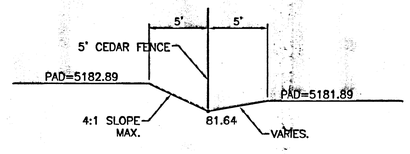

(OPTIONAL) SECTION A-A
TYPICAL SIDE YARD GRADING
NTS

EROSION CONTROL PLAN, NPDES PERMIT AND POLLUTION PREVENTION NOTES

1. CONTRACTOR IS RESPONSIBLE FOR OBTAINING A TOPSOIL DISTURBANCE PERMIT PRIOR TO BEGINNING WORK.
2. CONTRACTOR IS RESPONSIBLE FOR CLEANING ALL SEDIMENT OUT OF EXISTING RIGHT-OF-WAY.
3. CONTRACTOR IS RESPONSIBLE FOR MAINTAINING ALL STORM RUN OFF ON SITE.
4. REPAIR OF DAMAGED FACILITIES AND CLEAN-UP OF SEDIMENT ACCUMULATION ON ADJACENT PROPERTIES AND IN PUBLIC FACILITIES IS THE RESPONSIBILITY OF THE CONTRACTOR.
5. ALL EXPOSED EARTH SURFACES MUST BE PROTECTED FROM WIND AND WATER EROSION PRIOR TO FINAL ACCEPTANCE OF ANY PROJECT.
6. CONTRACTOR IS RESPONSIBLE FOR OBTAINING NPDES PERMIT FOR THE SITE

LEGEND

- EXISTING STORM SEWER LINE
- EXISTING CURB & GUTTER
- BOUNDARY LINE
- EASEMENT
- PROPOSED SIDEWALK
- SIDEWALKS TO BE DEFERRED
- EXISTING RETAINING WALL (RW)
- EXISTING SCREEN WALL

N

GRAPHIC SCALE
20 10 0 10 20
SCALE: 1"=20'

ROUGH GRADING APPROVAL DATE

ENGINEER'S SEAL

RONALD R. BOHANNAN P.E. #7868

DESERT PINE SUBDIVISION

GRADING AND DRAINAGE PLAN

TIERRA WEST, LLC
8509 JEFFERSON NE
ALBUQUERQUE, NEW MEXICO 87113
(505)858-3100

DRAWN BY	BDG
DATE	6-18-02
	2038GRB.DWG
SHEET #	1
JOB #	200048

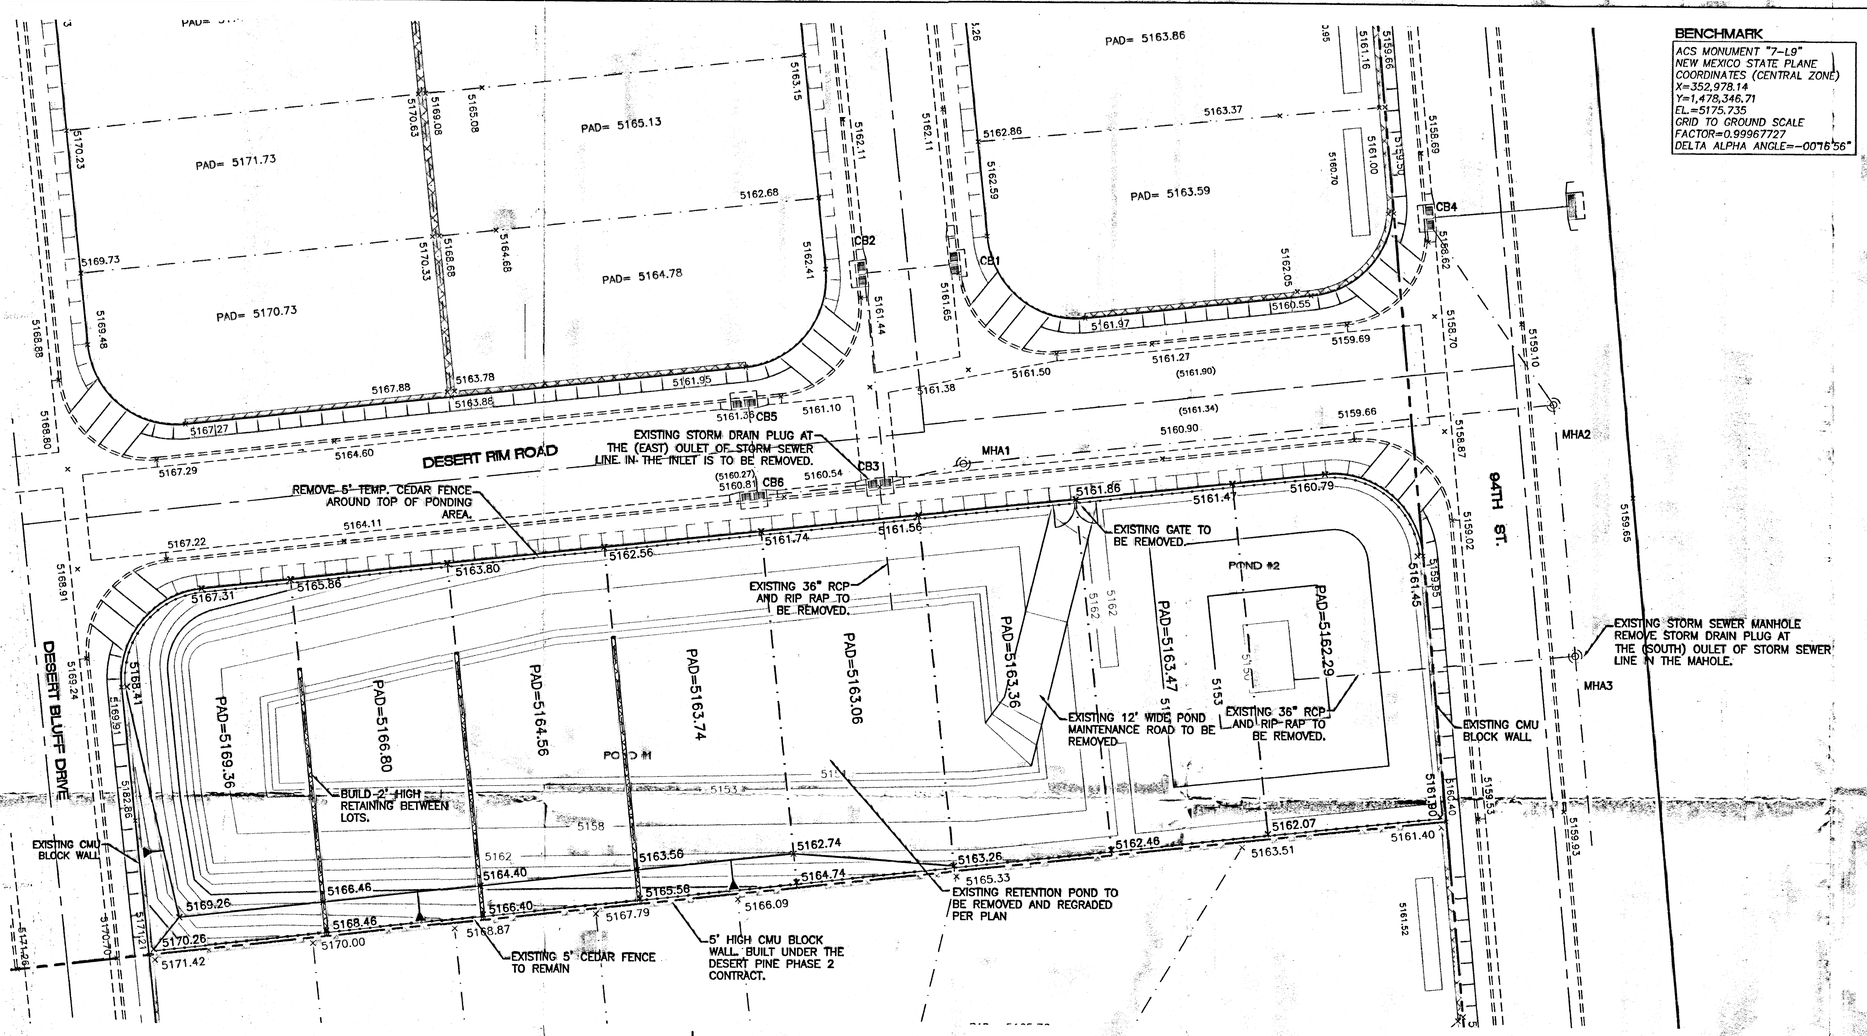

BENCHMARK

ACS MONUMENT "7-L9"
NEW MEXICO STATE PLANE
COORDINATES (CENTRAL ZONE)
X=352,978.14
Y=1,478,346.71
EL.=5175.735
GRID TO GROUND SCALE
FACTOR=0.99967727
DELTA ALPHA ANGLE=-0°16'56"

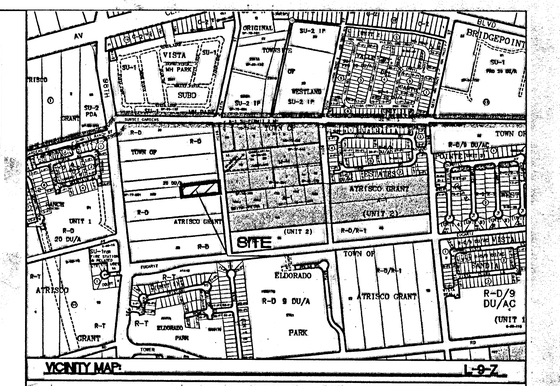

VICINITY MAP: L-9-Z

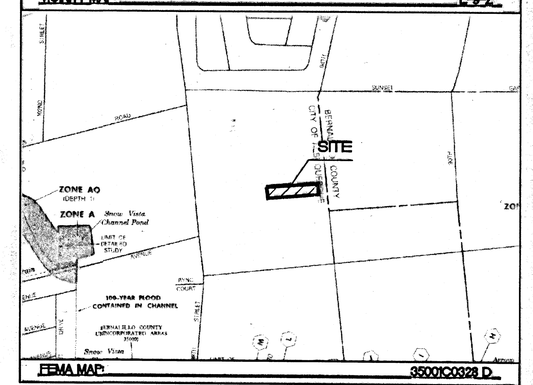

FEMA MAP: 35001C0328 D

LEGAL DESCRIPTION:

Proposed Desert Pine Subdivision, Comprising of Lot 36-A and all of Lots 37, 38 and 39, Unit 2

NOTES:

1. ALL SPOT ELEVATIONS REPRESENT THE FLOWLINE ELEVATION UNLESS OTHERWISE NOTED.

NOTICE TO CONTRACTORS

1. AN EXCAVATION/CONSTRUCTION PERMIT WILL BE REQUIRED BEFORE BEGINNING ANY WORK WITHIN CITY RIGHT-OF-WAY.
2. ALL WORK DETAILED ON THESE PLANS TO BE PERFORMED, EXCEPT AS OTHERWISE STATED OR PROVIDED HERON, SHALL BE CONSTRUCTED IN ACCORDANCE WITH CITY OF ALBUQUERQUE INTERIM STANDARD SPECIFICATIONS FOR PUBLIC WORKS CONSTRUCTION, 1985.
3. TWO WORKING DAYS PRIOR TO ANY EXCAVATION, CONTRACTOR MUST CONTACT LINE LOCATING SERVICE, 765-1234, FOR LOCATION OF EXISTING UTILITIES.
4. PRIOR TO CONSTRUCTION, THE CONTRACTOR SHALL EXCAVATE AND VERIFY THE HORIZONTAL AND VERTICAL LOCATIONS OF ALL CONSTRUCTIONS. SHOULD A CONFLICT EXIST, THE CONTRACTOR SHALL NOTIFY THE ENGINEER SO THAT THE CONFLICT CAN BE RESOLVED WITH A MINIMUM AMOUNT OF DELAY.
5. BACKFILL COMPACTION SHALL BE ACCORDING TO TRAFFIC/STREET USE.
6. MAINTENANCE OF THESE FACILITIES SHALL BE THE RESPONSIBILITY OF THE OWNER OF THE PROPERTY SERVED.
7. WORK ON ARTERIAL STREETS SHALL BE PERFORMED ON A 24-HOUR BASIS.

APPROVAL	NAME	DATE
INSPECTOR		

RECEIVED JUN 18 2002 HYDROLOGY SECTION

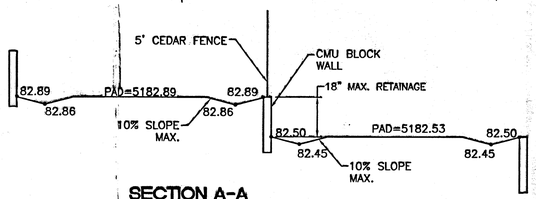

SECTION A-A
TYPICAL SIDE YARD GRADING
NTS

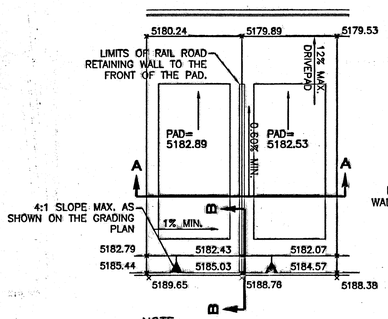

NOTE:
SPOT ELEVATION ON THIS DETAIL IS REPRESENTATIVE ONLY. SEE PLAN FOR EXACT ELEVATIONS

TYPICAL LOT GRADING
NTS

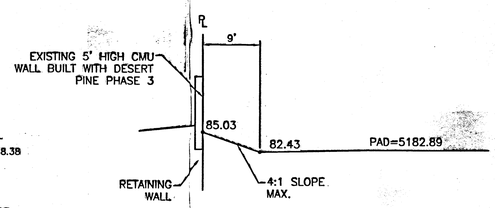

SECTION B-B
NTS

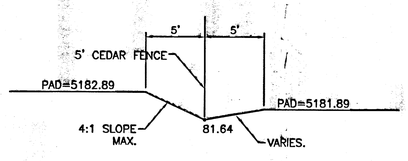

(OPTIONAL) SECTION A-A
TYPICAL SIDE YARD GRADING
NTS

EROSION CONTROL PLAN, NPDES PERMIT AND POLLUTION PREVENTION NOTES

1. CONTRACTOR IS RESPONSIBLE FOR OBTAINING A TOPSOIL DISTURBANCE PERMIT PRIOR TO BEGINNING WORK.
2. CONTRACTOR IS RESPONSIBLE FOR CLEANING ALL SEDIMENT OUT OF EXISTING RIGHT-OF-WAY.
3. CONTRACTOR IS RESPONSIBLE FOR MAINTAINING ALL STORM RUN OFF ON SITE.
4. REPAIR OF DAMAGED FACILITIES AND CLEAN-UP OF SEDIMENT ACCUMULATION ON ADJACENT PROPERTIES AND IN PUBLIC FACILITIES IS THE RESPONSIBILITY OF THE CONTRACTOR.
5. ALL EXPOSED EARTH SURFACES MUST BE PROTECTED FROM WIND AND WATER EROSION PRIOR TO FINAL ACCEPTANCE OF ANY PROJECT.
6. CONTRACTOR IS RESPONSIBLE FOR OBTAINING NPDES PERMIT FOR THE SITE

LEGEND

- EXISTING STORM SEWER LINE
- EXISTING CURB & GUTTER
- BOUNDARY LINE
- EASEMENT
- PROPOSED SIDEWALK
- SIDEWALKS TO BE DEFERRED
- EXISTING RETAINING WALL (RW)
- EXISTING SCREEN WALL

N

GRAPHIC SCALE
20 10 0 10 20
SCALE: 1"=20'

ROUGH GRADING APPROVAL DATE

ENGINEER'S SEAL
RONALD R. BOHANNAN NEW MEXICO 7868 PROFESSIONAL ENGINEER

RONALD R. BOHANNAN
P.E. #7868

DESERT PINE SUBDIVISION
GRADING AND DRAINAGE PLAN

TIERRA WEST, LLC
8509 JEFFERSON NE
ALBUQUERQUE, NEW MEXICO 87113
(505)858-3100

DRAWN BY BDG
DATE 6-18-02
2038GRB.DWG
SHEET # 1
JOB # 200048

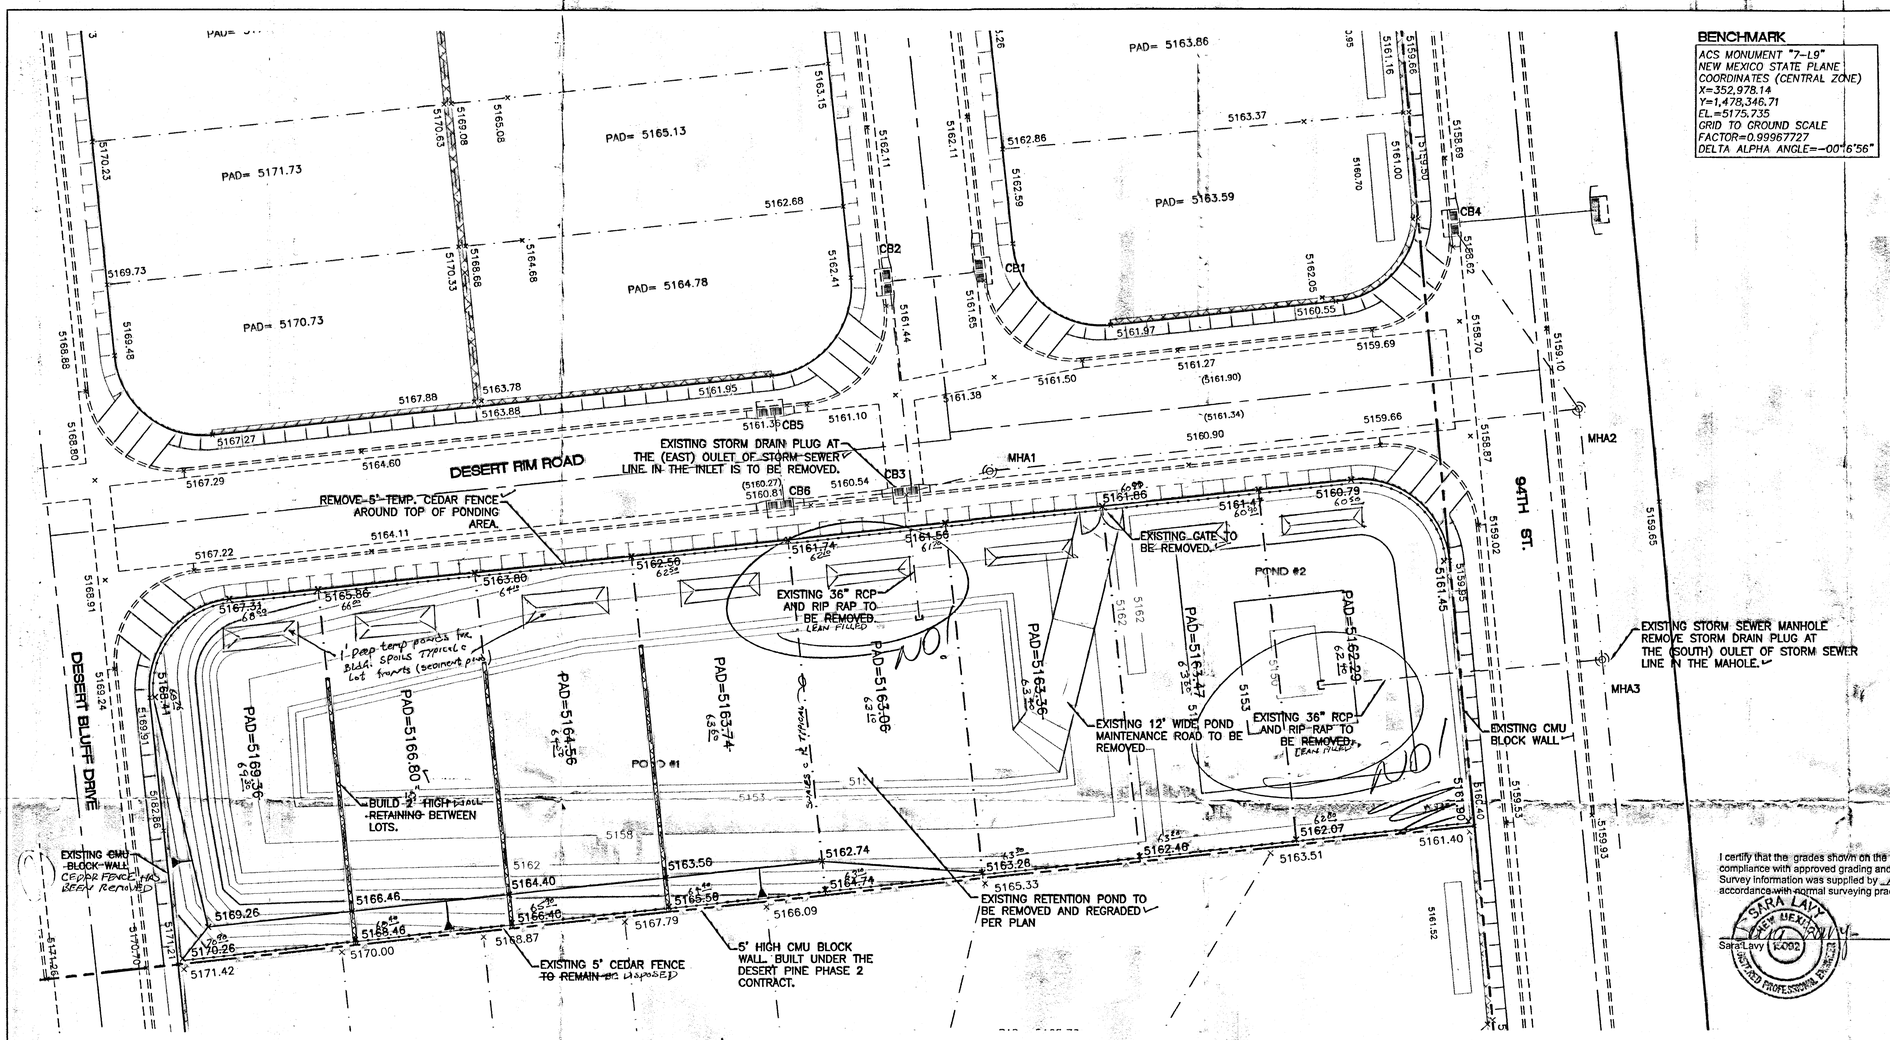

BENCHMARK

ACS MONUMENT "7-L9"
NEW MEXICO STATE PLANE
COORDINATES (CENTRAL ZONE)
X=352,978.14
Y=1,478,346.71
EL.=5175.735
GRID TO GROUND SCALE
FACTOR=0.99967727
DELTA ALPHA ANGLE=-00°16'56"

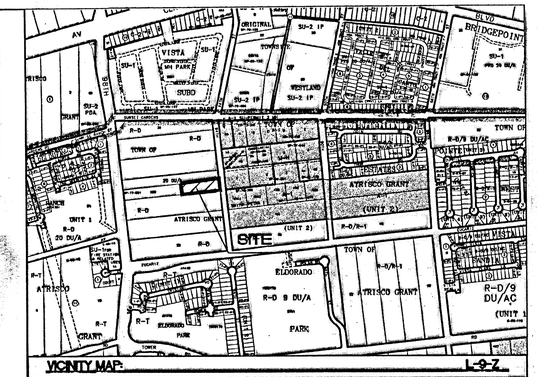

VICINITY MAP: L-9-Z

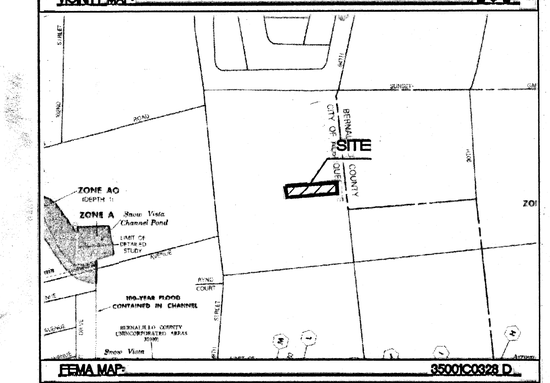

FEMA MAP: 35001C0328 D

LEGAL DESCRIPTION

Proposed Desert Pine Subdivision, Comprising of Lot 36-A and all of Lots 37, 38 and 39, Unit 2

NOTES:

1. ALL SPOT ELEVATIONS REPRESENT THE FLOWLINE ELEVATION UNLESS OTHERWISE NOTED.

I certify that the grades shown on the plans have been built in substantial compliance with approved grading and drainage plan dated 6/19/02. Survey information was supplied by BURGETT LAND SURVEYS in accordance with normal surveying practices.

SARA LAVY NEW MEXICO 15092 REGISTERED PROFESSIONAL ENGINEER

Sara Lavy #15092 6/25/02

NOTICE TO CONTRACTORS

1. AN EXCAVATION/CONSTRUCTION PERMIT WILL BE REQUIRED BEFORE BEGINNING ANY WORK WITHIN CITY RIGHT-OF-WAY.
2. ALL WORK DETAILED ON THESE PLANS TO BE PERFORMED, EXCEPT AS OTHERWISE STATED OR PROVIDED HERON, SHALL BE CONSTRUCTED IN ACCORDANCE WITH CITY OF ALBUQUERQUE INTERIM STANDARD SPECIFICATIONS FOR PUBLIC WORKS CONSTRUCTION, 1985.
3. TWO WORKING DAYS PRIOR TO ANY EXCAVATION, CONTRACTOR MUST CONTACT LINE LOCATING SERVICE, 765-1234, FOR LOCATION OF EXISTING UTILITIES.
4. PRIOR TO CONSTRUCTION, THE CONTRACTOR SHALL EXCAVATE AND VERIFY THE HORIZONTAL AND VERTICAL LOCATIONS OF ALL CONSTRUCTIONS. SHOULD A CONFLICT EXIST, THE CONTRACTOR SHALL NOTIFY THE ENGINEER SO THAT THE CONFLICT CAN BE RESOLVED WITH A MINIMUM AMOUNT OF DELAY.
5. BACKFILL COMPACTION SHALL BE ACCORDING TO TRAFFIC/STREET USE.
6. MAINTENANCE OF THESE FACILITIES SHALL BE THE RESPONSIBILITY OF THE OWNER OF THE PROPERTY SERVED.
7. WORK ON ARTERIAL STREETS SHALL BE PERFORMED ON A 24-HOUR BASIS.

APPROVAL	NAME	DATE
INSPECTOR		

RECEIVED JUN 25 2002 HYDROLOGY SECTION

Brad L. Bixler 6/19/02
ROUGH GRADING APPROVAL DATE

EROSION CONTROL PLAN, NPDES PERMIT AND POLLUTION PREVENTION NOTES

1. CONTRACTOR IS RESPONSIBLE FOR OBTAINING A TOPSOIL DISTURBANCE PERMIT PRIOR TO BEGINNING WORK.
2. CONTRACTOR IS RESPONSIBLE FOR CLEANING ALL SEDIMENT OUT OF EXISTING RIGHT-OF-WAY.
3. CONTRACTOR IS RESPONSIBLE FOR MAINTAINING ALL STORM RUN OFF ON SITE.
4. REPAIR OF DAMAGED FACILITIES AND CLEAN-UP OF SEDIMENT ACCUMULATION ON ADJACENT PROPERTIES AND IN PUBLIC FACILITIES IS THE RESPONSIBILITY OF THE CONTRACTOR.
5. ALL EXPOSED EARTH SURFACES MUST BE PROTECTED FROM WIND AND WATER EROSION PRIOR TO FINAL ACCEPTANCE OF ANY PROJECT.
6. CONTRACTOR IS RESPONSIBLE FOR OBTAINING NPDES PERMIT FOR THE SITE

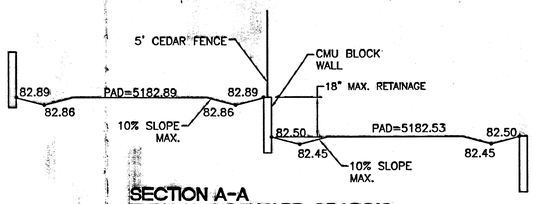

SECTION A-A
TYPICAL SIDE YARD GRADING
NTS

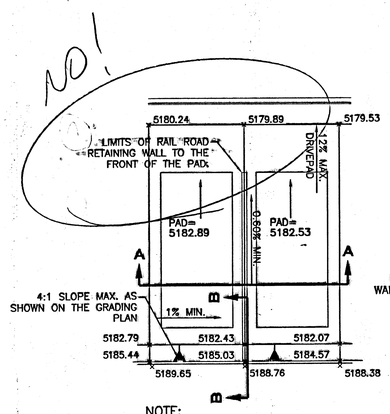

NOTE:
SPOT ELEVATION ON THIS DETAIL IS REPRESENTATIVE ONLY. SEE PLAN FOR EXACT ELEVATIONS

TYPICAL LOT GRADING
NTS

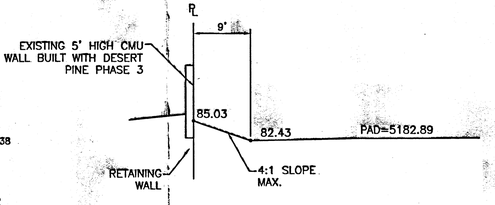

SECTION B-B
NTS

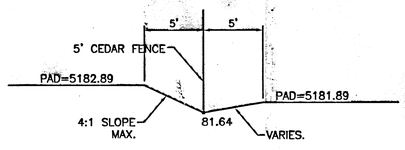

(OPTIONAL) SECTION A-A
TYPICAL SIDE YARD GRADING
NTS

LEGEND

- EXISTING STORM SEWER LINE
- EXISTING CURB & GUTTER
- BOUNDARY LINE
- EASEMENT
- PROPOSED SIDEWALK
- SIDEWALKS TO BE DEFERRED
- EXISTING RETAINING WALL (RW)
- EXISTING SCREEN WALL

N

GRAPHIC SCALE
20 10 0 10 20
SCALE: 1"=20'

ENGINEER'S SEAL RONALD RAY BOHANNAN NEW MEXICO 7868 REGISTERED PROFESSIONAL ENGINEER RONALD R. BOHANNAN P.E. #7868	DESERT PINE SUBDIVISION GRADING AND DRAINAGE PLAN	DRAWN BY BDG DATE 6-18-02 2038GRB.DWG SHEET # 1 JOB # 200048
	TIERRA WEST, LLC 8509 JEFFERSON NE ALBUQUERQUE, NEW MEXICO 87113 (505)858-3100	

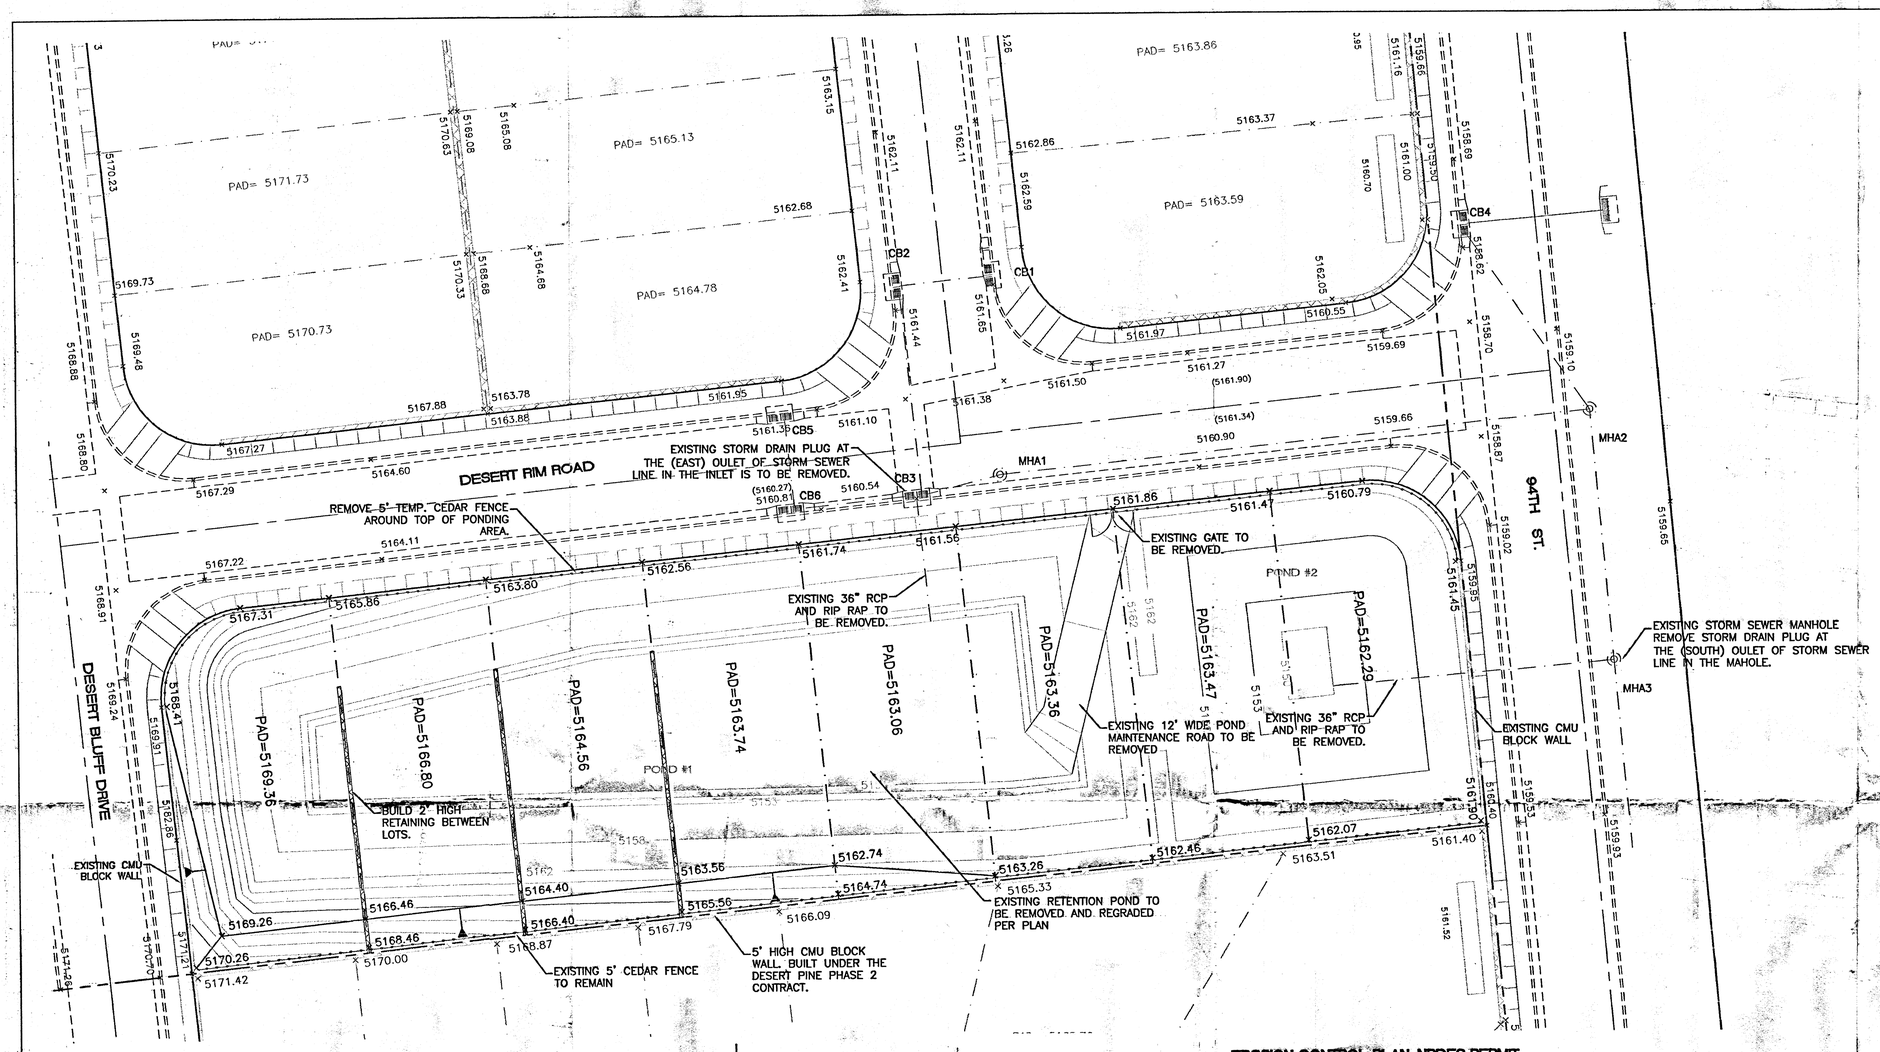

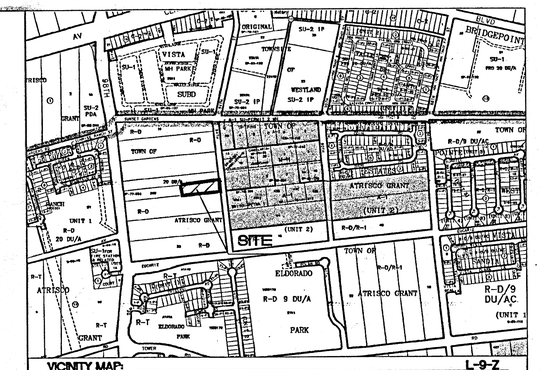

VICINITY MAP: L-9-Z

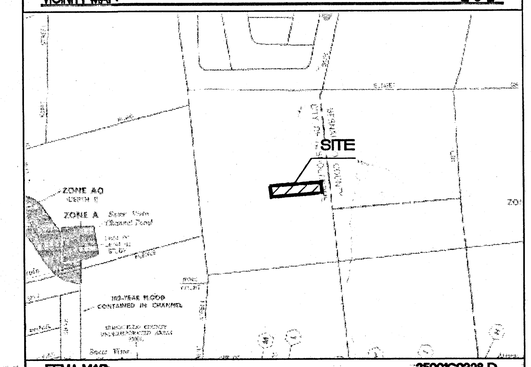

FEMA MAP: 35001C0328 D

LEGAL DESCRIPTION:

Proposed Desert Pine Subdivision, Comprising of Lot 36-A and all of Lots 37, 38 and 39, Unit 2

NOTES:

1. ALL SPOT ELEVATIONS REPRESENT THE FLOWLINE ELEVATION UNLESS OTHERWISE NOTED.

BENCHMARK

ACS MONUMENT "7-L9"
NEW MEXICO STATE PLANE
COORDINATES (CENTRAL ZONE)
X=352,978.14
Y=1,478,346.71
EL.=5175.735
GRID TO GROUND SCALE
FACTOR=0.99967727
DELTA ALPHA ANGLE=-00°16'56"

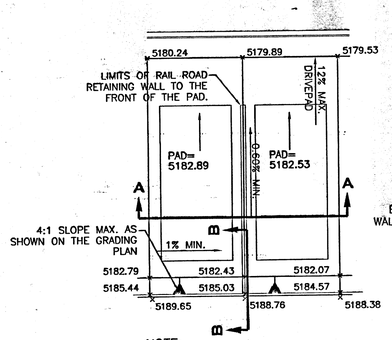

NOTE:
SPOT ELEVATION ON THIS DETAIL IS REPRESENTATIVE ONLY. SEE PLAN FOR EXACT ELEVATIONS

TYPICAL LOT GRADING
NTS

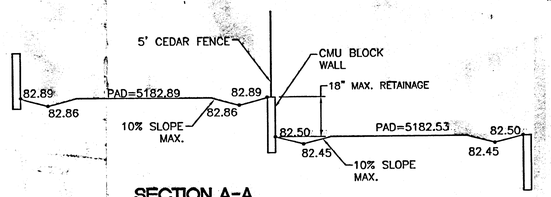

SECTION A-A
TYPICAL SIDE YARD GRADING
NTS

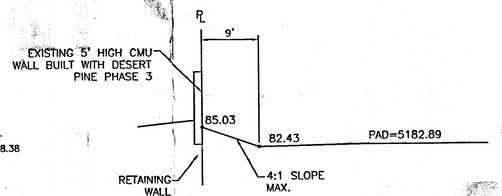

SECTION B-B
NTS

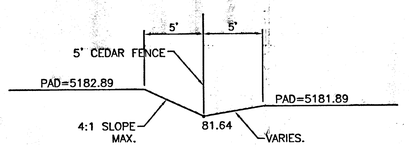

(OPTIONAL) SECTION A-A
TYPICAL SIDE YARD GRADING
NTS

EROSION CONTROL PLAN, NPDES PERMIT AND POLLUTION PREVENTION NOTES

1. CONTRACTOR IS RESPONSIBLE FOR OBTAINING A TOPSOIL DISTURBANCE PERMIT PRIOR TO BEGINNING WORK.
2. CONTRACTOR IS RESPONSIBLE FOR CLEANING ALL SEDIMENT OUT OF EXISTING RIGHT-OF-WAY.
3. CONTRACTOR IS RESPONSIBLE FOR MAINTAINING ALL STORM RUN OFF ON SITE.
4. REPAIR OF DAMAGED FACILITIES AND CLEAN-UP OF SEDIMENT ACCUMULATION ON ADJACENT PROPERTIES AND IN PUBLIC FACILITIES IS THE RESPONSIBILITY OF THE CONTRACTOR.
5. ALL EXPOSED EARTH SURFACES MUST BE PROTECTED FROM WIND AND WATER EROSION PRIOR TO FINAL ACCEPTANCE OF ANY PROJECT.
6. CONTRACTOR IS RESPONSIBLE FOR OBTAINING NPDES PERMIT FOR THE SITE

LEGEND

- EXISTING STORM SEWER LINE
- EXISTING CURB & GUTTER
- BOUNDARY LINE
- EASEMENT
- PROPOSED SIDEWALK
- SIDEWALKS TO BE DEFERRED
- EXISTING RETAINING WALL (RW)
- EXISTING SCREEN WALL

N

GRAPHIC SCALE
20 10 0 10 20
SCALE: 1"=20'

RECEIVED MAY 23 2002 HYDROLOGY SECTION

ROUGH GRADING APPROVAL DATE

ENGINEER'S SEAL RONALD R. BOHANNAN P.E. #7868	DESERT PINE SUBDIVISION GRADING AND DRAINAGE PLAN TIERRA WEST, LLC 8509 JEFFERSON NE ALBUQUERQUE, NEW MEXICO 87113 (505)858-3100	DRAWN BY BDG DATE 05/23/02 2048GRB.DWG SHEET # 1 JOB # 200048

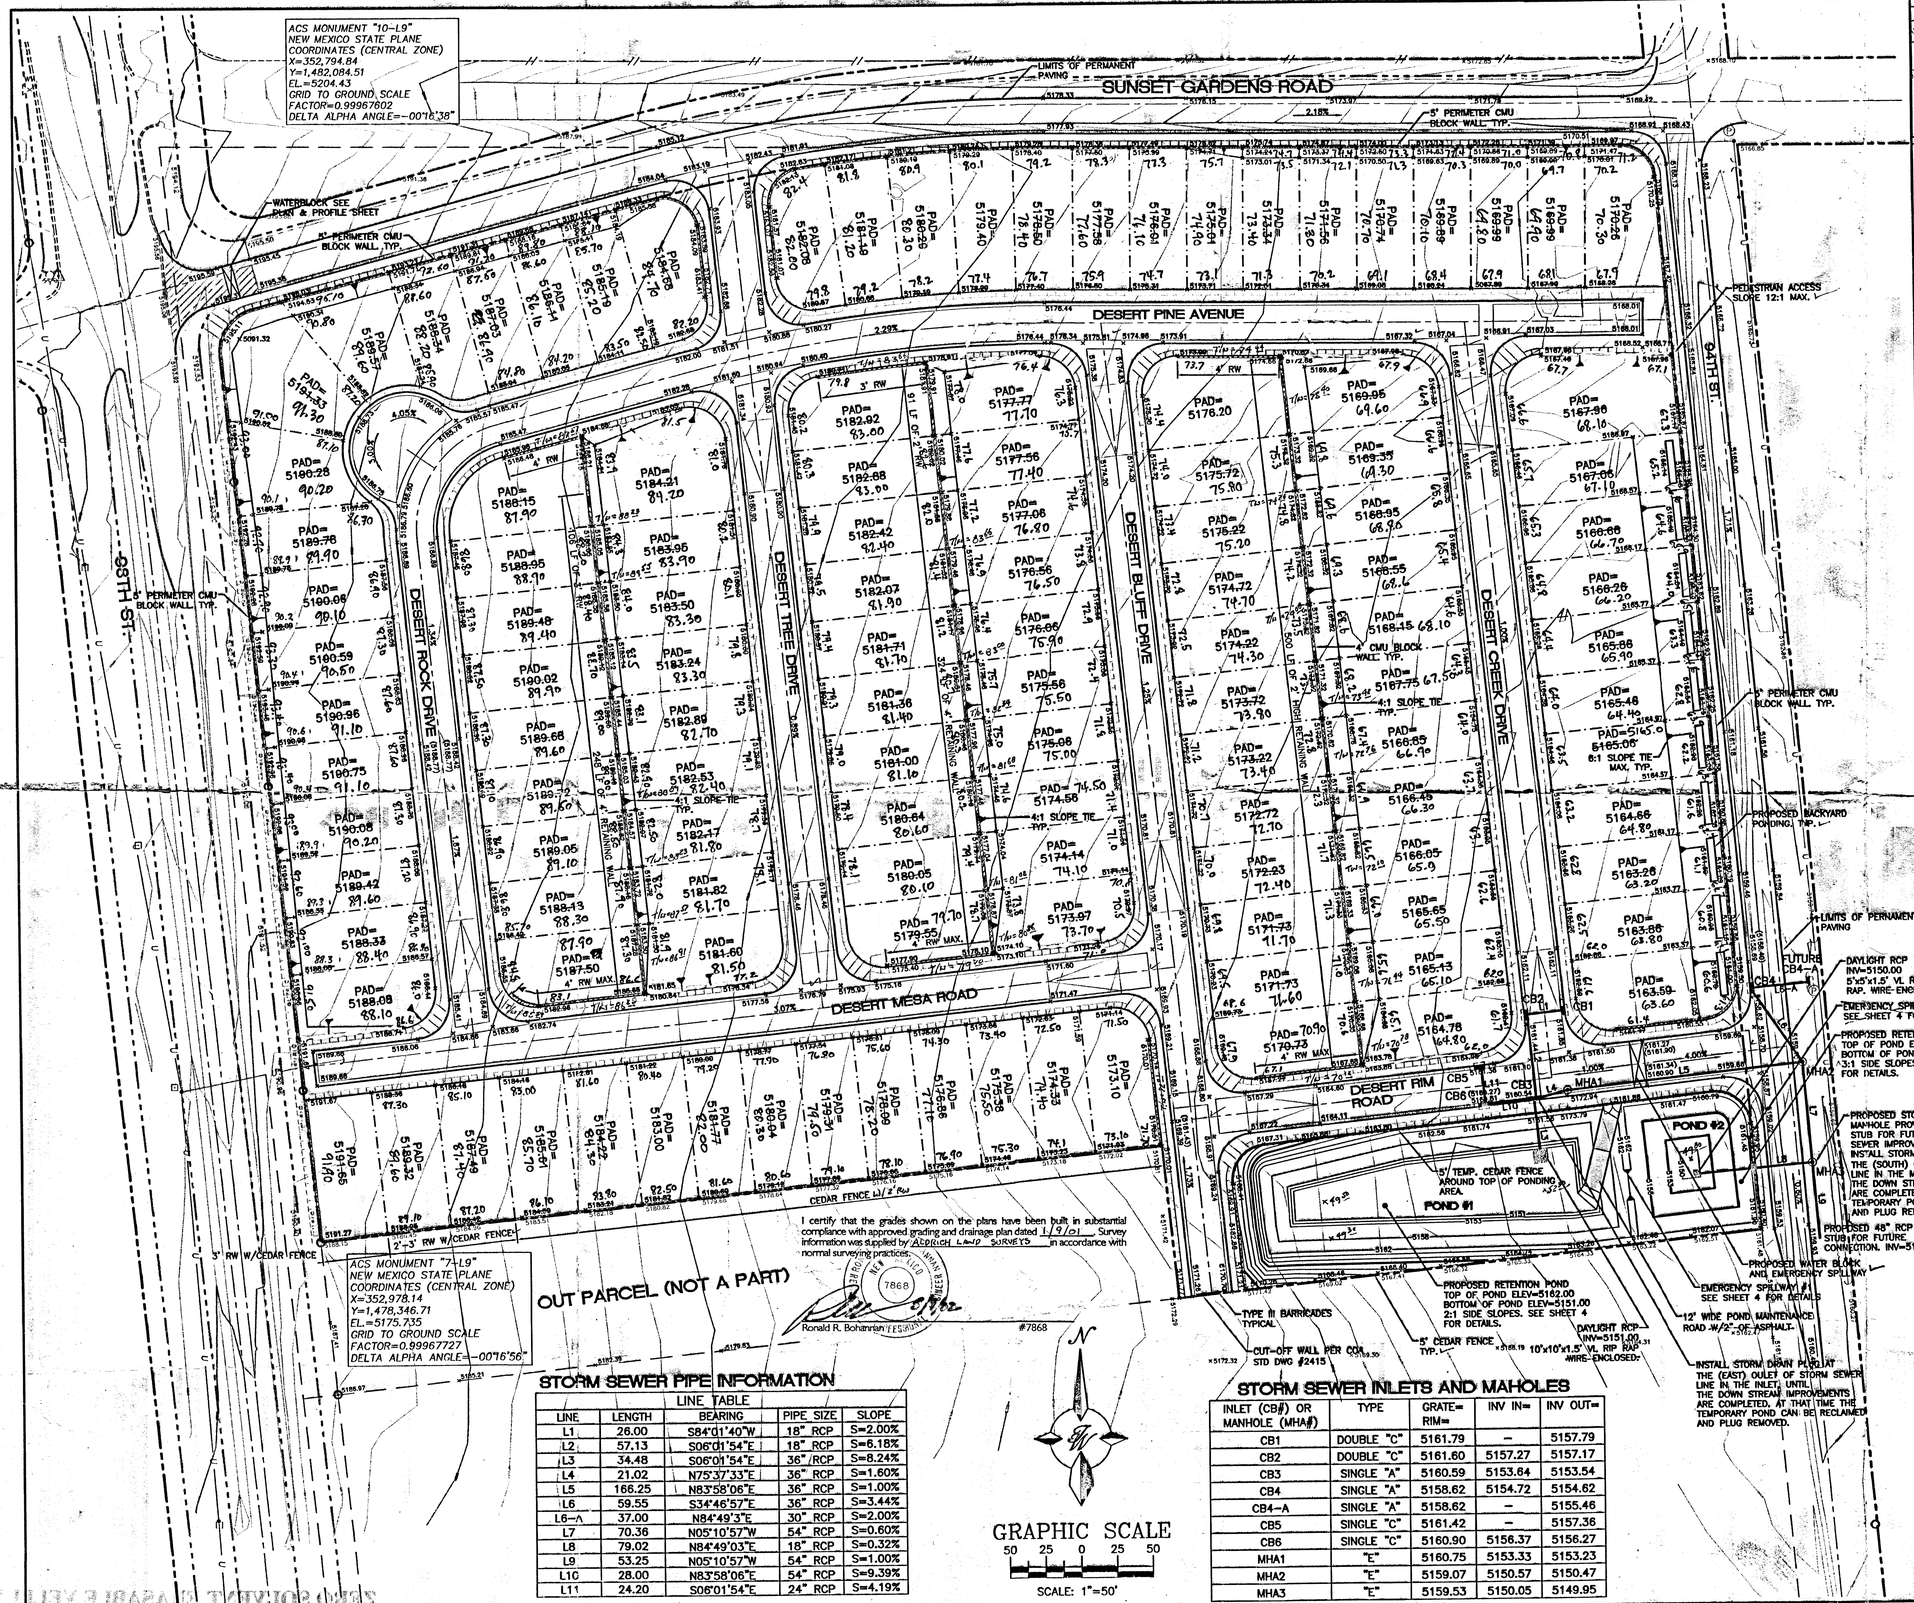

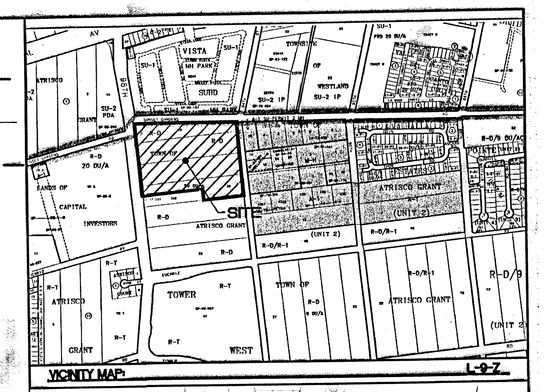

VICINITY MAP: L-9-Z

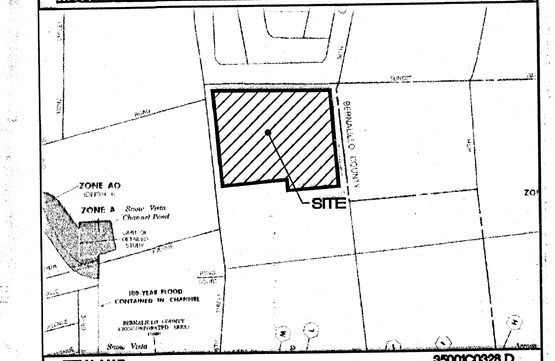

FEMA MAP: 35001C0328 D

LEGAL DESCRIPTION:

Proposed Desert Pine Subdivision, Comprising of Lot 36-A and all of Lots 37, 38 and 39, Unit 2

NOTES:

1. ALL SPOT ELEVATIONS REPRESENT THE FLOWLINE ELEVATION UNLESS OTHERWISE NOTED.
2. SEE SHEET 5 FOR TYPICAL LOT LAYOUT AND GRADING
3. 98th STREET IS PART OF SAD 222 AND WILL BE BUILT BY OTHERS ALONG WITH A 6' WIDE SIDEWALK.
4. LIMITS OF STANDARD CURB AND GUTTER AS SHOWN. VERIFY WITH PLAN AND PROFILE SHEETS.

LEGEND

- EXISTING SANITARY SEWER LINE
- EXISTING WATER LINE
- EXISTING STORM SEWER LINE
- EXISTING CURB & GUTTER
- BOUNDARY LINE
- EASEMENT
- PROPOSED SIDEWALK
- SIDEWALKS TO BE DEFERRED
- PROPOSED RETAINING WALL (RW)
- PROPOSED SCREEN WALL
- PROPOSED MOUNTABLE CURB & GUTTER
- PROPOSED DEPRESSED MOUNTABLE C & G
- PROPOSED STANDARD CURB & GUTTER

RECEIVED MAY 17 2002 HYDROLOGY SECTION

STORM SEWER PIPE INFORMATION

LINE TABLE

LINE	LENGTH	BEARING	PIPE SIZE	SLOPE
L1	26.00	S84°01'40"W	18" RCP	S=2.00%
L2	57.13	S06°01'54"E	18" RCP	S=6.18%
L3	34.48	S06°01'54"E	36" RCP	S=8.24%
L4	21.02	N75°37'33"E	36" RCP	S=1.60%
L5	166.25	N83°58'06"E	36" RCP	S=1.00%
L6	59.55	S34°46'57"E	36" RCP	S=3.44%
L6-A	37.00	N84°49'3"E	30" RCP	S=2.00%
L7	70.36	N05°10'57"W	54" RCP	S=0.60%
L9	53.25	N05°10'57"W	54" RCP	S=1.00%
L10	28.00	N83°58'06"E	54" RCP	S=9.39%
L11	24.20	S06°01'54"E	24" RCP	S=4.19%

STORM SEWER INLETS AND MAHOLES

INLET (CB#) OR MANHOLE (MHA#)	TYPE	GRATE= RIM=	INV IN=	INV OUT=
CB1	DOUBLE "C"	5161.79	—	5157.79
CB2	DOUBLE "C"	5161.60	5157.27	5157.17
CB3	SINGLE "A"	5160.59	5153.64	5153.54
CB4	SINGLE "A"	5158.62	5154.72	5154.62
CB4-A	SINGLE "A"	5158.62	—	5155.46
CB5	SINGLE "C"	5161.42	—	5157.36
CB6	SINGLE "C"	5160.90	5156.37	5156.27
MHA1	"E"	5160.75	5153.33	5153.23
MHA2	"E"	5159.07	5150.57	5150.47
MHA3	"E"	5159.53	5150.05	5149.95

ROUGH GRADING APPROVAL DATE

ENGINEER'S SEAL

RONALD R. BOHANNAN P.E. #7868

DESERT PINE SUBDIVISION

GRADING AND DRAINAGE PLAN

TIERRA WEST, LLC
8509 JEFFERSON NE
ALBUQUERQUE, NEW MEXICO 87113
(505)858-3100

DRAWN BY	BDG
DATE	01-08-01
	2048GRA.DWG
SHEET #	4
JOB #	200048

RECEIVED JAN 11 2001 HYDROLOGY SECTION

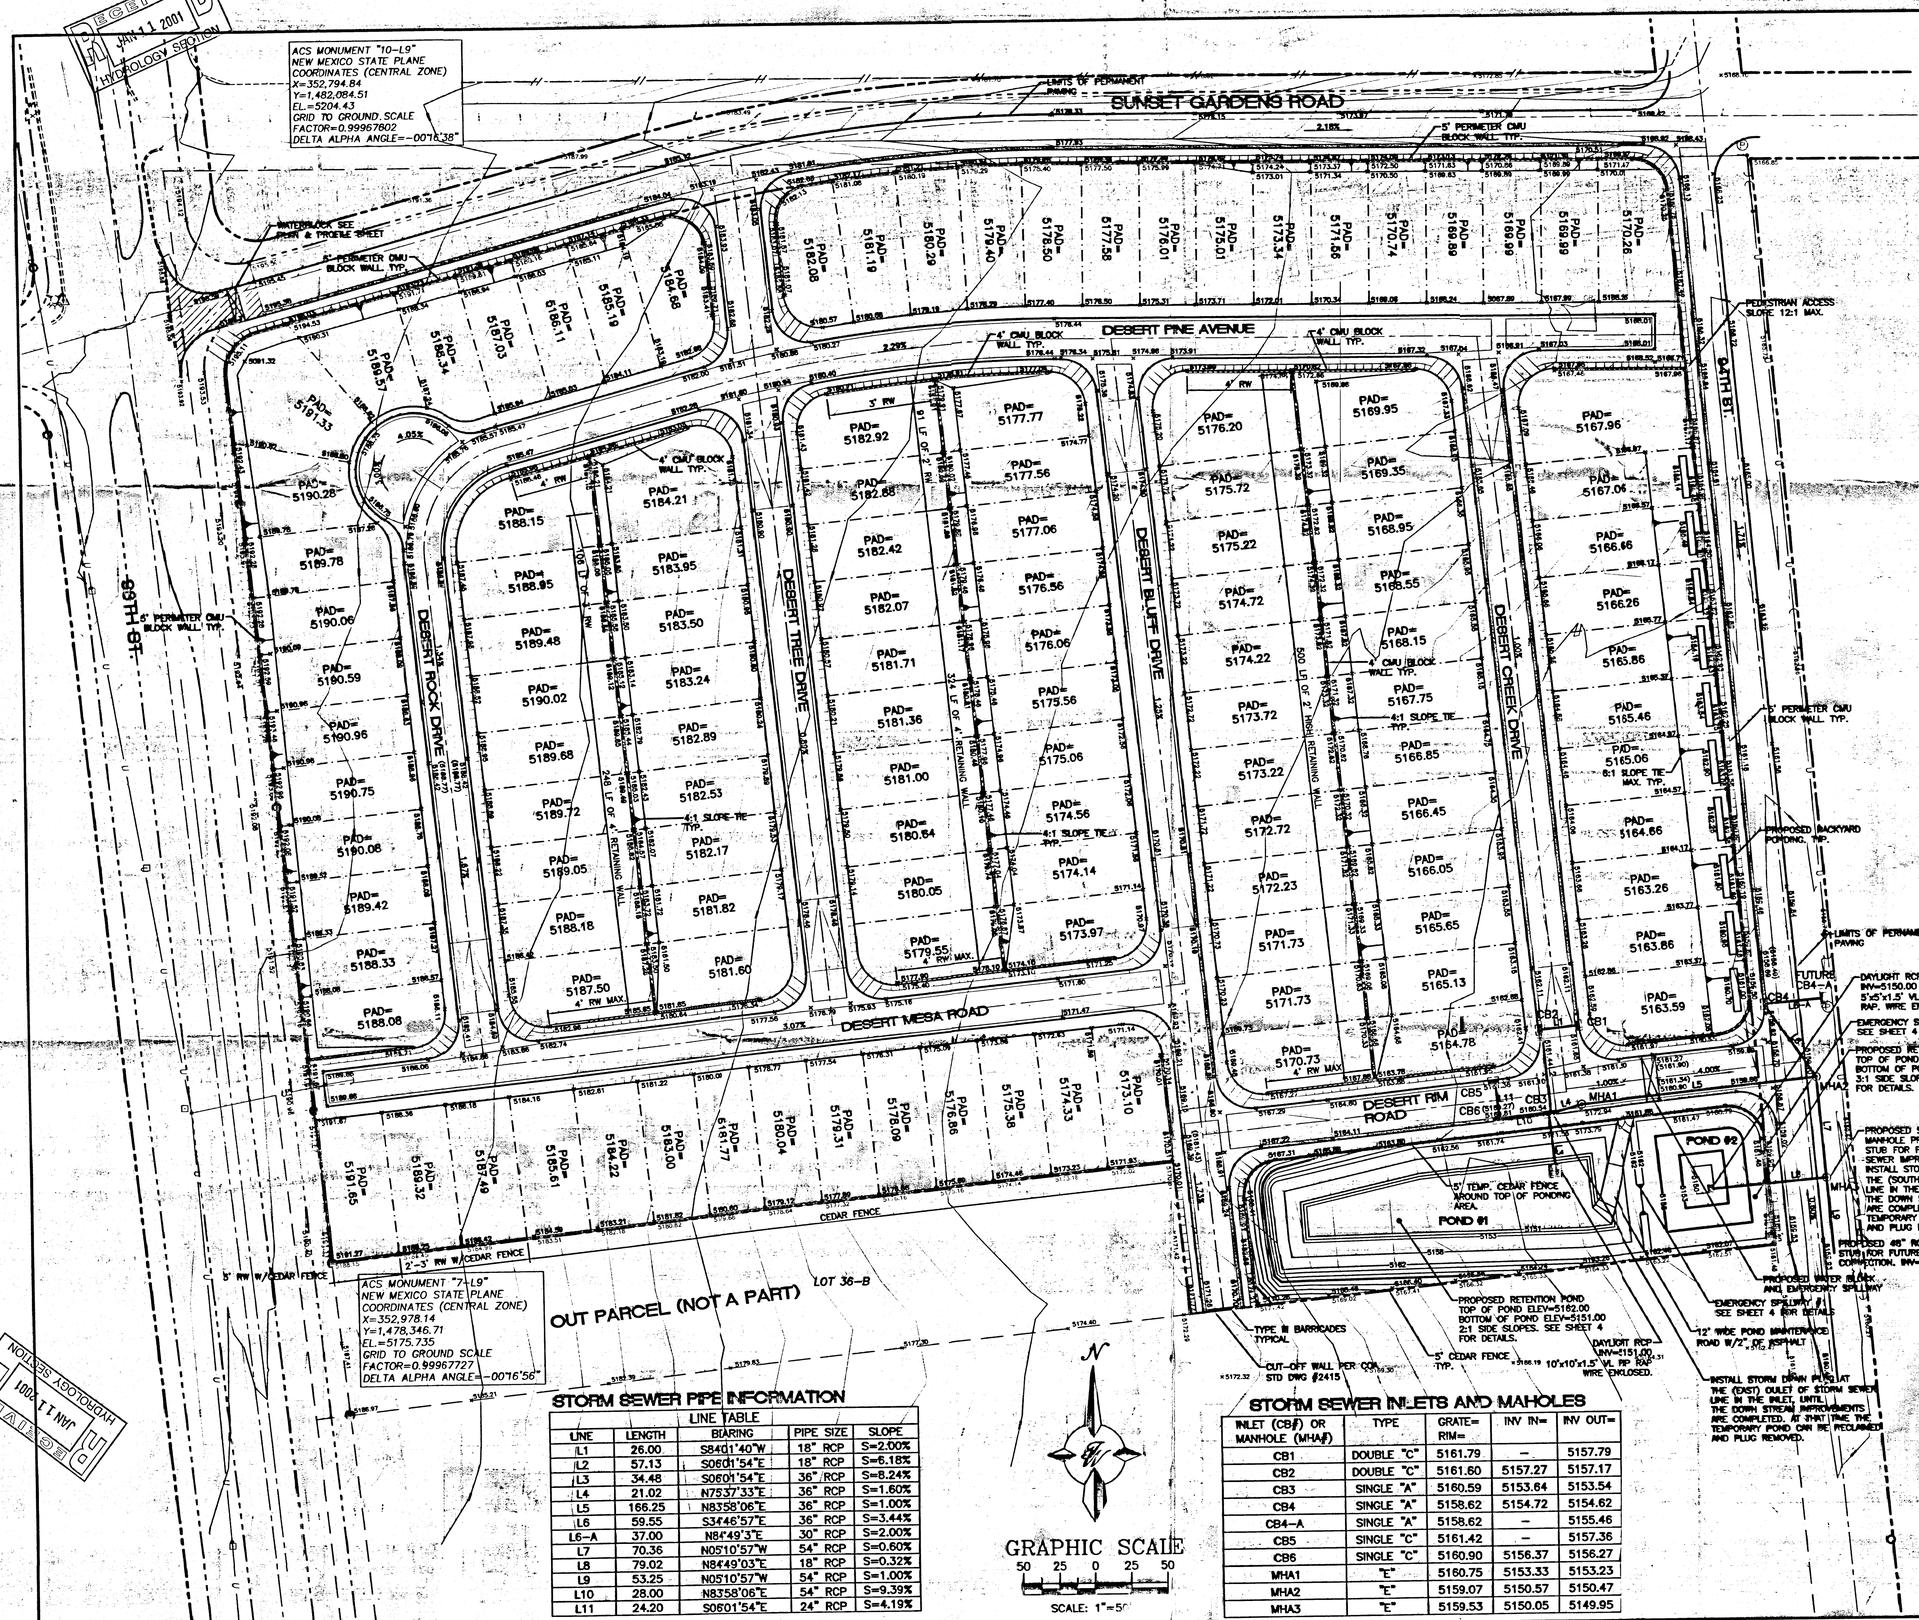

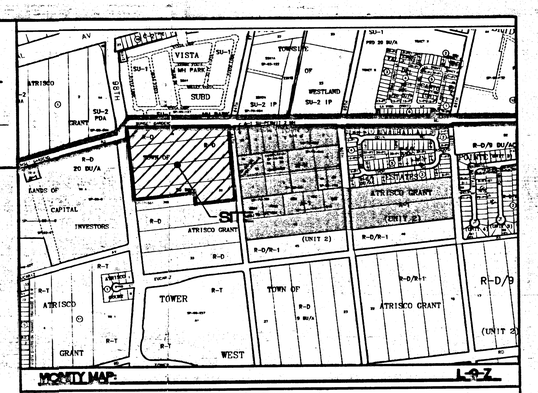

VICINITY MAP: L-9-Z

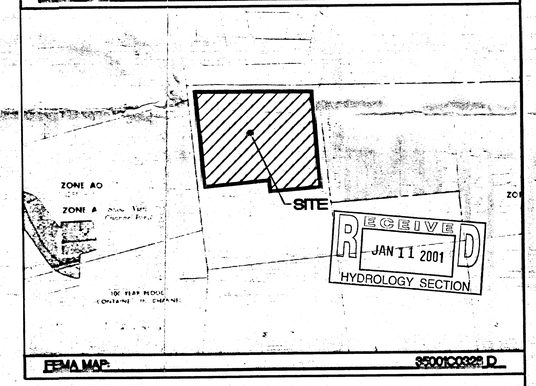

RECEIVED JAN 11 2001 HYDROLOGY SECTION

FEMA MAP: 35001C0328 D

LEGAL DESCRIPTION:

Proposed Desert Pine Subdivision, Comprising of Lot 36-A and all of Lots 37, 38 and 39, Unit 2

NOTES:

1. ALL SPOT ELEVATIONS REPRESENT THE FLOWLINE ELEVATION UNLESS OTHERWISE NOTED.
2. SEE SHEET 5 FOR TYPICAL LOT LAYOUT AND GRADING
3. 98th STREET IS PART OF SAD 222 AND WILL BE BUILT BY OTHERS ALONG WITH A 6' WIDE SIDEWALK.
4. LIMITS OF STANDARD CURB AND GUTTER AS SHOWN. VERIFY WITH PLAN AND PROFILE SHEETS.

LEGEND

- EXISTING SANITARY SEWER LINE
- EXISTING WATER LINE
- EXISTING STORM SEWER LINE
- EXISTING CURB & GUTTER
- BOUNDARY LINE
- EASEMENT
- PROPOSED SIDEWALK
- SIDEWALKS TO BE DEFERRED
- PROPOSED RETAINING WALL (RW)
- PROPOSED SCREEN WALL
- PROPOSED MOUNTABLE CURB & GUTTER
- PROPOSED DEPRESSED MOUNTABLE C & G
- PROPOSED STANDARD CURB & GUTTER

STORM SEWER PIPE INFORMATION

LINE TABLE

LINE	LENGTH	BEARING	PIPE SIZE	SLOPE
L1	26.00	S84°01'40"W	18" RCP	S=2.00%
L2	57.13	S06°01'54"E	18" RCP	S=6.16%
L3	34.48	S06°01'54"E	36" RCP	S=8.24%
L4	21.02	N75°37'33"E	36" RCP	S=1.60%
L5	166.25	N83°58'06"E	36" RCP	S=1.00%
L6	59.55	S34°46'57"E	36" RCP	S=3.44%
L6-A	37.00	N84°49'3"E	30" RCP	S=2.00%
L7	70.36	N05°10'57"W	54" RCP	S=0.60%
L8	79.02	N84°49'03"E	18" RCP	S=0.32%
L9	53.25	N05°10'57"W	54" RCP	S=1.00%
L10	28.00	N83°58'06"E	54" RCP	S=9.39%
L11	24.20	S06°01'54"E	24" RCP	S=4.19%

STORM SEWER INLETS AND MAHOLES

INLET (CB#) OR MANHOLE (MHA#)	TYPE	GRATE= RIM=	INV IN=	INV OUT=
CB1	DOUBLE "C"	5161.79	–	5157.79
CB2	DOUBLE "C"	5161.60	5157.27	5157.17
CB3	SINGLE "A"	5160.59	5153.64	5153.54
CB4	SINGLE "A"	5158.62	5154.72	5154.62
CB4-A	SINGLE "A"	5158.62	–	5155.46
CB5	SINGLE "C"	5161.42	–	5157.36
CB6	SINGLE "C"	5160.90	5156.37	5156.27
MHA1	"E"	5160.75	5153.33	5153.23
MHA2	"E"	5159.07	5150.57	5150.47
MHA3	"E"	5159.53	5150.05	5149.95

ROUGH GRADING APPROVAL DATE

RECEIVED JAN 11 2001 HYDROLOGY SECTION

ENGINEER'S SEAL

RONALD R. BOHANNAN P.E. 7868

DESERT PINE SUBDIVISION

GRADING AND DRAINAGE PLAN

TIERRA WEST, LLC
8509 JEFFERSON NE
ALBUQUERQUE, NEW MEXICO 87113
(505)858-3100

DRAWN BY: BDC
DATE: 01-08-01
2048GRAD.DWG
SHEET # 4
JOB # 200048

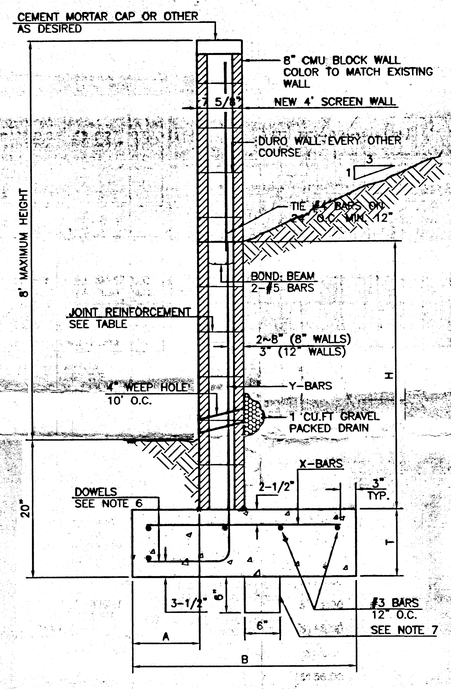

RETAINING WALL DETAIL
NTS

8 INCH REINFORCED CONCRETE MASONRY WALL

H	X	A	B	T	Y-BARS	X-BARS
ft.-in.	ft.-in.	in.	ft.-in.	in.		
2'-0"	1'-1"	8"	2'-4"	9"	#3 @32" O.C.	#3 @27" O.C.
2'-8"	1'-9"	8"	2'-9"	9"	#4 @32" O.C.	#3 @27" O.C.
3'-4"	2'-5"	8"	2'-4"	9"	#3 @32" O.C.	#3 @27" O.C.
4'-0"	3'-1"	10"	2'-9"	9"	#4 @32" O.C.	#3 @27" O.C.
4'-8"	3'-10"	12"	3'-4"	10"	#5 @32" O.C.	#3 @27" O.C.
5'-4"	4'-6"	14"	3'-8"	10"	#4 @16" O.C.	#4 @30" O.C.
6'-0"	5'-3"	16"	4'-2"	12"	#6 @24" O.C.	#4 @25" O.C.

12 INCH REINFORCED CONCRETE MASONRY WALL

H	X	A	B	T	Y-BARS	X-BARS
ft.-in.	ft.-in.	in.	ft.-in.	in.		
5'-4"	4'-8"	14"	3'-8"	10"	#4 @24" O.C.	#3 @25" O.C.
6'-0"	5'-4"	15"	4'-2"	12"	#4 @16" O.C.	#4 @30" O.C.
6'-8"	6'-0"	16"	4'-6"	12"	#6 @24" O.C.	#4 @22" O.C.
7'-4"	6'-8"	18"	4'-10"	12"	#5 @16" O.C.	#5 @26" O.C.
8'-0"	7'-4"	20"	5'-4"	12"	#7 @24" O.C.	#5 @21" O.C.
8'-8"	8'-0"	20"	5'-8"	12"	#7 @16" O.C.	#5 @21" O.C.

GENERAL NOTES:

1. ALL CONCRETE IS TO BE 4000 PSI @ 28 DAYS.
2. MINIMUM COMPACTION UNDER FOOTINGS IS TO BE 95% PER ASTM. D 1557 FOR A DEPTH OF 12" MOISTURE CONTENT IS TO BE ± 2.0%.
3. BACK FILL AGAINST WALLS IS TO BE HAND-PLACED AND COMPACTED.
4. ALL BARS ARE TO BE GRADE 60, ASTM 615.
5. TRUSS TYPE DUR-O-WALL EVERY OTHER COURSE.
6. DOWELS SHALL BE AT LEAST EQUAL IN SIZE AND SPACING TO V-BARS, SHALL PROJECT A MINIMUM OF 30 BAR DIA. INTO THE FILLED BLOCK CORES, AND SHALL EXTEND TO THE TOE OF THE FOOTING.
7. PROVIDE KEY FOR 8" AND 12" WALLS WHERE H EXCEEDS 6'-0"
8. USE EITHER EXPANSION JOINTS ON 20' CENTERS OR PILASTERS EVERY 16'.
9. #3 BARS TO BE USED ON WALLS EXCEEDING 2'-8" HEIGHT
10. X BARS TO BE USED ON WALLS EXCEEDING 2'-8" HEIGHT
11. #4 BARS TO BE USED ON WALLS SMALLER THAN 3'-4"
12. BOND BEAM, 1-#4 BARS FOR WALLS UNDER 3'-4", 2-#4 BARS FOR WALLS UNDER 5'-4", 2-#5 BARS FOR WALLS OVER 5'-4".

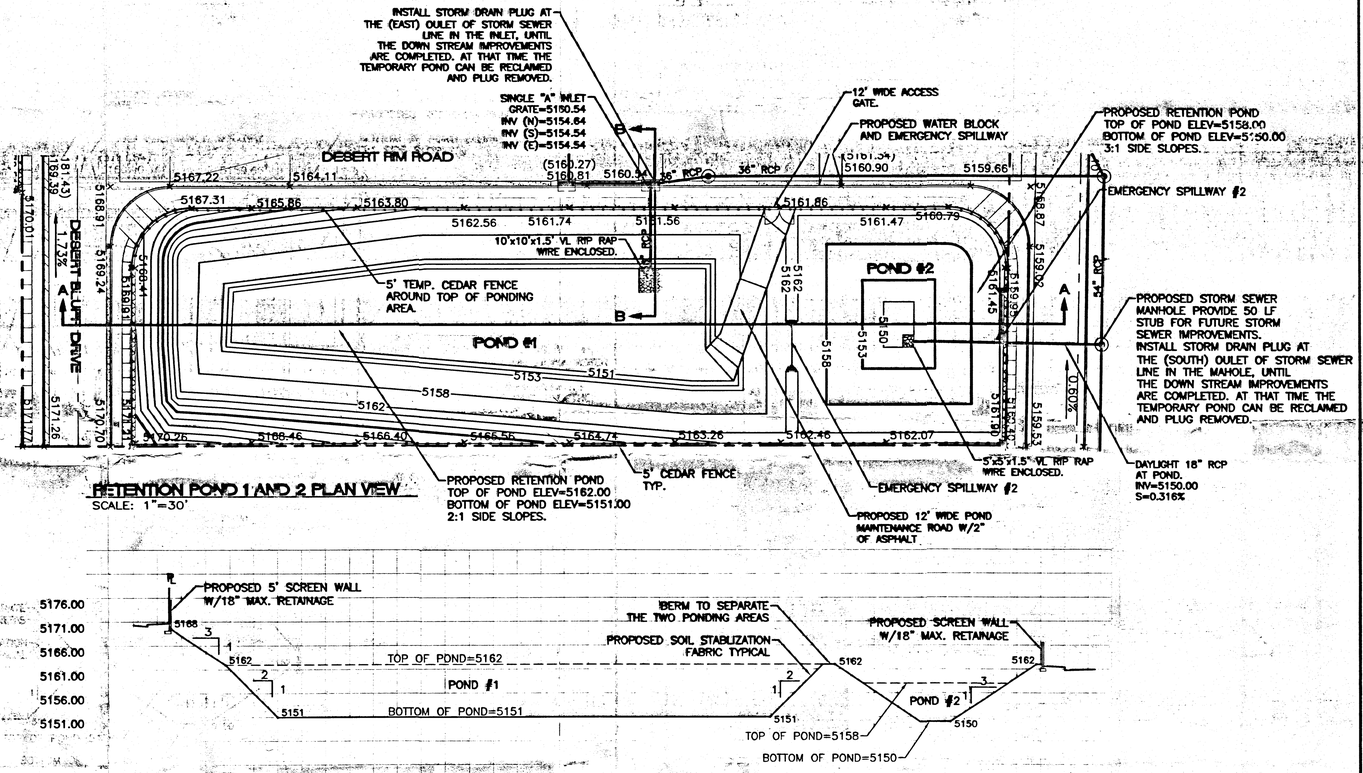

RETENTION POND 1 AND 2 PLAN VIEW
SCALE: 1"=30'

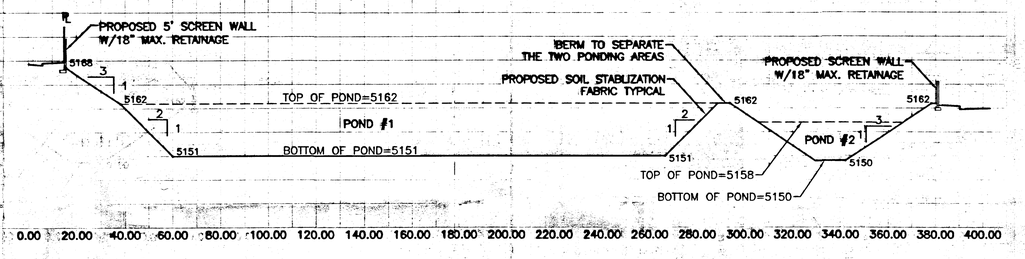

SECTION A-A
HORZ SCALE: 1"=30'
VERT. SCALE: 1"=15'

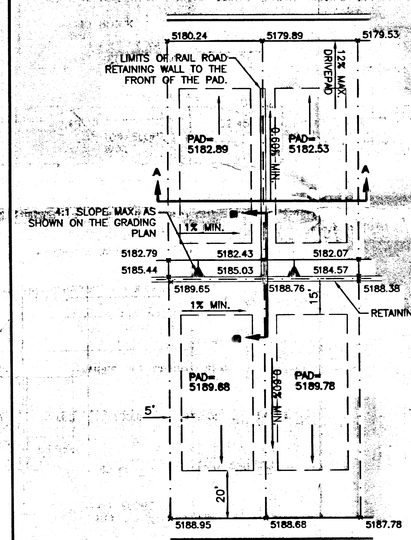

TYPICAL LOT GRADING
SCALE: 1"=30'

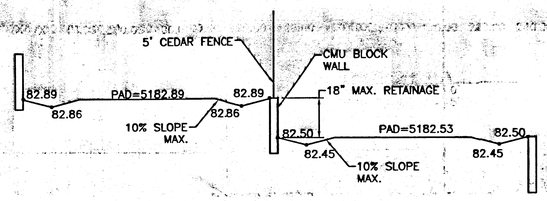

SECTION A-A
TYPICAL SIDE YARD GRADING
NTS

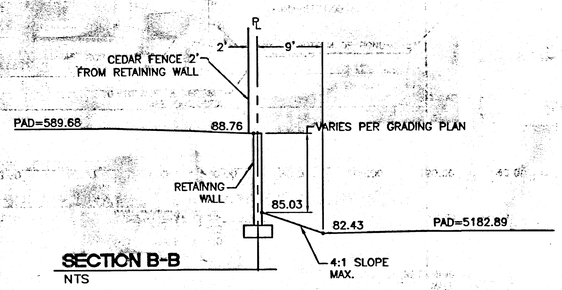

SECTION B-B
NTS

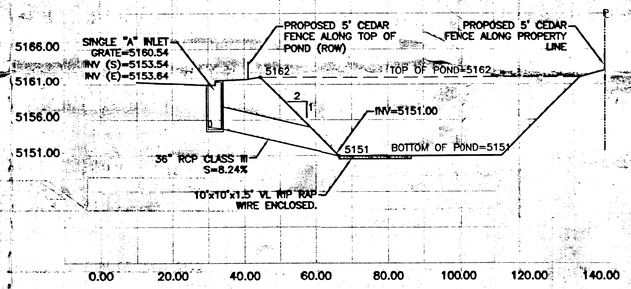

SECTION B-B
HORZ SCALE: 1"=20'
VERT. SCALE: 1"=10'

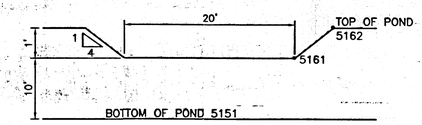

EMERGENCY SPILLWAY #1
NTS

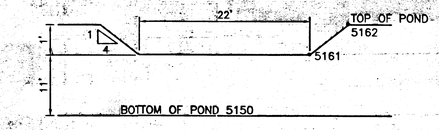

EMERGENCY SPILLWAY #2
NTS

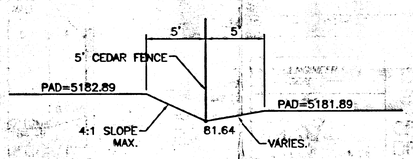

(OPTIONAL) SECTION A-A
TYPICAL SIDE YARD GRADING
NTS

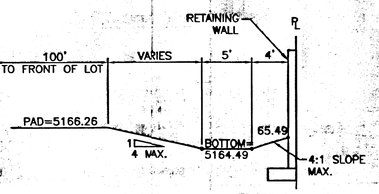

TYPICAL BACK YARD PONDING SECTION
NTS

ENGINEER'S SEAL

RONALD R. BOHANNAN P.E. #7868

DESERT PINE SUBDIVISION

GRADING AND DRAINAGE PLAN DETAILS

TIERRA WEST, LLC
8509 JEFFERSON NE
ALBUQUERQUE, NEW MEXICO 87113
(505)858-3100

DRAWN BY BDG
DATE 01-08-01
204BGR.DWG
SHEET # 5
JOB # 200048

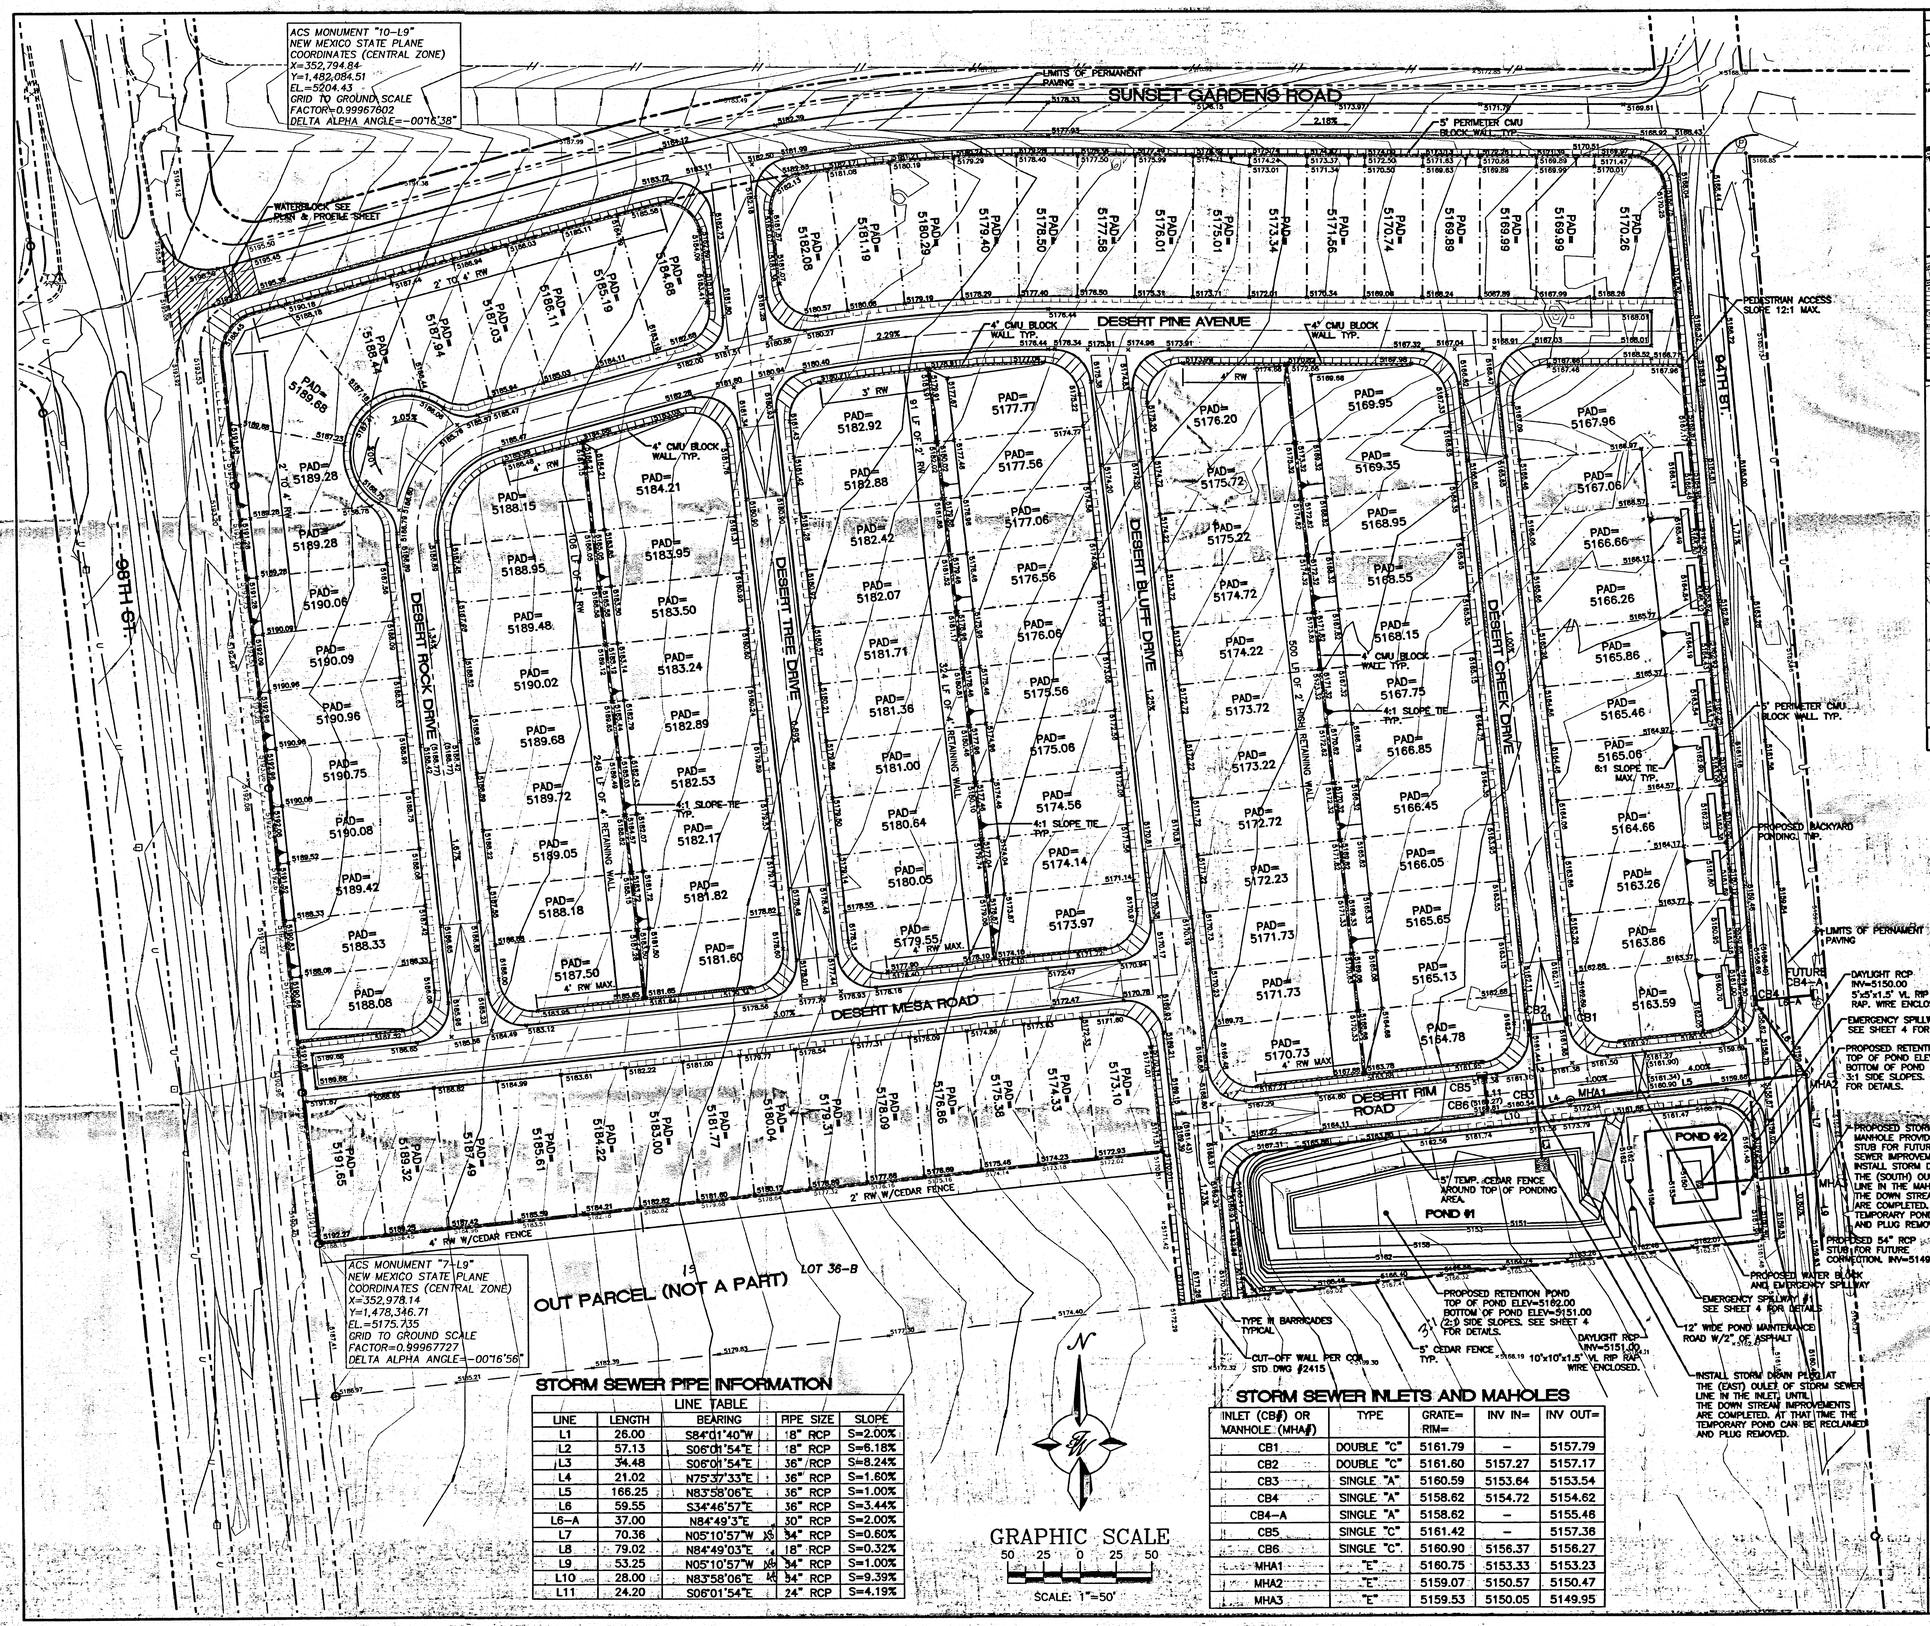

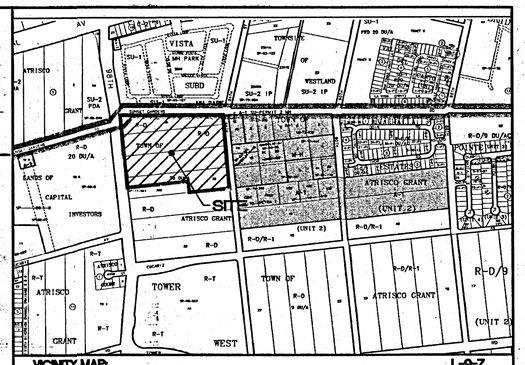

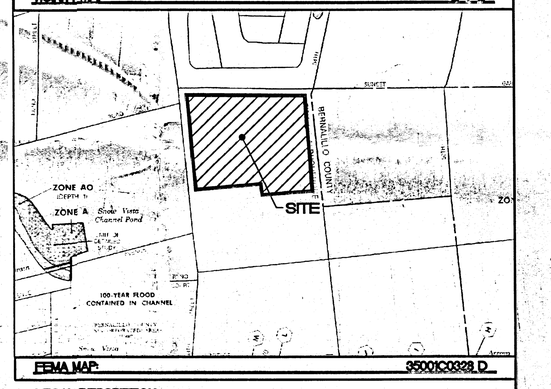

LEGAL DESCRIPTION:

Proposed Desert Pine Subdivision, Comprising of Lot 36-A and all of Lots 37, 38 and 39, Unit 2

NOTES:

1. ALL SPOT ELEVATIONS REPRESENT THE FLOWLINE ELEVATION UNLESS OTHERWISE NOTED.
2. SEE SHEET 5 FOR TYPICAL LOT LAYOUT AND GRADING
3. 98th STREET IS PART OF SAD 222 AND WILL BE BUILT BY OTHERS ALONG WITH A 6' WIDE SIDEWALK.
4. LIMITS OF STANDARD CURB AND GUTTER AS SHOWN. VERIFY WITH PLAN AND PROFILE SHEETS.

LEGEND

- EXISTING SANITARY SEWER LINE
- EXISTING WATER LINE
- EXISTING STORM SEWER LINE
- EXISTING CURB & GUTTER
- BOUNDARY LINE
- EASEMENT
- PROPOSED SIDEWALK
- SIDEWALKS TO BE DEFERRED
- PROPOSED RETAINING WALL (RW)
- PROPOSED SCREEN WALL
- PROPOSED MOUNTABLE CURB & GUTTER
- PROPOSED DEPRESSED MOUNTABLE C & G
- PROPOSED STANDARD CURB & GUTTER

STORM SEWER PIPE INFORMATION

LINE TABLE

LINE	LENGTH	BEARING	PIPE SIZE	SLOPE
L1	26.00	S84°01'40"W	18" RCP	S=2.00%
L2	57.13	S06°01'54"E	18" RCP	S=6.18%
L3	34.48	S06°01'54"E	36" RCP	S=8.24%
L4	21.02	N75°37'33"E	36" RCP	S=1.60%
L5	166.25	N83°58'06"E	36" RCP	S=1.00%
L6	59.55	S34°46'57"E	36" RCP	S=3.44%
L6-A	37.00	N84°49'3"E	30" RCP	S=2.00%
L11	24.20	S06°01'54"E	24" RCP	S=4.19%

STORM SEWER INLETS AND MAHOLES

INLET (CB#) OR MANHOLE (MHA#)	TYPE	GRATE= RIM=	INV IN=	INV OUT=
CB1	DOUBLE "C"	5161.79	–	5157.79
CB2	DOUBLE "C"	5161.60	5157.27	5157.17
CB3	SINGLE "A"	5160.59	5153.64	5153.54
CB4	SINGLE "A"	5158.62	5154.72	5154.62
CB4-A	SINGLE "A"	5158.62	–	5155.46
CB5	SINGLE "C"	5161.42	–	5157.36
CB6	SINGLE "C"	5160.90	5156.37	5156.27
MHA1	"E"	5160.75	5153.33	5153.23
MHA2	"E"	5159.07	5150.57	5150.47
MHA3	"E"	5159.53	5150.05	5149.95

RECEIVED
NOV 14 2000
DATE HYDROLOGY SECTION

ROUGH GRADING APPROVAL

ENGINEER'S SEAL

RONALD R. BOHANNAN P.E. #7868

DESERT PINE SUBDIVISION

GRADING AND DRAINAGE PLAN

TIERRA WEST, LLC
8509 JEFFERSON NE
ALBUQUERQUE, NEW MEXICO 87113
(505)858-3100

DRAWN BY BDG
DATE 11-13-00
2048GRA.DWG
SHEET # 4
JOB # 200048

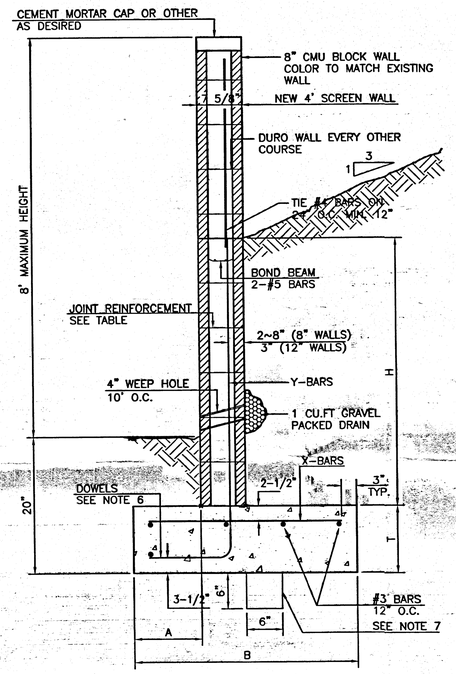

RETAINING WALL DETAIL
NTS

8 INCH REINFORCED CONCRETE MASONRY WALL

H	X	A	B	T	Y-BARS	X-BARS
ft.-in.	ft.-in.	in.	ft.-in.	in.		
2'-0"	1'-1"	8"	2'-4"	9"	#3 @32" O.C.	#3 @27" O.C.
2'-8"	1'-9"	8"	2'-9"	9"	#4 @32" O.C.	#3 @27" O.C.
3'-4"	2'-5"	8"	2'-4"	9"	#3 @32" O.C.	#3 @27" O.C.
4'-0"	3'-1"	10"	2'-9"	9"	#4 @32" O.C.	#3 @27" O.C.
4'-8"	3'-10"	12"	3'-4"	10"	#5 @32" O.C.	#3 @27" O.C.
5'-4"	4'-6"	14"	3'-8"	10"	#4 @16" O.C.	#4 @30" O.C.
6'-0"	5'-3"	16"	4'-2"	12"	#6 @24" O.C.	#4 @25" O.C.

12 INCH REINFORCED CONCRETE MASONRY WALL

H	X	A	B	T	Y-BARS	X-BARS
ft.-in.	ft.-in.	in.	ft.-in.	in.		
5'-4"	4'-8"	14"	3'-8"	10"	#4 @24" O.C.	#3 @25" O.C.
6'-0"	5'-4"	15"	4'-2"	12"	#4 @16" O.C.	#4 @30" O.C.
6'-8"	6'-0"	16"	4'-6"	12"	#6 @24" O.C.	#4 @22" O.C.
7'-4"	6'-8"	18"	4'-10"	12"	#5 @16" O.C.	#5 @26" O.C.
8'-0"	7'-4"	20"	5'-4"	12"	#7 @24" O.C.	#5 @21" O.C.
8'-8"	8'-0"	20"	5'-8"	12"	#7 @16" O.C.	#5 @21" O.C.

GENERAL NOTES:

1. ALL CONCRETE IS TO BE 4000 PSI @ 28 DAYS.
2. MINIMUM COMPACTION UNDER FOOTINGS IS TO BE 95% PER ASTM. D 1557 FOR A DEPTH OF 12" MOISTURE CONTENT IS TO BE ± 2.0%.
3. BACK FILL AGAINST WALLS IS TO BE HAND-PLACED AND COMPACTED.
4. ALL BARS ARE TO BE GRADE 60, ASTM 615.
5. TRUSS TYPE DUR-O-WALL EVERY OTHER COURSE.
6. DOWELS SHALL BE AT LEAST EQUAL IN SIZE AND SPACING TO V-BARS, SHALL PROJECT A MINIMUM OF 30 BAR DIA. INTO THE FILLED BLOCK CORES, AND SHALL EXTEND TO THE TOE OF THE FOOTING.
7. PROVIDE KEY FOR 8" AND 12" WALLS WHERE H EXCEEDS 6'-0"
8. USE EITHER EXPANSION JOINTS ON 20' CENTERS OR PILASTERS EVERY 16'.
9. #3 BARS TO BE USED ON WALLS EXCEEDING 2'-8" HEIGHT
10. X BARS TO BE USED ON WALLS EXCEEDING 2'-8" HEIGHT
11. #4 BARS TO BE USED ON WALLS SMALLER THAN 3'-4"
12. BOND BEAM, 1-#4 BARS FOR WALLS UNDER 3'-4", 2-#4 BARS FOR WALLS UNDER 5'-4", 2-#5 BARS FOR WALLS OVER 5'-4".

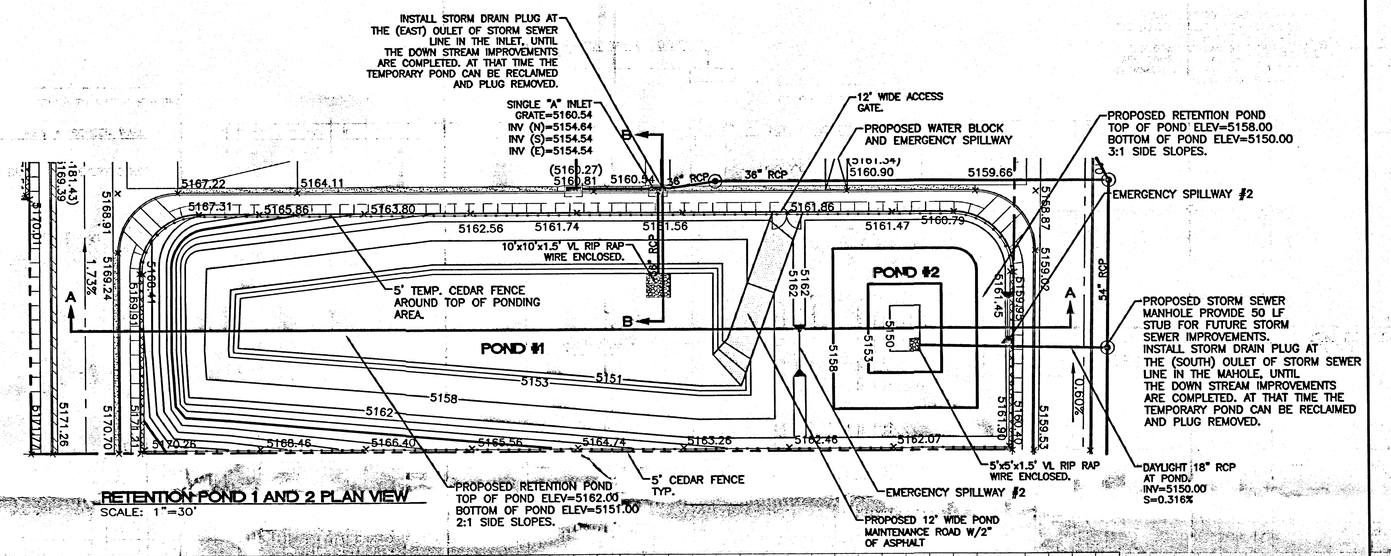

RETENTION POND 1 AND 2 PLAN VIEW
SCALE: 1"=30'

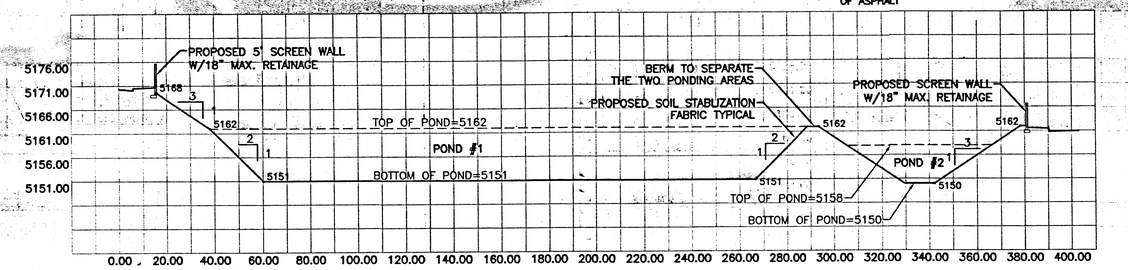

SECTION A-A
HORZ SCALE: 1"=30'
VERT. SCALE: 1"=15'

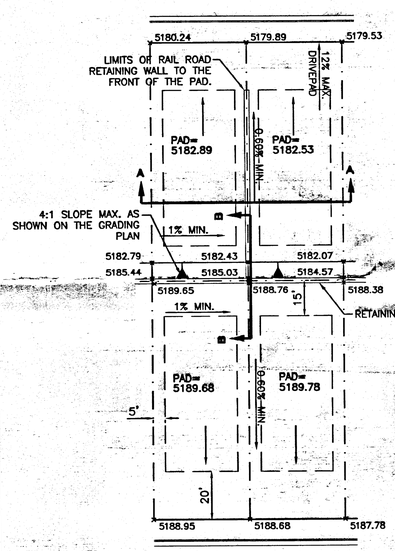

TYPICAL LOT GRADING
SCALE: 1"=30'

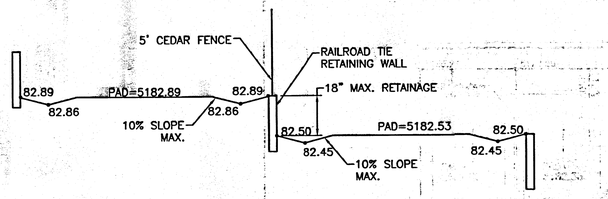

SECTION A-A
TYPICAL SIDE YARD GRADING
NTS

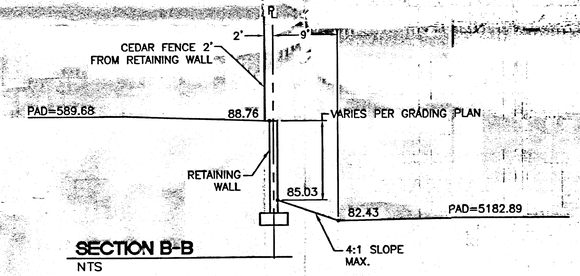

SECTION B-B
NTS

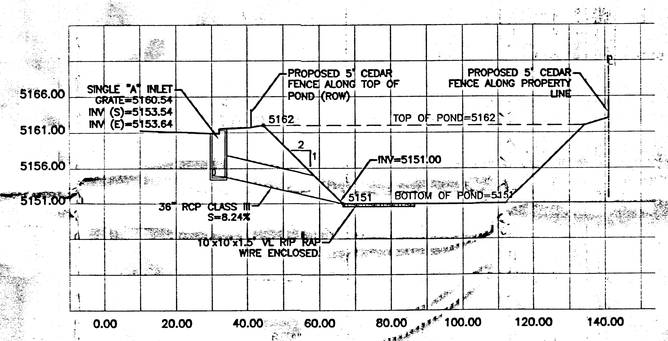

SECTION B-B
HORZ SCALE: 1"=20'
VERT. SCALE: 1"=10'

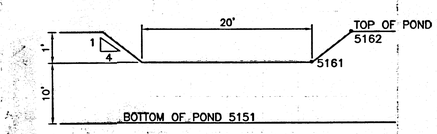

EMERGENCY SPILLWAY #1
NTS

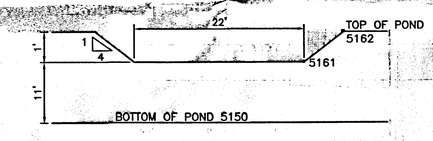

EMERGENCY SPILLWAY #2
NTS

(OPTIONAL) SECTION A-A
TYPICAL SIDE YARD GRADING
NTS

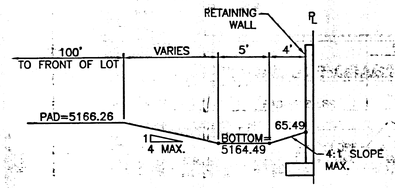

TYPICAL BACK YARD PONDING SECTION
NTS

RECEIVED NOV 14 2000 HYDROLOGY SECTION

ENGINEER'S SEAL	DESERT PINE SUBDIVISION	DRAWN BY BDG
	GRADING AND DRAINAGE PLAN DETAILS	DATE 11-13-00
		2048GR.DWG
	TIERRA WEST, LLC 8509 JEFFERSON NE ALBUQUERQUE, NEW MEXICO 87113 (505)858-3100	SHEET # 5
RONALD R. BOHANNAN P.E. #7868		JOB # 200048

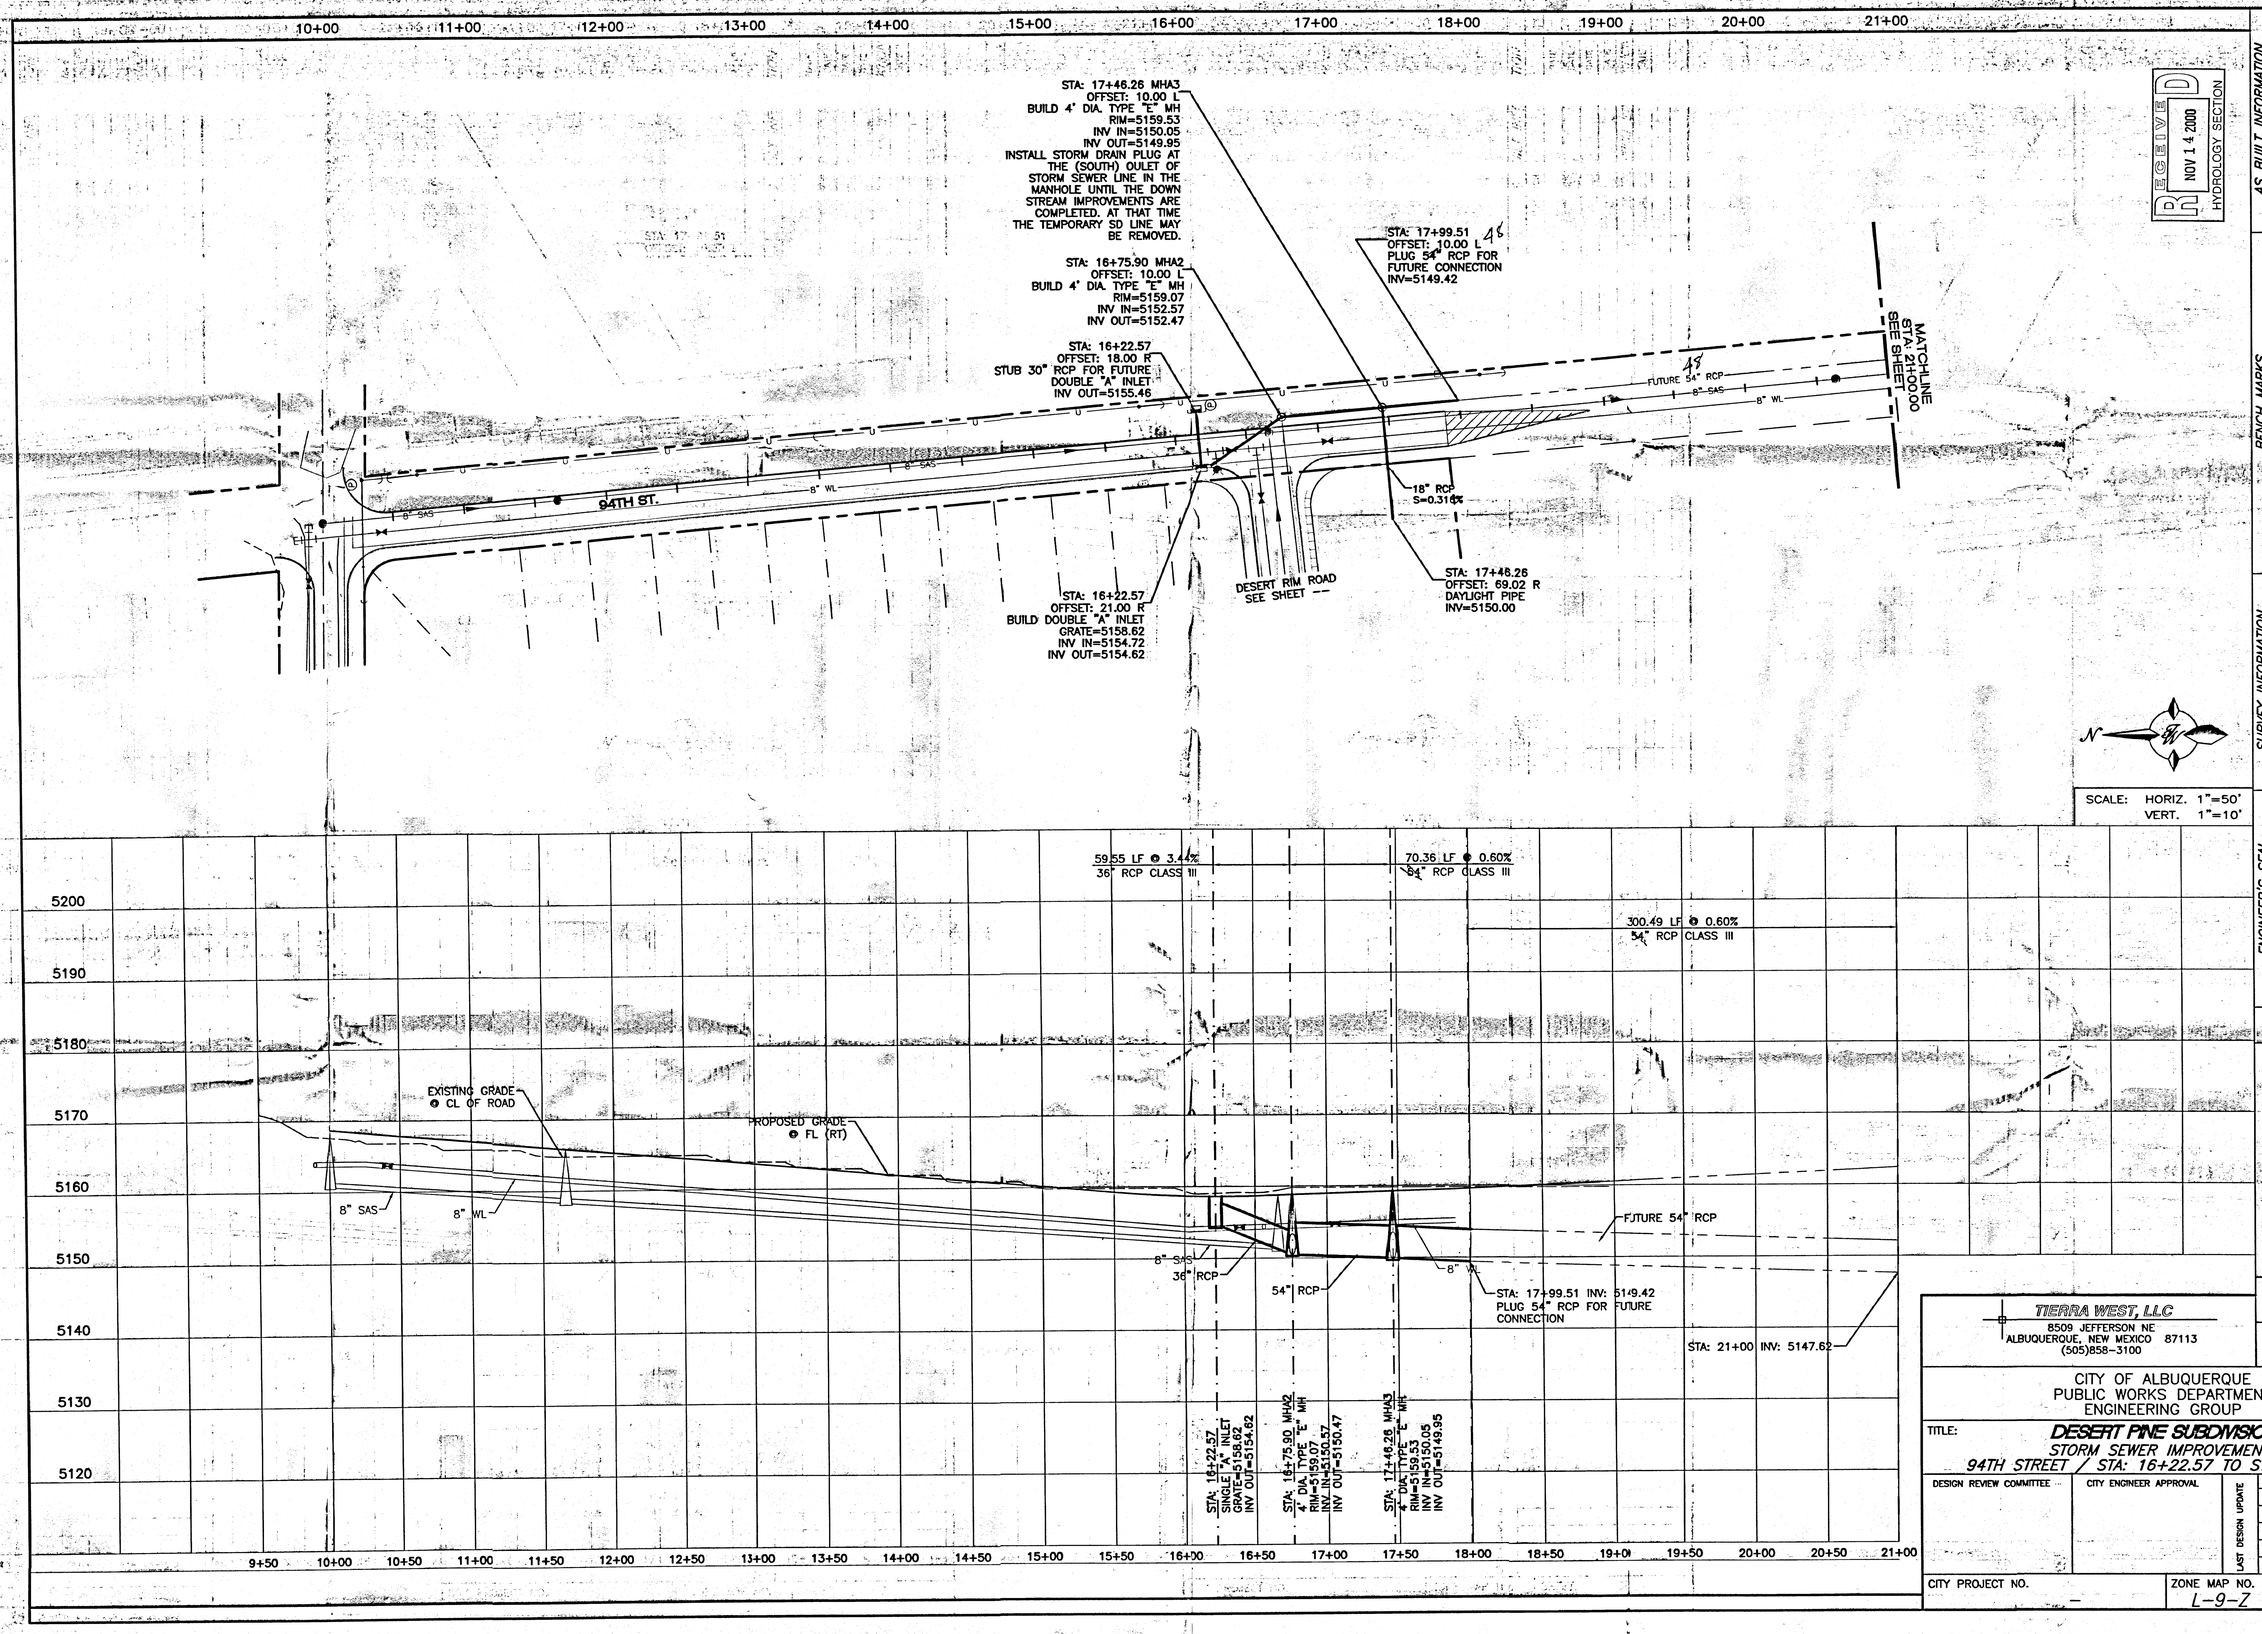

RECEIVED NOV 14 2000 HYDROLOGY SECTION

SCALE: HORIZ. 1"=50'
VERT. 1"=10'

AS BUILT INFORMATION

CONTRACTOR		
WORK STAKED BY		DATE
INSPECTOR'S ACCEPTANCE BY		DATE
FIELD VERIFICATION BY		DATE
DRAWINGS CORRECTED BY		DATE

MICRO-FILM INFORMATION

RECORDED BY	DATE
NO.	

BENCH MARKS

ACS MONUMENT "10-L9"
CENTRAL STATION DATA
NM STATE PLANE COORDINATES
Central Zone
X=352,794.84
Y=1,482,084.51
G-G=0.99967602
Da=-00°16'38"
EL.=5204.43

SURVEY INFORMATION

FIELD NOTES

NO.	BY	DATE

ENGINEER'S SEAL

DONALD RAY BOHANNAN NEW MEXICO 6844 PROFESSIONAL ENGINEER

NO.	DATE	REMARKS	BY
		REVISIONS	

DESIGN

DESIGNED BY	RRB	DATE 10-00
DRAWN BY	BDG	DATE 11-13-00
DRAWN NAME:	94TH STREET SP.DWG	
CHECKED BY	RRB	DATE 10-00

TIERRA WEST, LLC
8509 JEFFERSON NE
ALBUQUERQUE, NEW MEXICO 87113
(505)858-3100

CITY OF ALBUQUERQUE
PUBLIC WORKS DEPARTMENT
ENGINEERING GROUP

RECEIVED NOV 14 2000 HYDROLOGY SECTION

TITLE: **DESERT PINE SUBDIVISION**
STORM SEWER IMPROVEMENTS
94TH STREET / STA: 16+22.57 TO STA: 17+99.51

DESIGN REVIEW COMMITTEE	CITY ENGINEER APPROVAL	LAST DESIGN UPDATE	MO./DAY/YR.	MO./DAY/YR.

CITY PROJECT NO.	ZONE MAP NO.	SHEET	OF
–	L-9-Z	–	

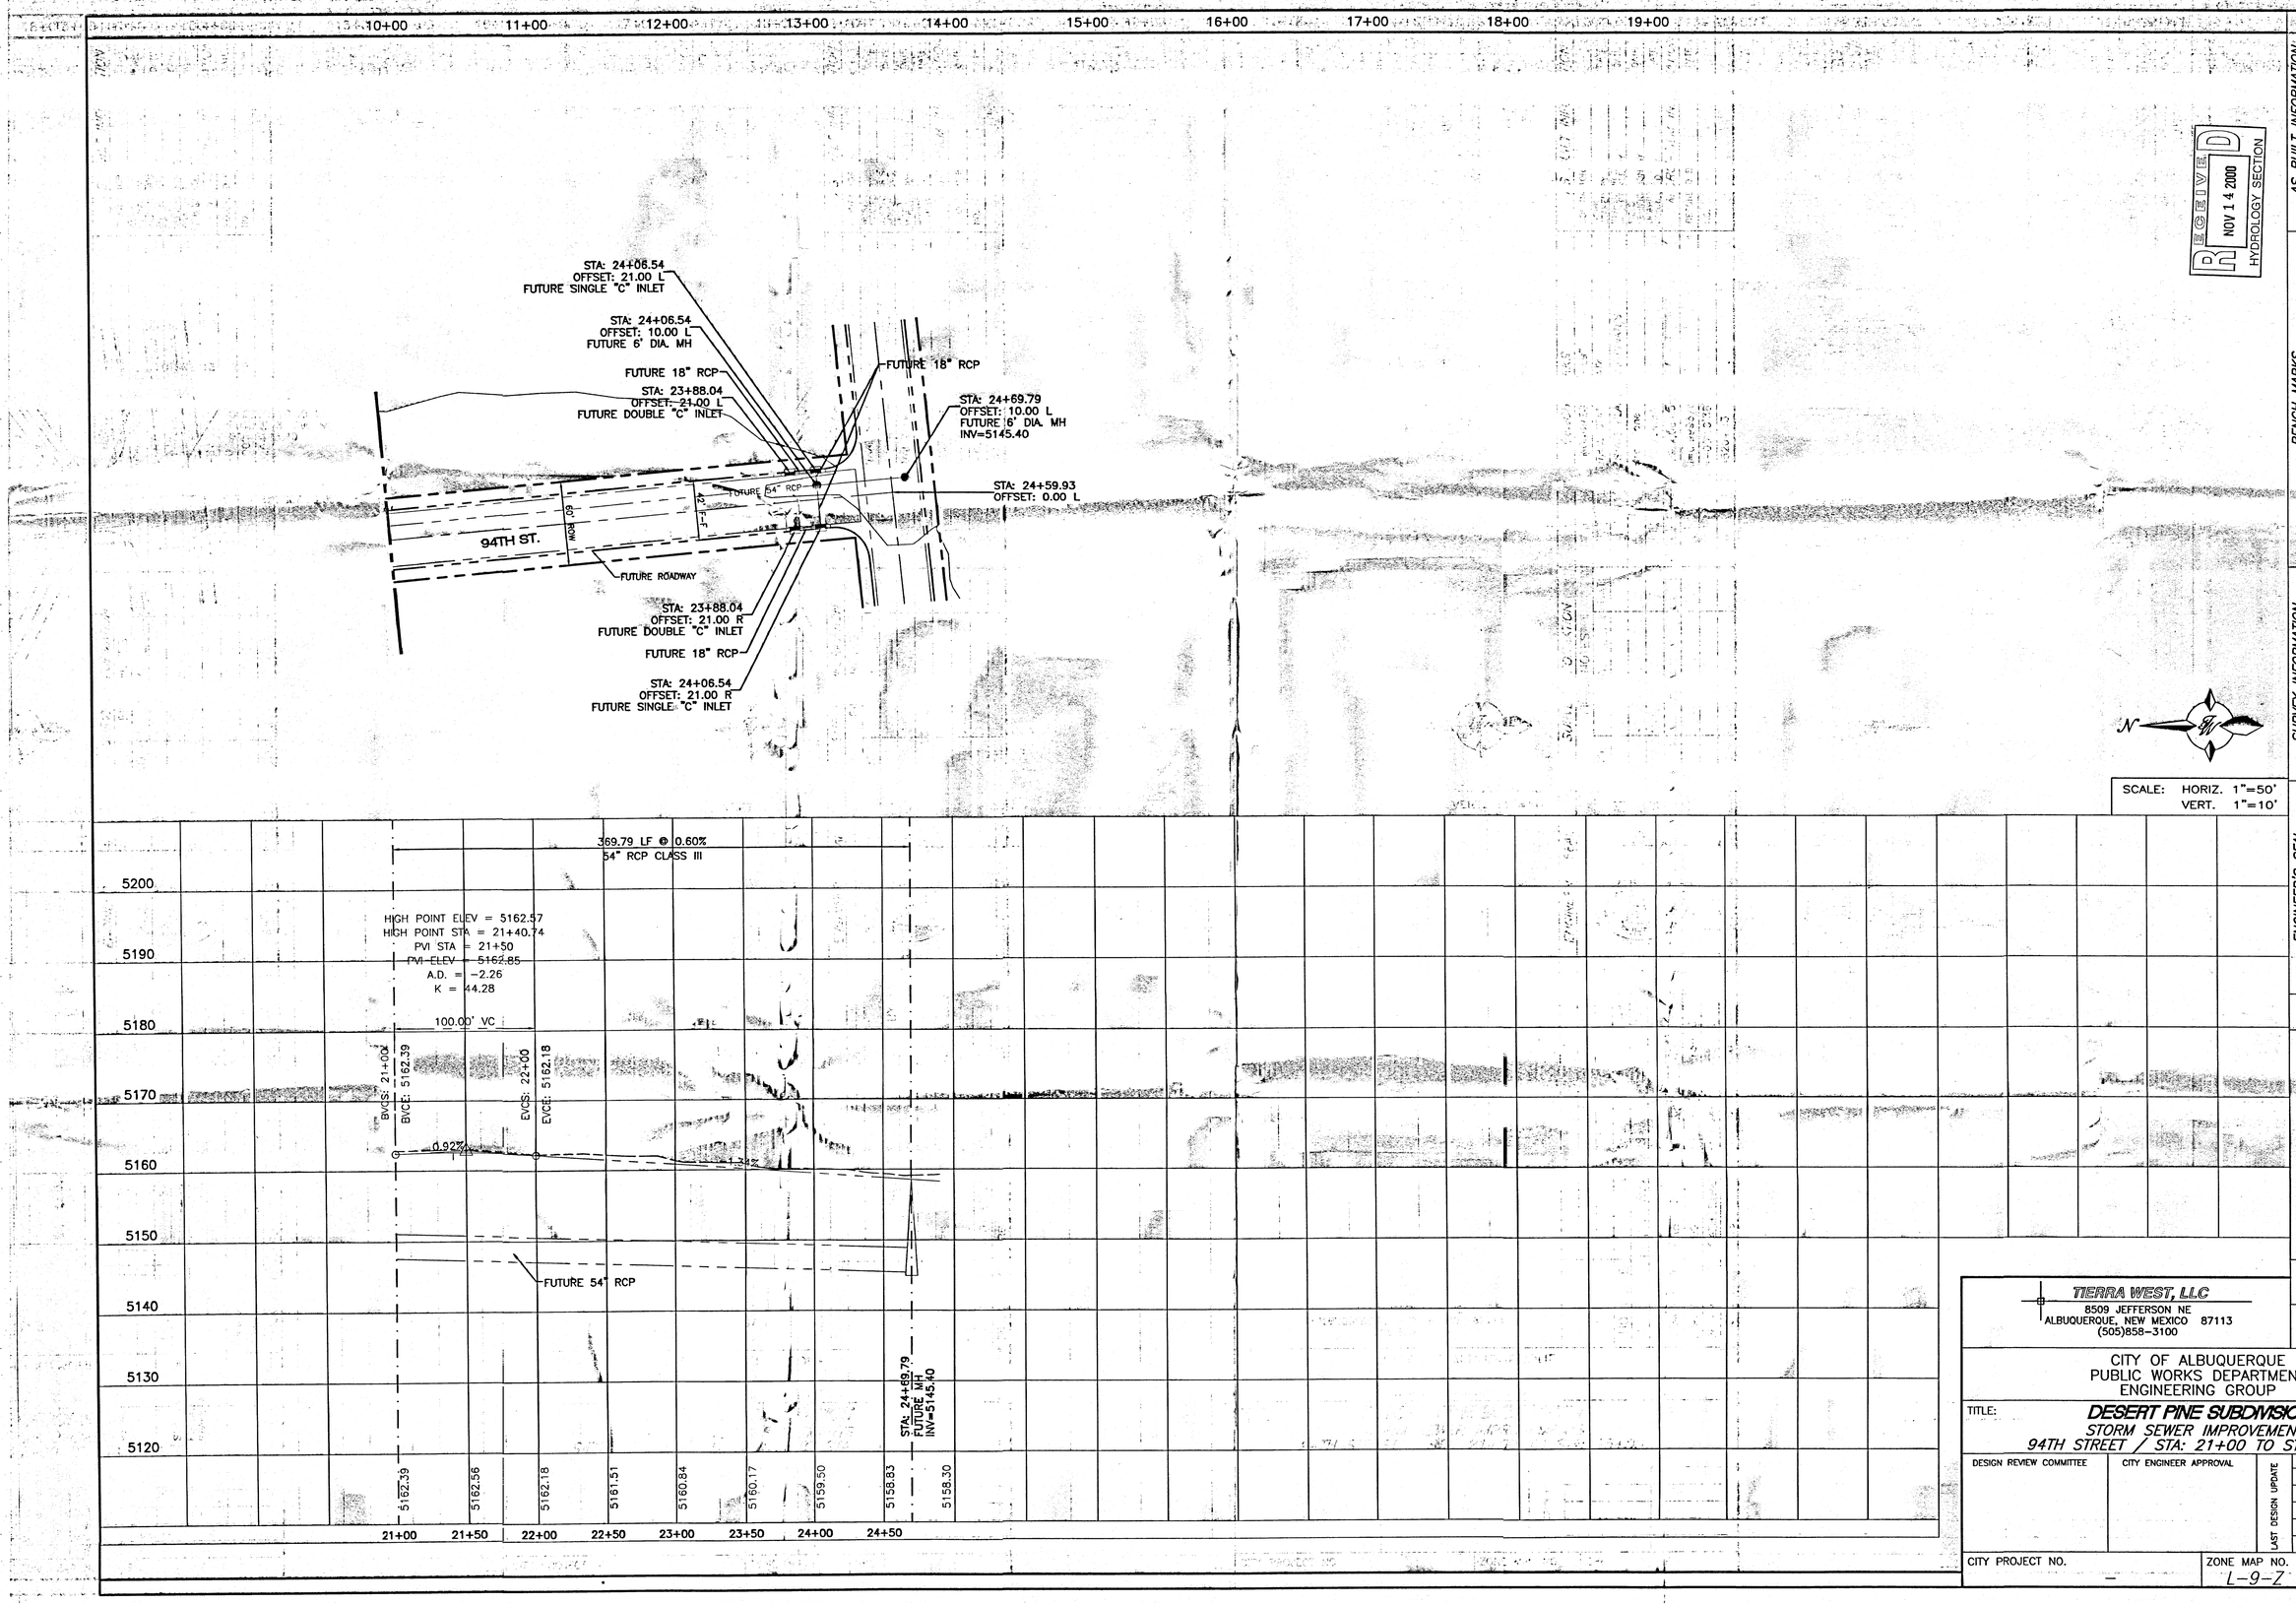

AS BUILT INFORMATION		
CONTRACTOR		
WORK STAKED BY		DATE
INSPECTOR ACCEPTANCE BY		DATE
FIELD VERIFICATION BY		DATE
DRAWINGS CORRECTED BY		DATE
MICRO-FILM INFORMATION		
RECORDED BY		DATE
NO.		

BENCH MARKS

ACS MONUMENT "10-L9"
CENTRAL STATION DATA
NM STATE PLANE COORDINATES
Central Zone
X=352,794.84
Y=1,482,084.51
G-G=0.99967602
Do=-0°16'38"
EL.=5204.43

SURVEY INFORMATION

FIELD NOTES

NO.	BY	DATE

ENGINEER'S SEAL

NEW MEXICO BOARD OF REGISTRATION FOR PROFESSIONAL ENGINEERS
11-13-2000

NO.	DATE	REMARKS	BY

REVISIONS

DESIGNED BY	RRB	DATE 10-00
DRAWN BY	BDG	DATE 11-13-00
DRAWN NAME:	94TH STREET SPPU.DWG	
CHECKED BY	RRB	DATE 10-00

TIERRA WEST, LLC
8509 JEFFERSON NE
ALBUQUERQUE, NEW MEXICO 87113
(505)858-3100

CITY OF ALBUQUERQUE
PUBLIC WORKS DEPARTMENT
ENGINEERING GROUP

RECEIVED NOV 14 2000 HYDROLOGY SECTION

TITLE: **DESERT PINE SUBDIVISION**
STORM SEWER IMPROVEMENTS
94TH STREET / STA: 21+00 TO STA: 25+00

DESIGN REVIEW COMMITTEE	CITY ENGINEER APPROVAL	LAST DESIGN UPDATE	MO./DAY/YR.	MO./DAY/YR.

CITY PROJECT NO.	ZONE MAP NO.	SHEET	OF
–	L-9-Z	–	–

CURVE TABLE						
CURVE	LENGTH	RADIUS	TANGENT	DELTA	CHORD BEARING	CHORD LENGTH
C1	41.67	25.00	27.53	95°30'22"	N42°34'14"E	37.01
C2	44.27	30.00	27.27	84°32'26"	N47°27'10"W	40.36
C3	52.00	30.00	35.32	99°19'06"	S44°28'36"W	45.73
C4	38.90	25.00	24.63	89°09'02"	N50°36'26"W	35.09
C5	39.64	25.00	25.37	90°50'58"	N50°36'26"W	35.62

QUARTER POINTS

C2	FL	ELEV.
	1	5168.68
	2	5168.53
	3	5168.24

C4	FL	ELEV.
	4	5159.27
	5	5159.11
	6	5158.95

C5	FL	ELEV.
	7	5158.68
	8	5158.80
	9	5158.20

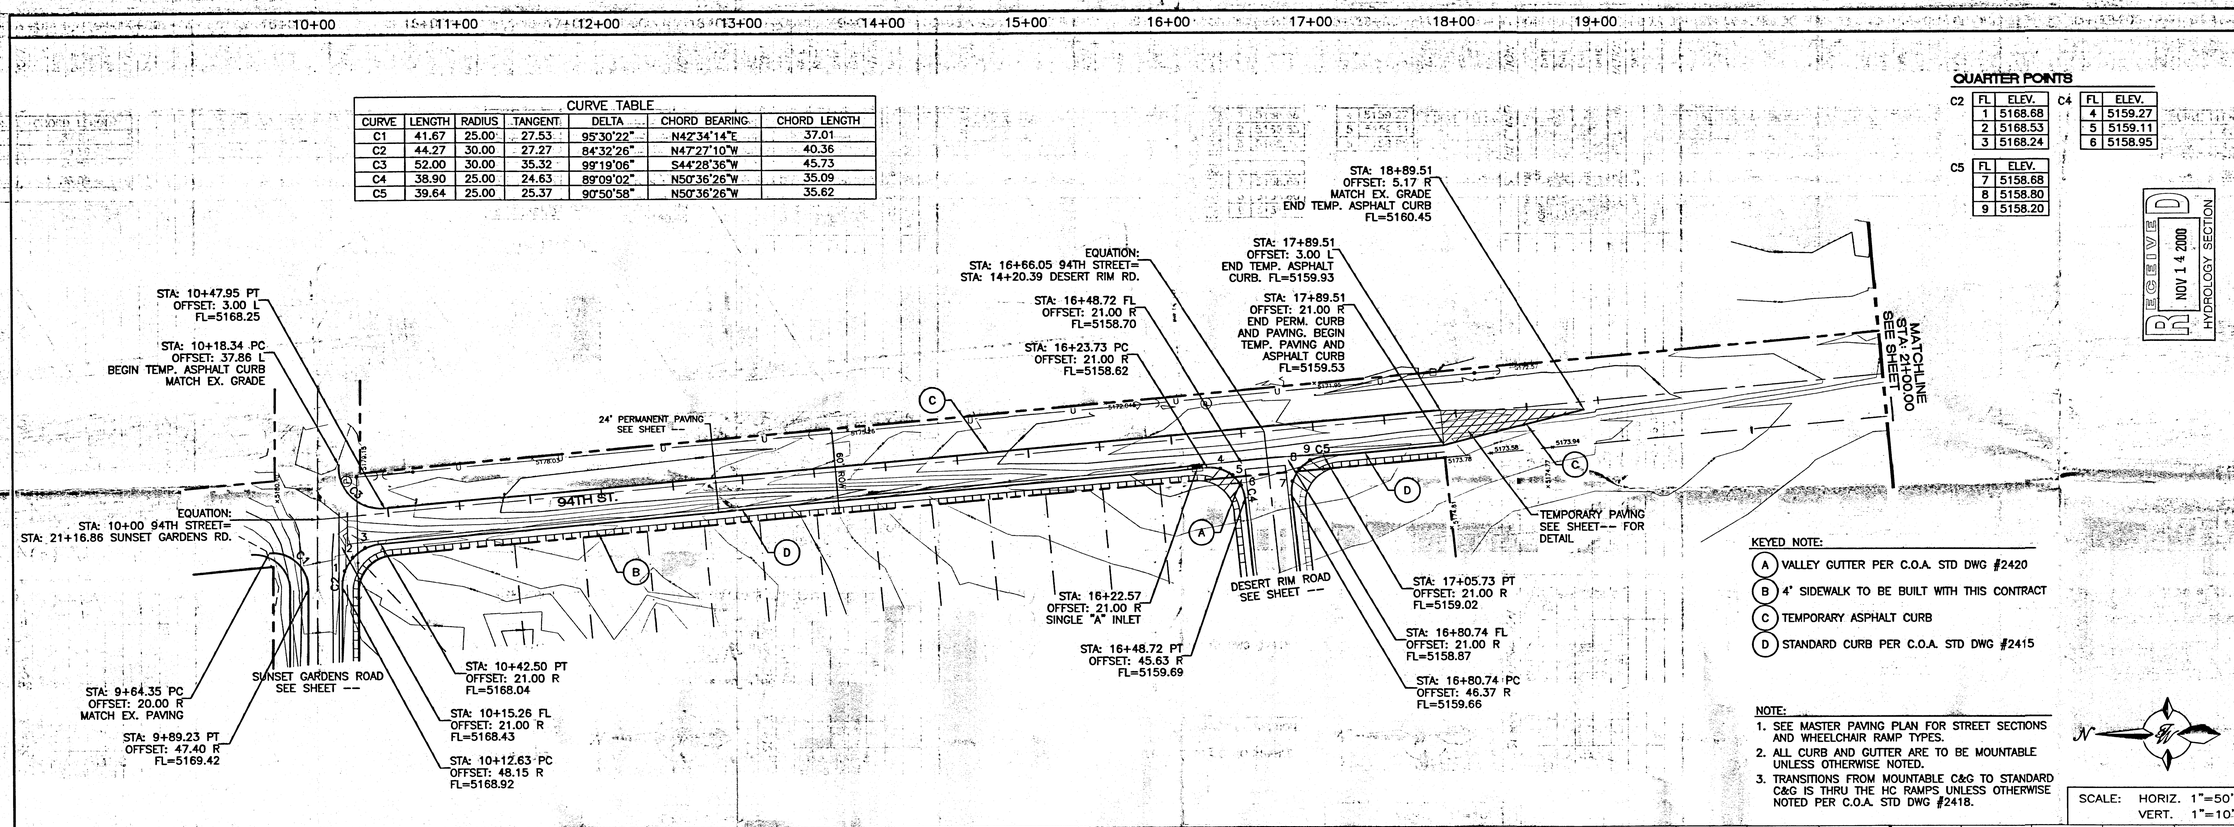

KEYED NOTE:

- (A) VALLEY GUTTER PER C.O.A. STD DWG #2420
- (B) 4' SIDEWALK TO BE BUILT WITH THIS CONTRACT
- (C) TEMPORARY ASPHALT CURB
- (D) STANDARD CURB PER C.O.A. STD DWG #2415

NOTE:

1. SEE MASTER PAVING PLAN FOR STREET SECTIONS AND WHEELCHAIR RAMP TYPES.
2. ALL CURB AND GUTTER ARE TO BE MOUNTABLE UNLESS OTHERWISE NOTED.
3. TRANSITIONS FROM MOUNTABLE C&G TO STANDARD C&G IS THRU THE HC RAMPS UNLESS OTHERWISE NOTED PER C.O.A. STD DWG #2418.

SCALE: HORIZ. 1"=50'
VERT. 1"=10'

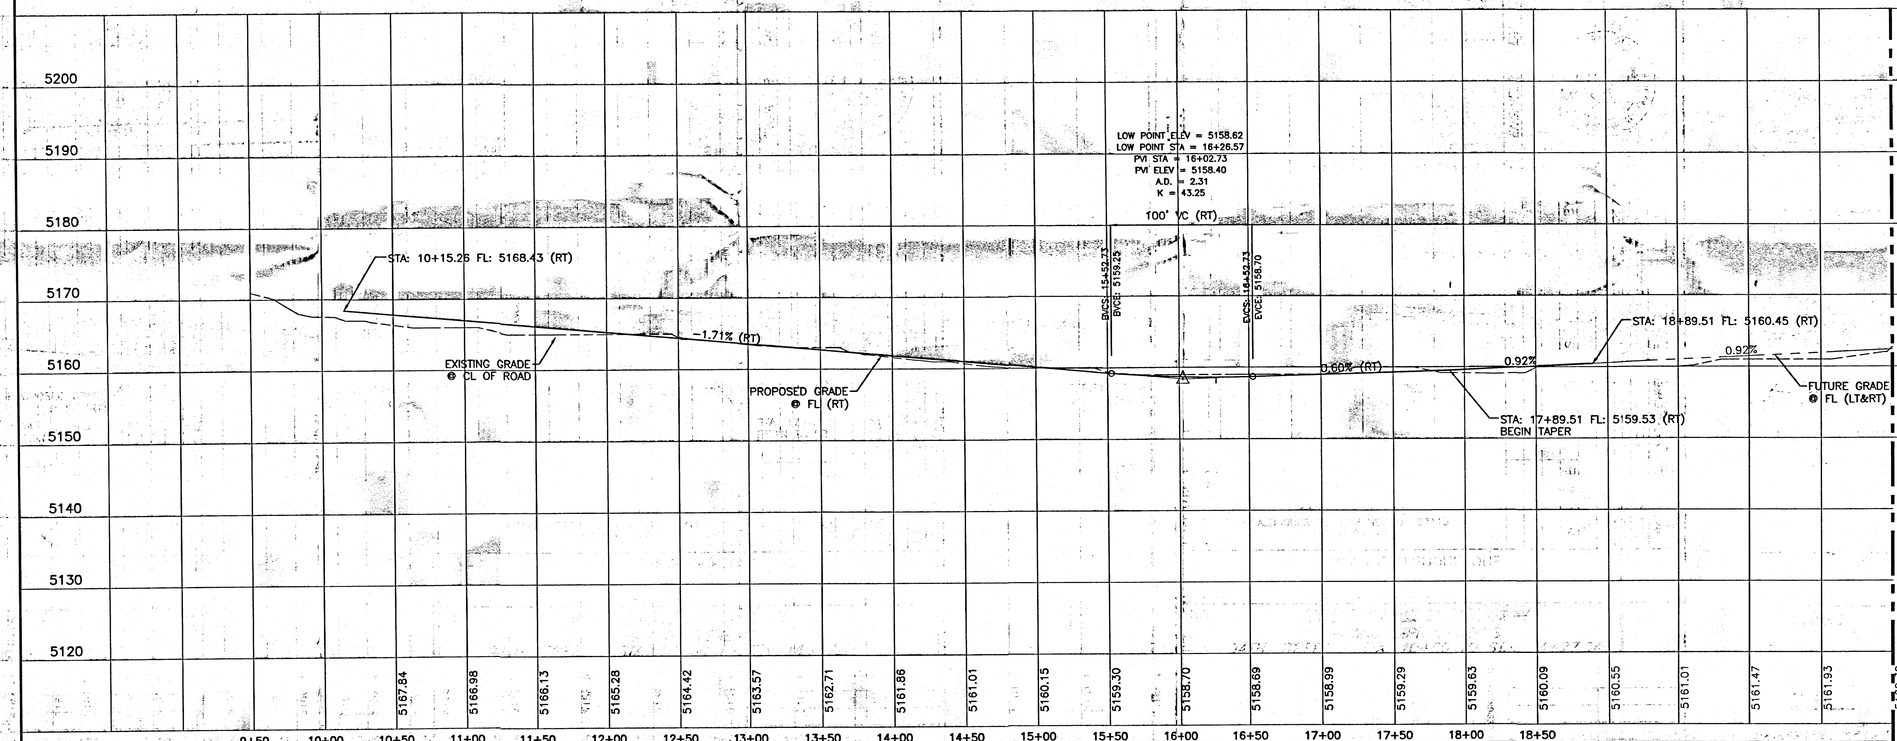

RECEIVED NOV 14 2000 HYDROLOGY SECTION

AS BUILT INFORMATION
CONTRACTOR
WORK STAKED BY
INSPECTOR'S ACCEPTANCE BY
FIELD VERIFICATION BY
DRAWINGS CORRECTED BY
DATE
MICRO-FILM INFORMATION
RECORDED BY
DATE
NO.

BENCH MARKS
ACS MONUMENT "10-L9"
CENTRAL STATION DATA
NM STATE PLANE COORDINATES
Central Zone
X=352,794.84
Y=1,482,084.51
G-G=0.999967602
Dg=-0°16'39"
EL=5204.43,

SURVEY INFORMATION
FIELD NOTES
NO. BY DATE

ENGINEER'S SEAL
GERALD RAY BATTAVIANI
NEW MEXICO
10-13-2000
PROFESSIONAL ENGINEER

NO.	DATE	REMARKS: REVISIONS	BY
		DESIGN	
		DESIGNED BY RRB	DATE 10-00
		DRAWN BY BDG	DATE 11-10-00
		DRAWN NAME: 94TH STREET PP.DWG	DATE 10-00
		CHECKED BY RRB	

TIERRA WEST, LLC
8509 JEFFERSON NE
ALBUQUERQUE, NEW MEXICO 87113
(505)858-3100

CITY OF ALBUQUERQUE
PUBLIC WORKS DEPARTMENT
ENGINEERING GROUP

RECEIVED NOV 14 2000 HYDROLOGY SECTION

TITLE: **DESERT PINE SUBDIVISION**
PAVING IMPROVEMENTS
94TH STREET / STA: 10+00 TO STA: 14+77.94

DESIGN REVIEW COMMITTEE	CITY ENGINEER APPROVAL	LAST DESIGN UPDATE	MO./DAY/YR.	MO./DAY/YR.

CITY PROJECT NO.	ZONE MAP NO.	SHEET	OF
–	L-9-Z	–	