



CITY OF ALBUQUERQUE
DEPARTMENT OF PUBLIC WORKS

PLANS
FOR CONSTRUCTION
OF

SAN JOSE DRAINAGE IMPROVEMENTS

1	2	3	4	5	6	7	8	9	10	11	12	13	14	15	16	17	18	19	20	21	22	23	24	25	26	27	28	29
0	8	7	0	4	0	1	7	0						2	0			2	0									


10

HARMAN OF THE CITY COMMISSION & EX-OFFICIO MAYOR *Charles E. Bernhardt*
CITY MANAGER *David W. McHugh*
CITY ATTORNEY *Frank Nelson*

DIRECTOR OF PUBLIC WORKS *F. F. Herkenhoff*
CITY ENGINEER *William J. Stevens*



GORDON HERKENHOFF AND ASSOCIATES
ENGINEERS
PLANNERS
AS CONSTRUCTED

 

AS CONSTRUCTED


ALBUQUERQUE, NEW MEXICO
SAN JOSE DRAINAGE IMPROVEMENTS

LOCATION MAP


GORDON HERKENHOFF & ASSOCIATES, INC.
CONSULTING ENGINEERS
ALBUQUERQUE NEW MEXICO

SCALE 1" = 1000'	DATE MARCH, 1970	DRAWN: G.C. CHECKED: R.D.M.	SHEET 2 OF 10
---------------------	---------------------	--------------------------------	------------------
















08 704 0270 21 21

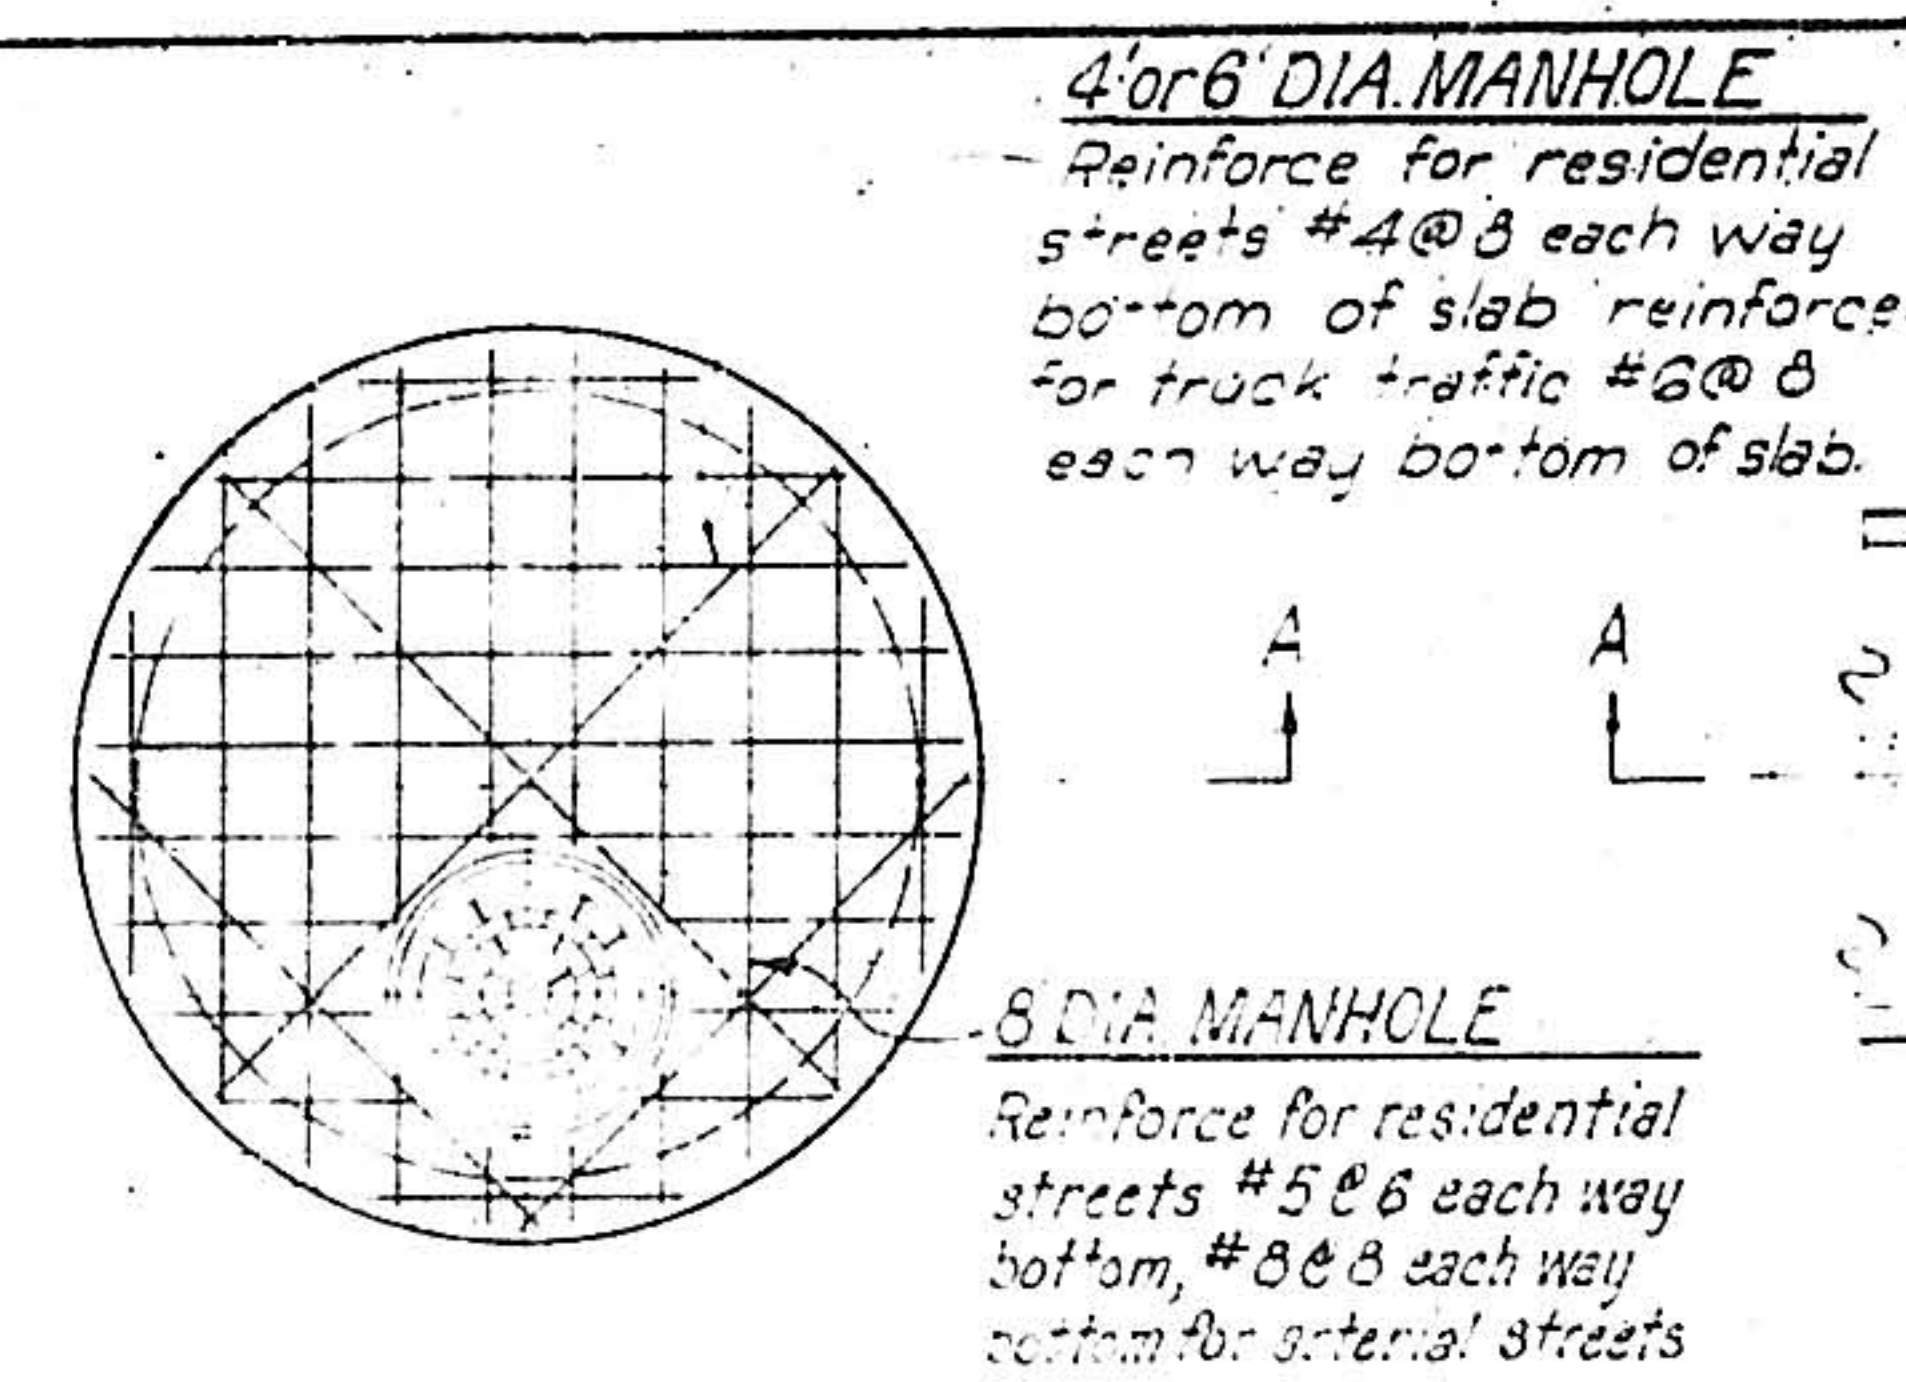

TOP PLAN OF TYPE A
SCALE: 3/8" = 1'-0"


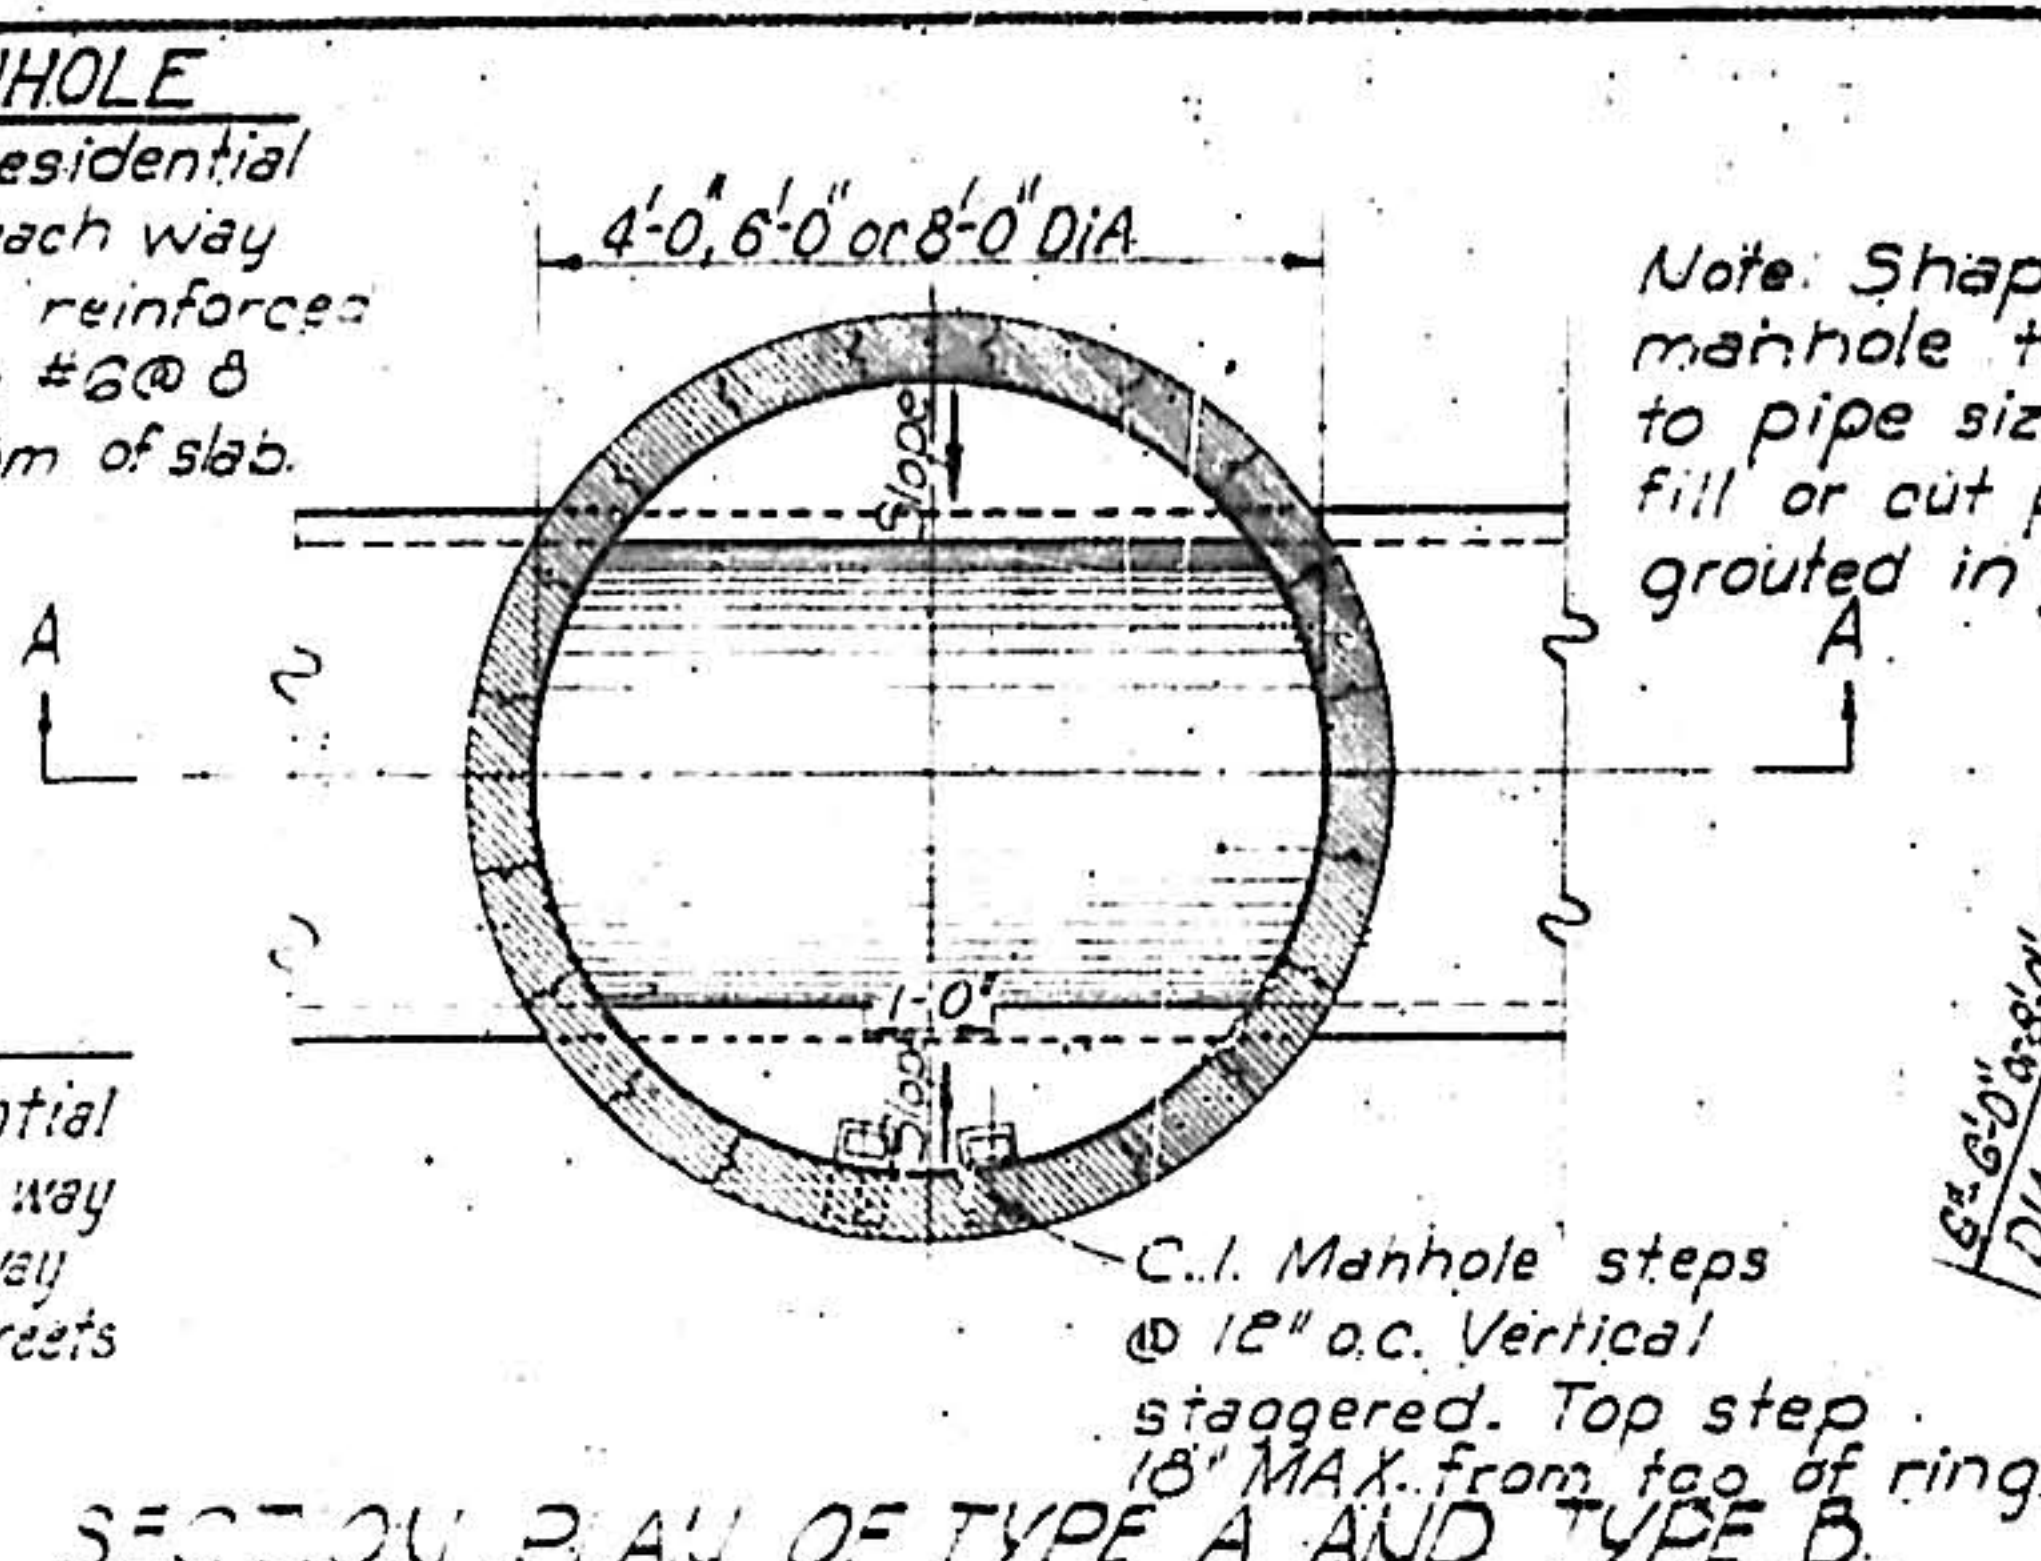


Note: Shape invert of manhole to conform to pipe size by concrete fill or cut pipe section grouted in place.

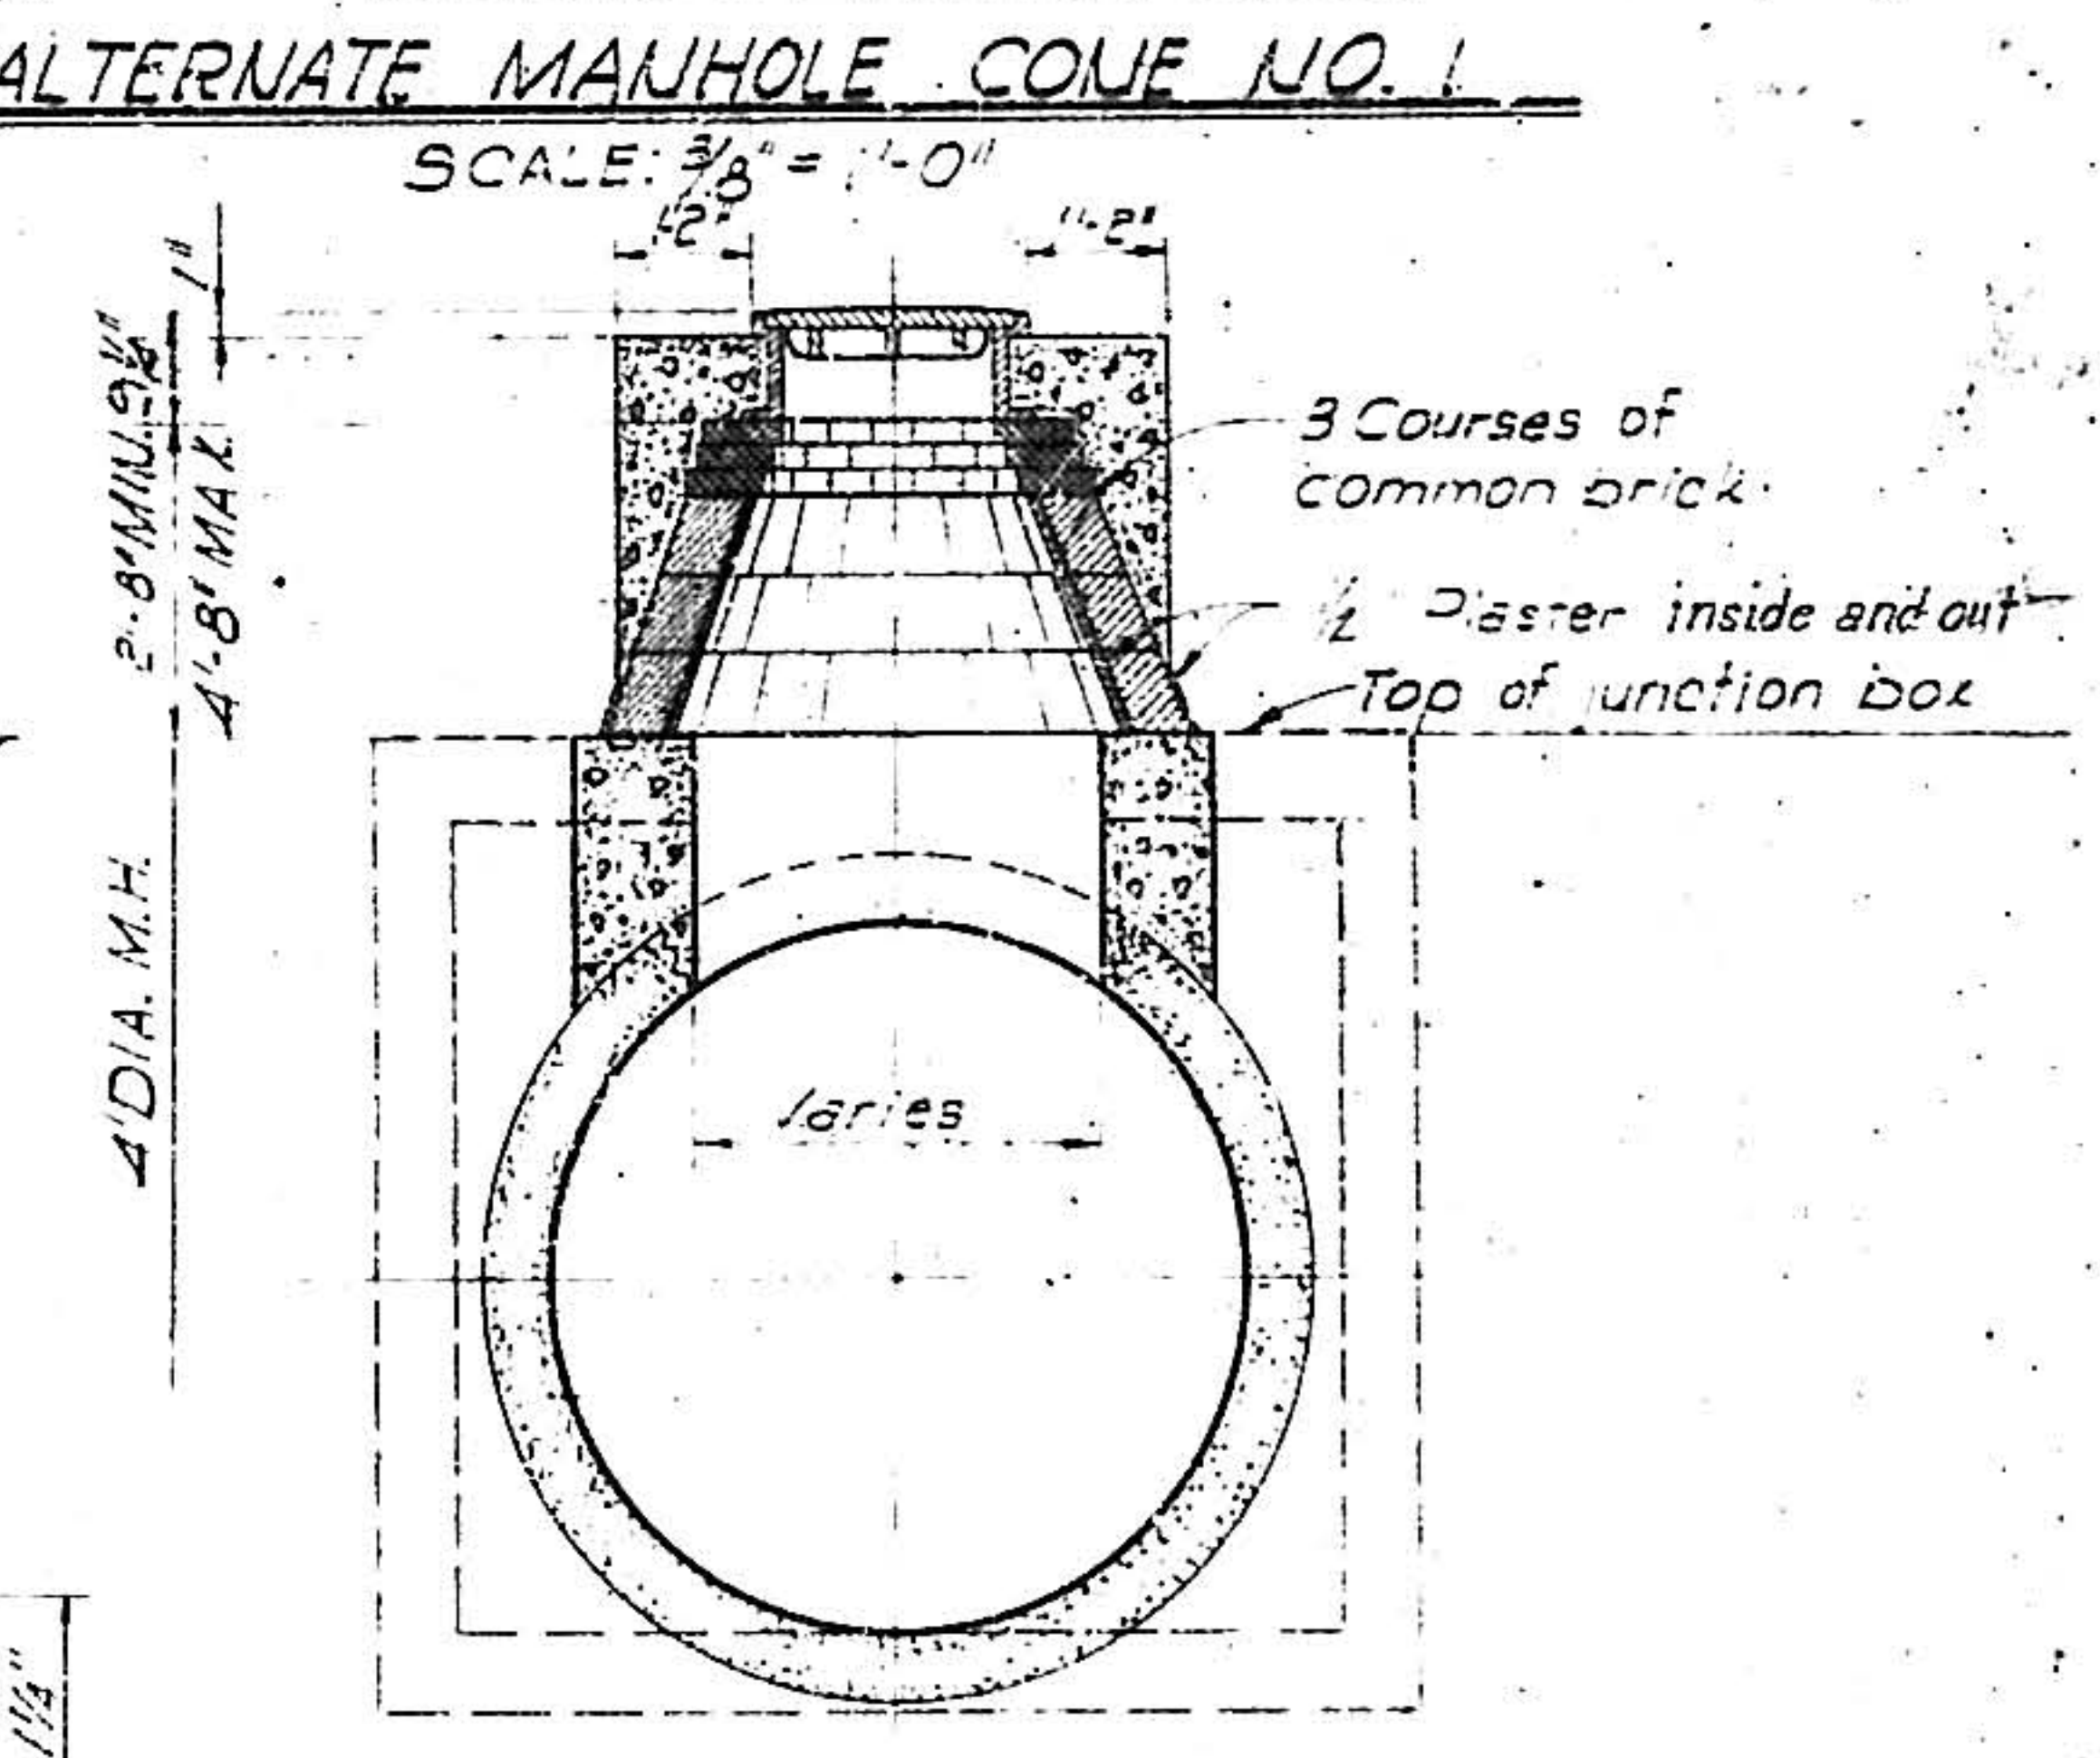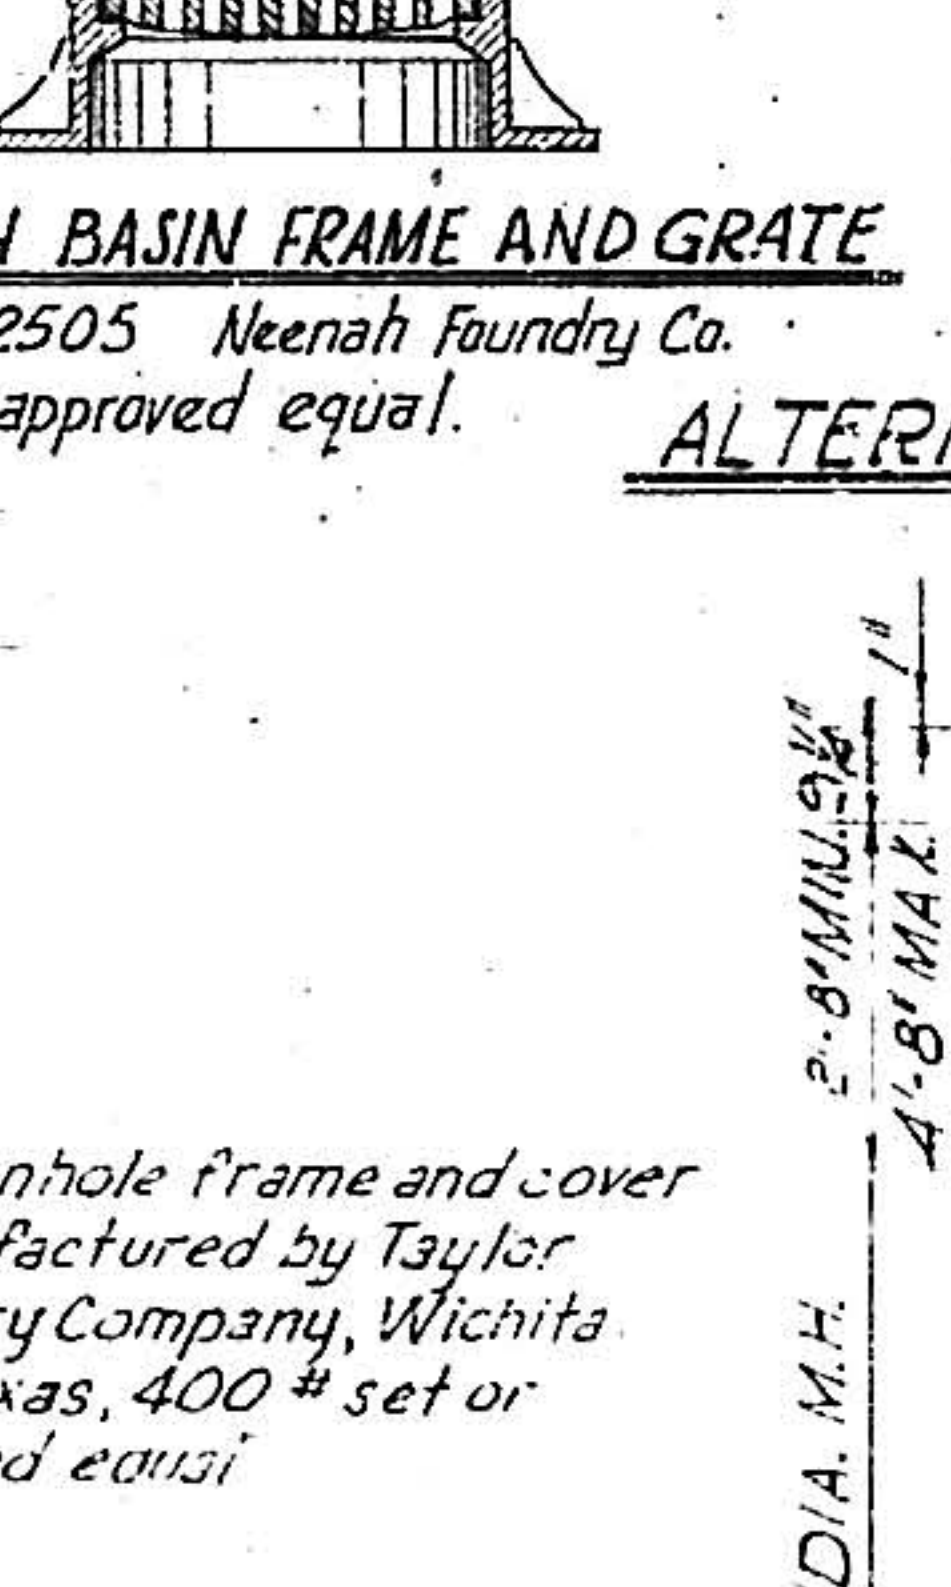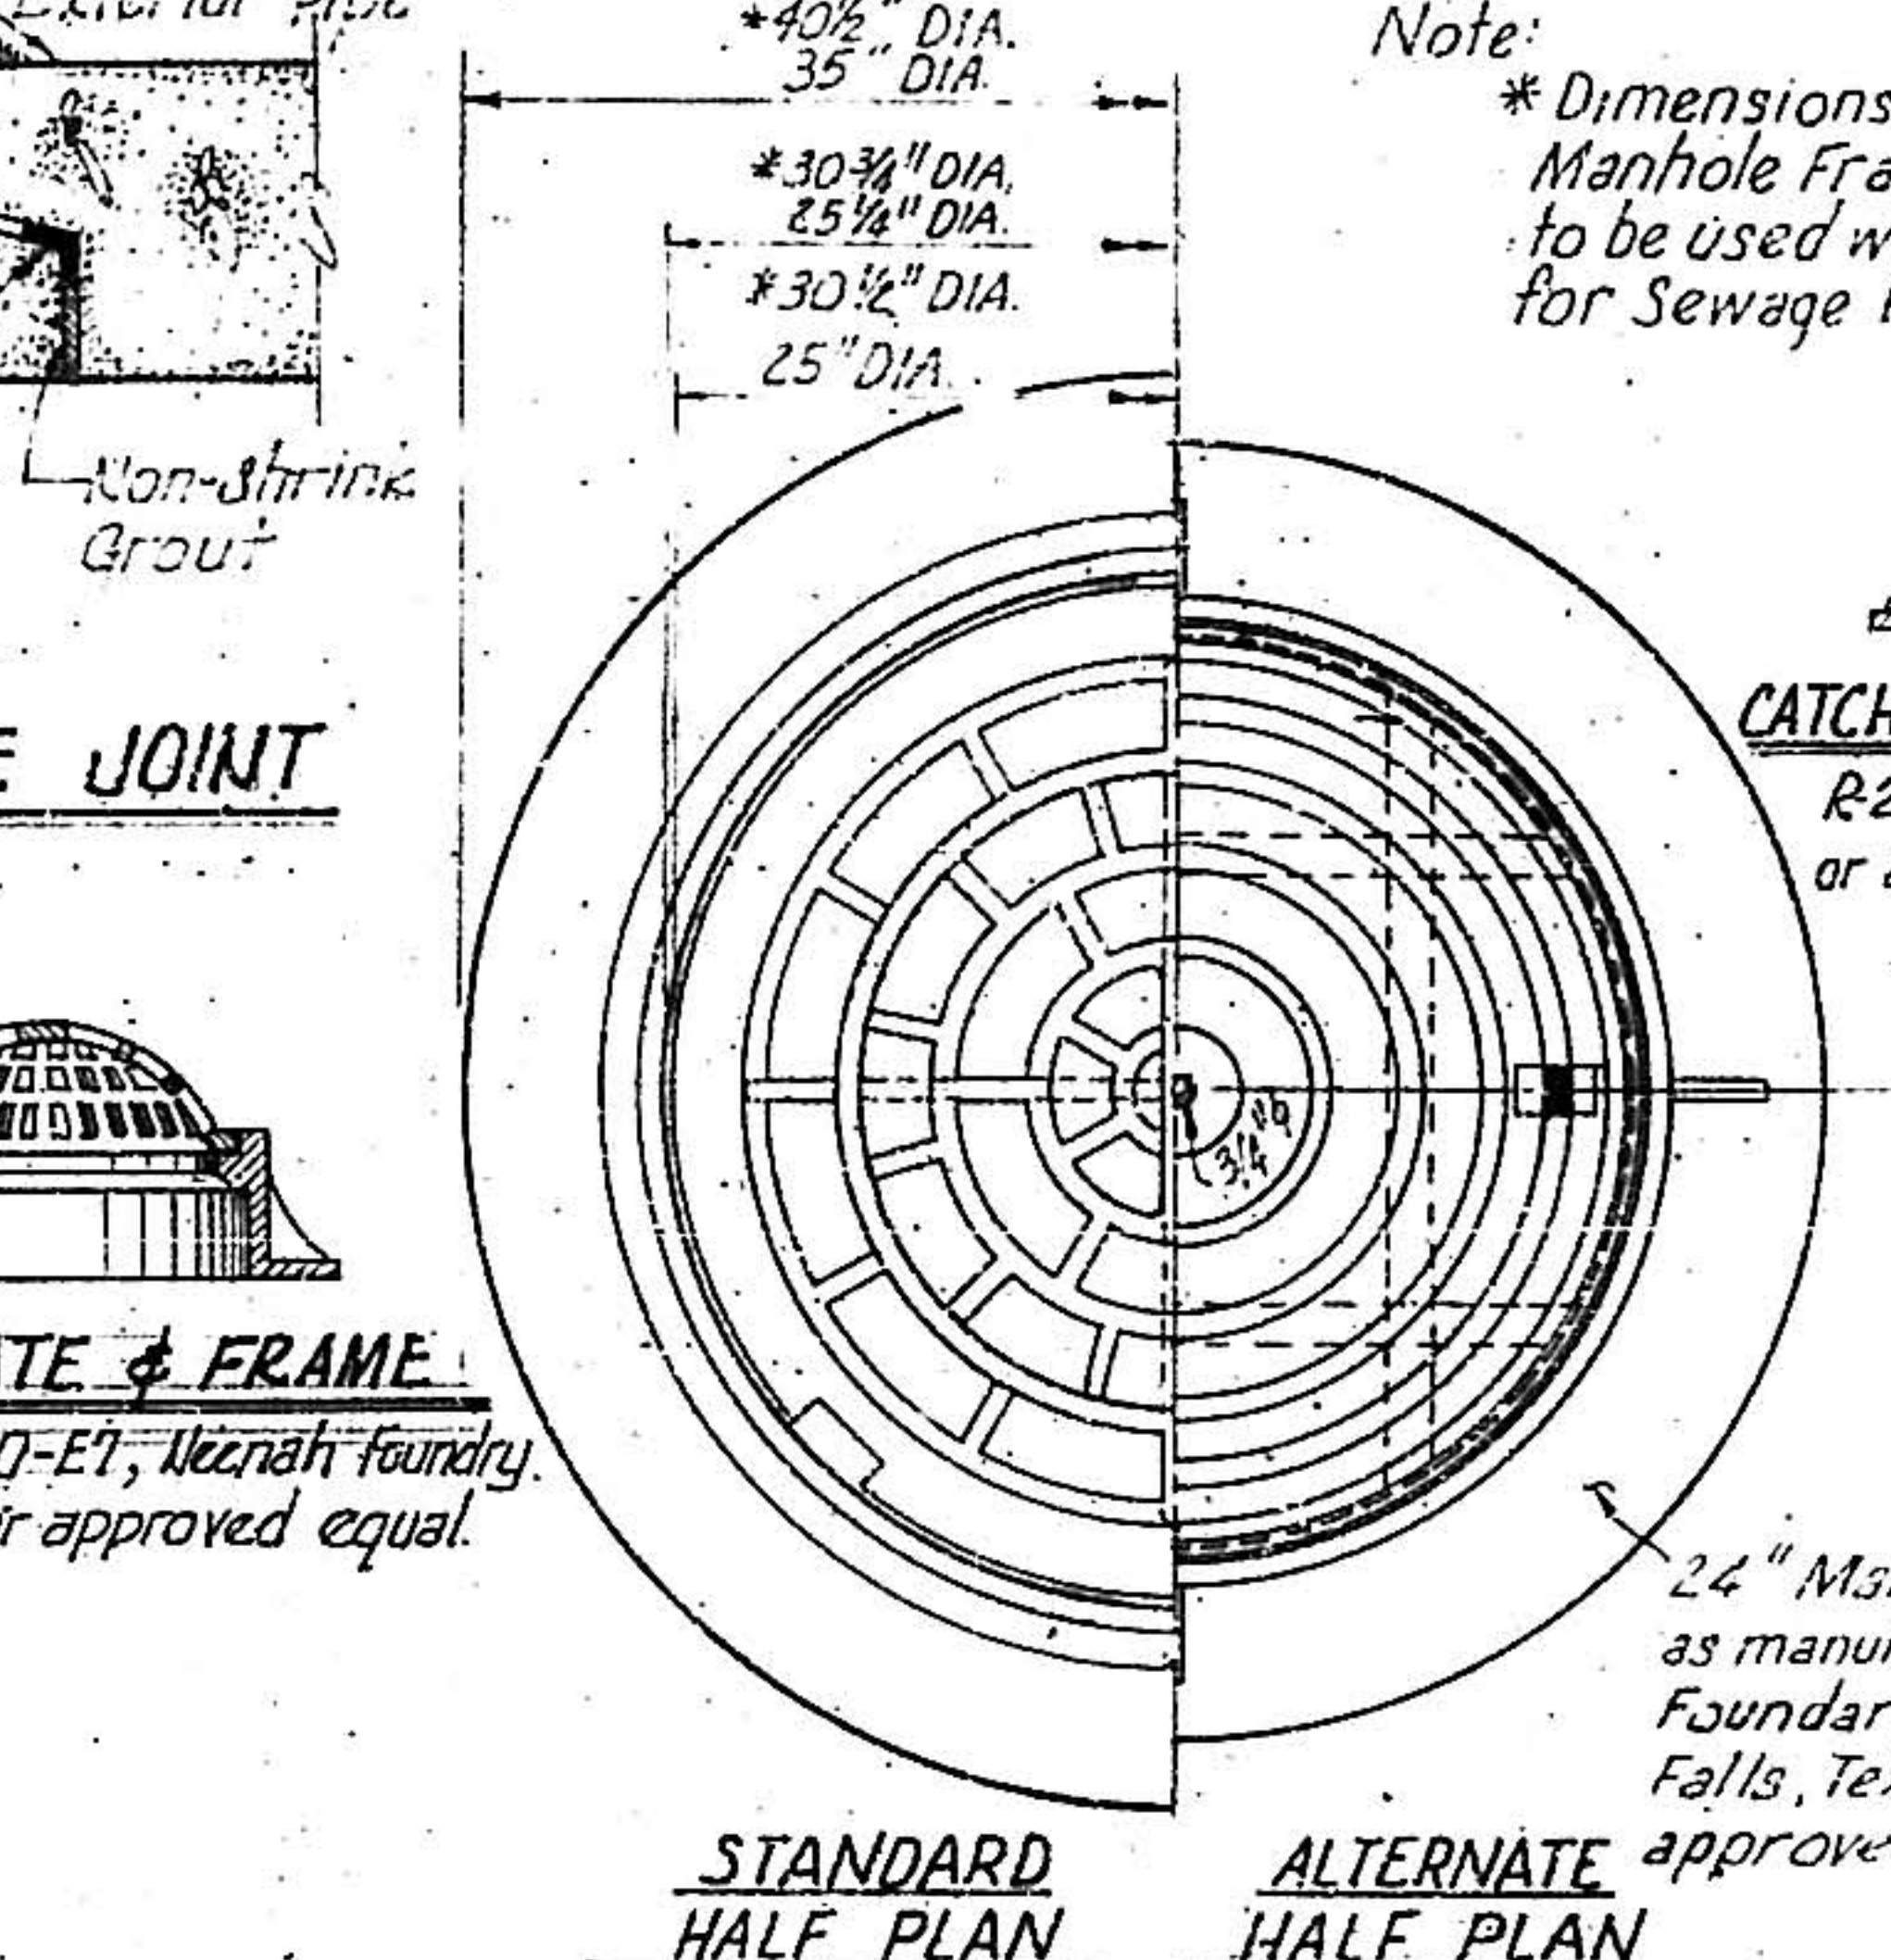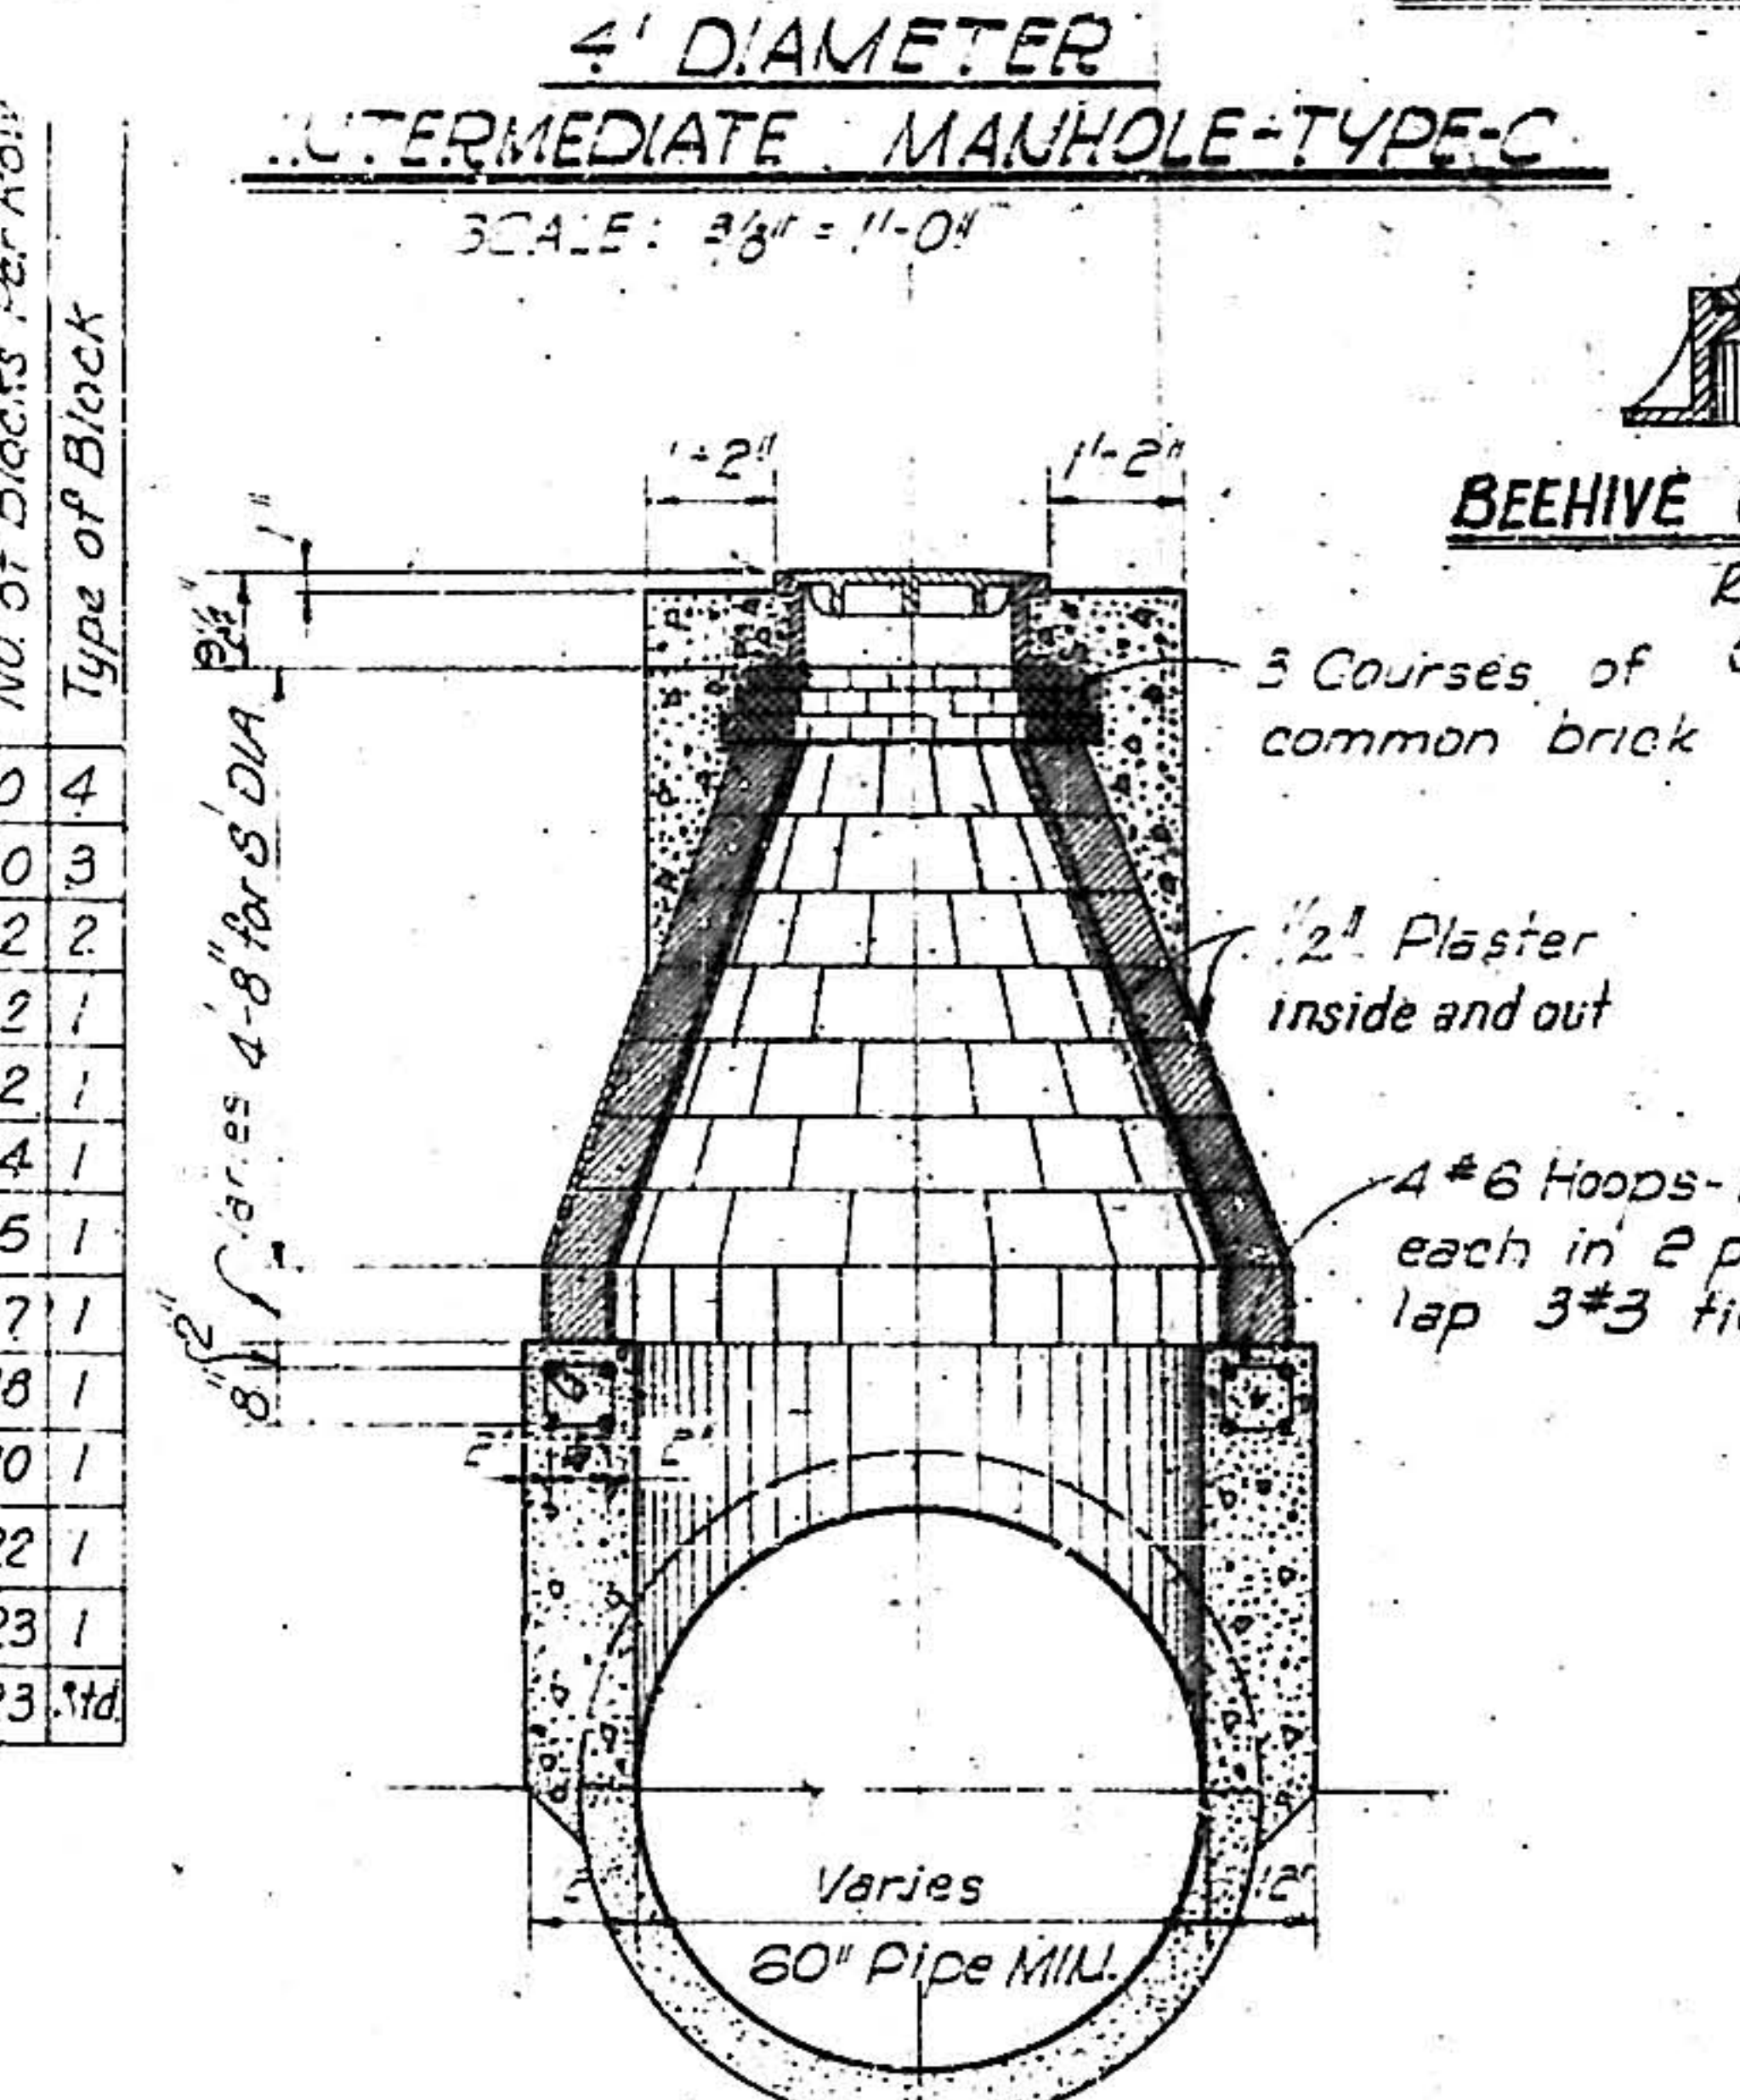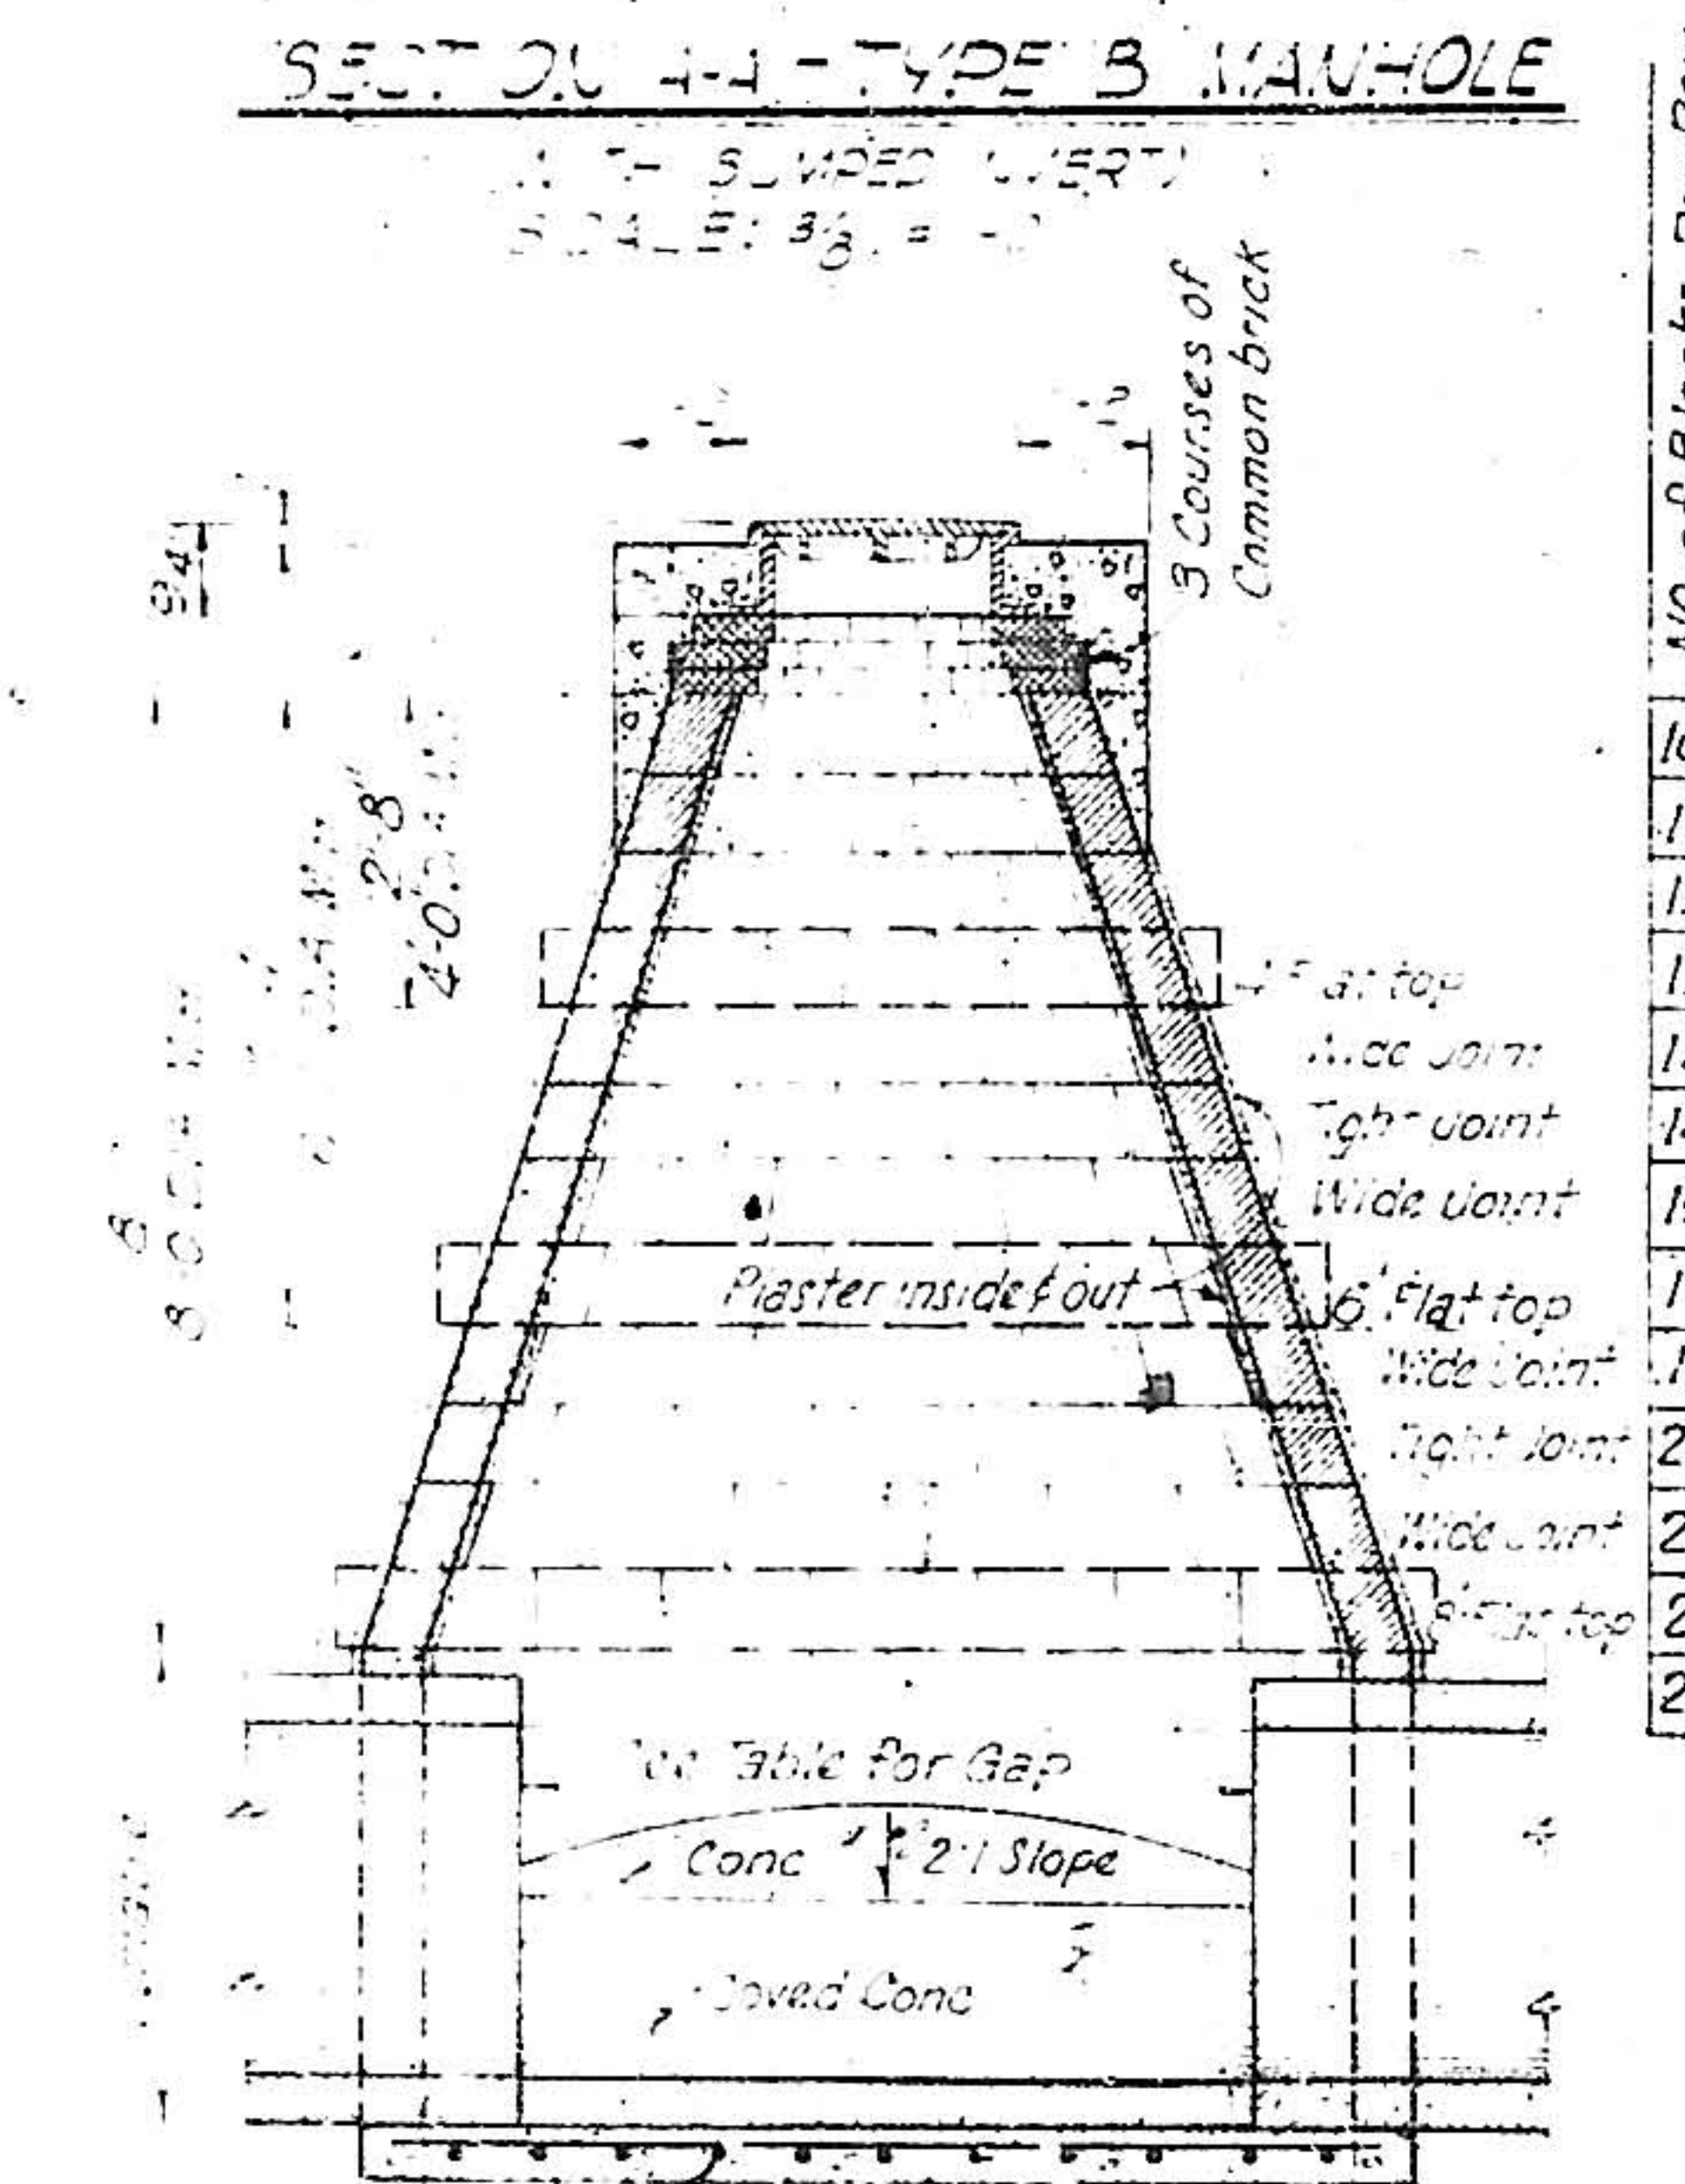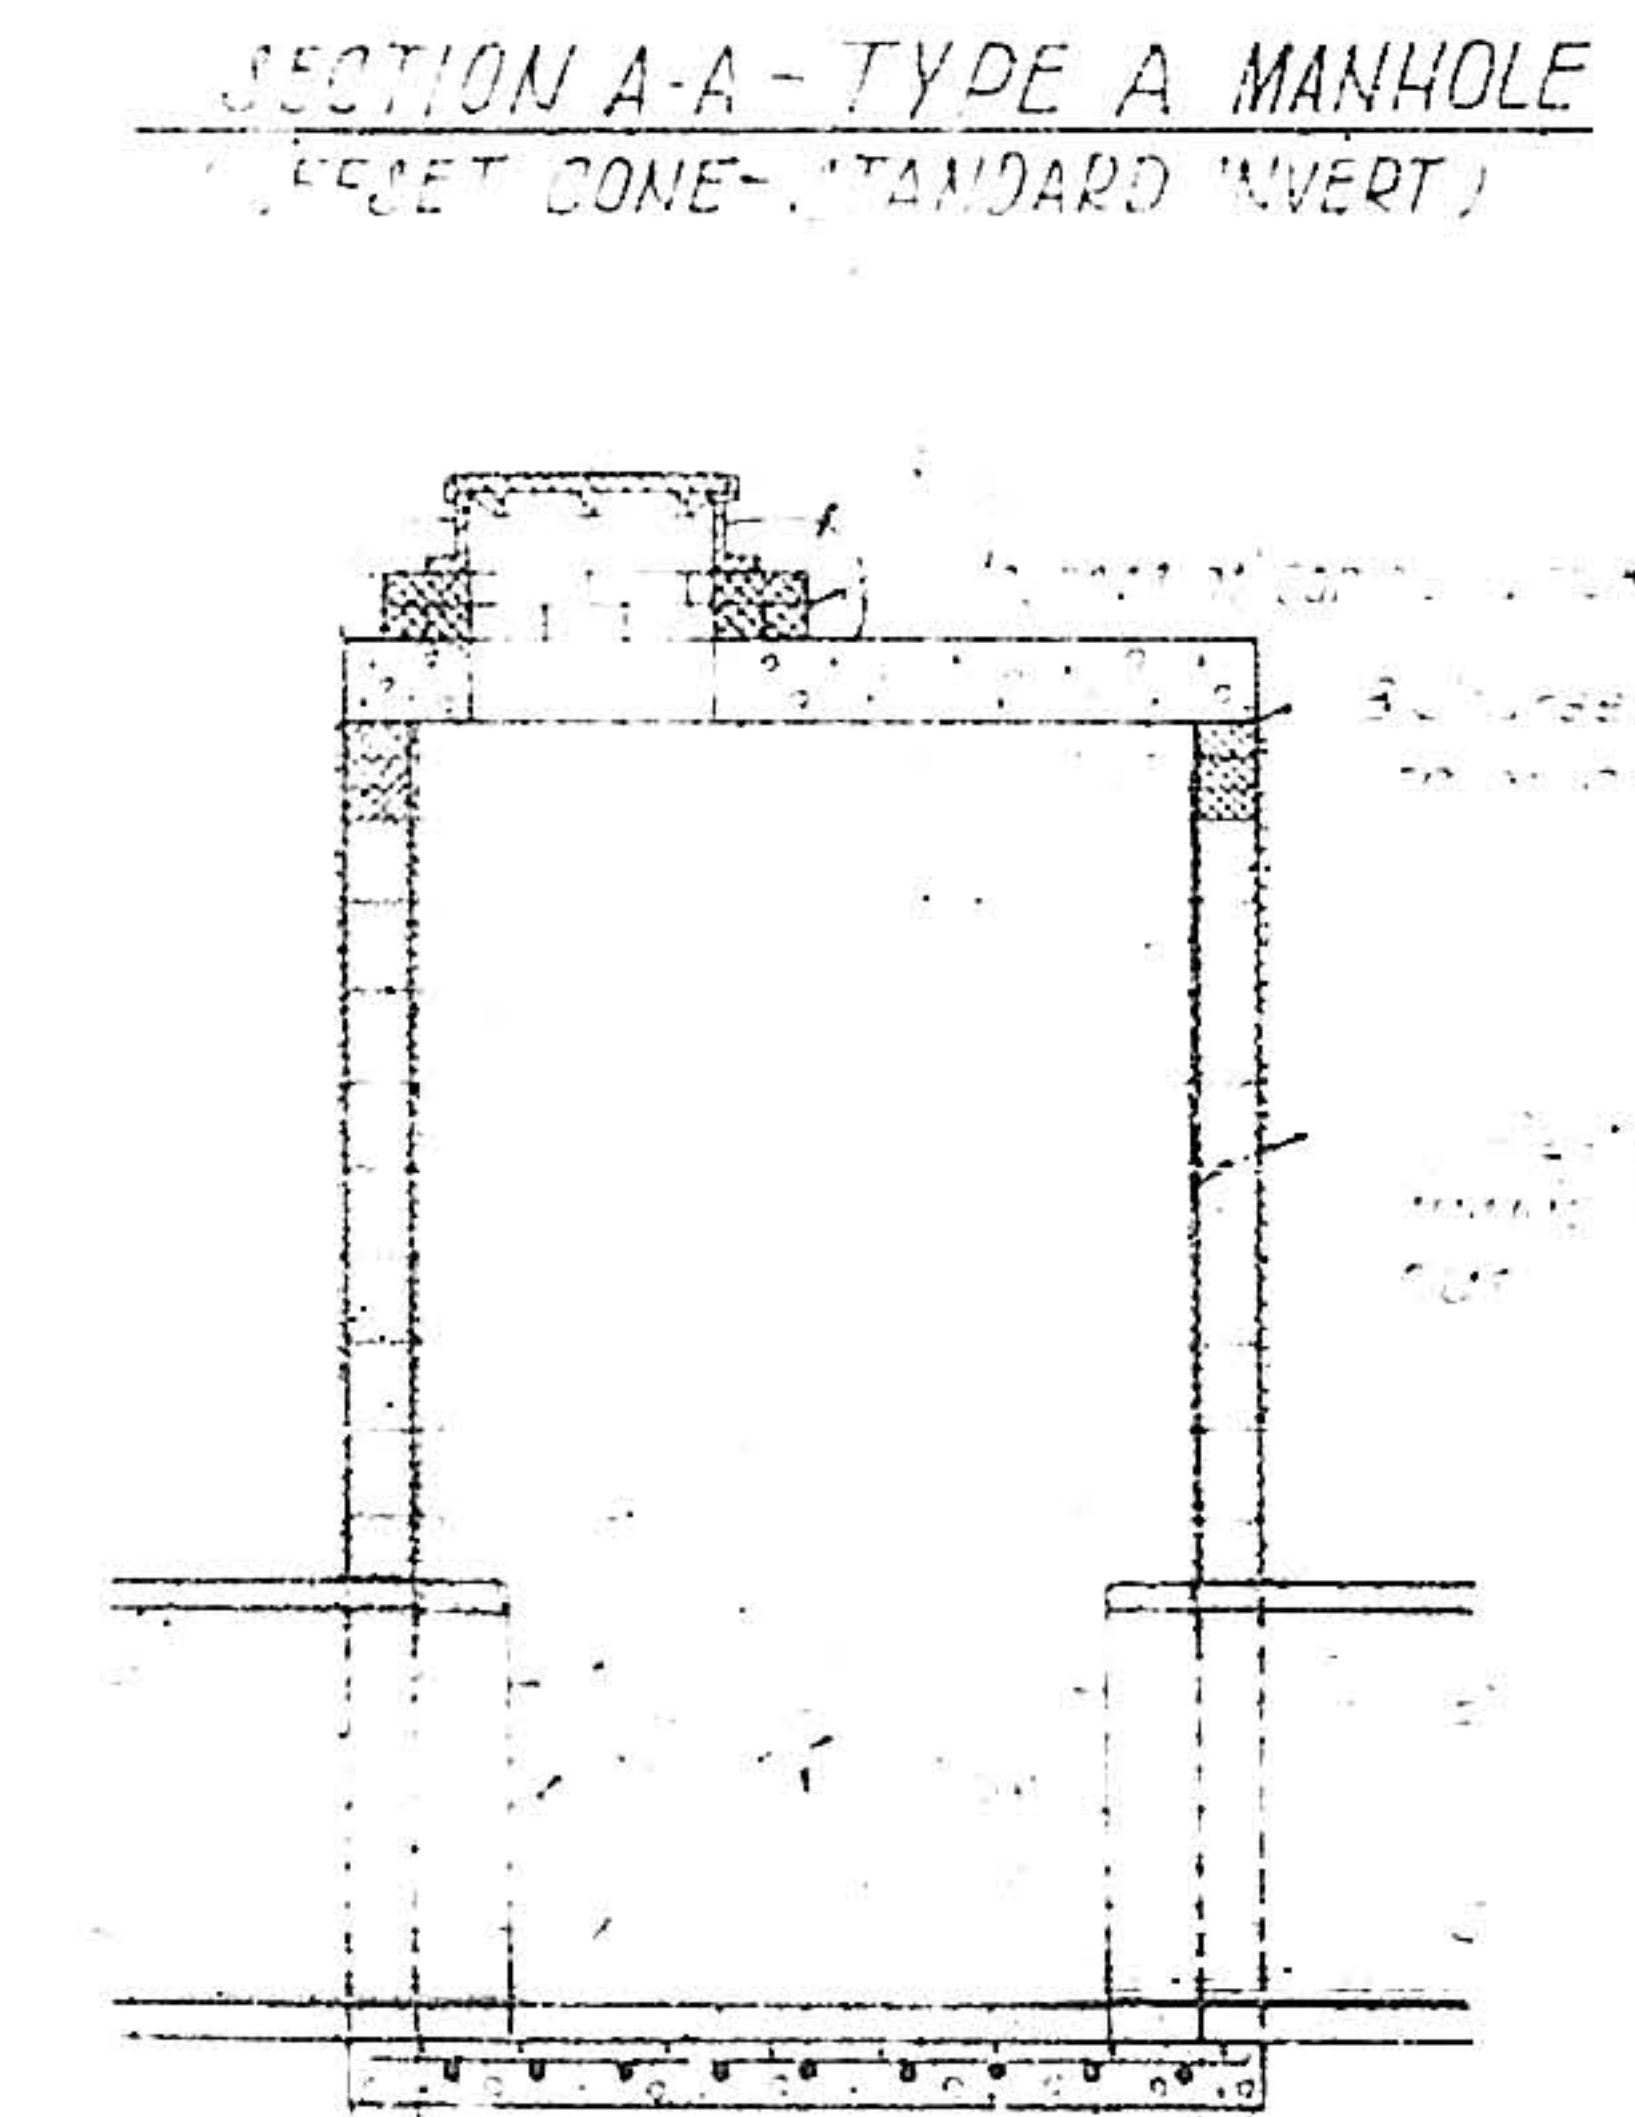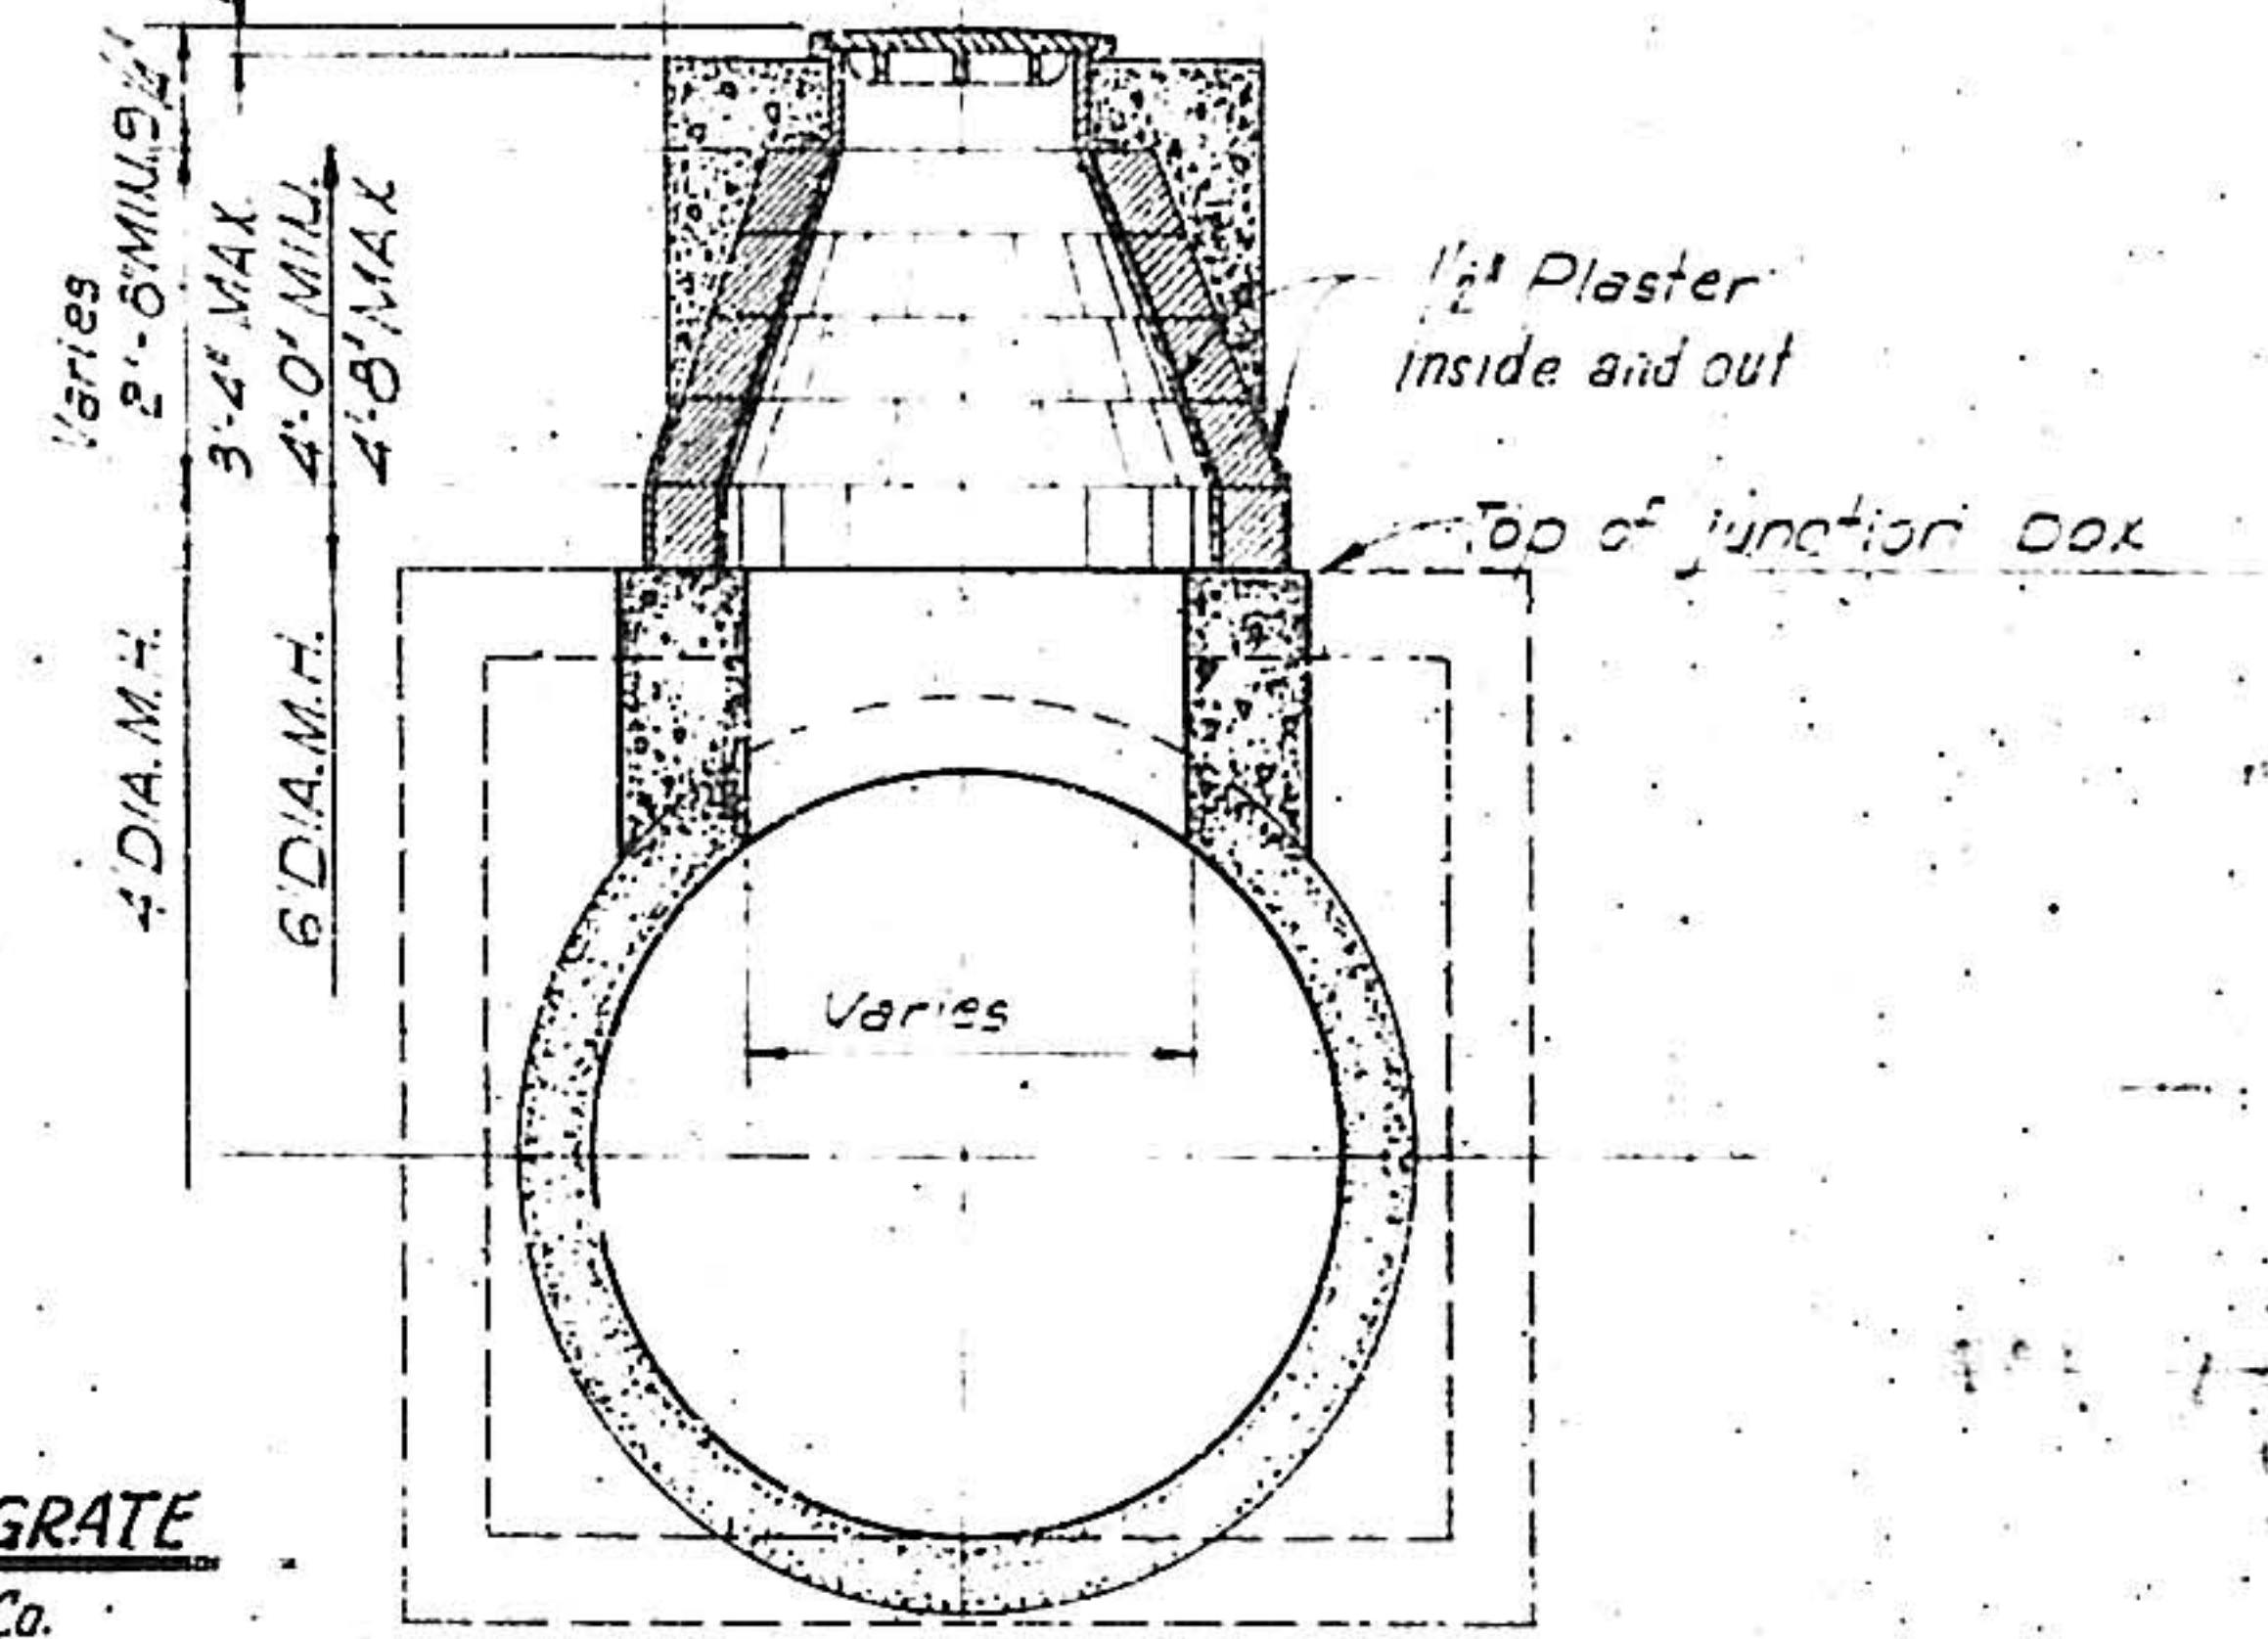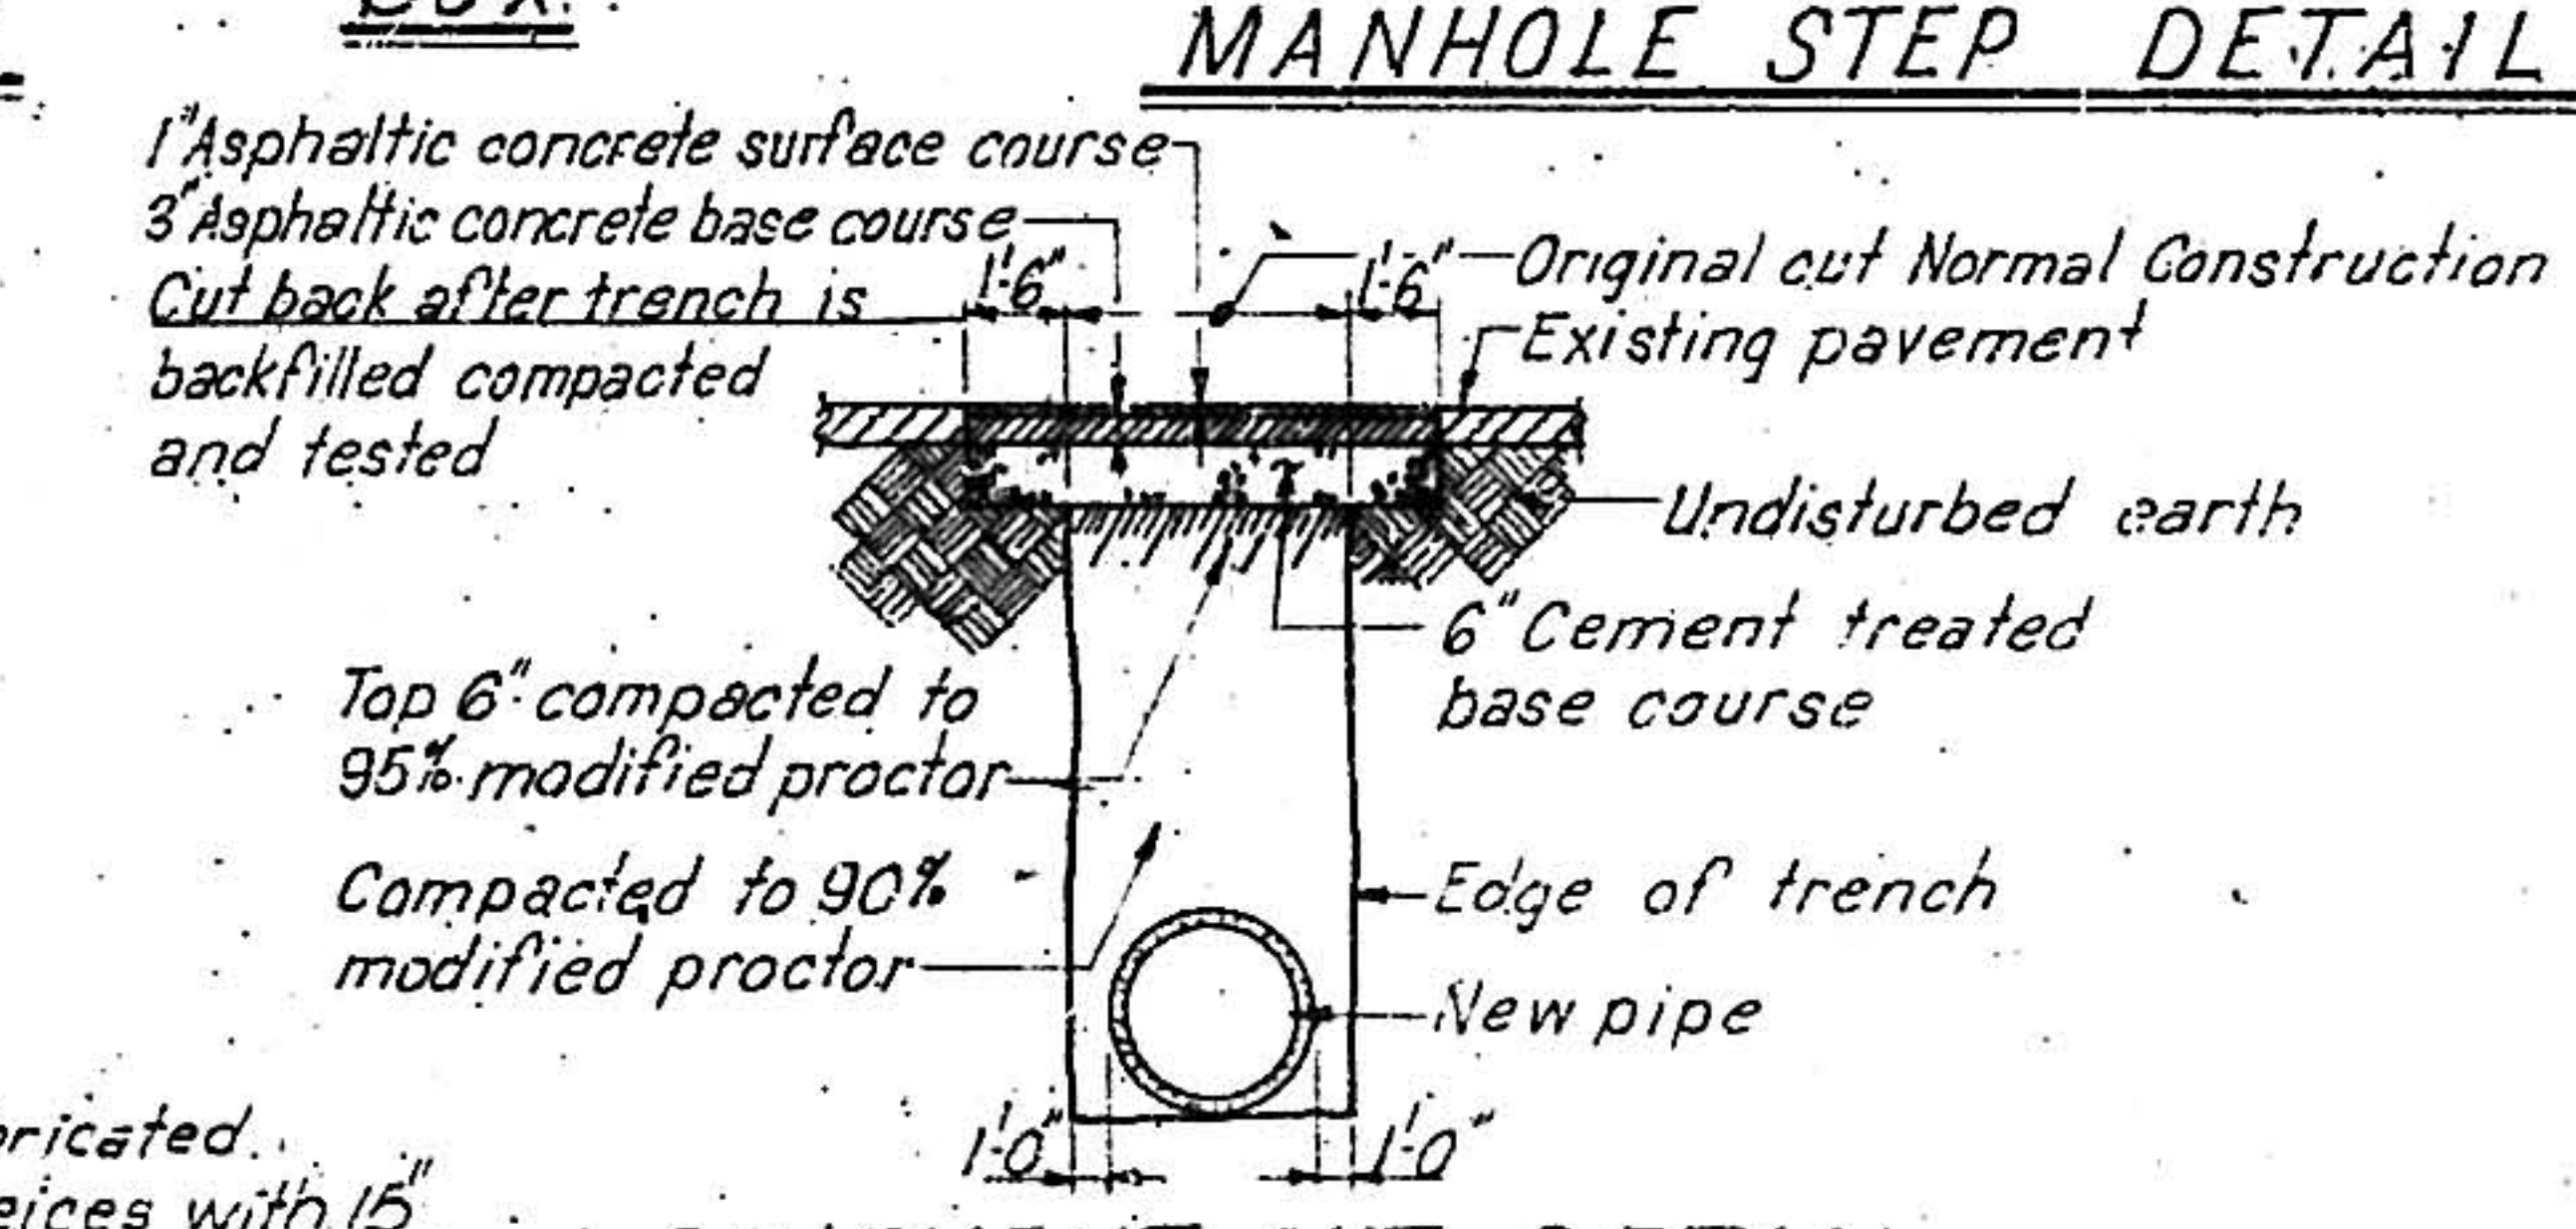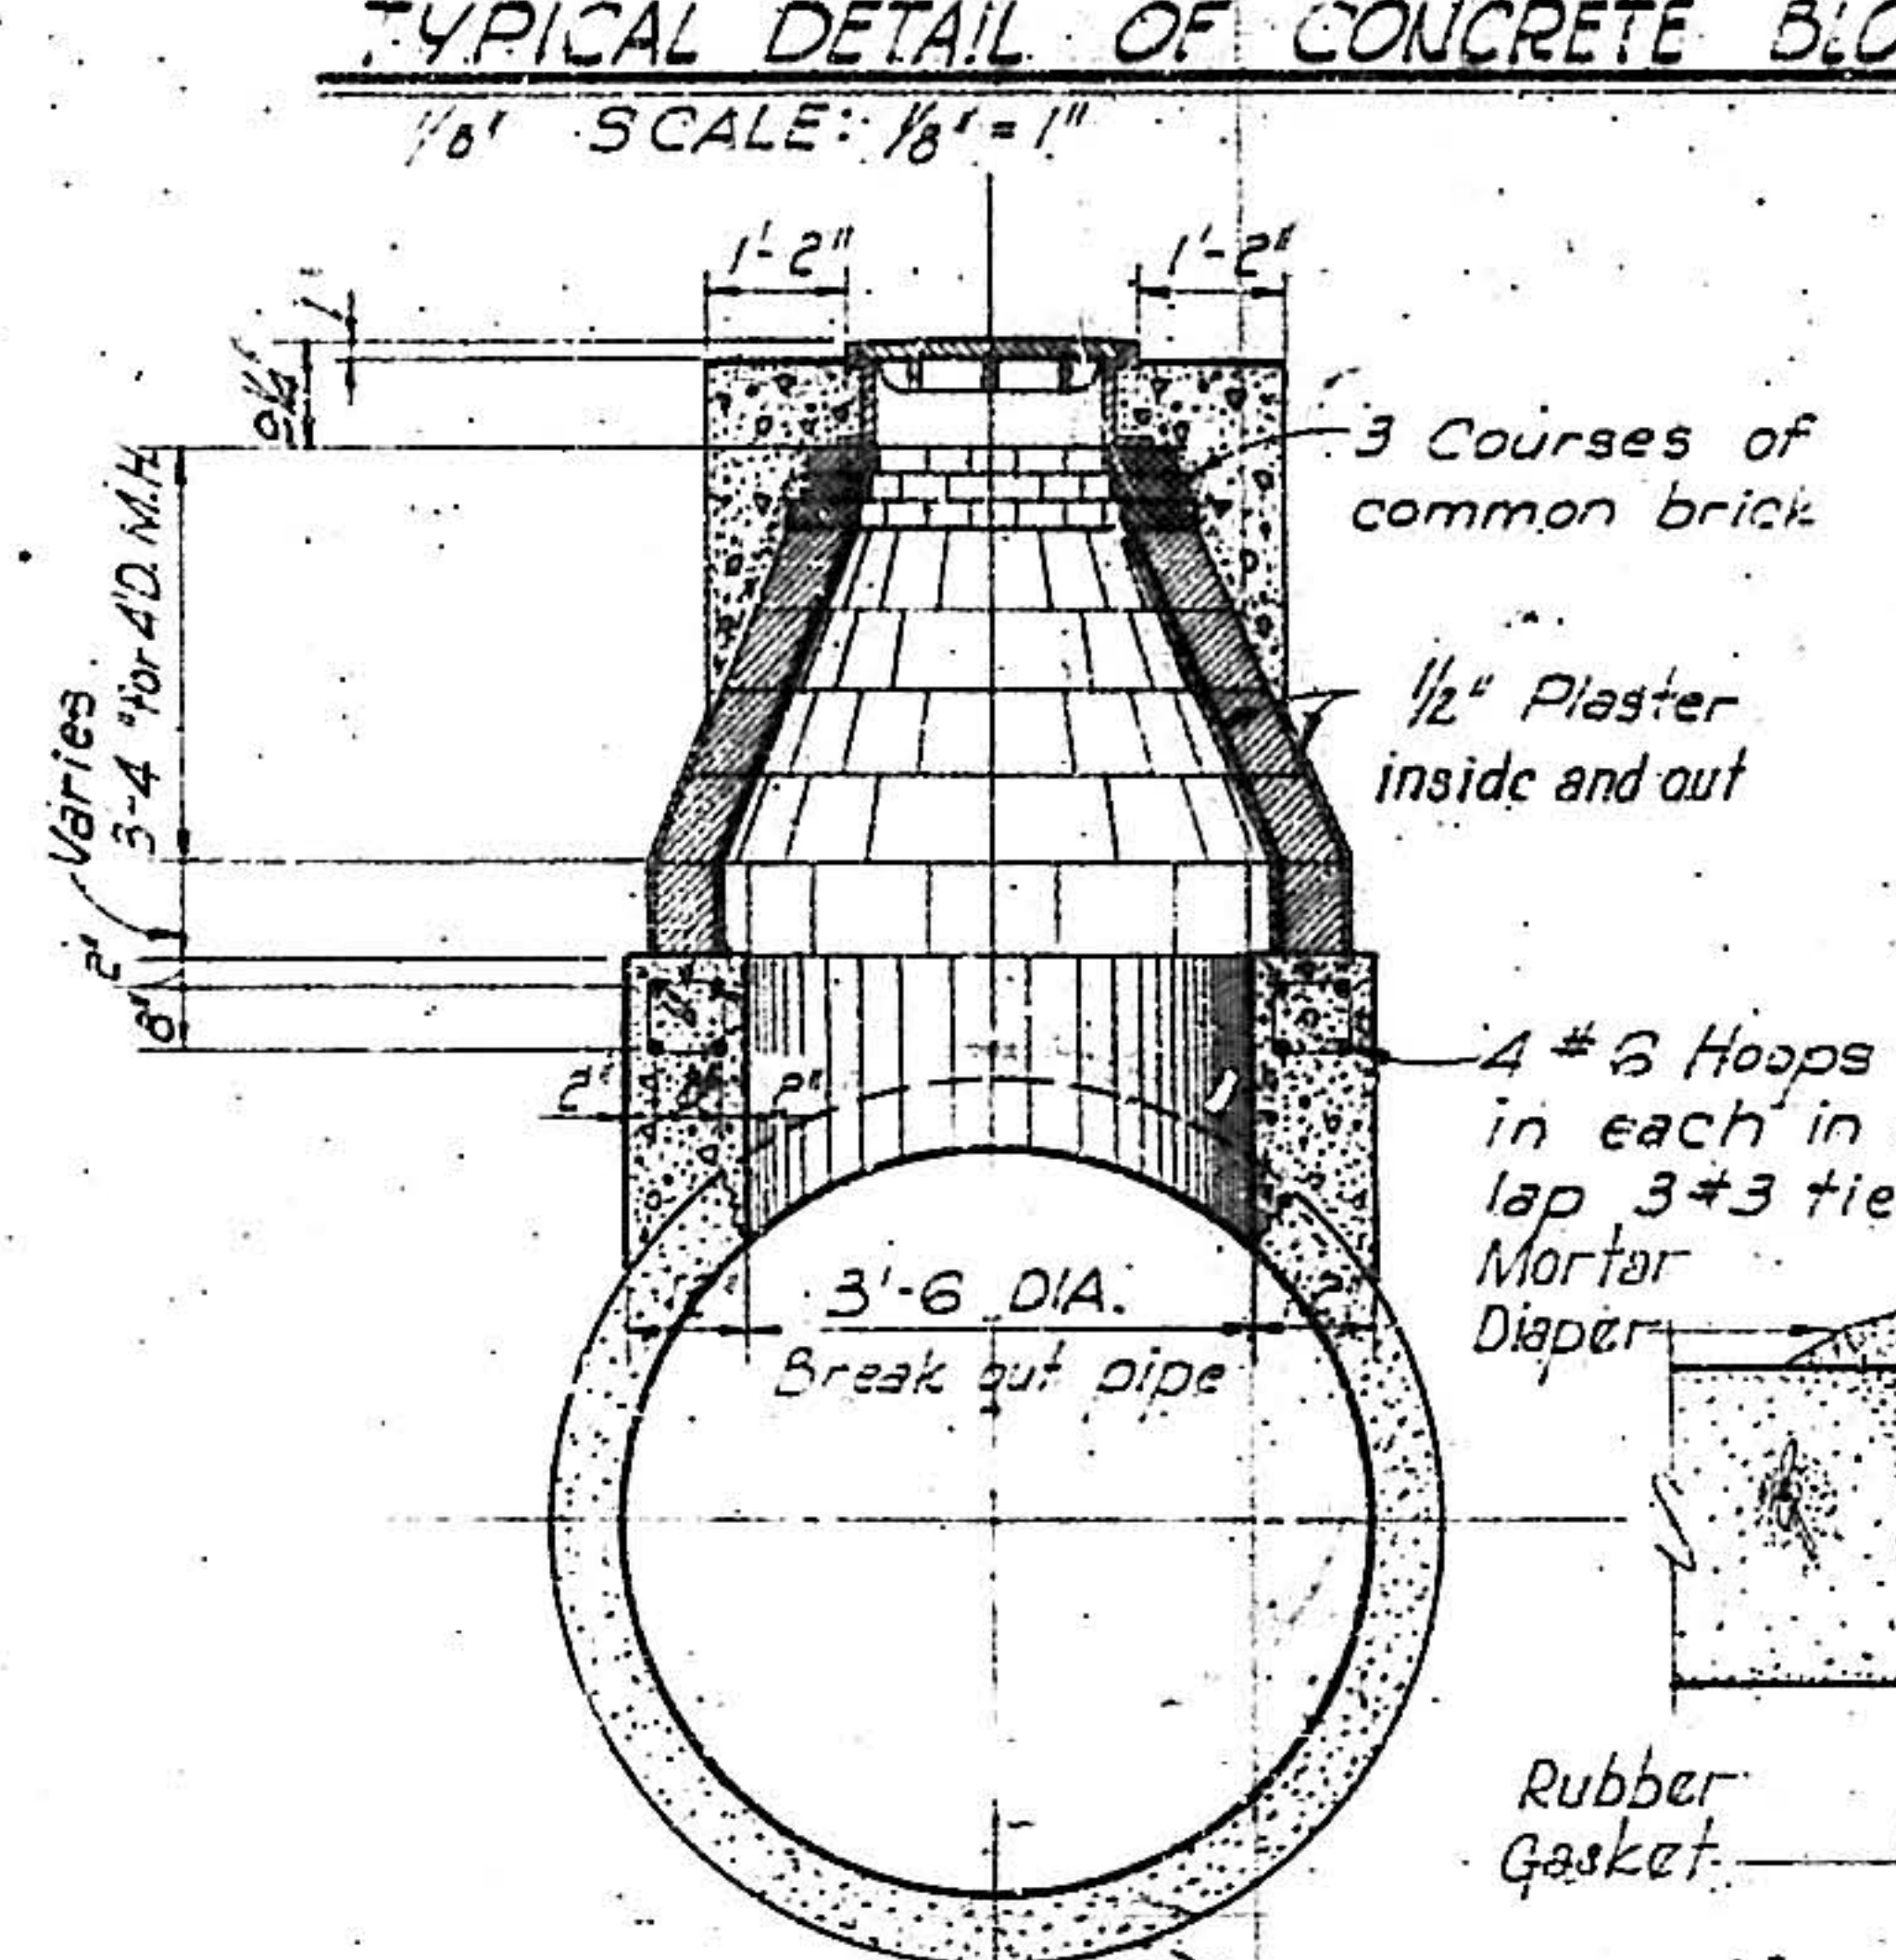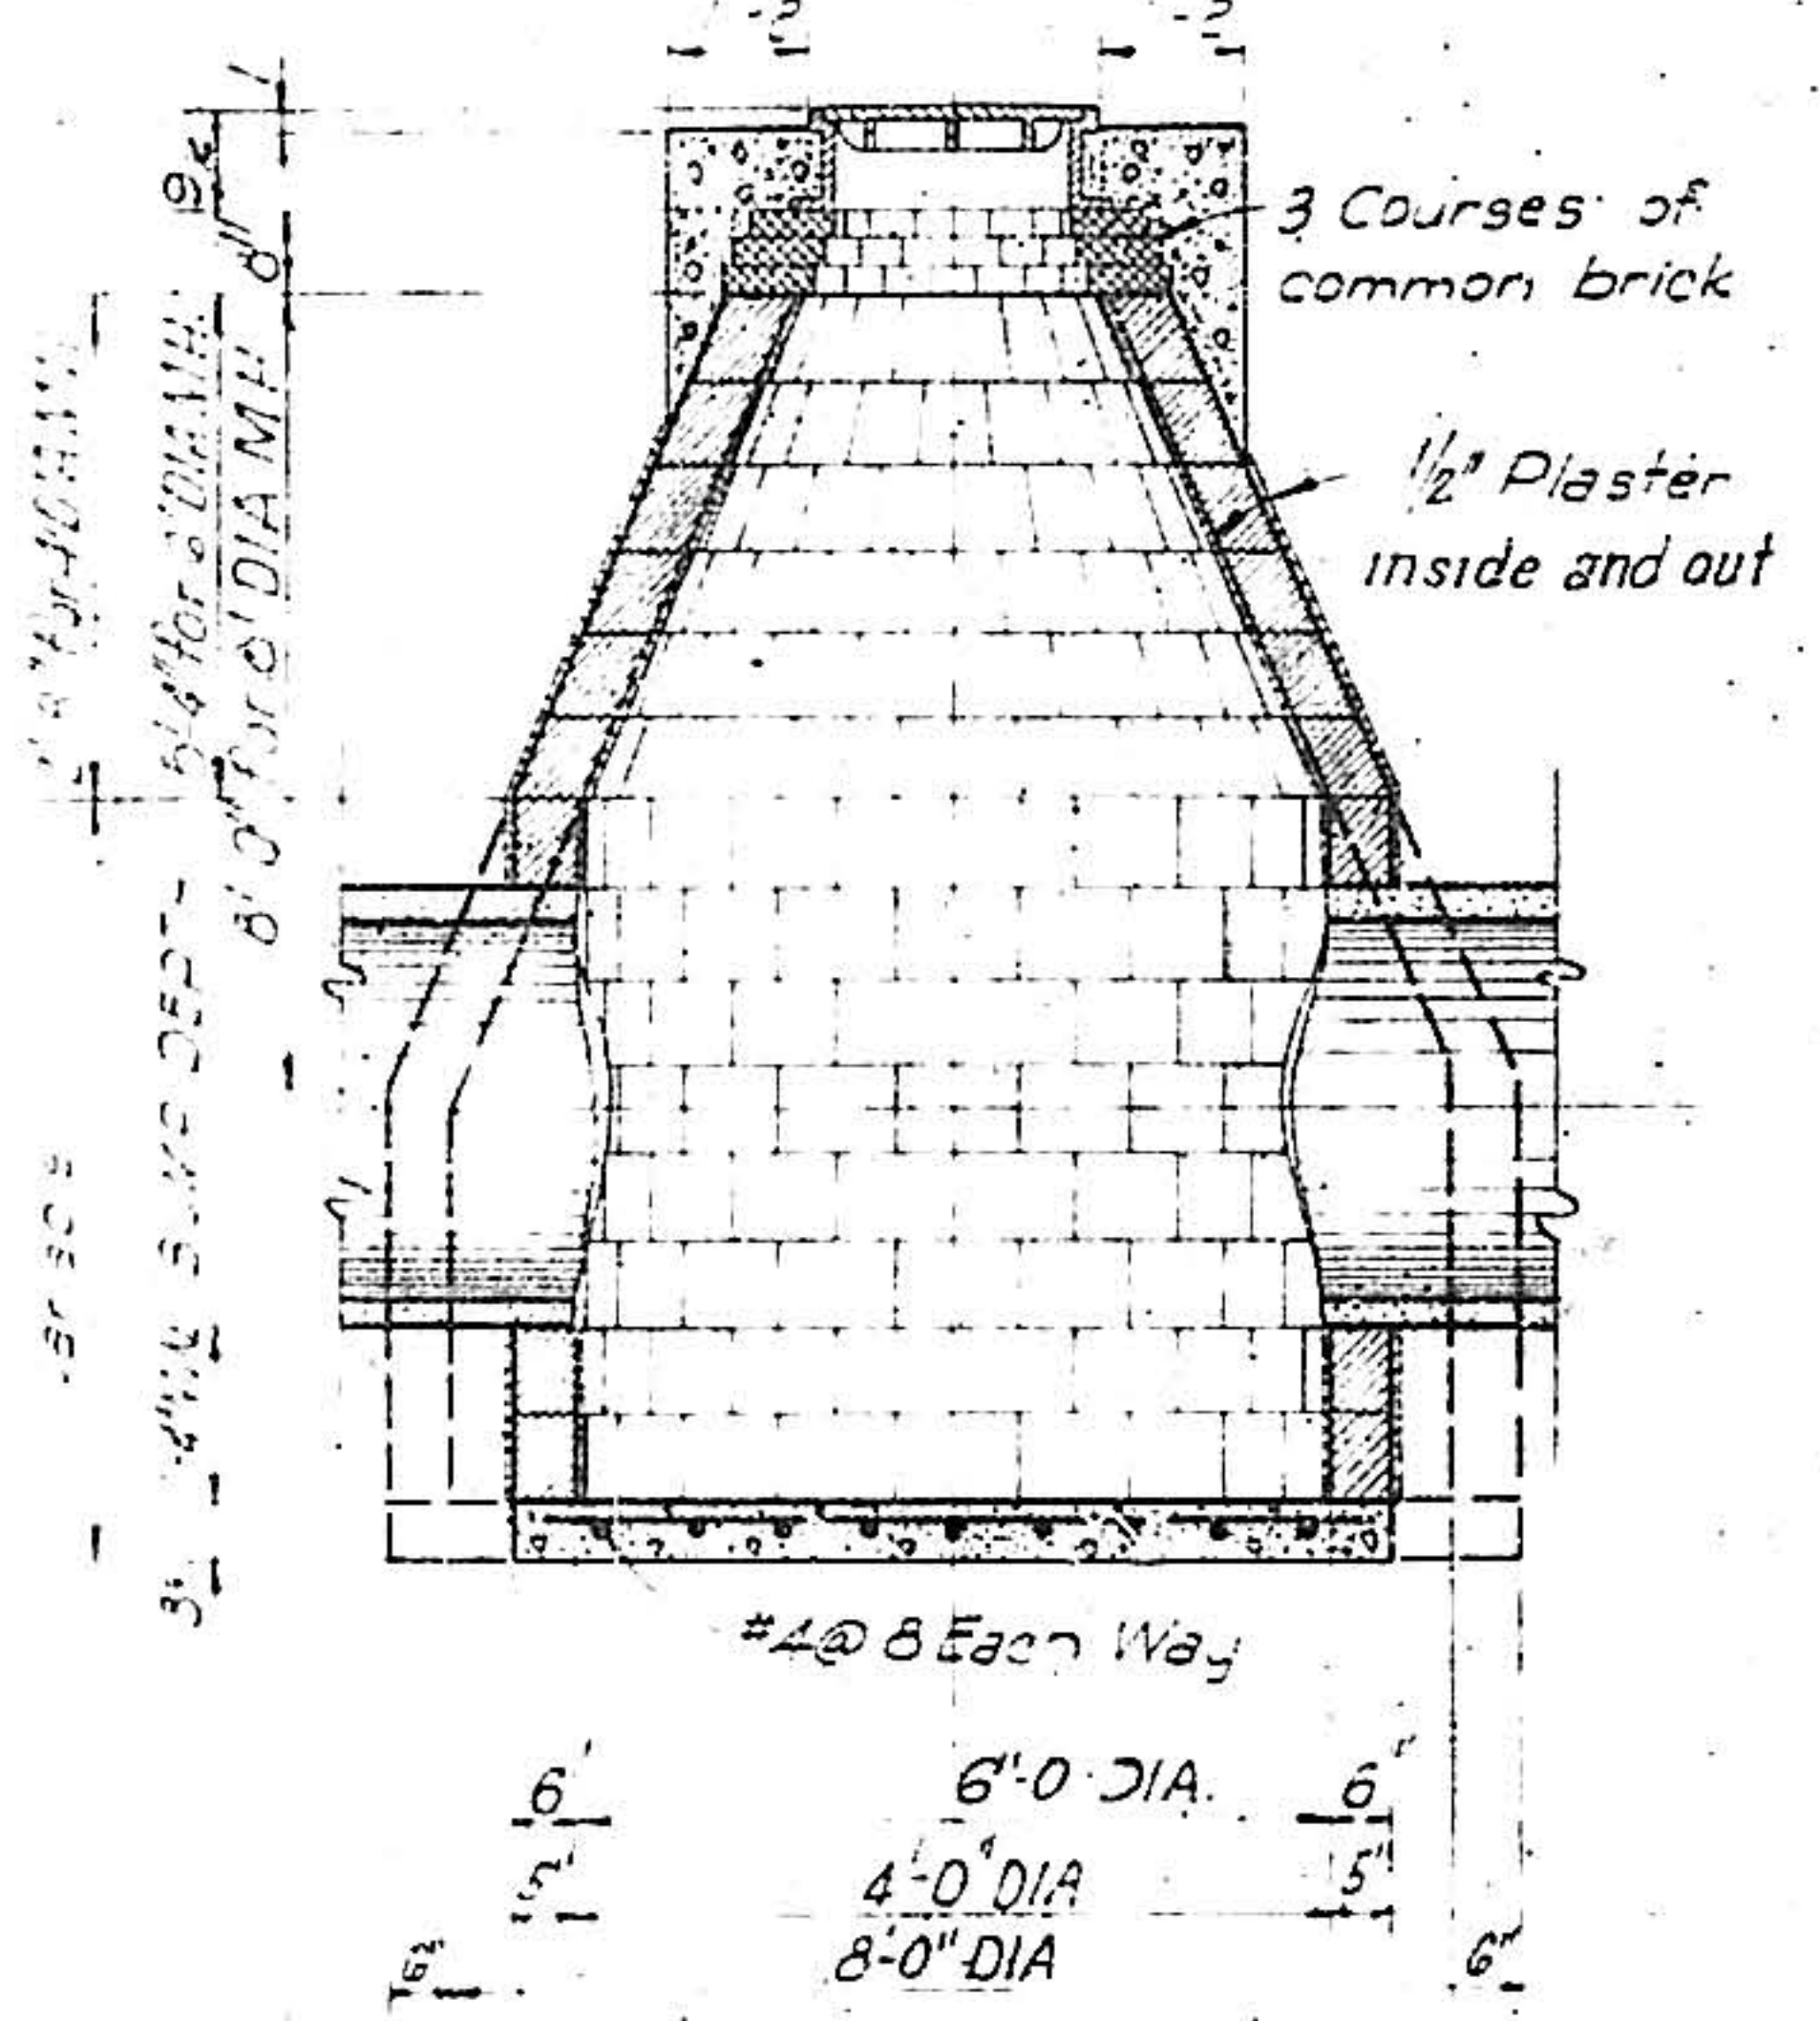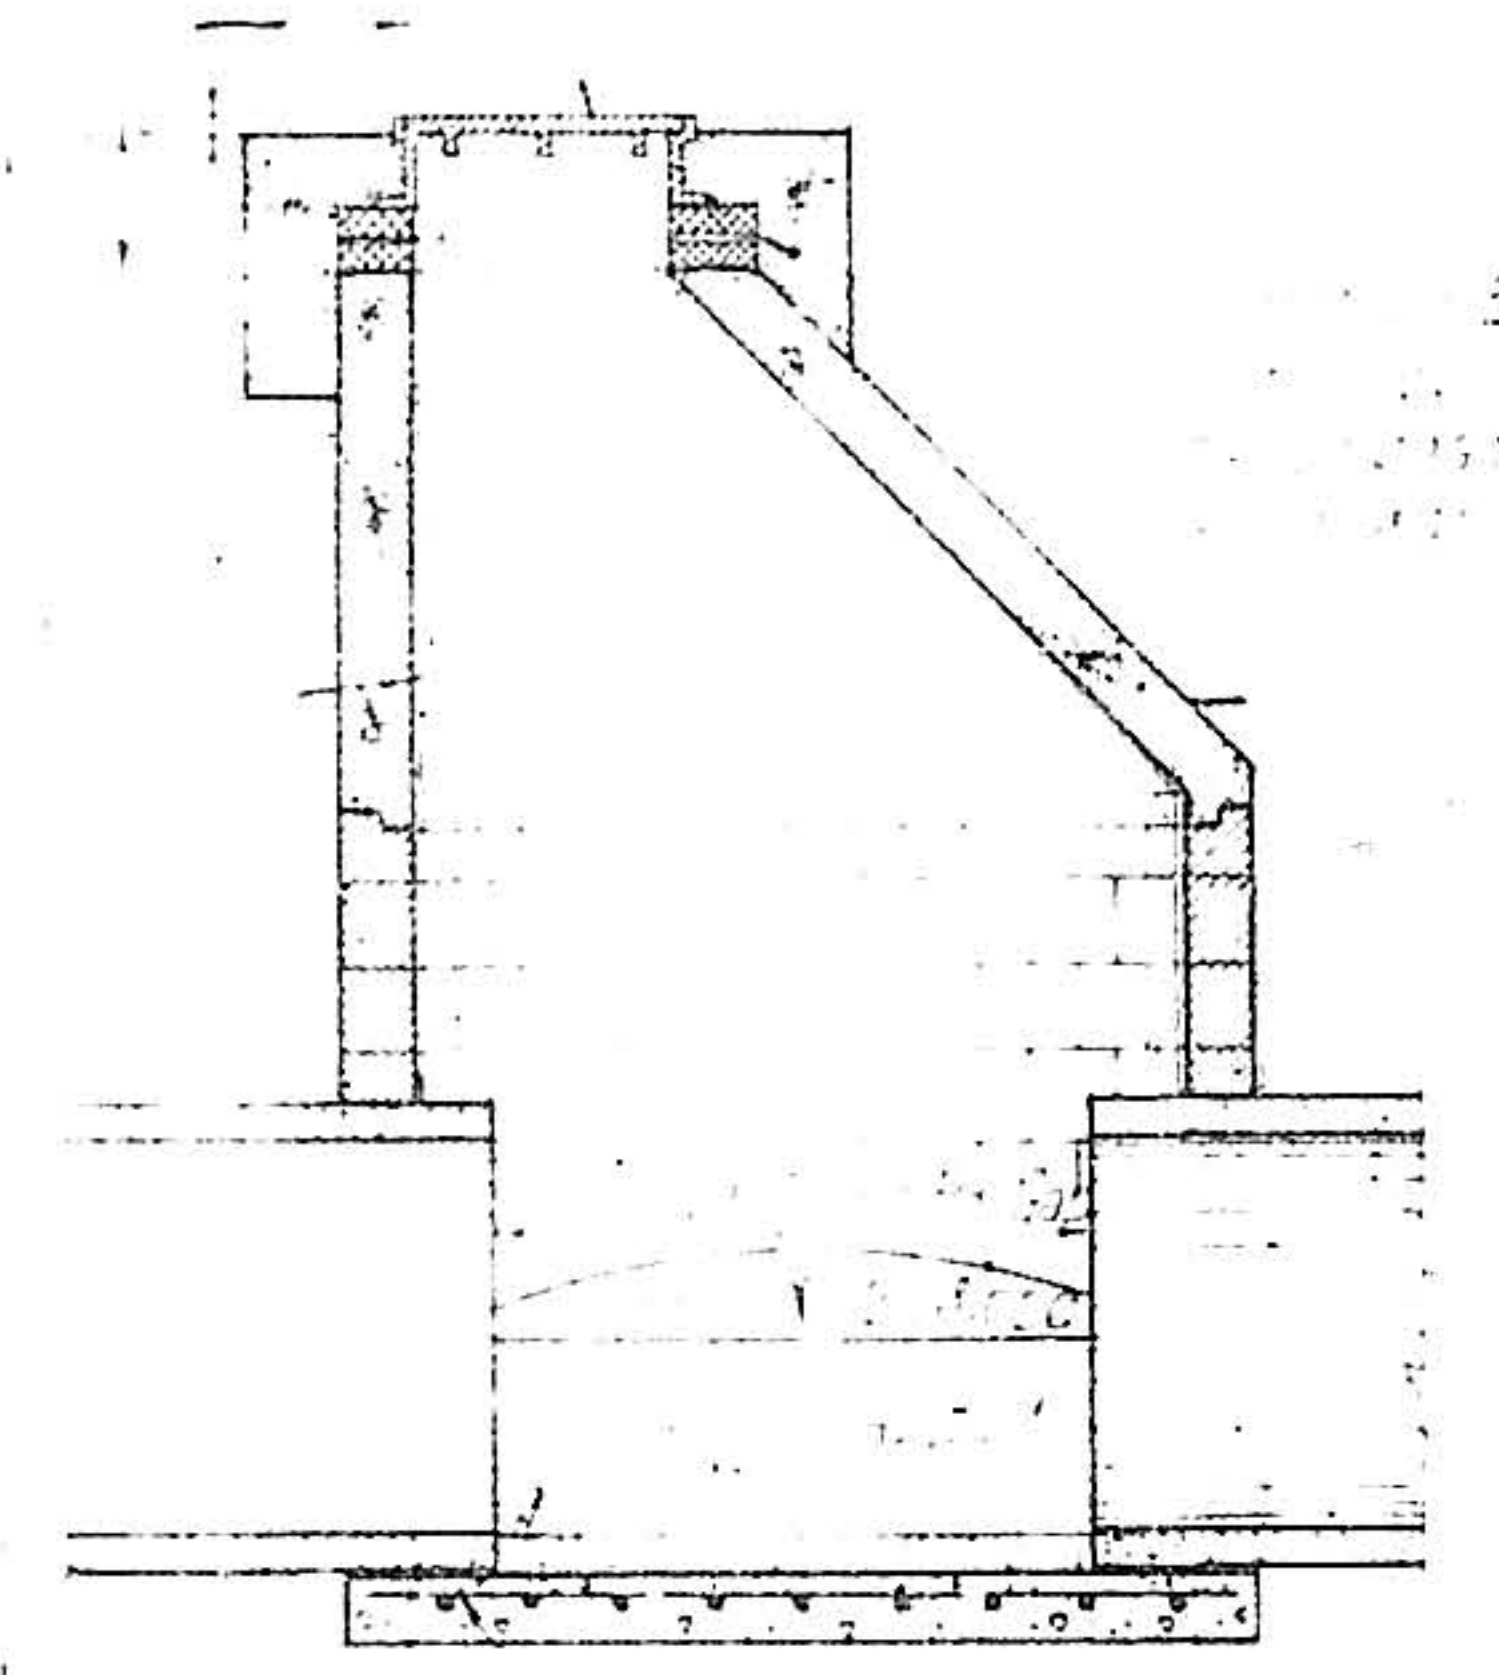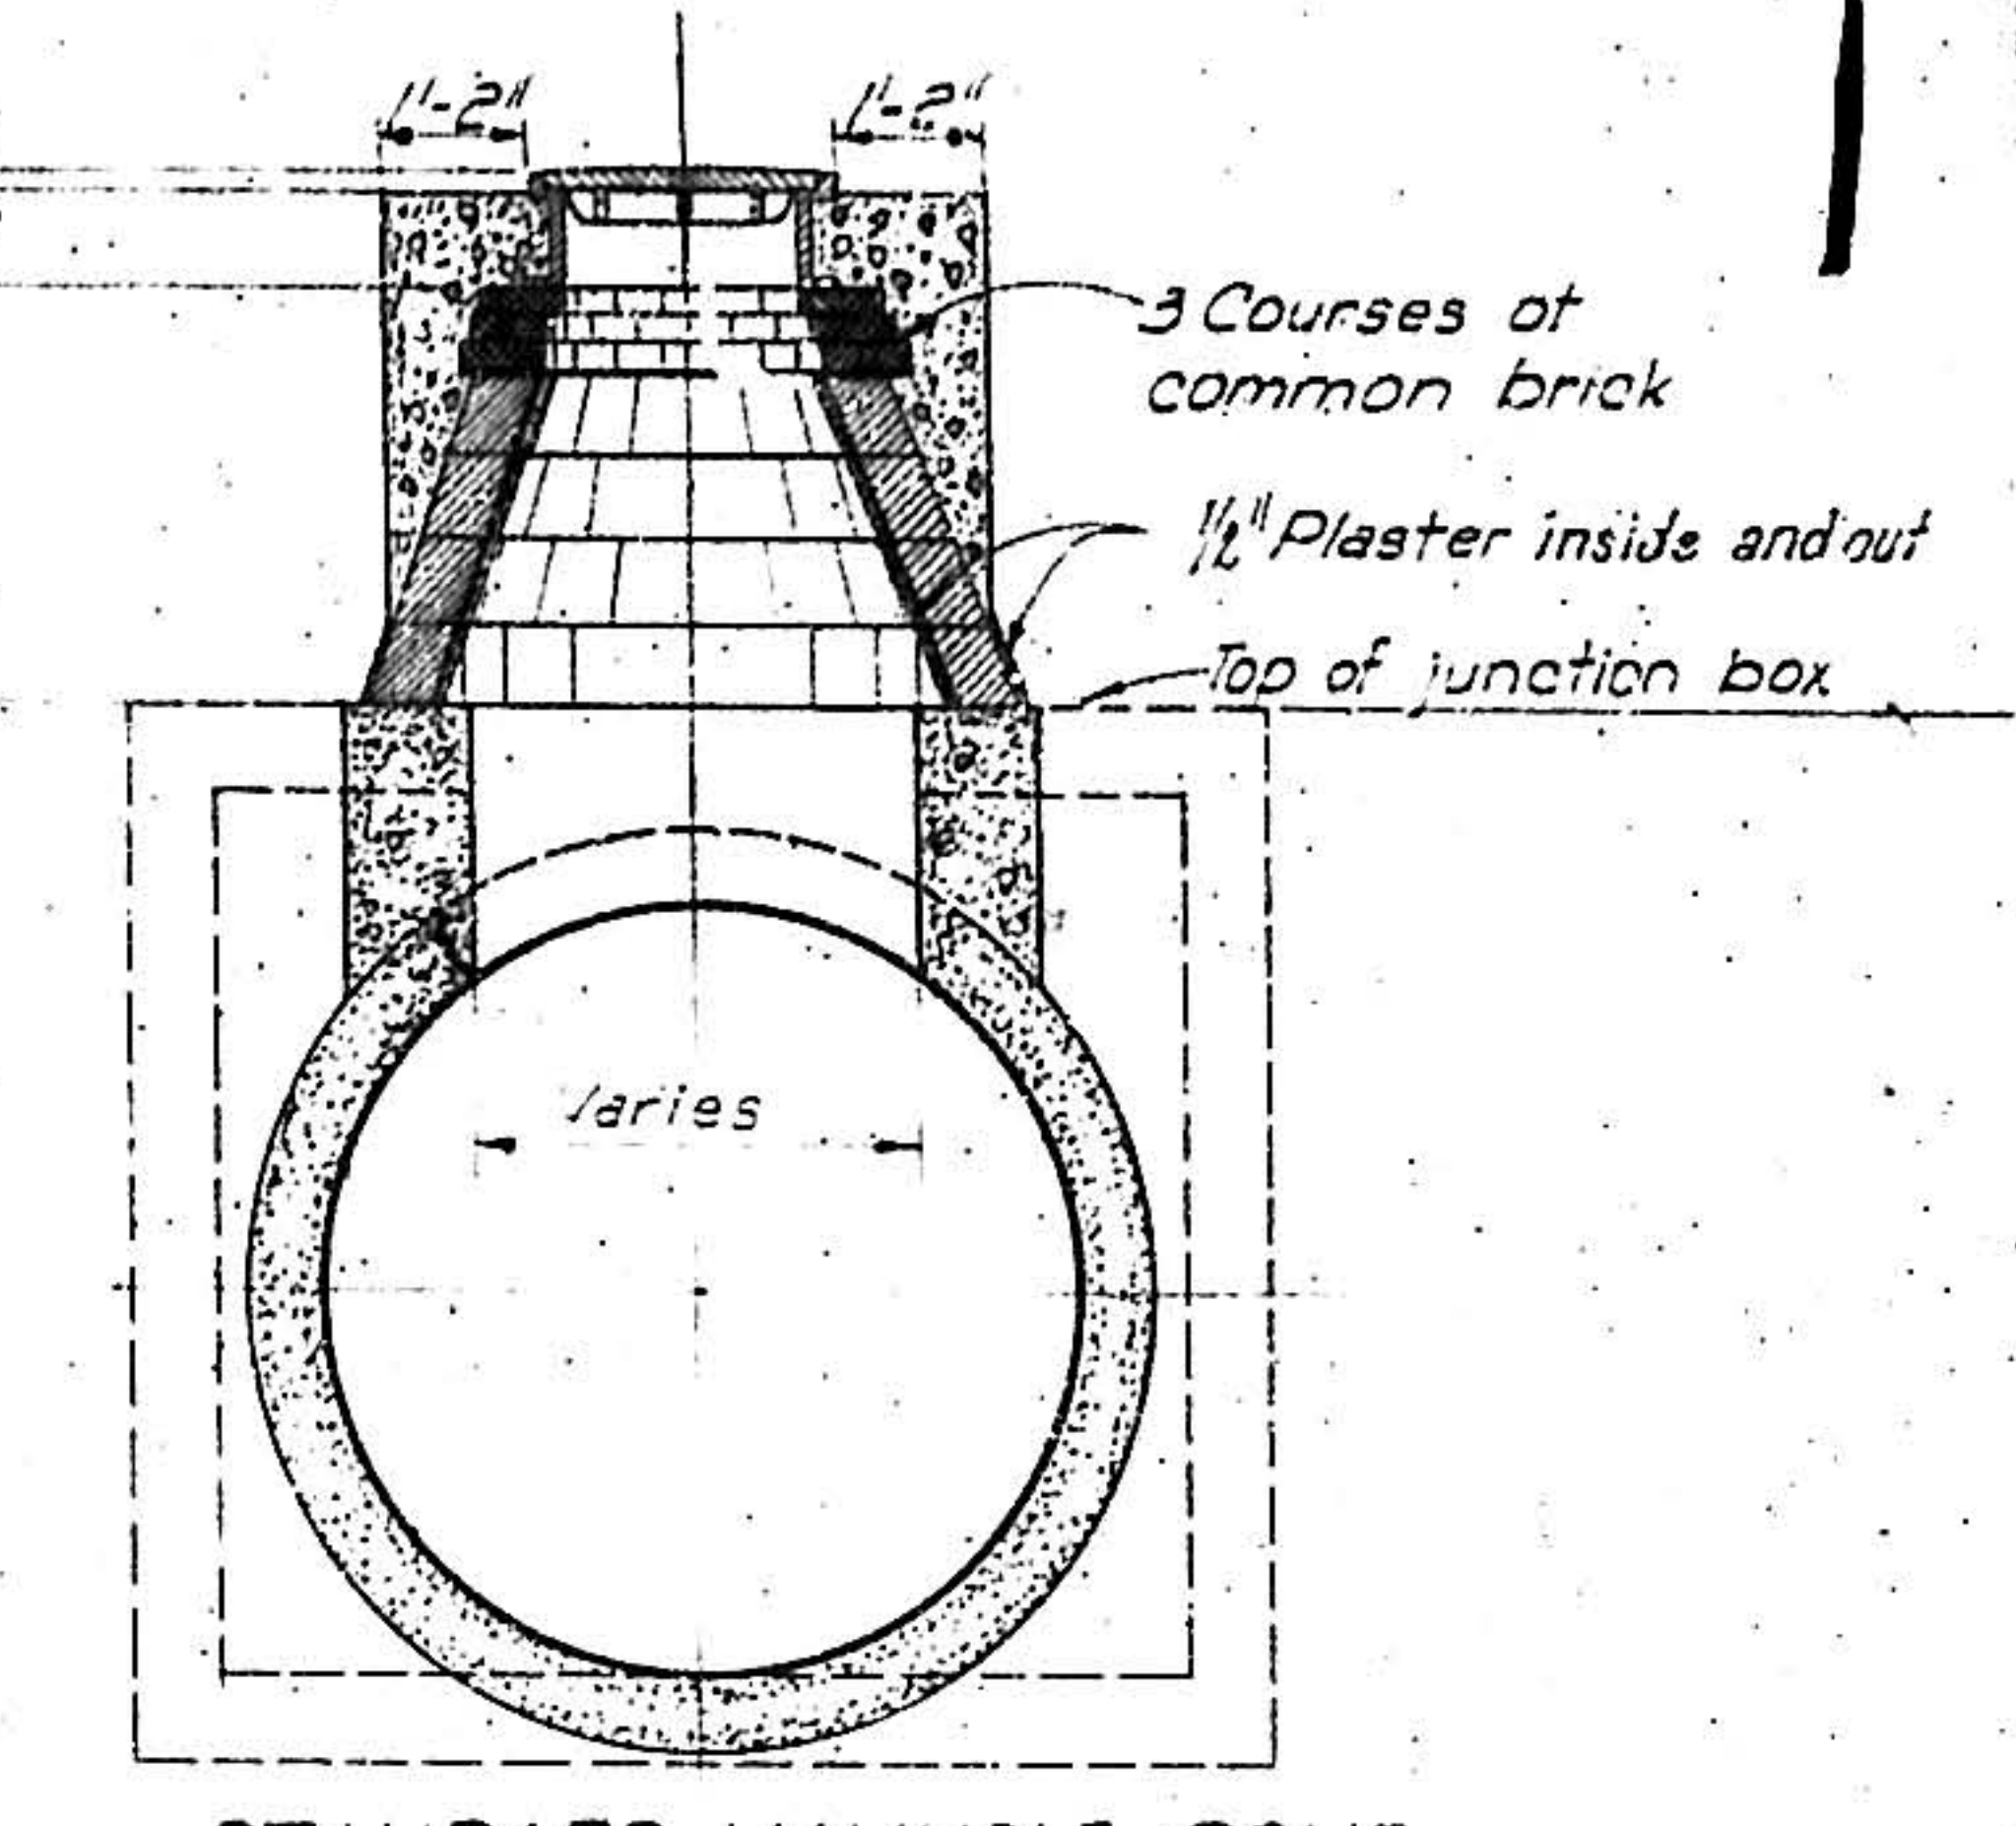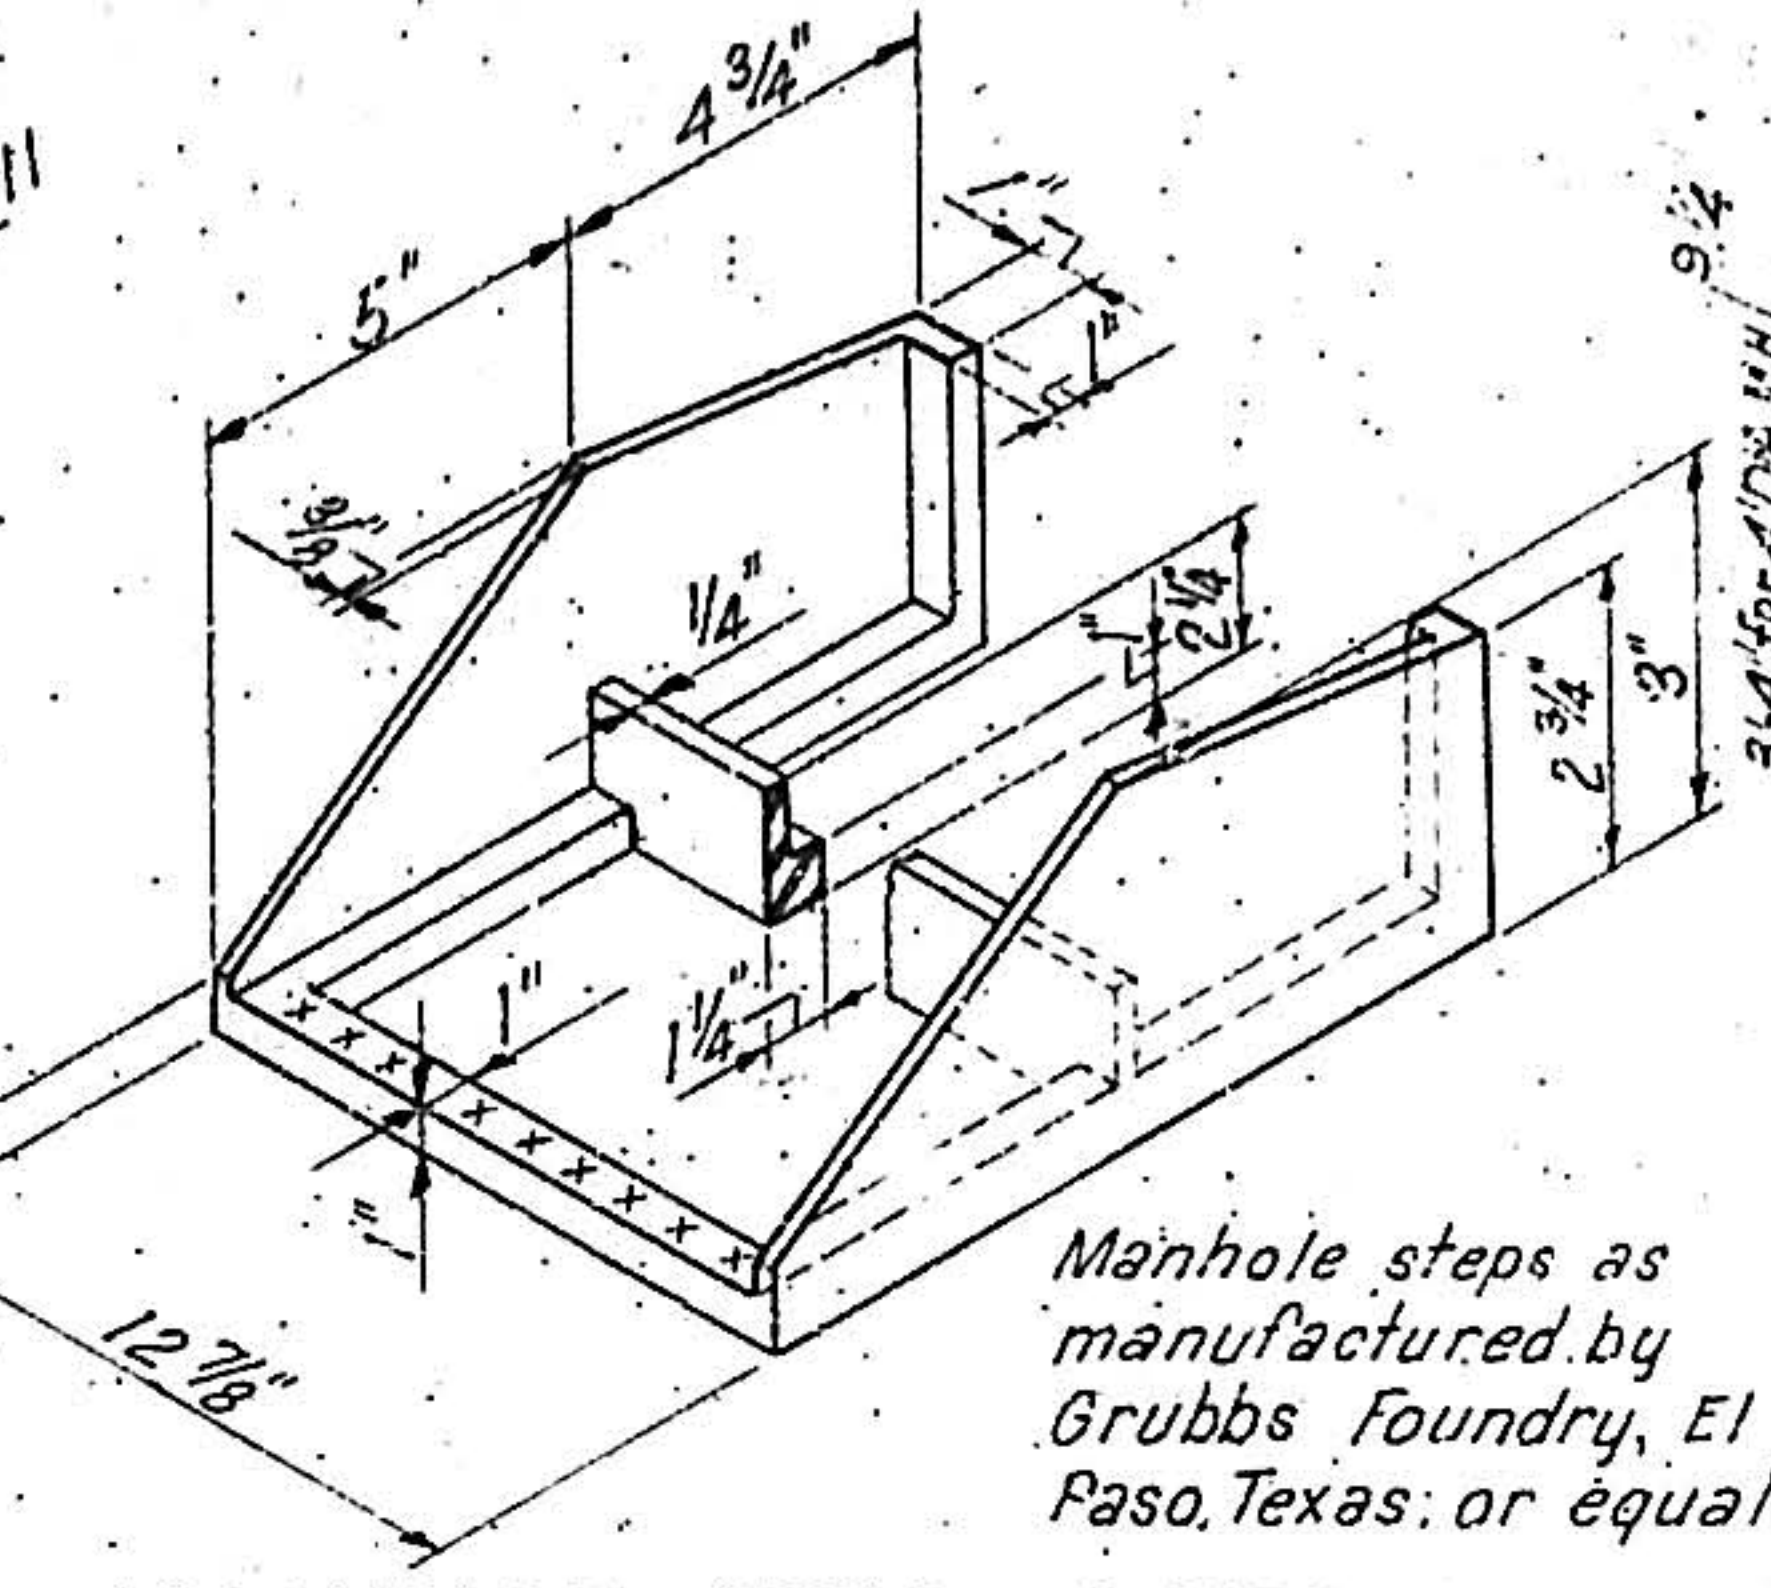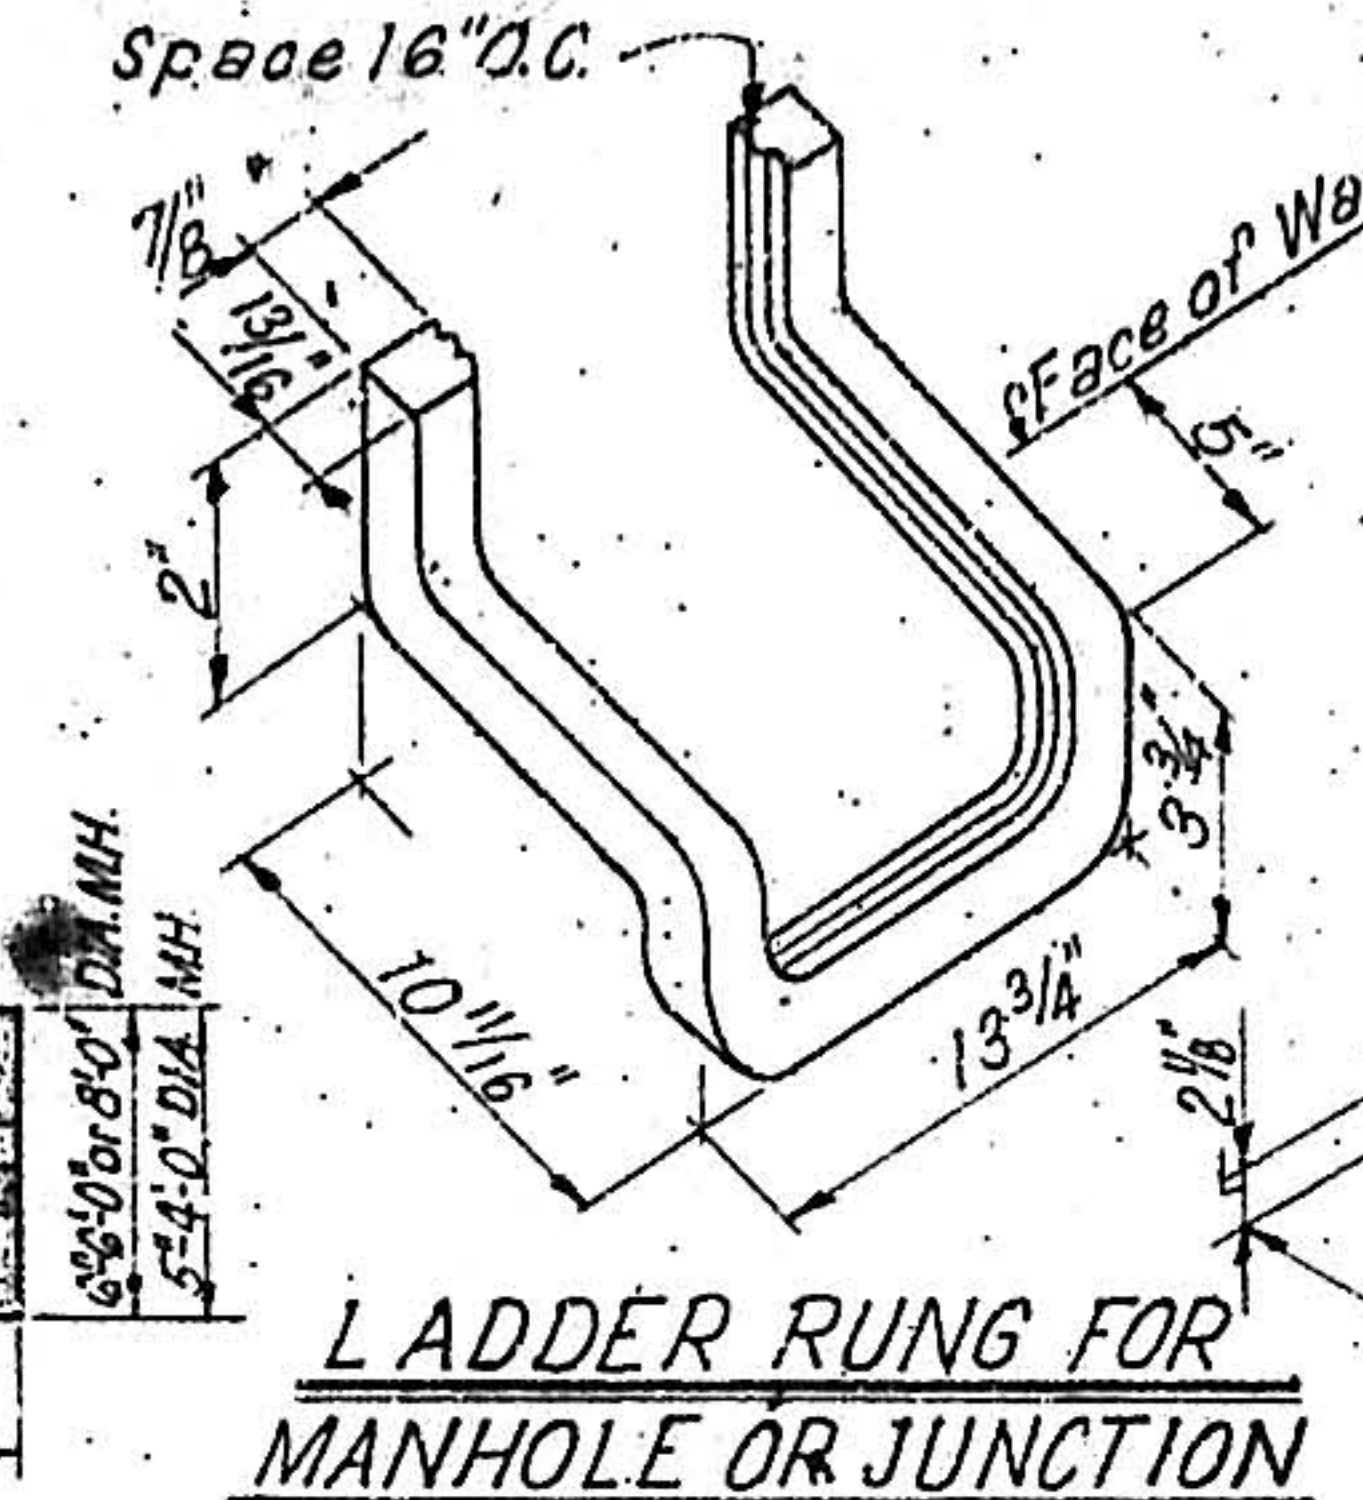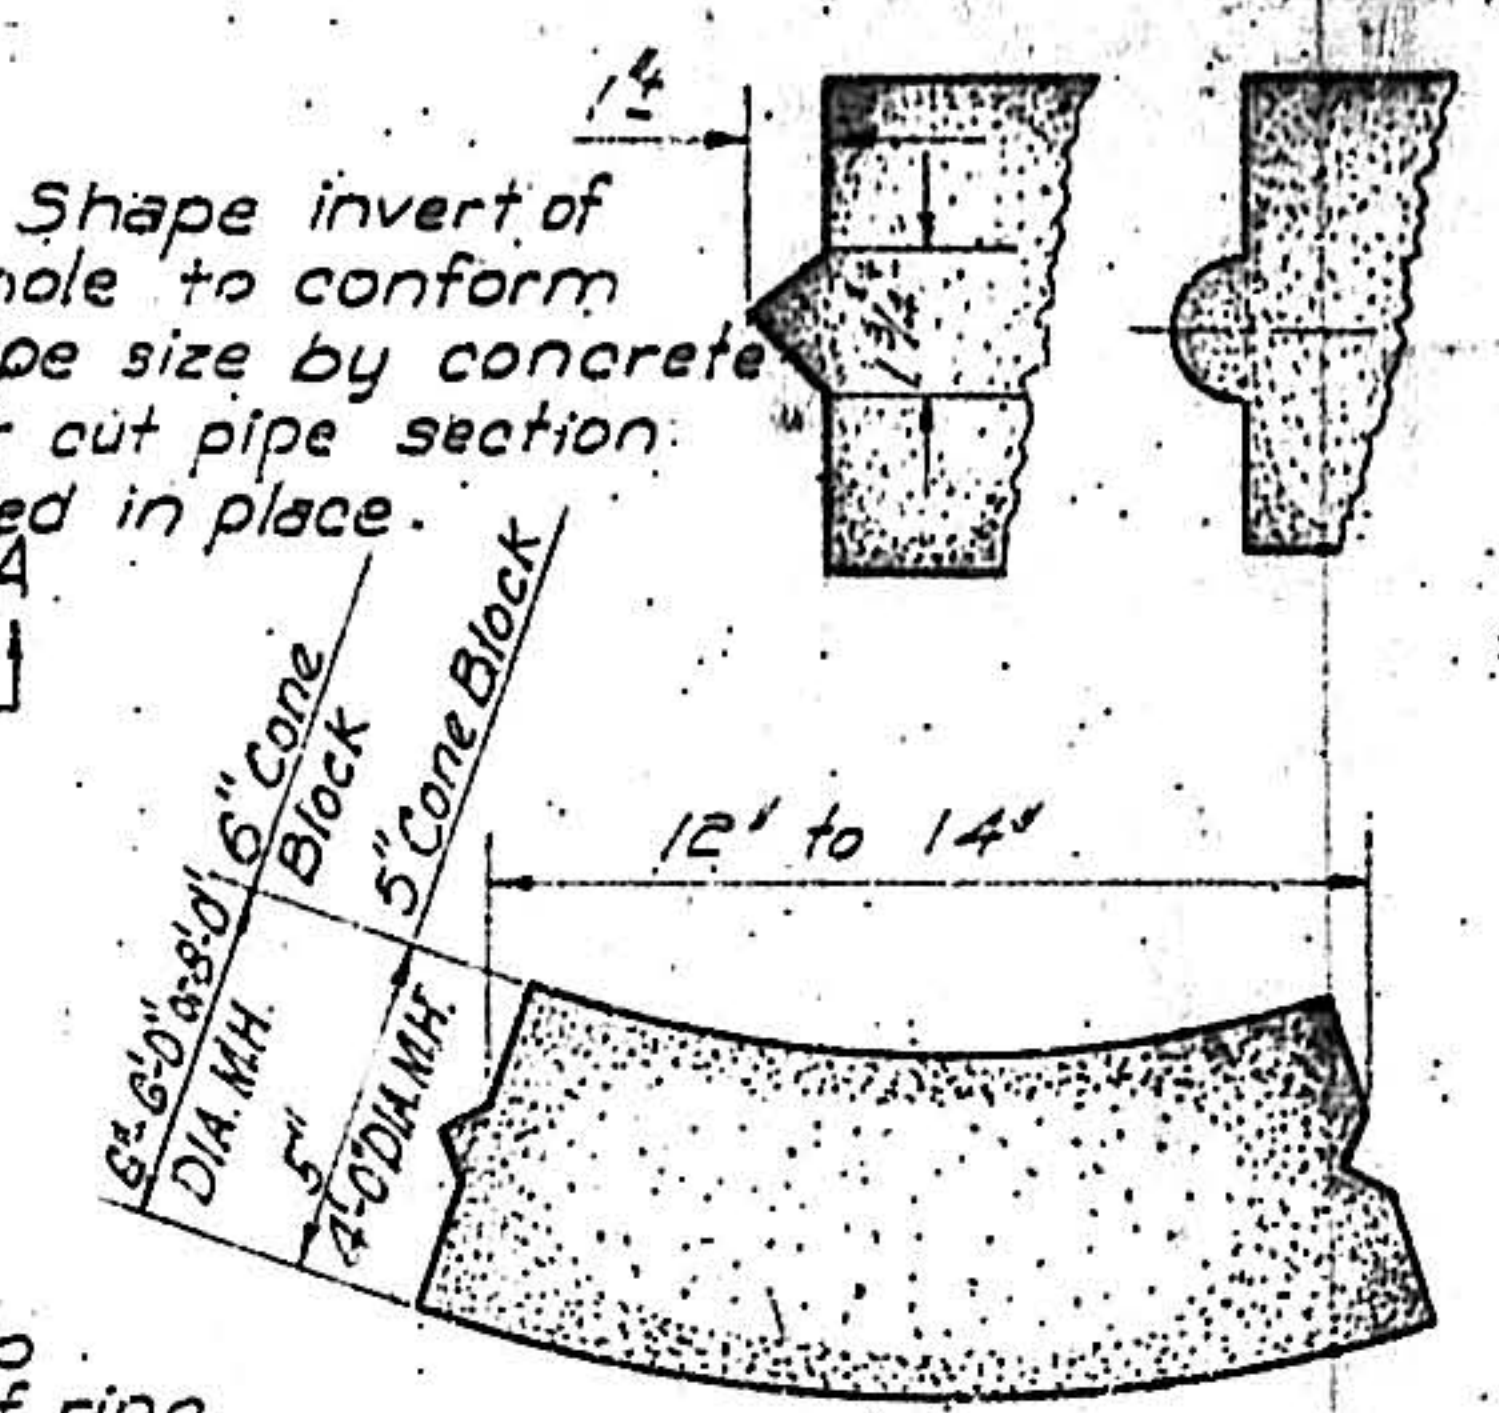

6' DIAMETER INTERMEDIATE MANHOLE TYPE C
Scale: 3/8" = 1'-0"


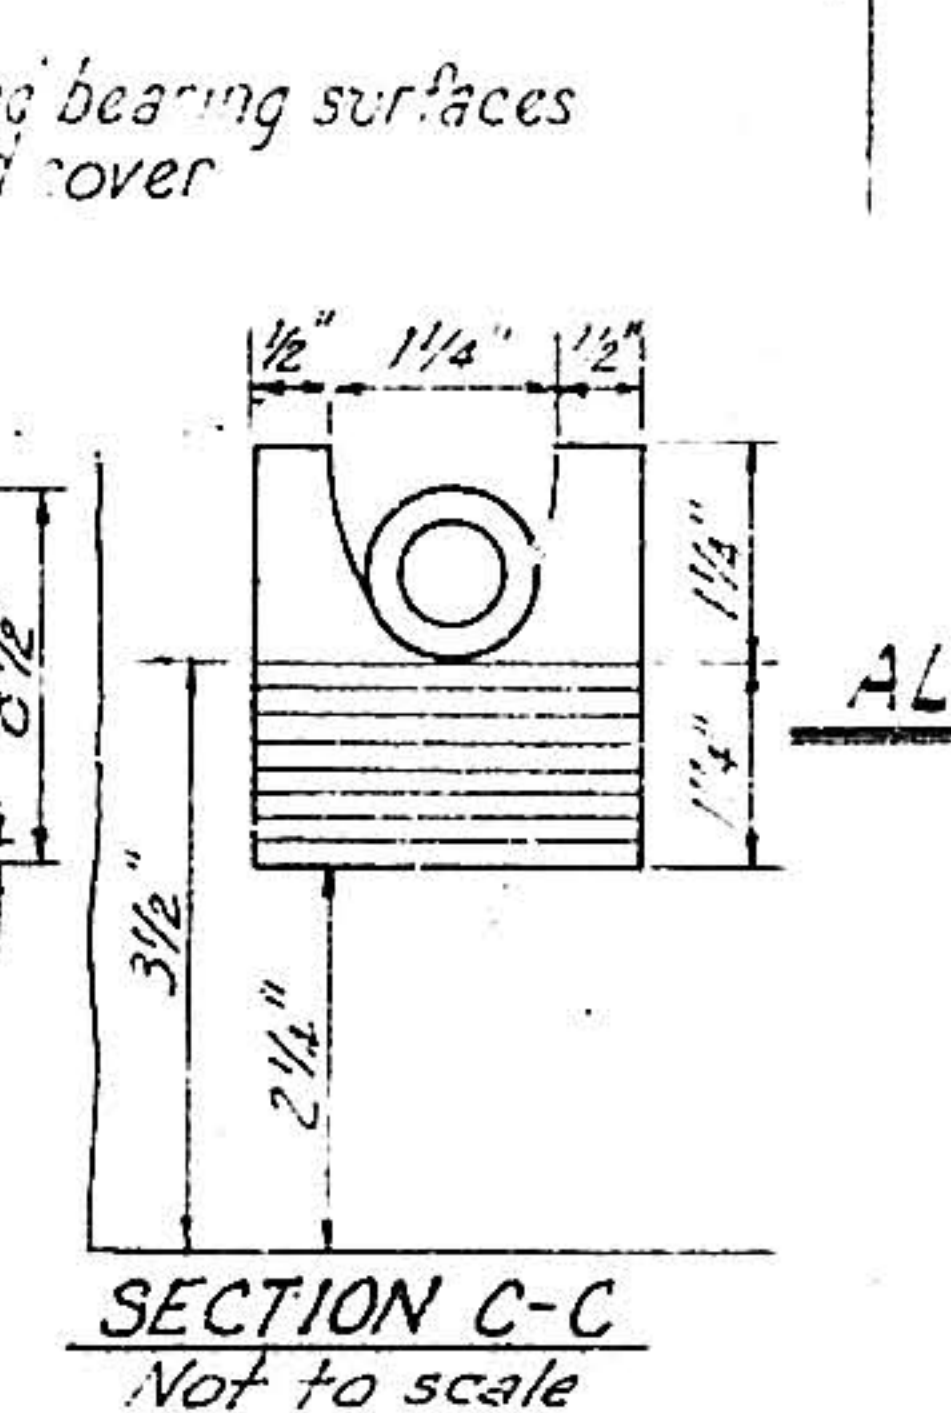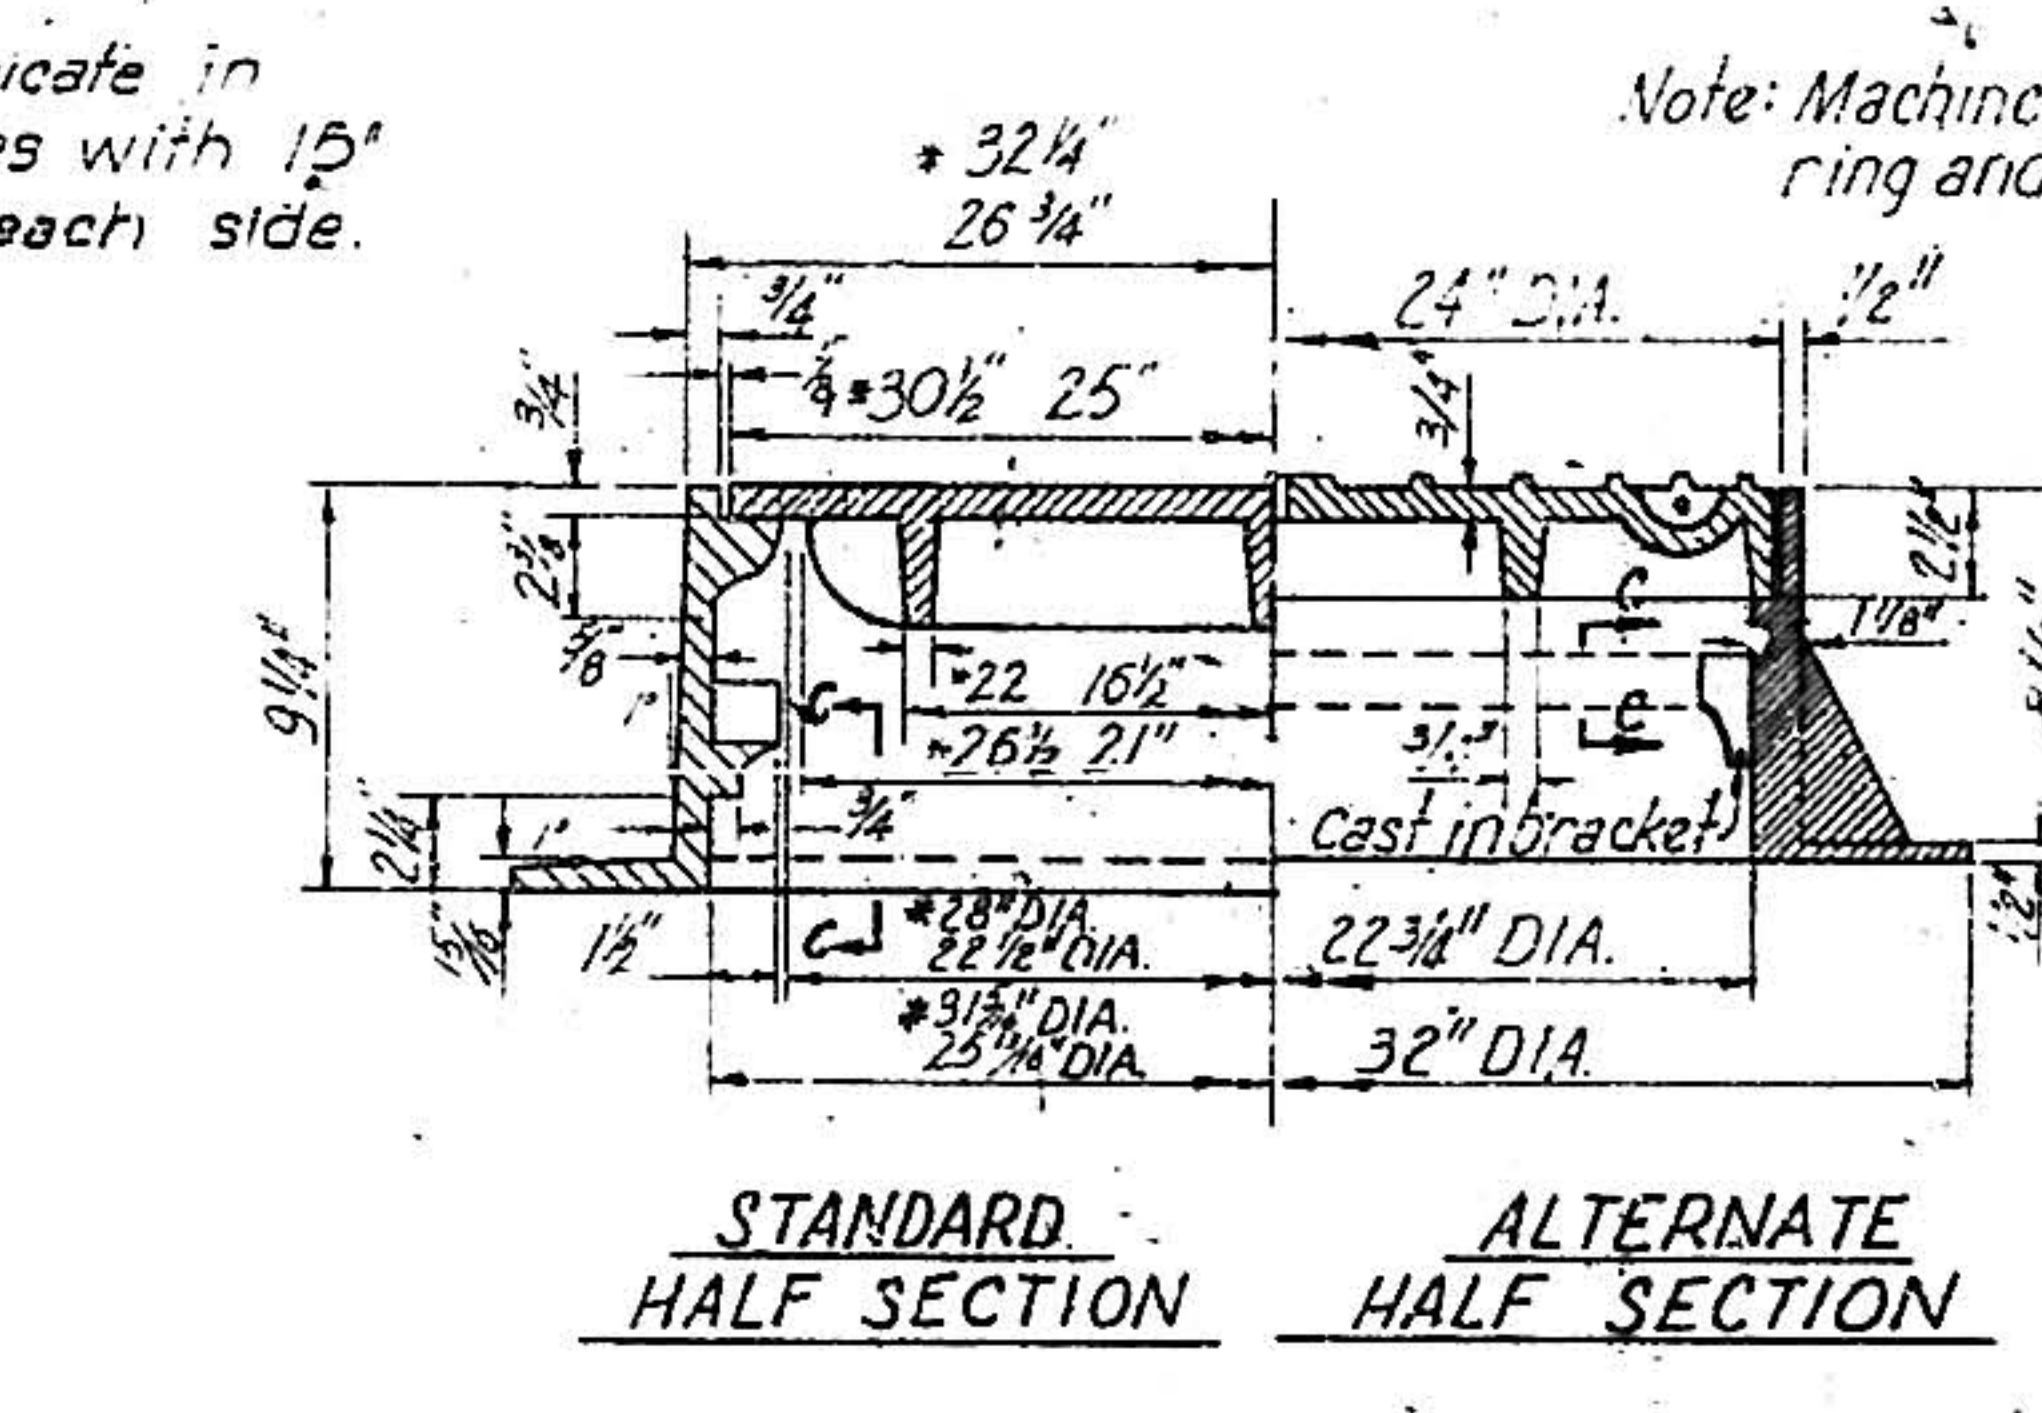

TYPICAL DETAILS OF CAST IRON MANHOLE RING AND COVER
SCALE: 1/8" = 1'-0"


Note: Manholes to be constructed under water to be plastered on the outside 1/2" thick from 1'-0" above water level on down to bottom of M.H.









ALBUQUERQUE, NEW MEXICO
STORM DRAIN STANDARDS

PAVEMENT CUT AND MANHOLE DETAILS







GORDON HERKLNHOFF & ASSOCIATES, INC.
CONSULTING ENGINEERS
ALBUQUERQUE NEW MEXICO

SCALE: AS SHOWN
DATE: NOV. 1956
DRAWN: R.A.G.
CHECKED: G.A.J.

SHEET 3 OF 10

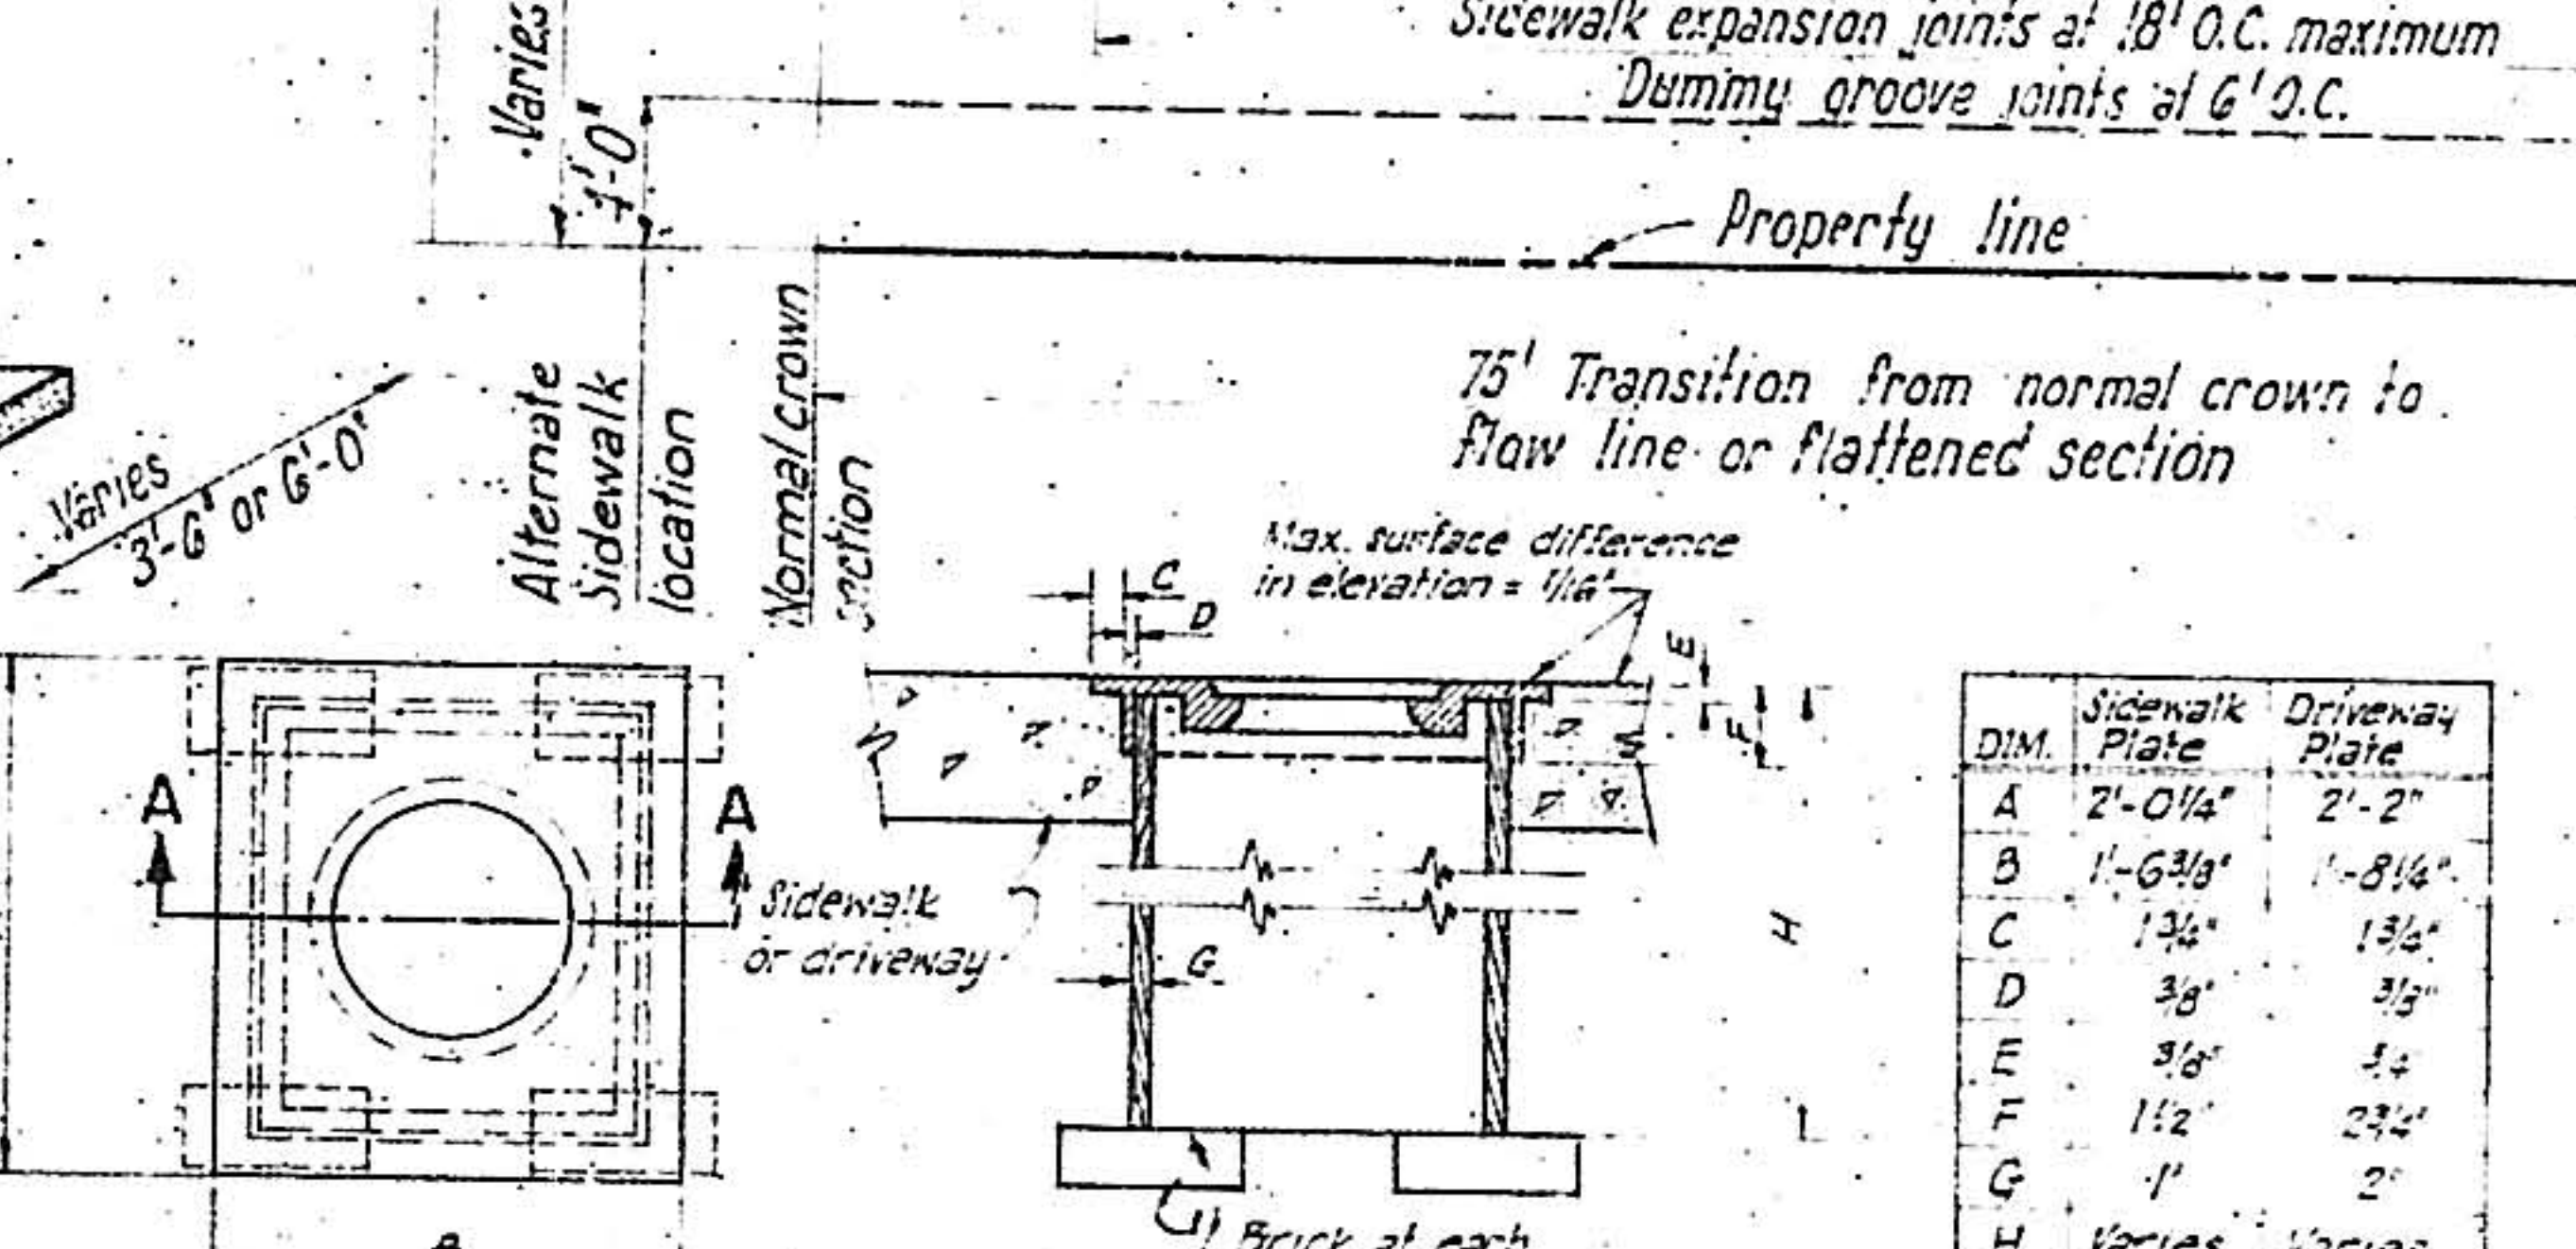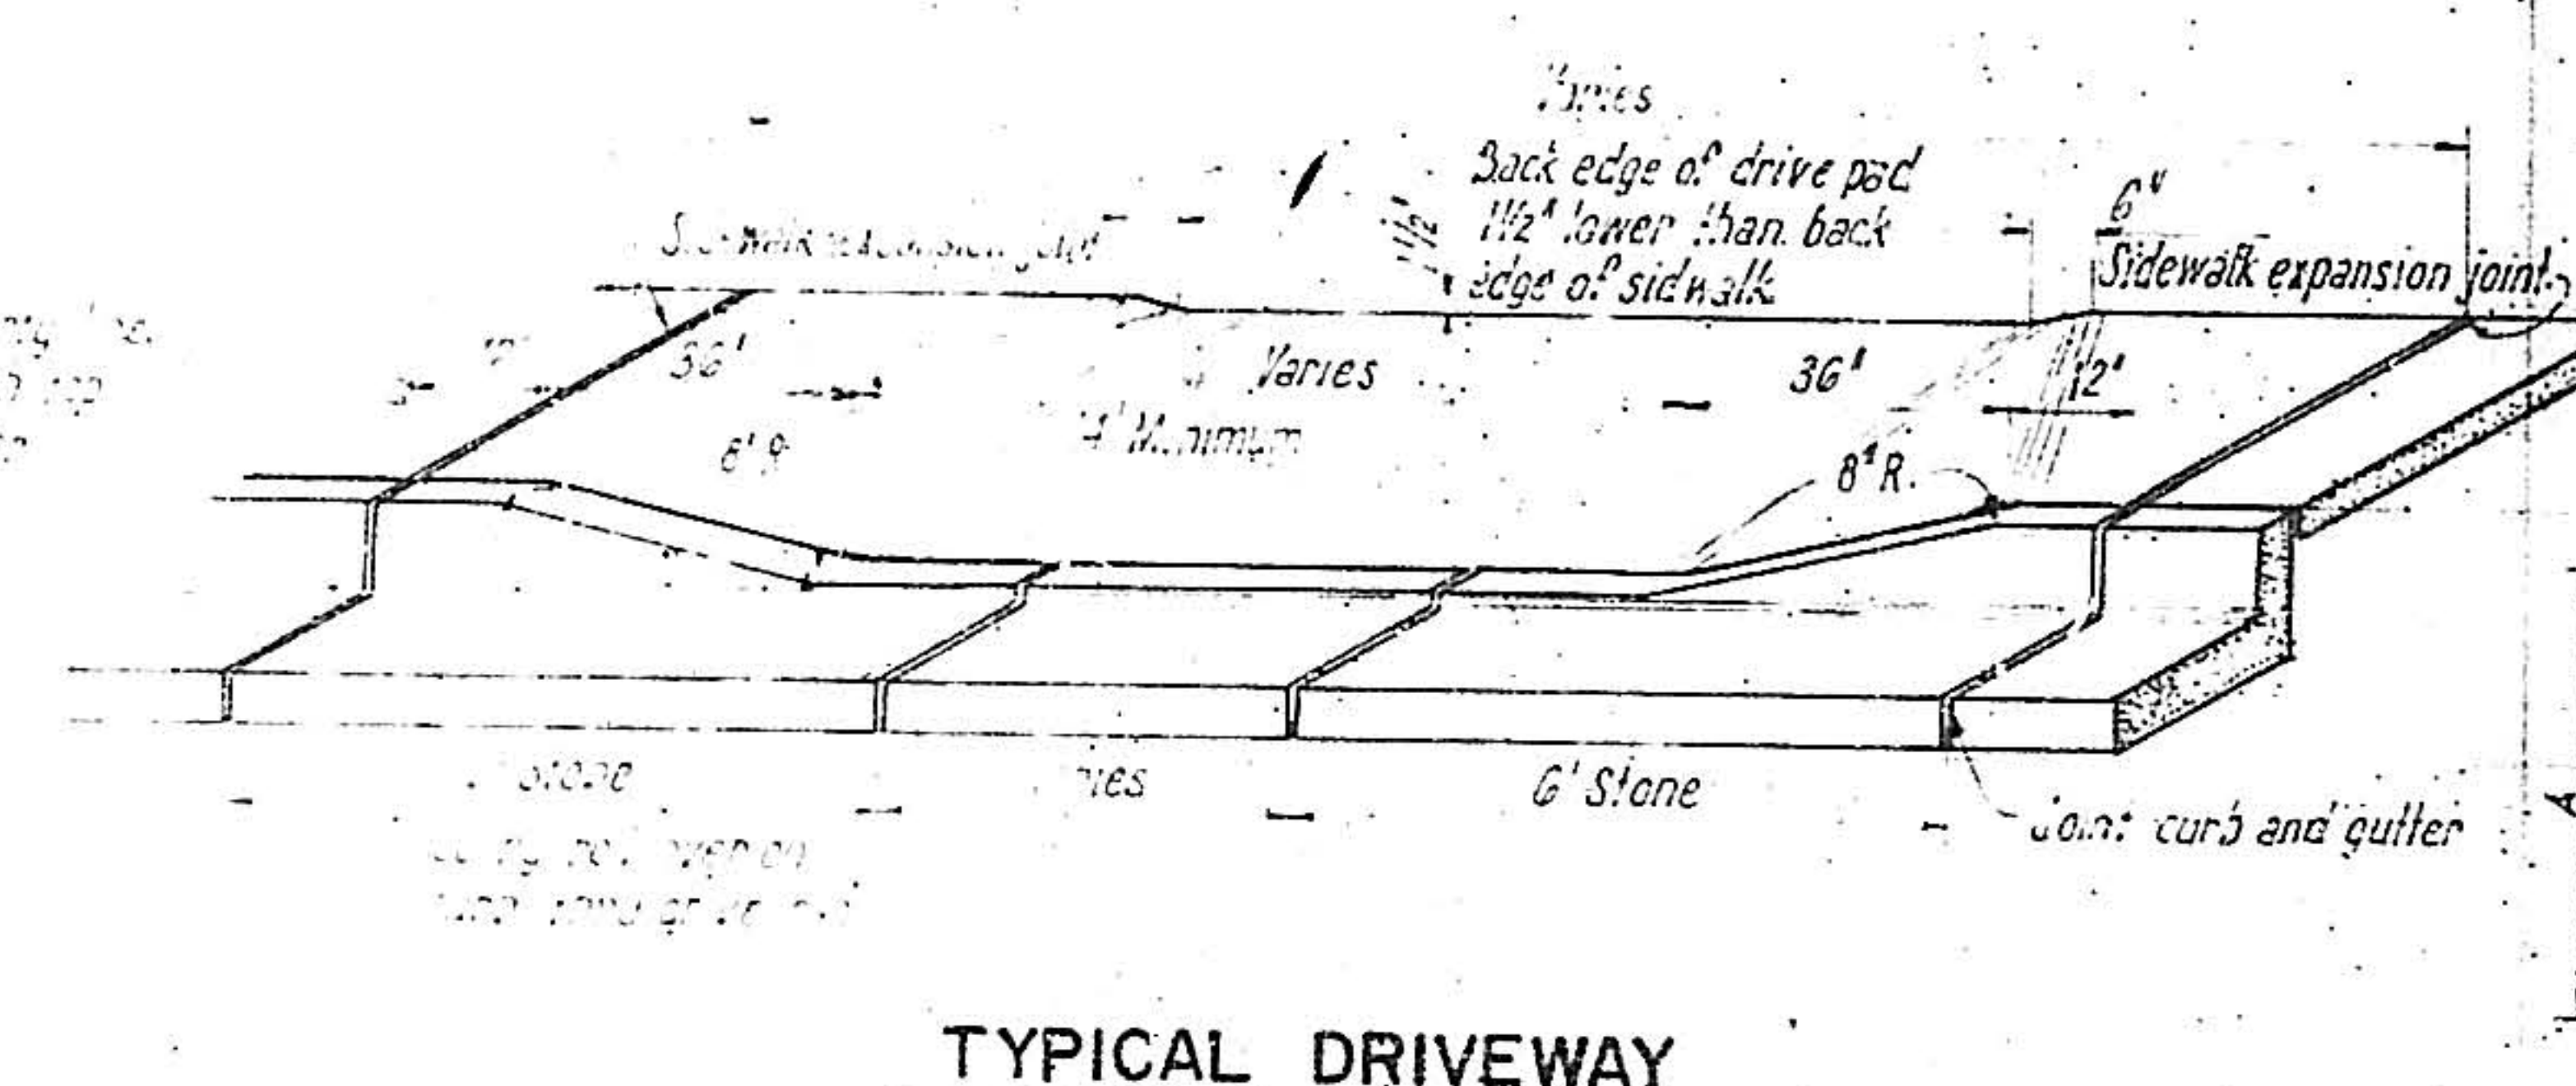 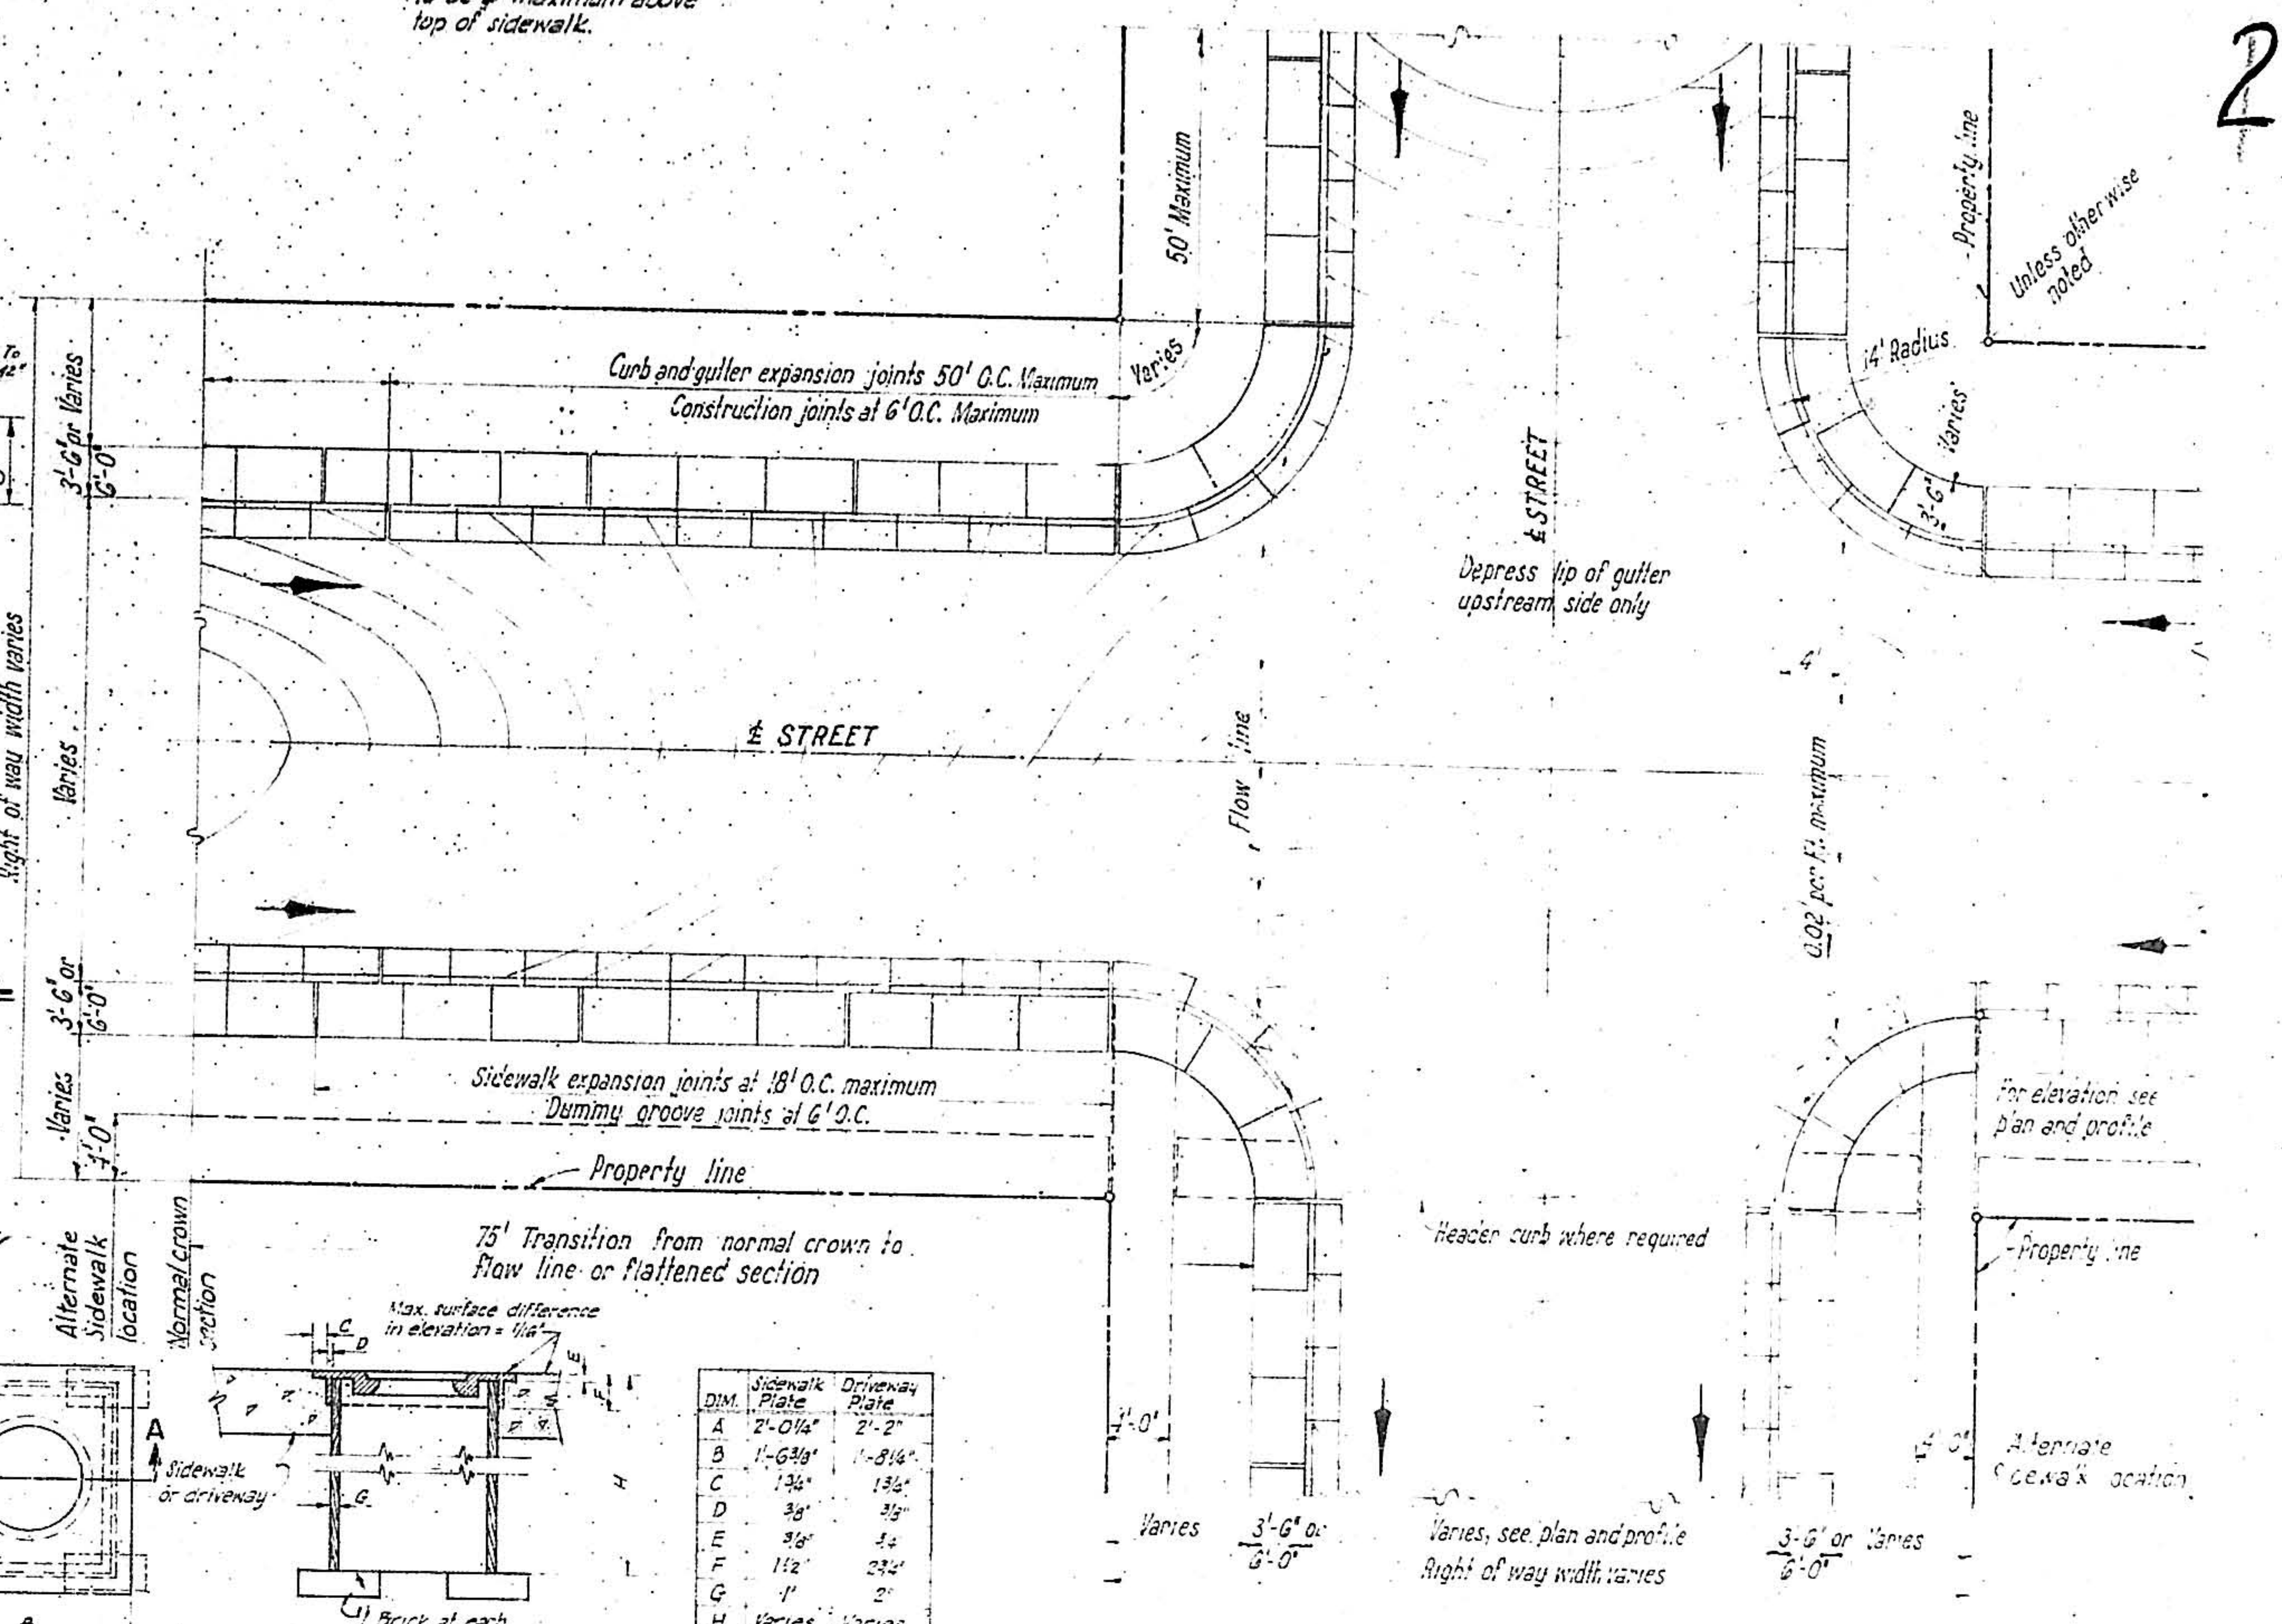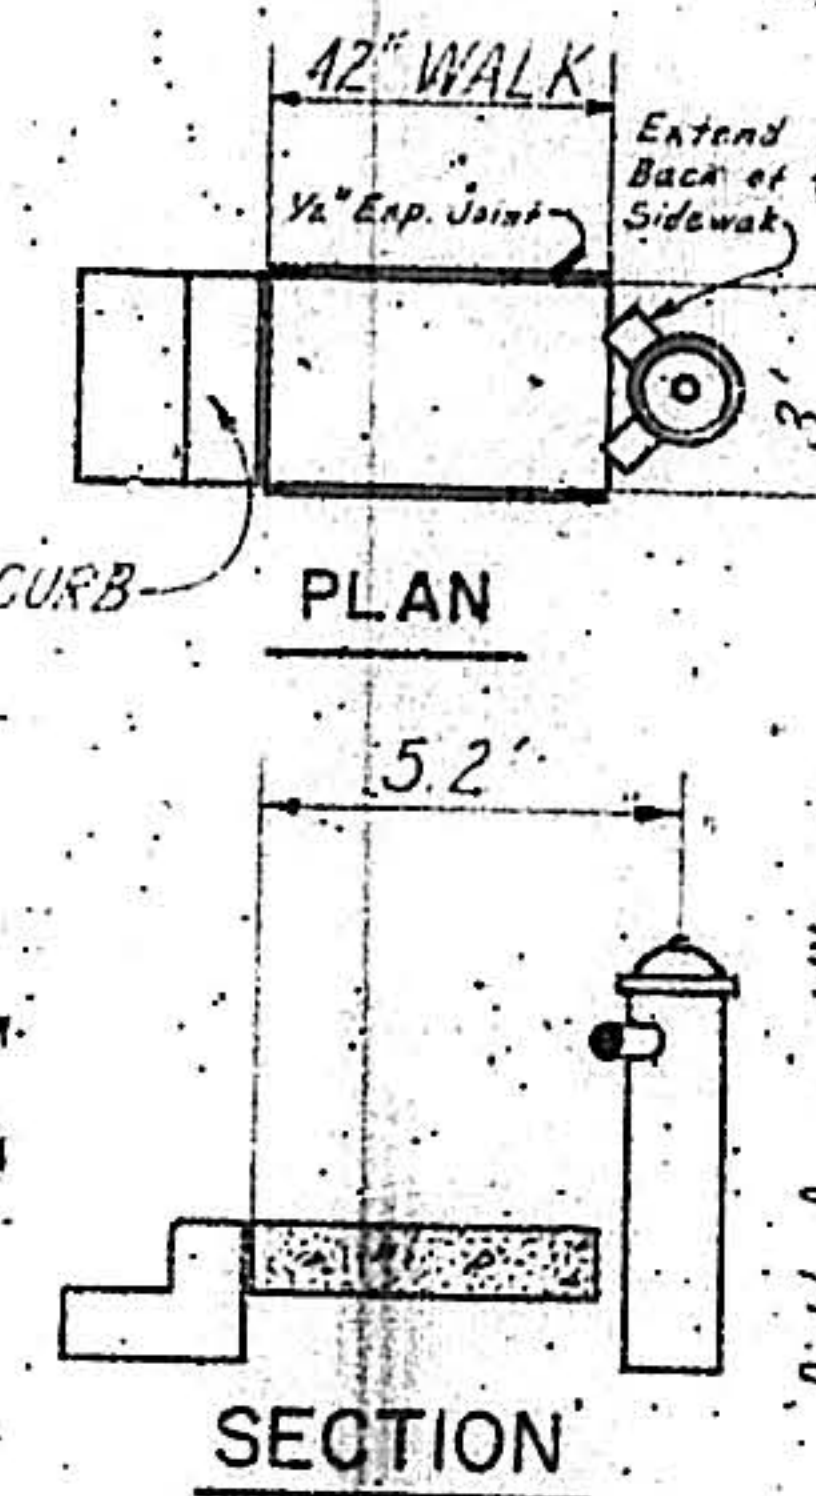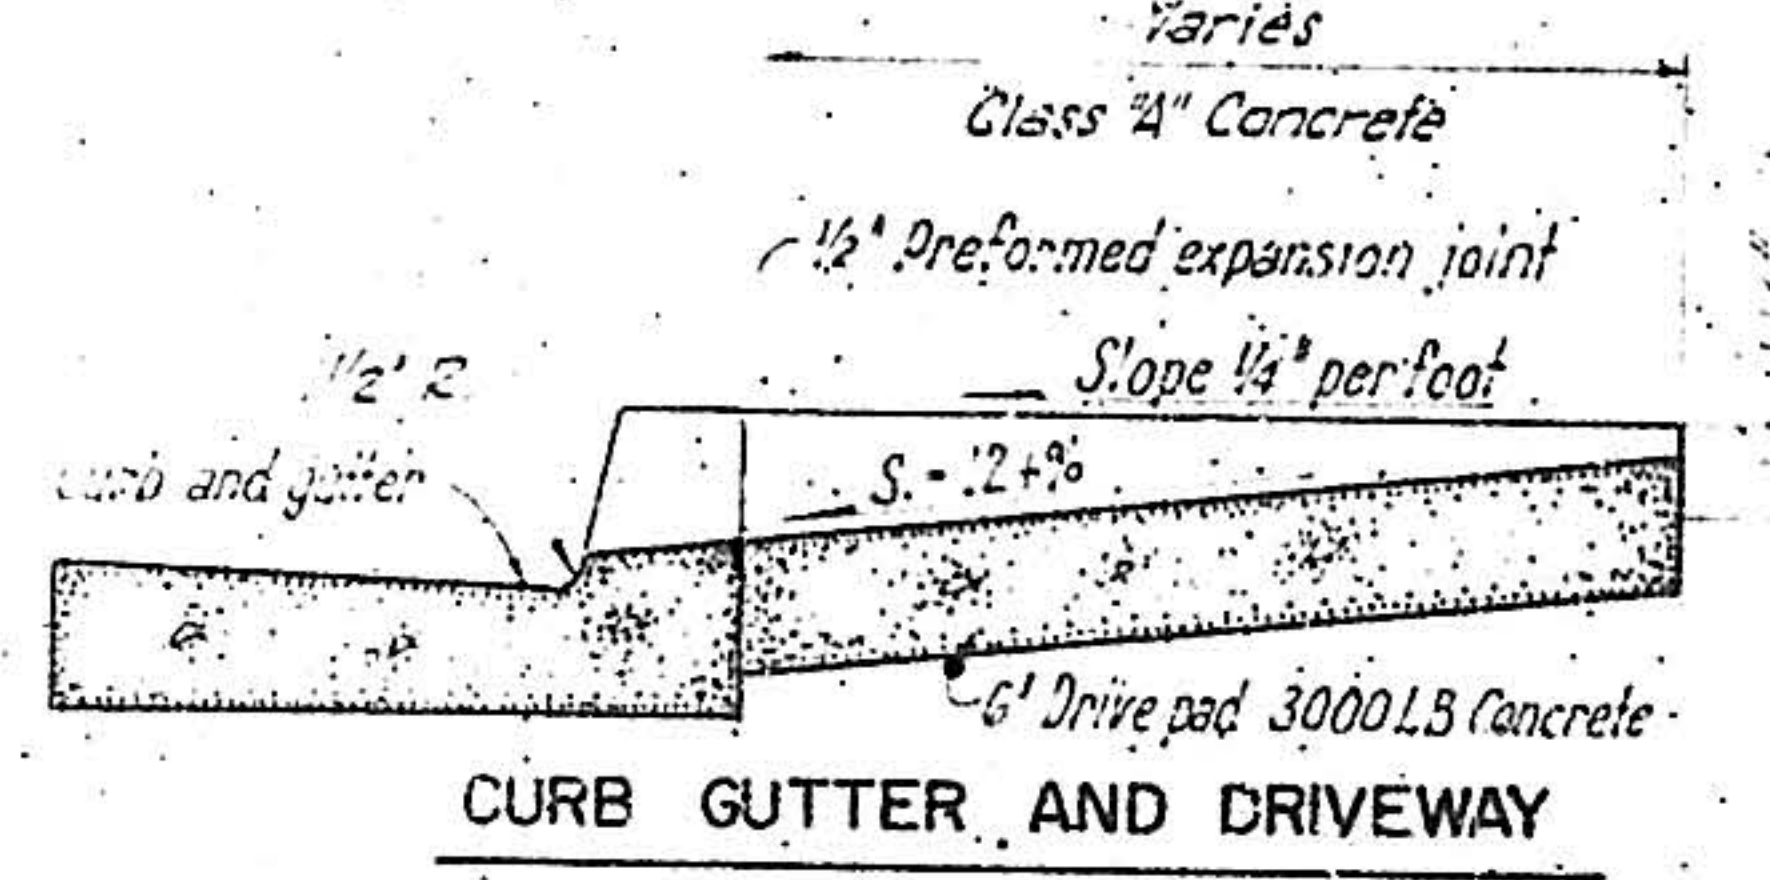
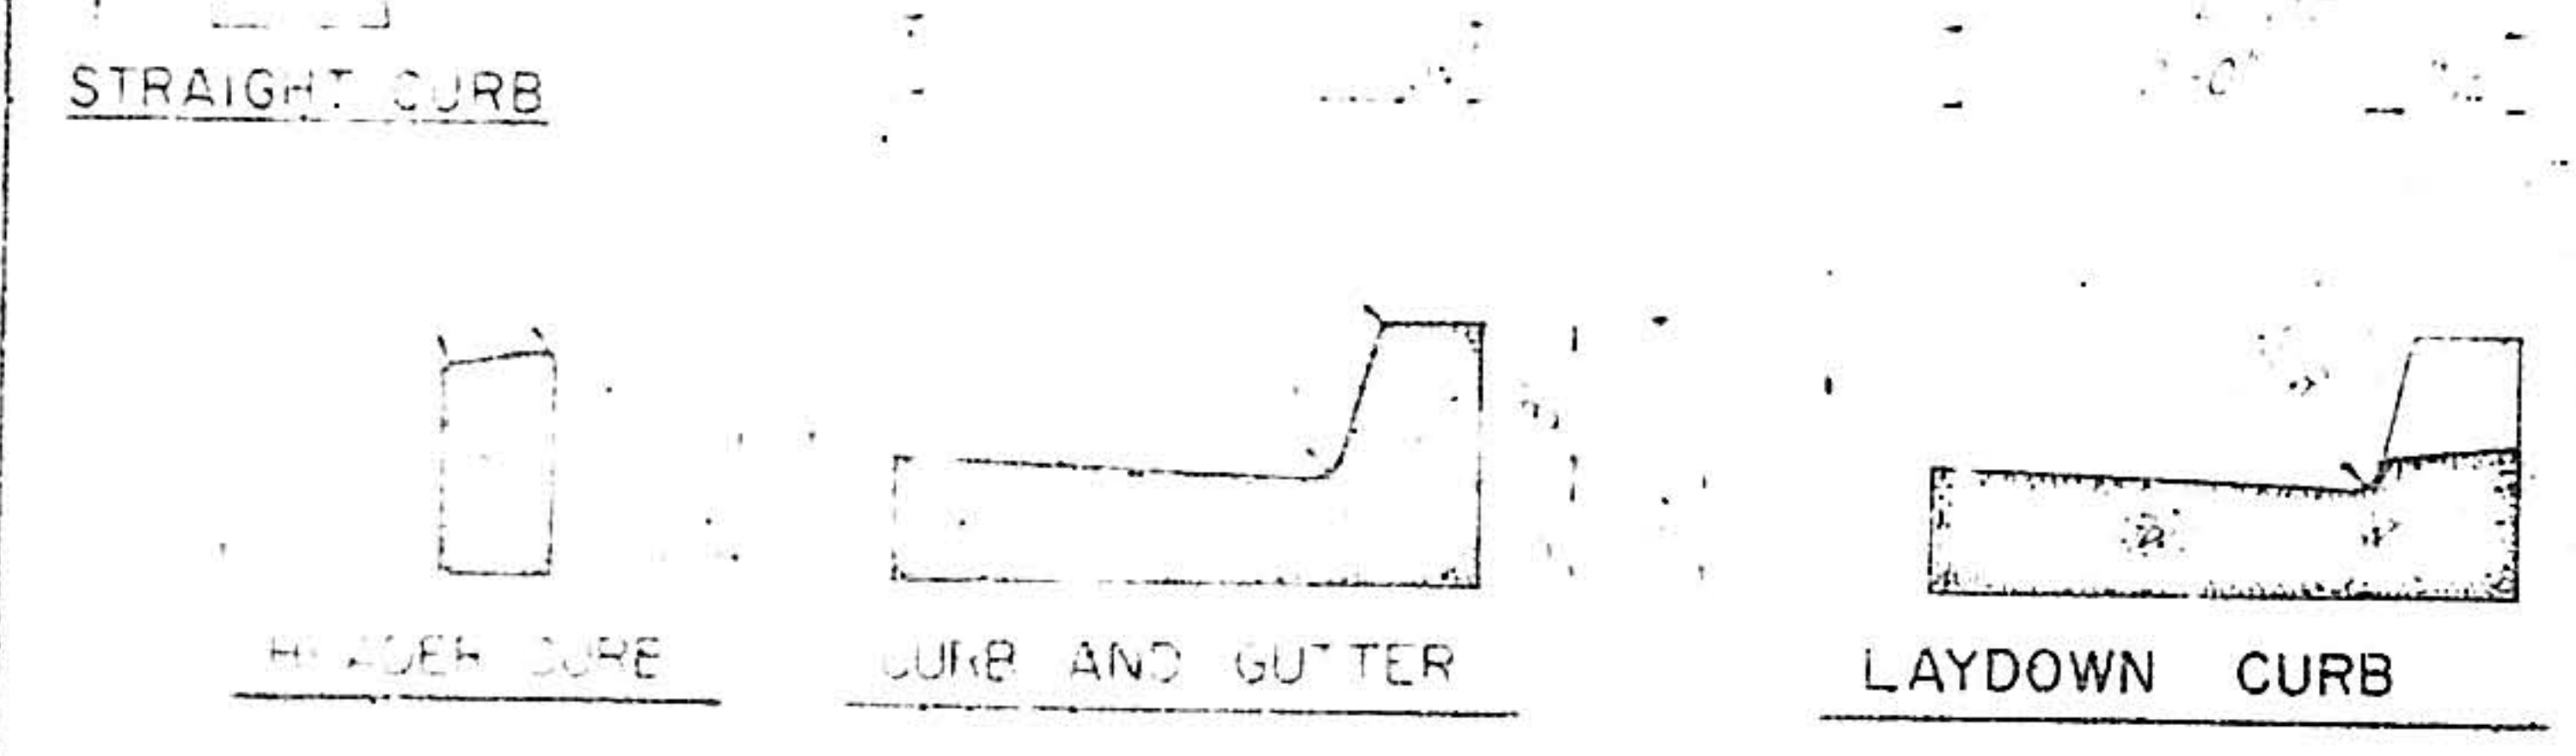
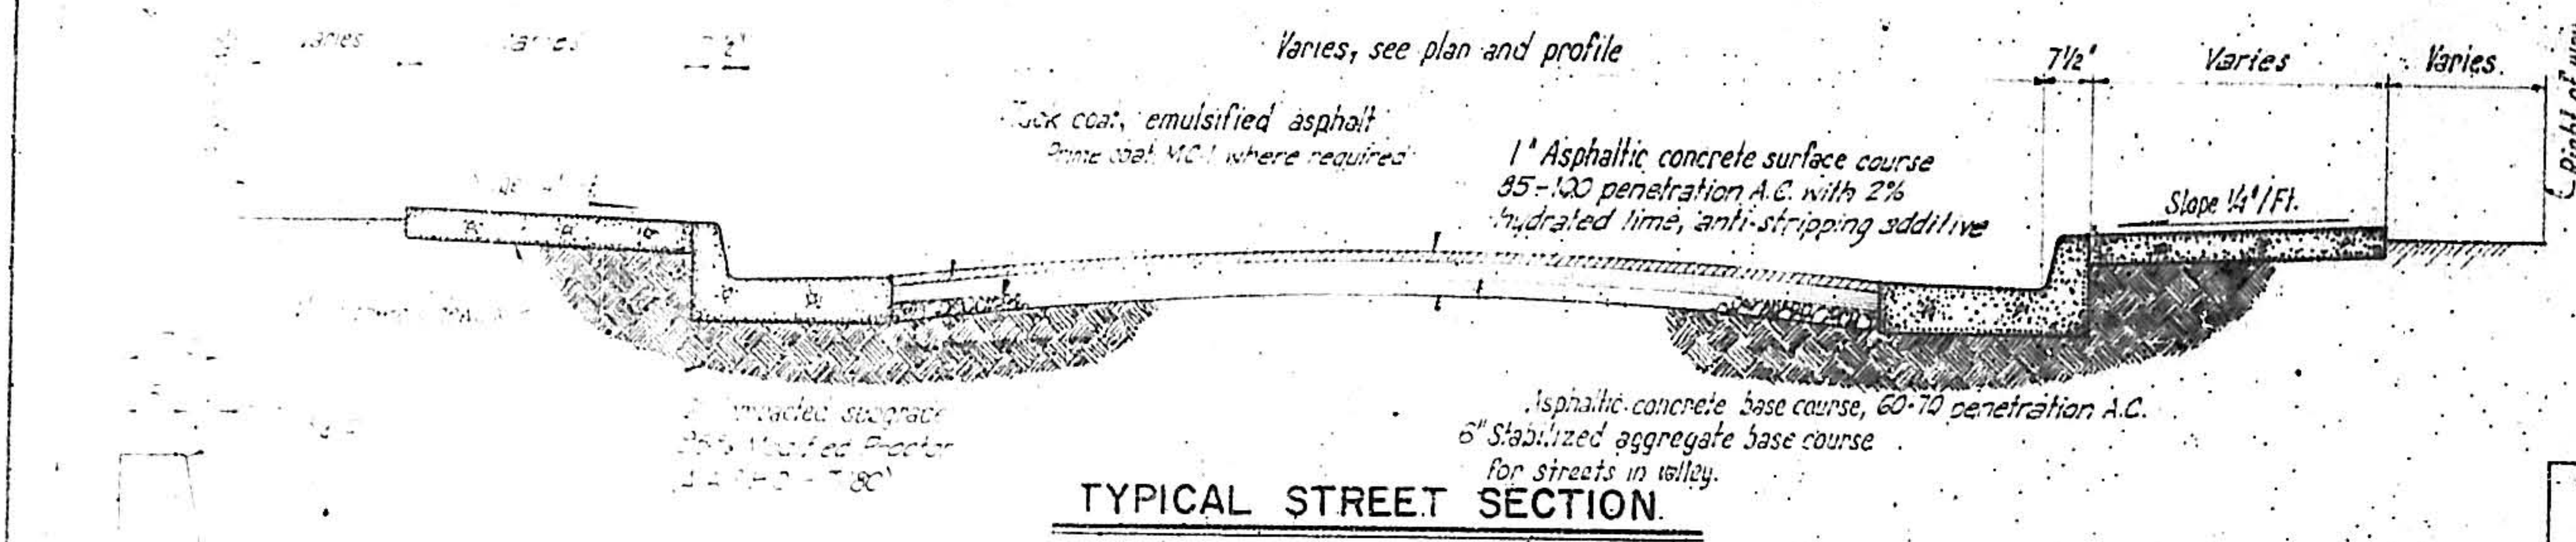


DIM.	Sidewalk Plate	Driveway Plate
A	2'-0 1/4"	2'-2"
B	1'-6 3/8"	1'-8 1/4"
C	1 3/4"	1 3/4"
D	3 3/8"	3 3/8"
E	3 3/8"	3 3/8"
F	1'-2"	2'-2"
G	1'	2'
H	Varies	Varies

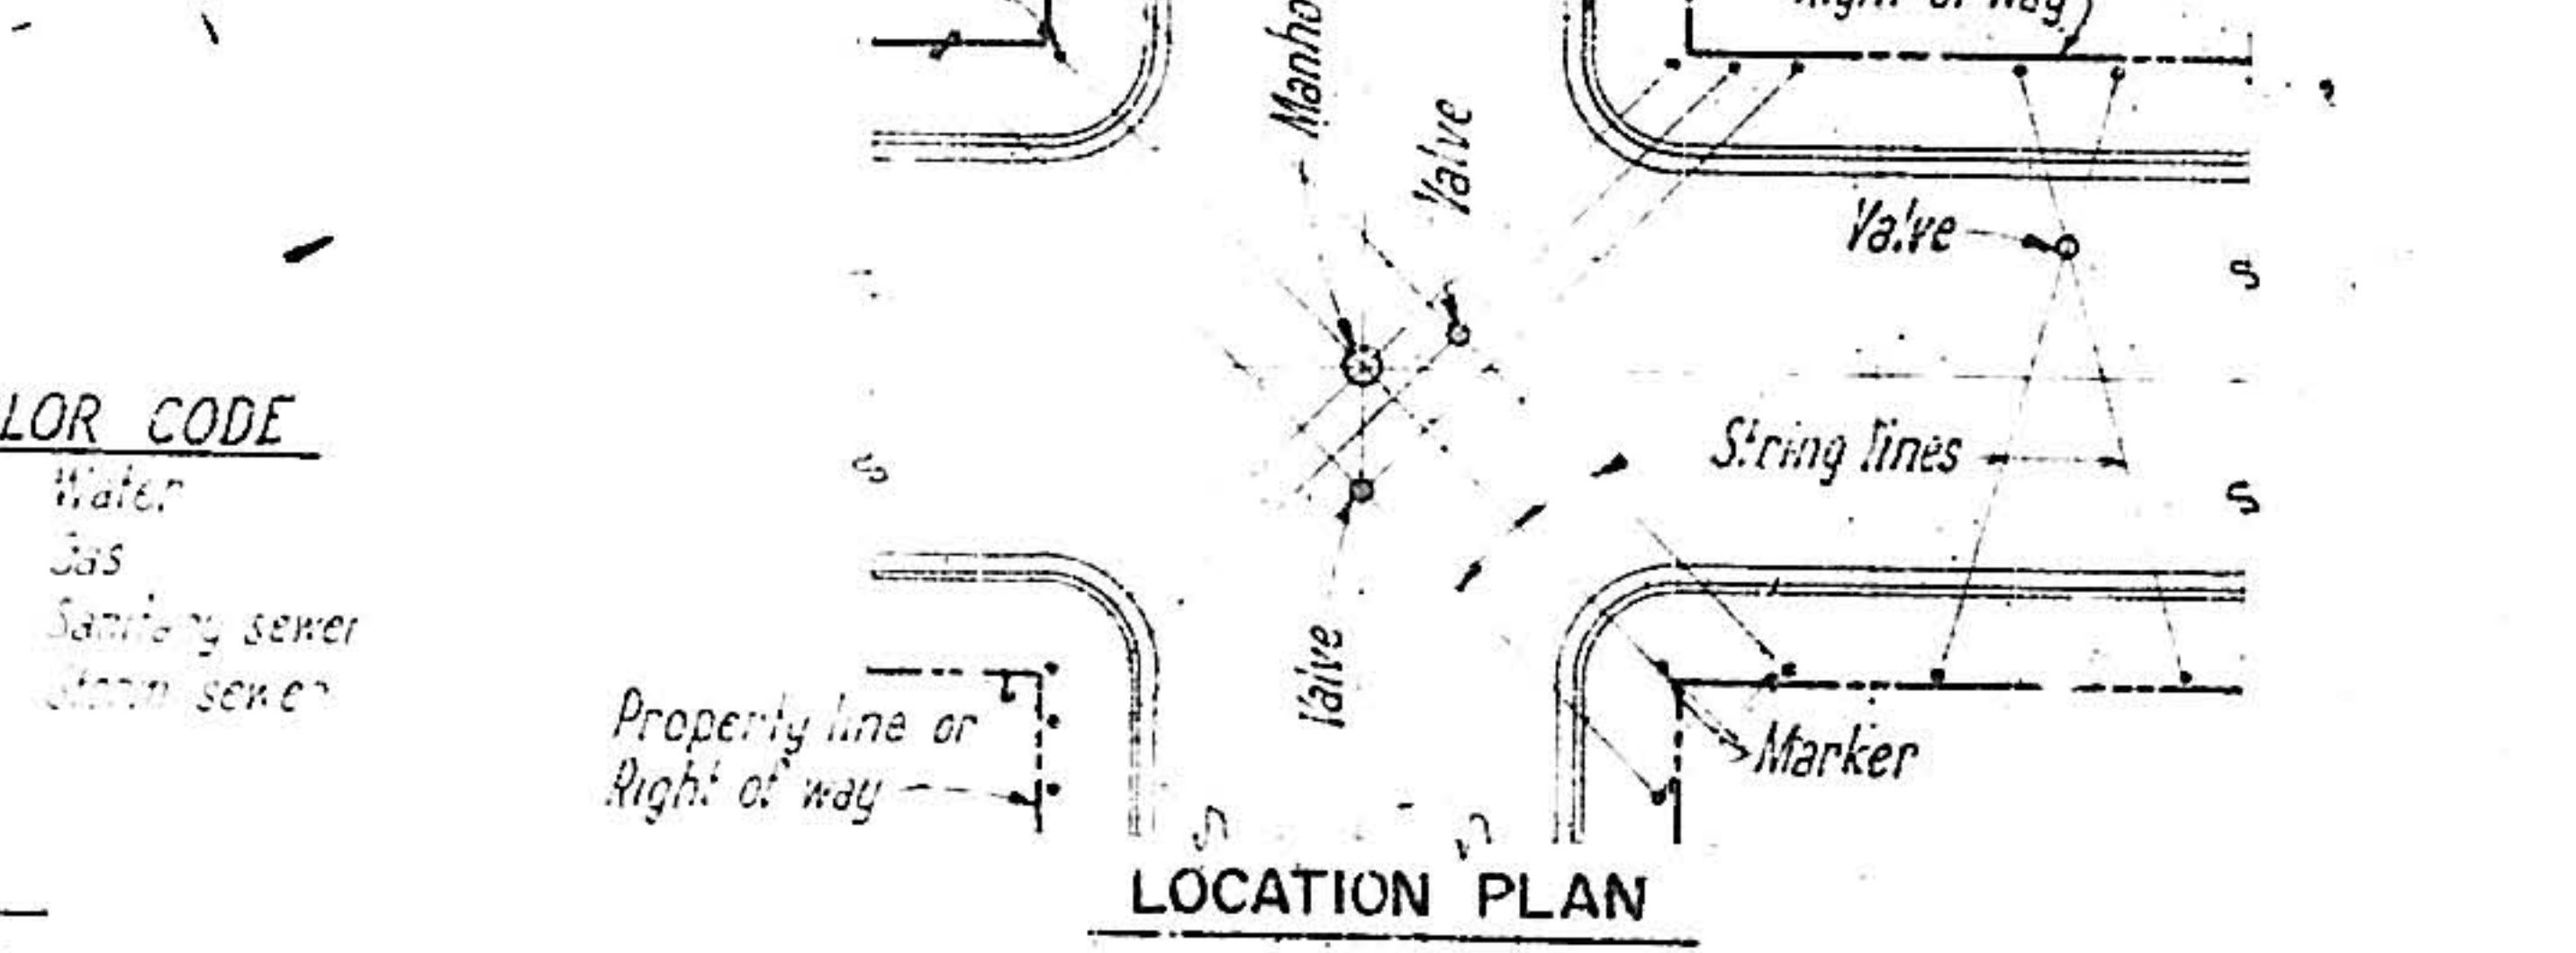 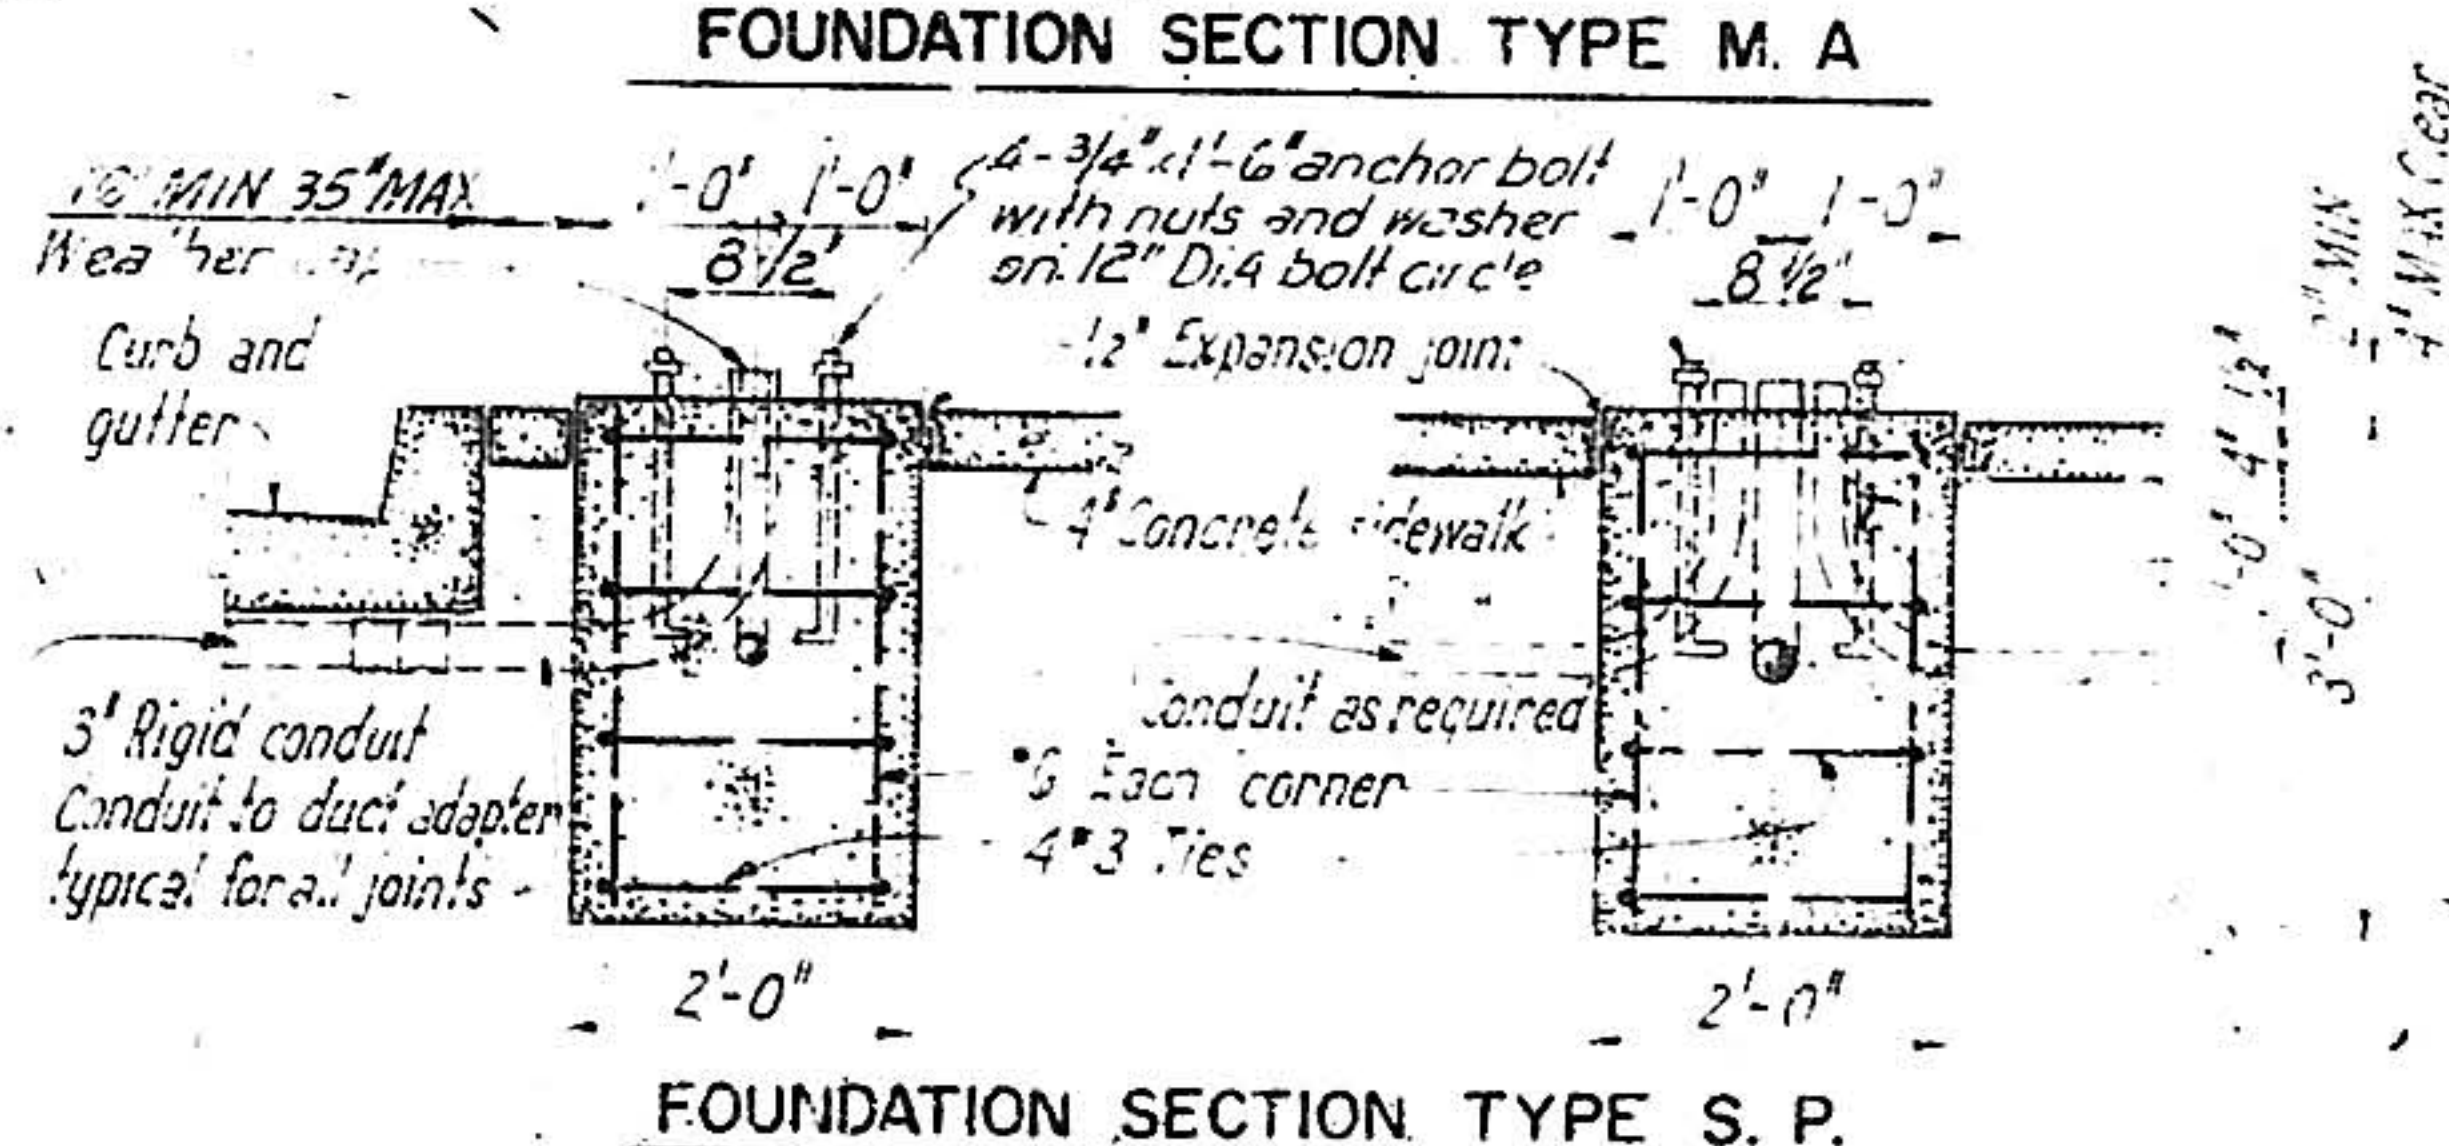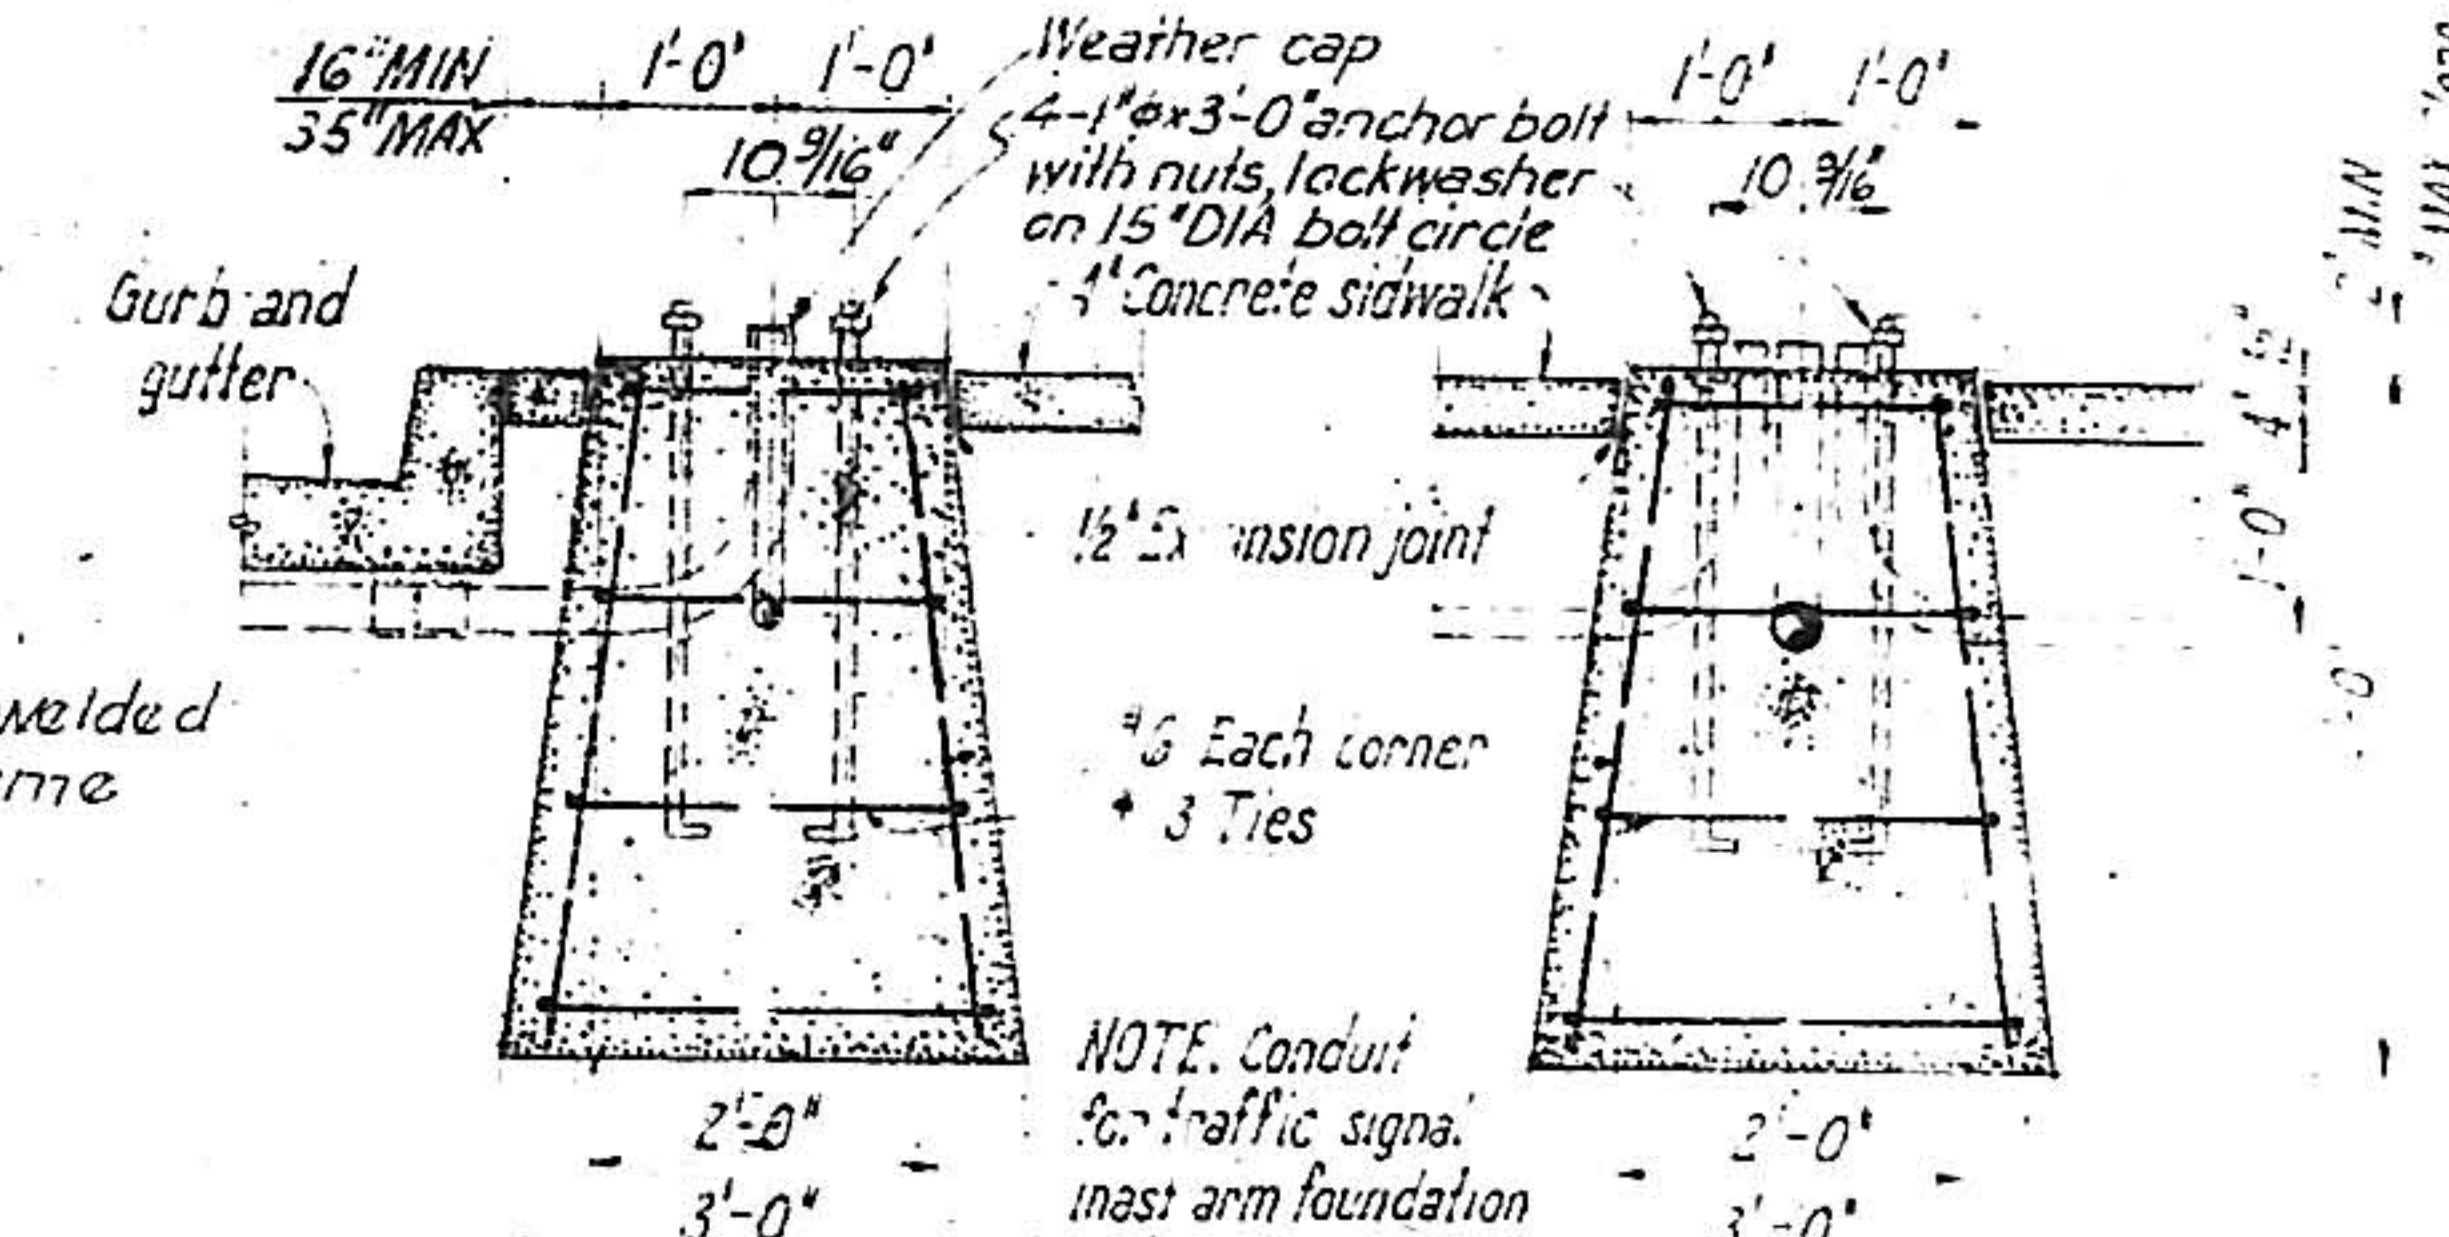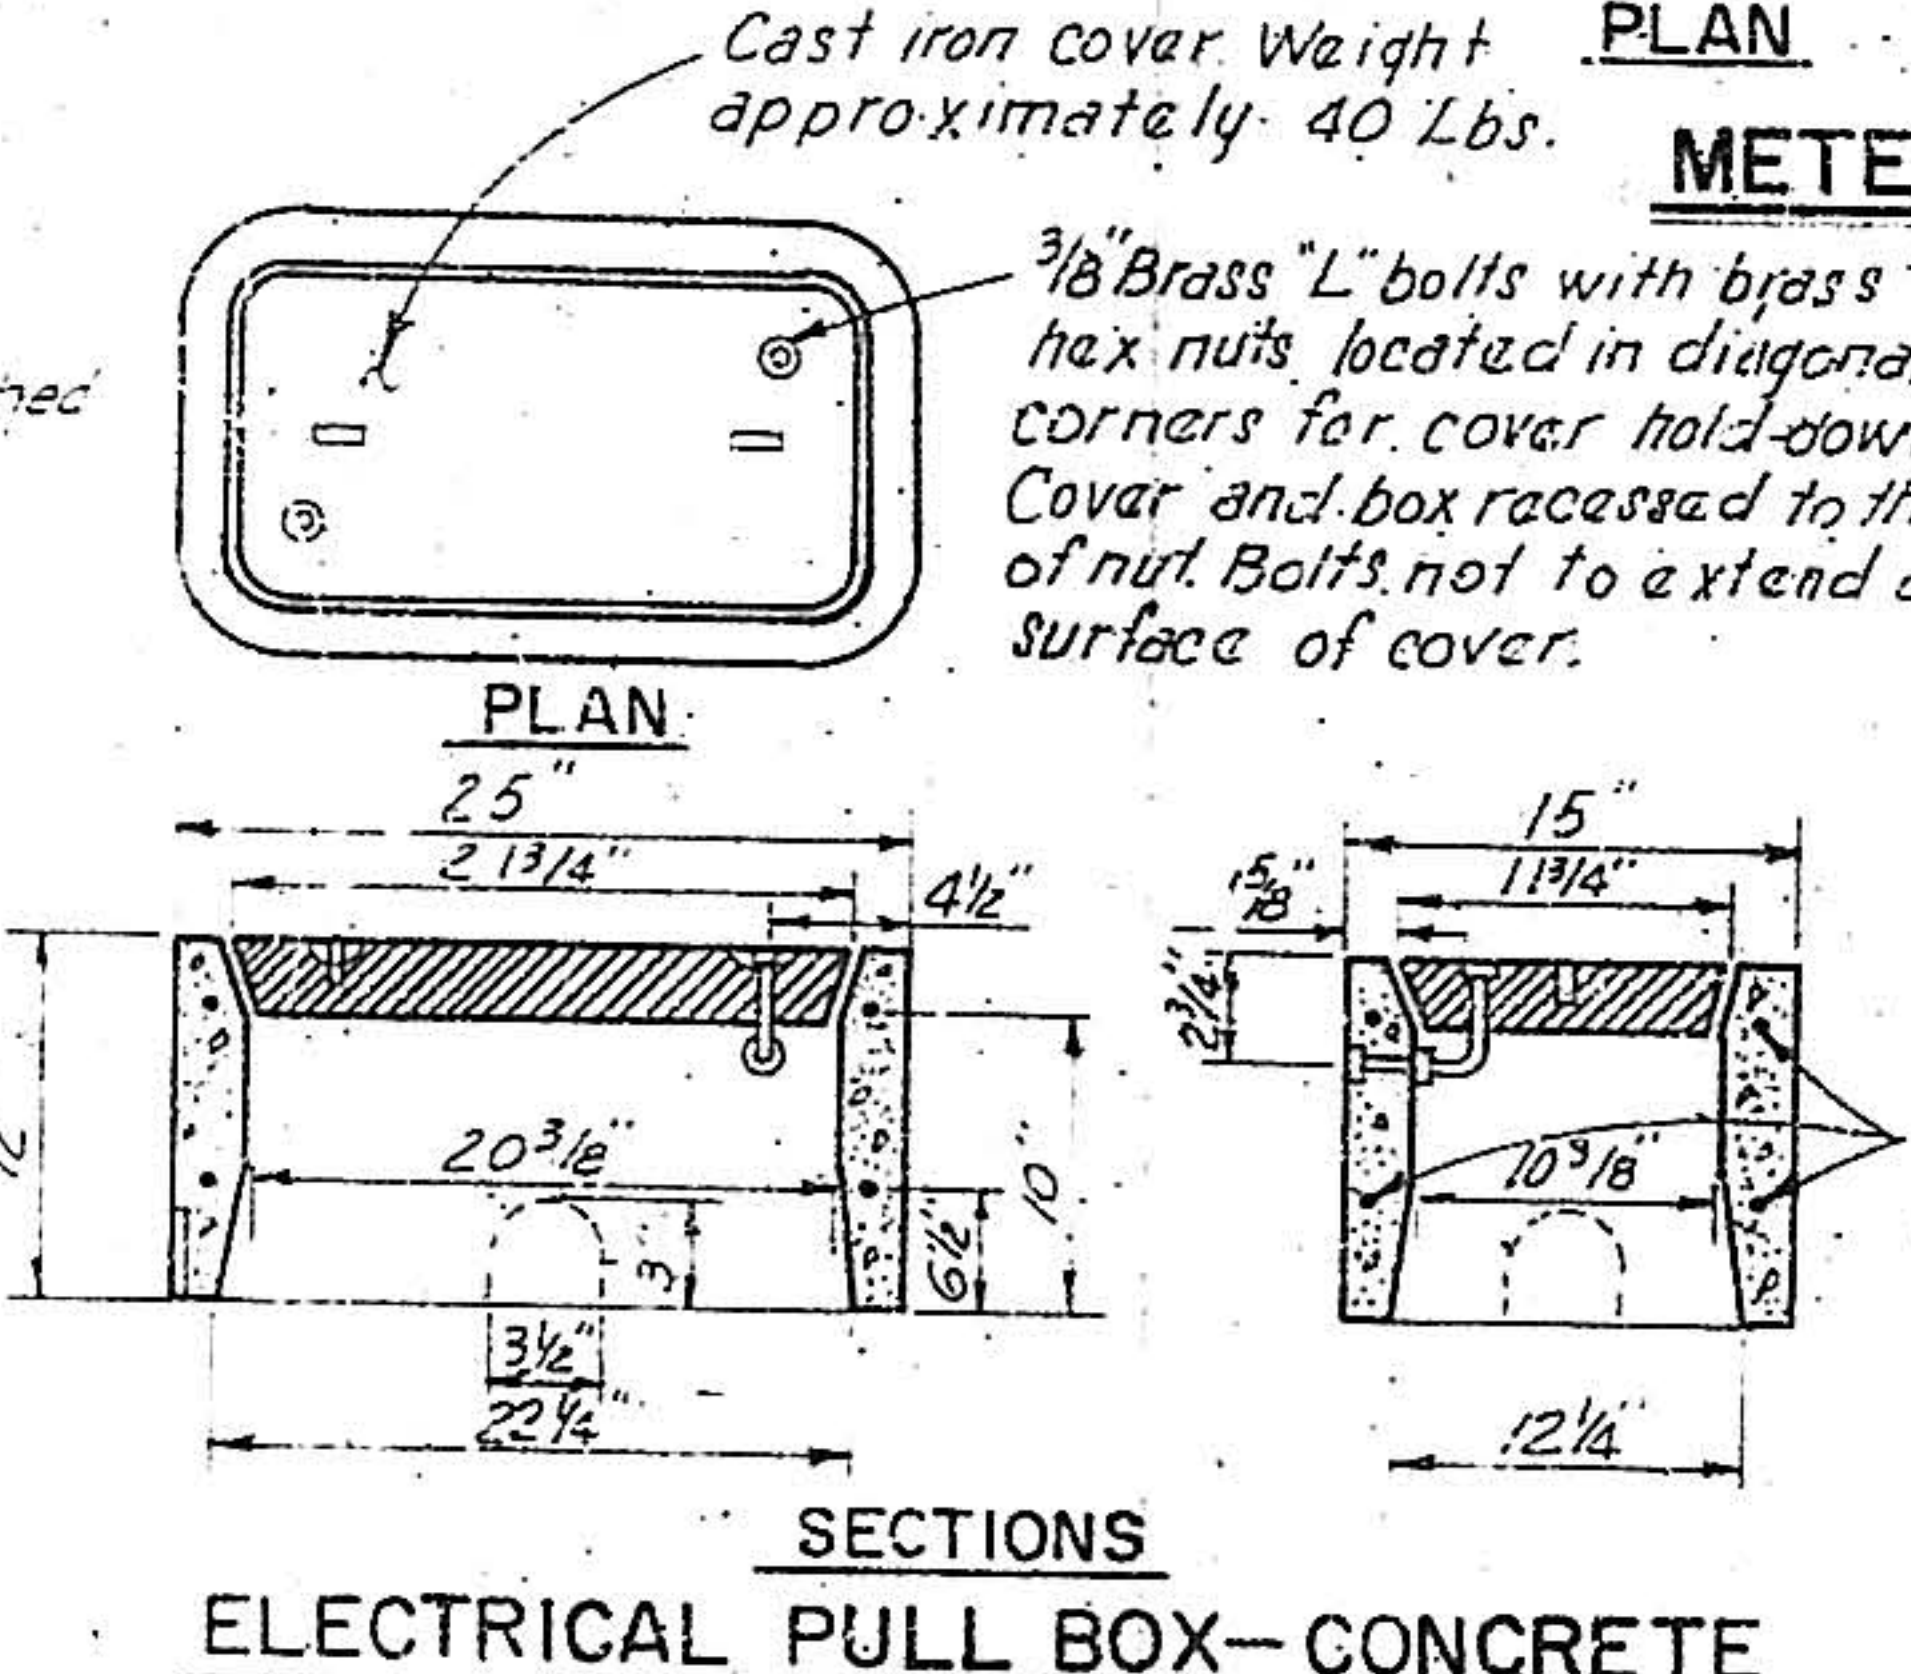 [illegible]


1	2	3	4	5	6	7	8	9	10	11	12	13	14	15	16	17	18	19	20	21	22	23	24	25	26	27	28	29	
1	0		7	0	4				0	4	7	0						1	0										
08																													

AS CONSTRUCTED ALBUQUERQUE, NEW MEXICO PAVING STANDARD			
RESIDENTIAL STREET PAVEMENT DETAILS			
GORDON HERKENHOFF & ASSOCIATES, INC. CONSULTING ENGINEERS			
ALBUQUERQUE		NEW MEXICO	
SCALE	DATE	DRAWN: A.O.H.	SHEET 4
NOT TO SCALE		CHECKED: G.A.J.	OF 10.

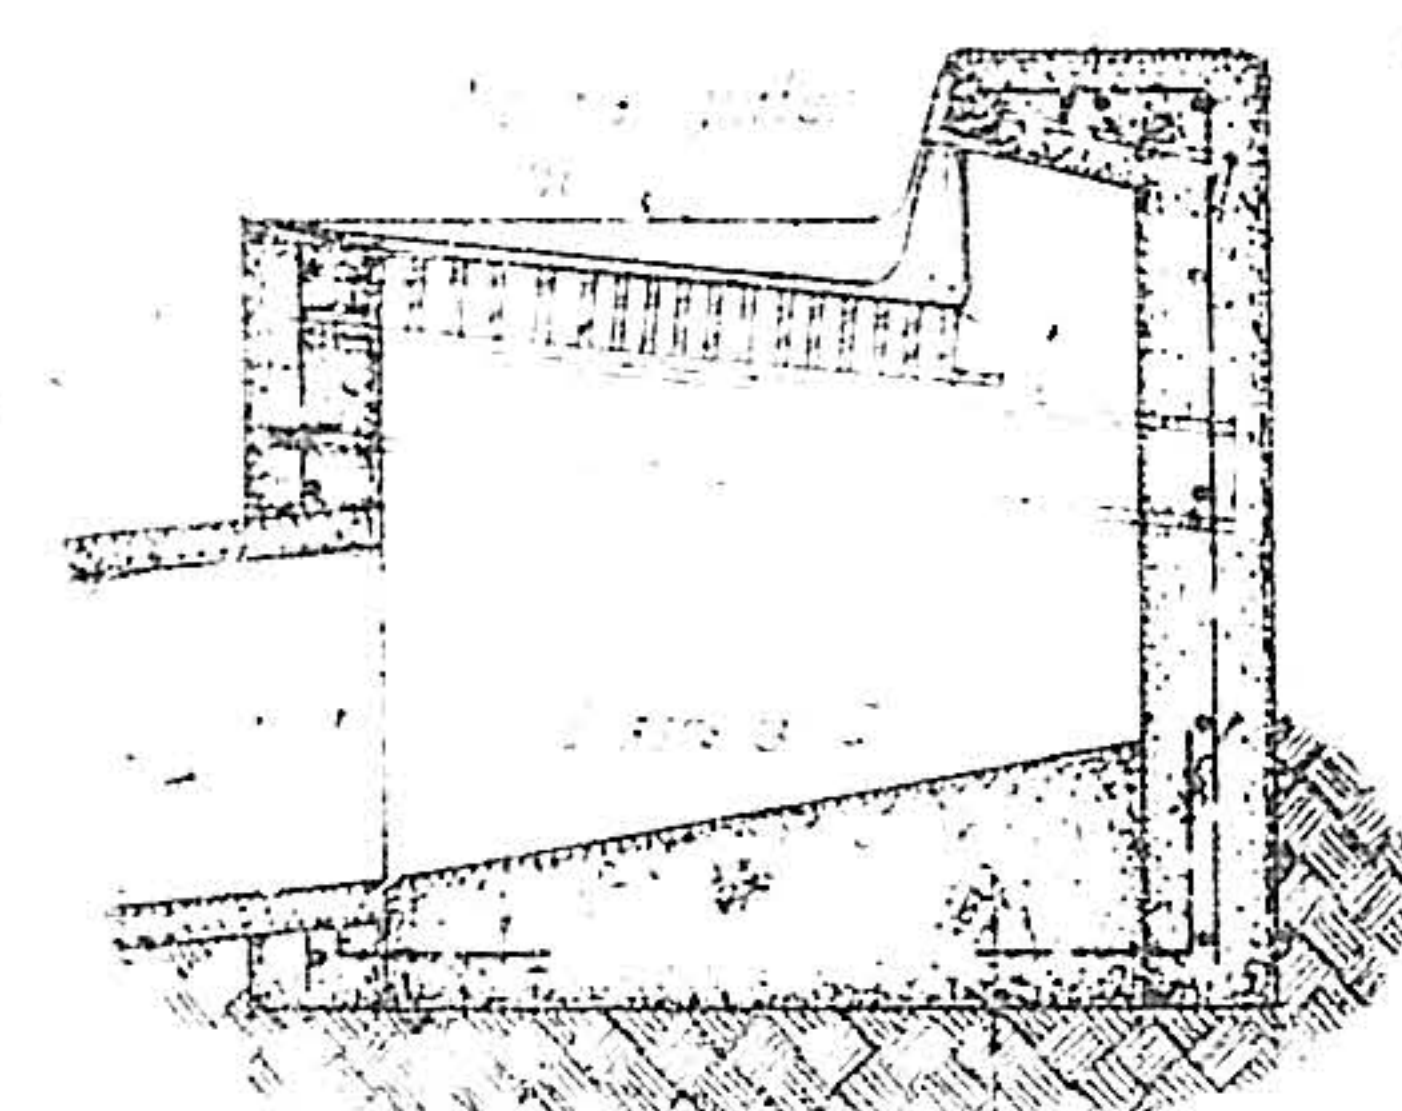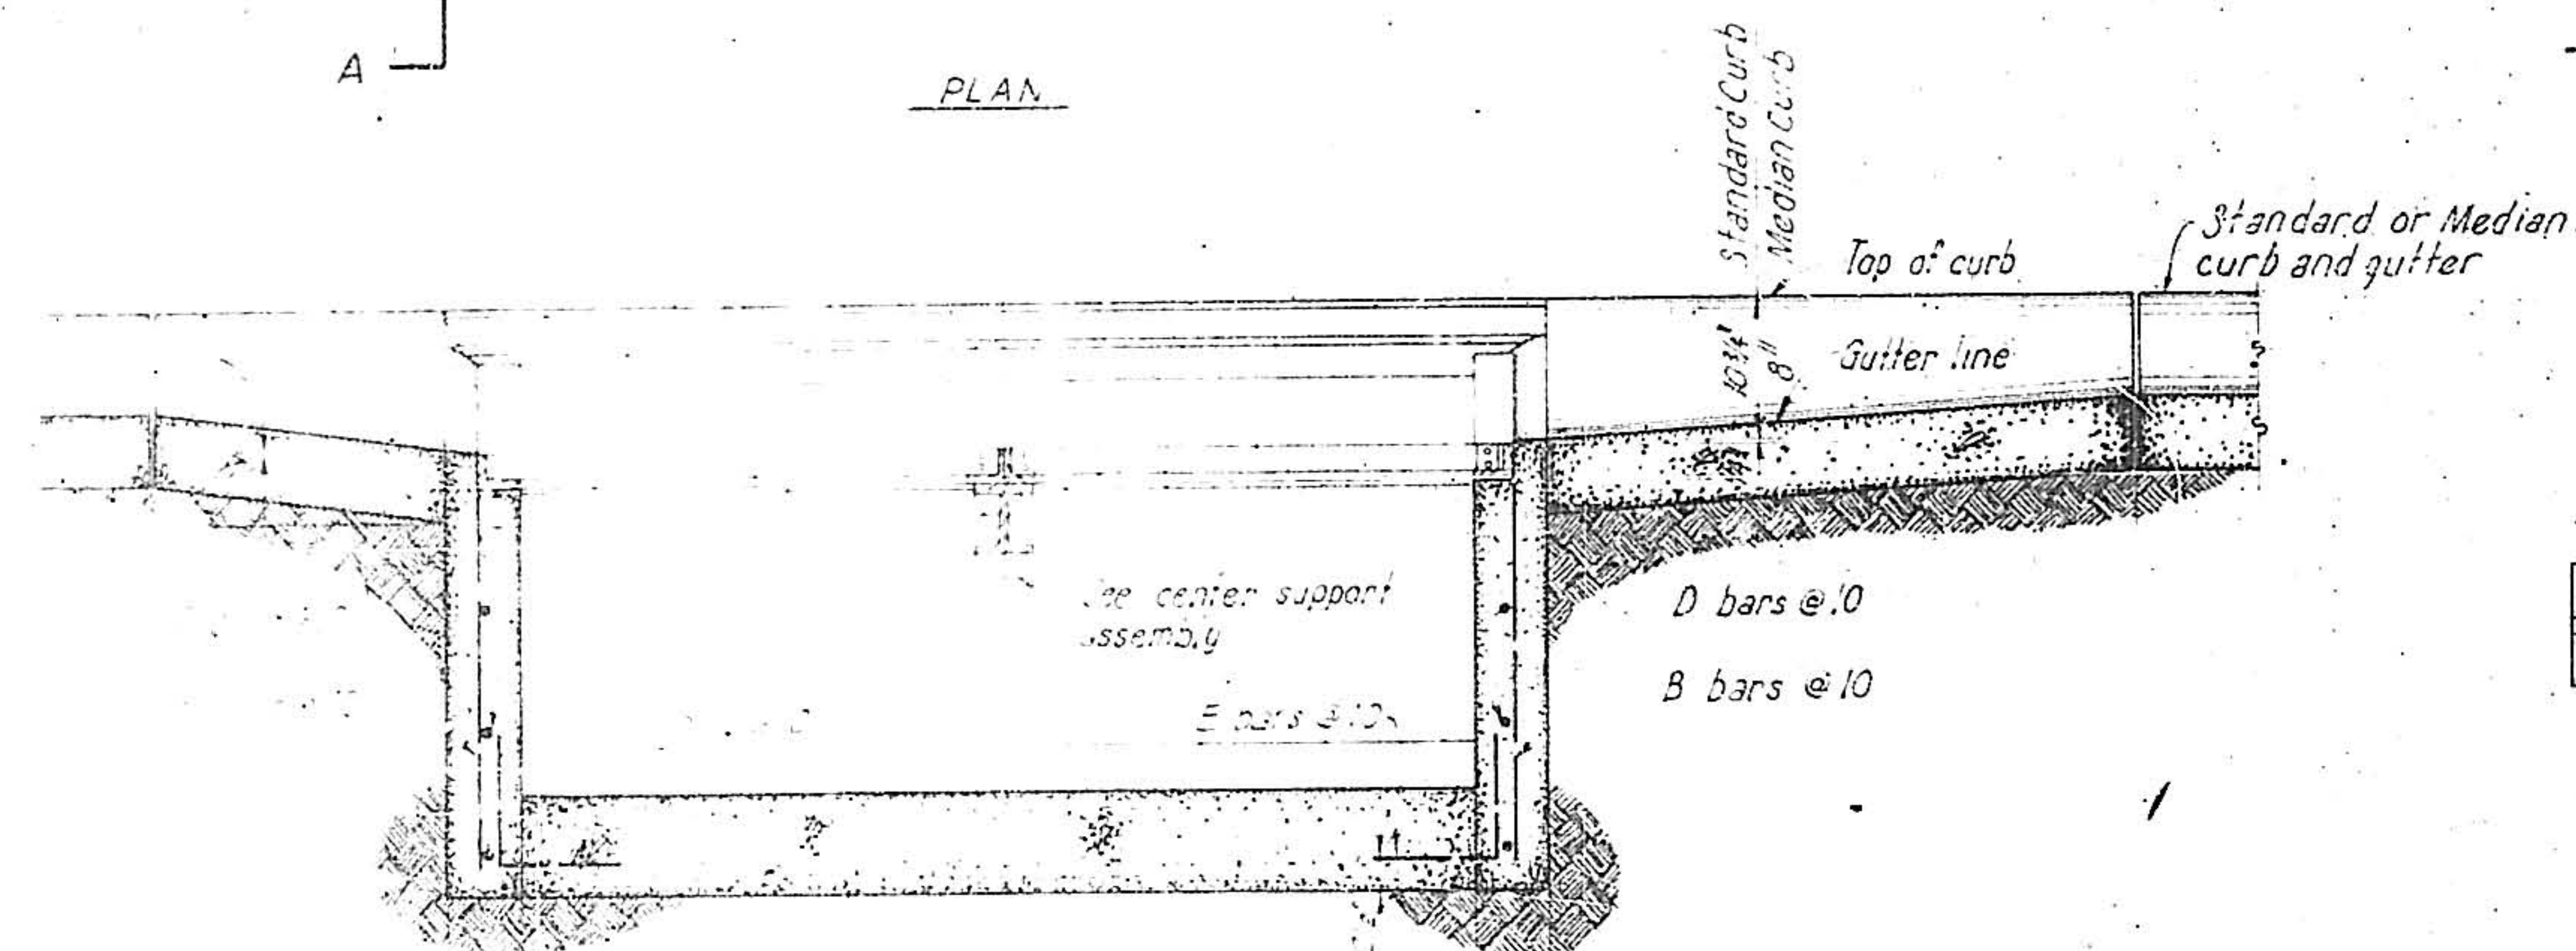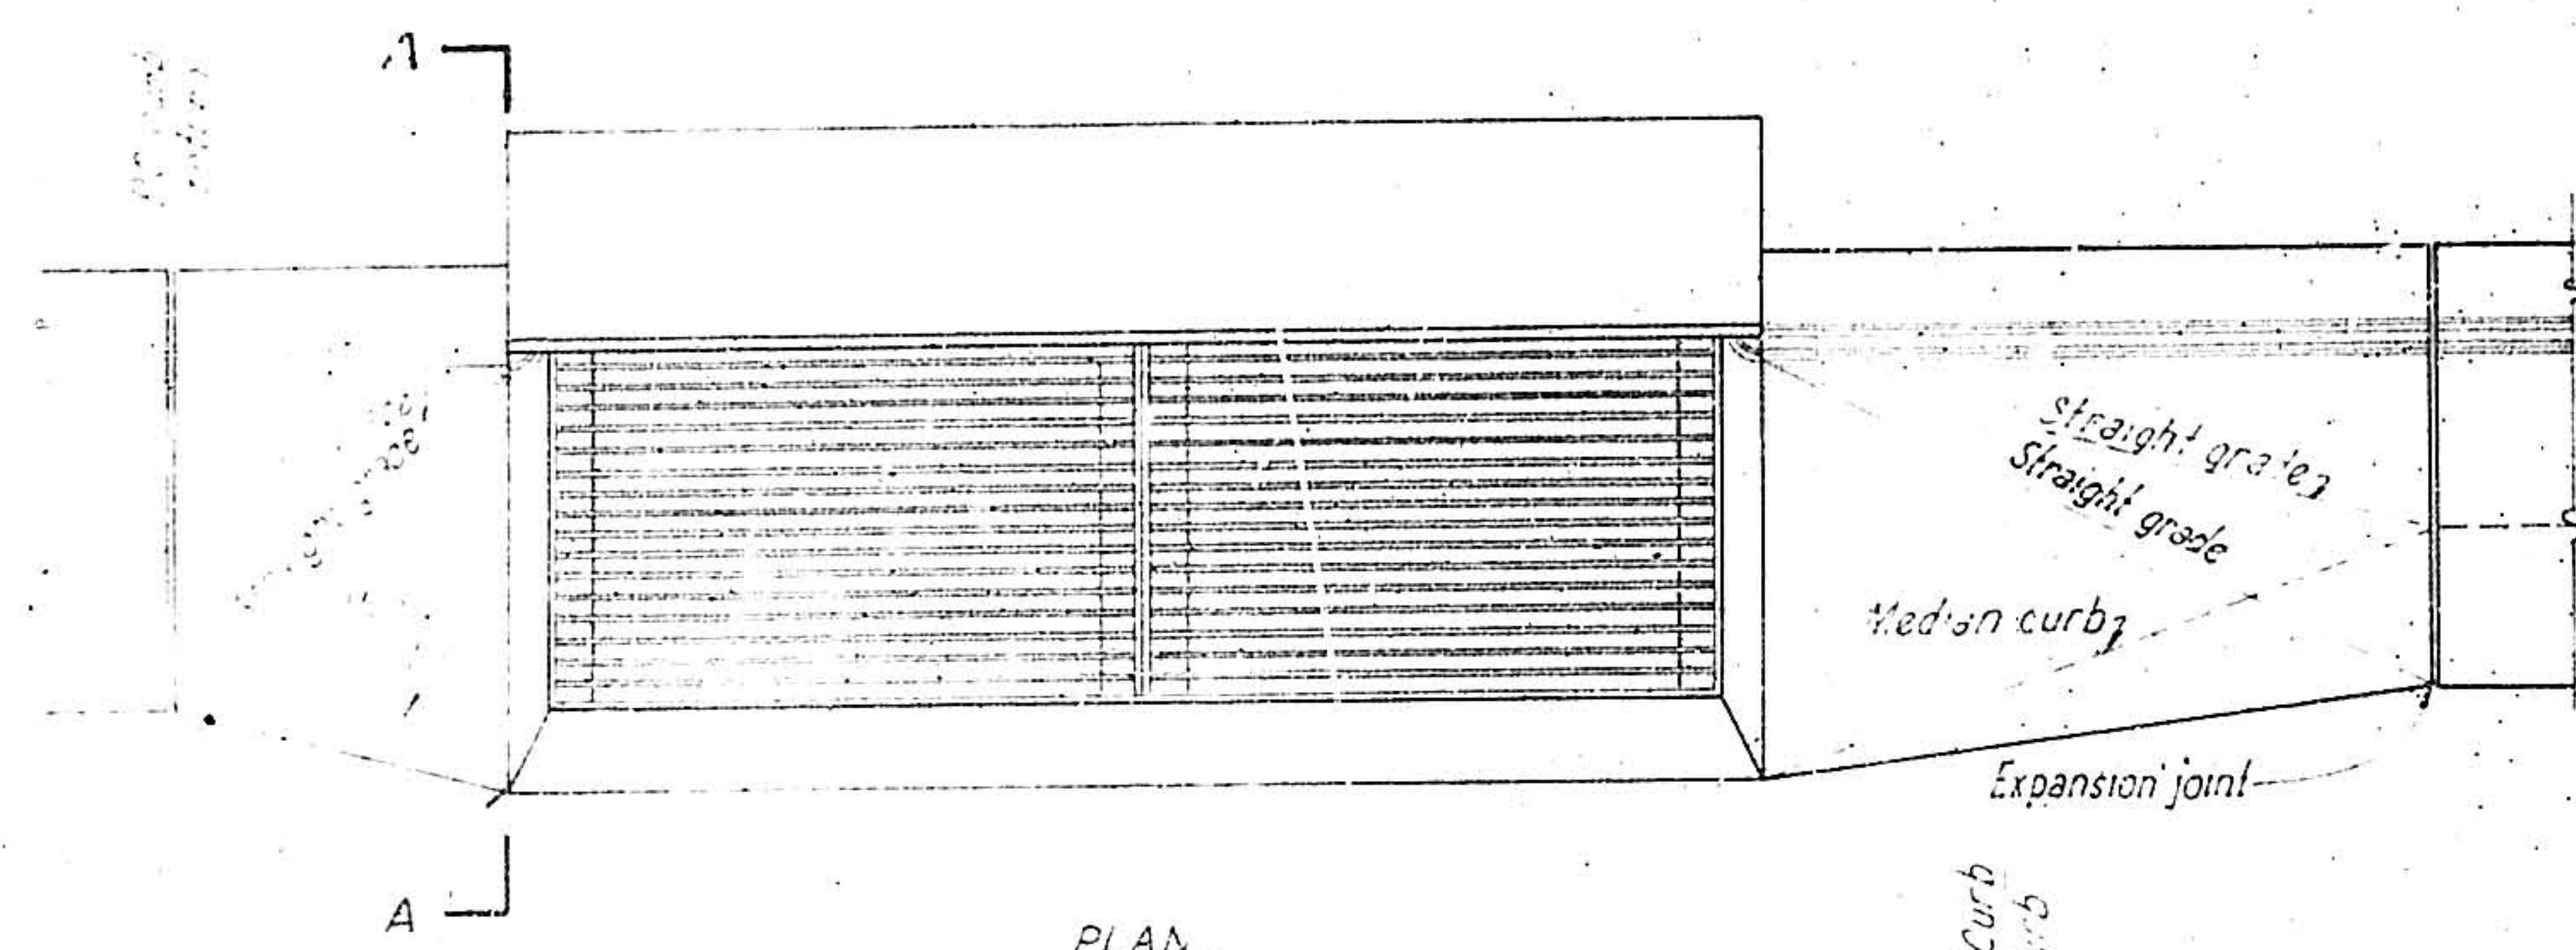

DOUBLE C INLET




ANCHOR DETAIL

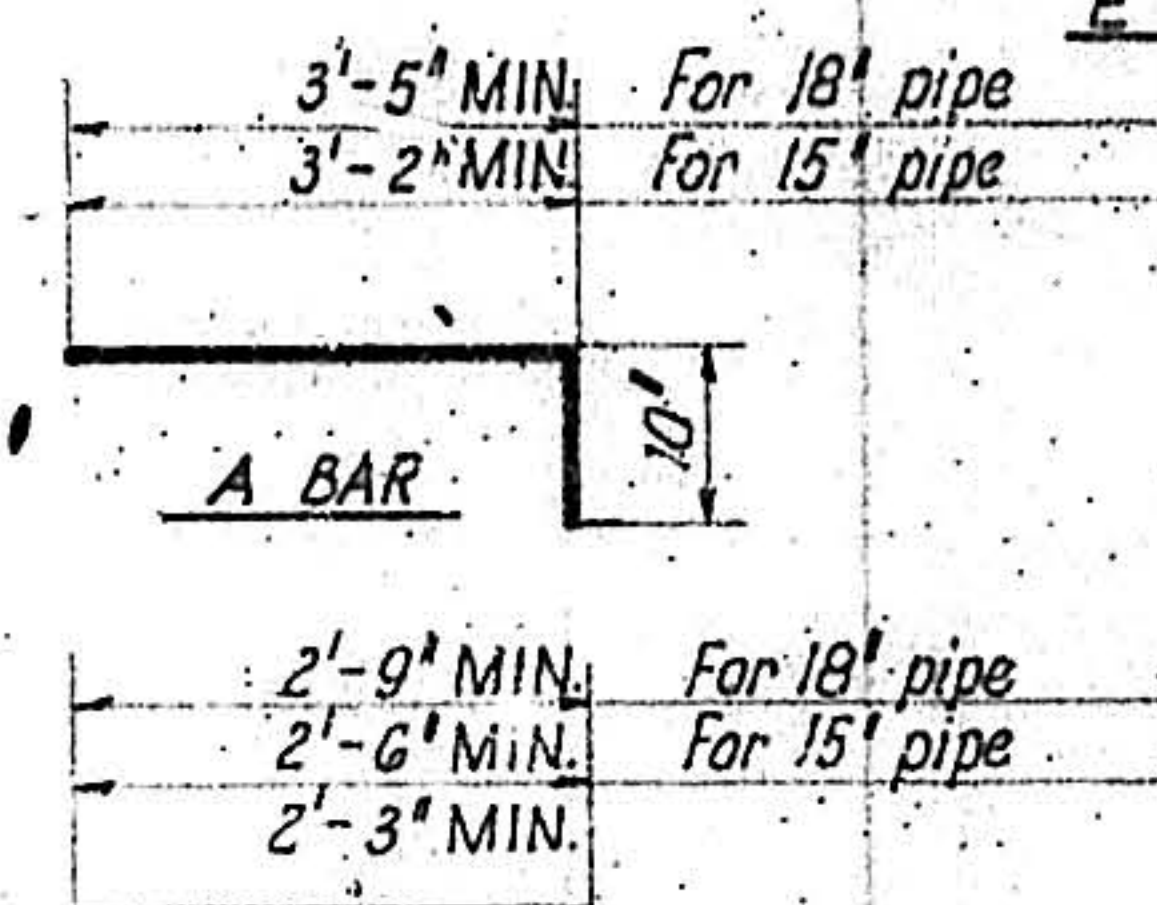

NOTE: All bars to be #4

BAR BENDING DETAILS

Not to scale

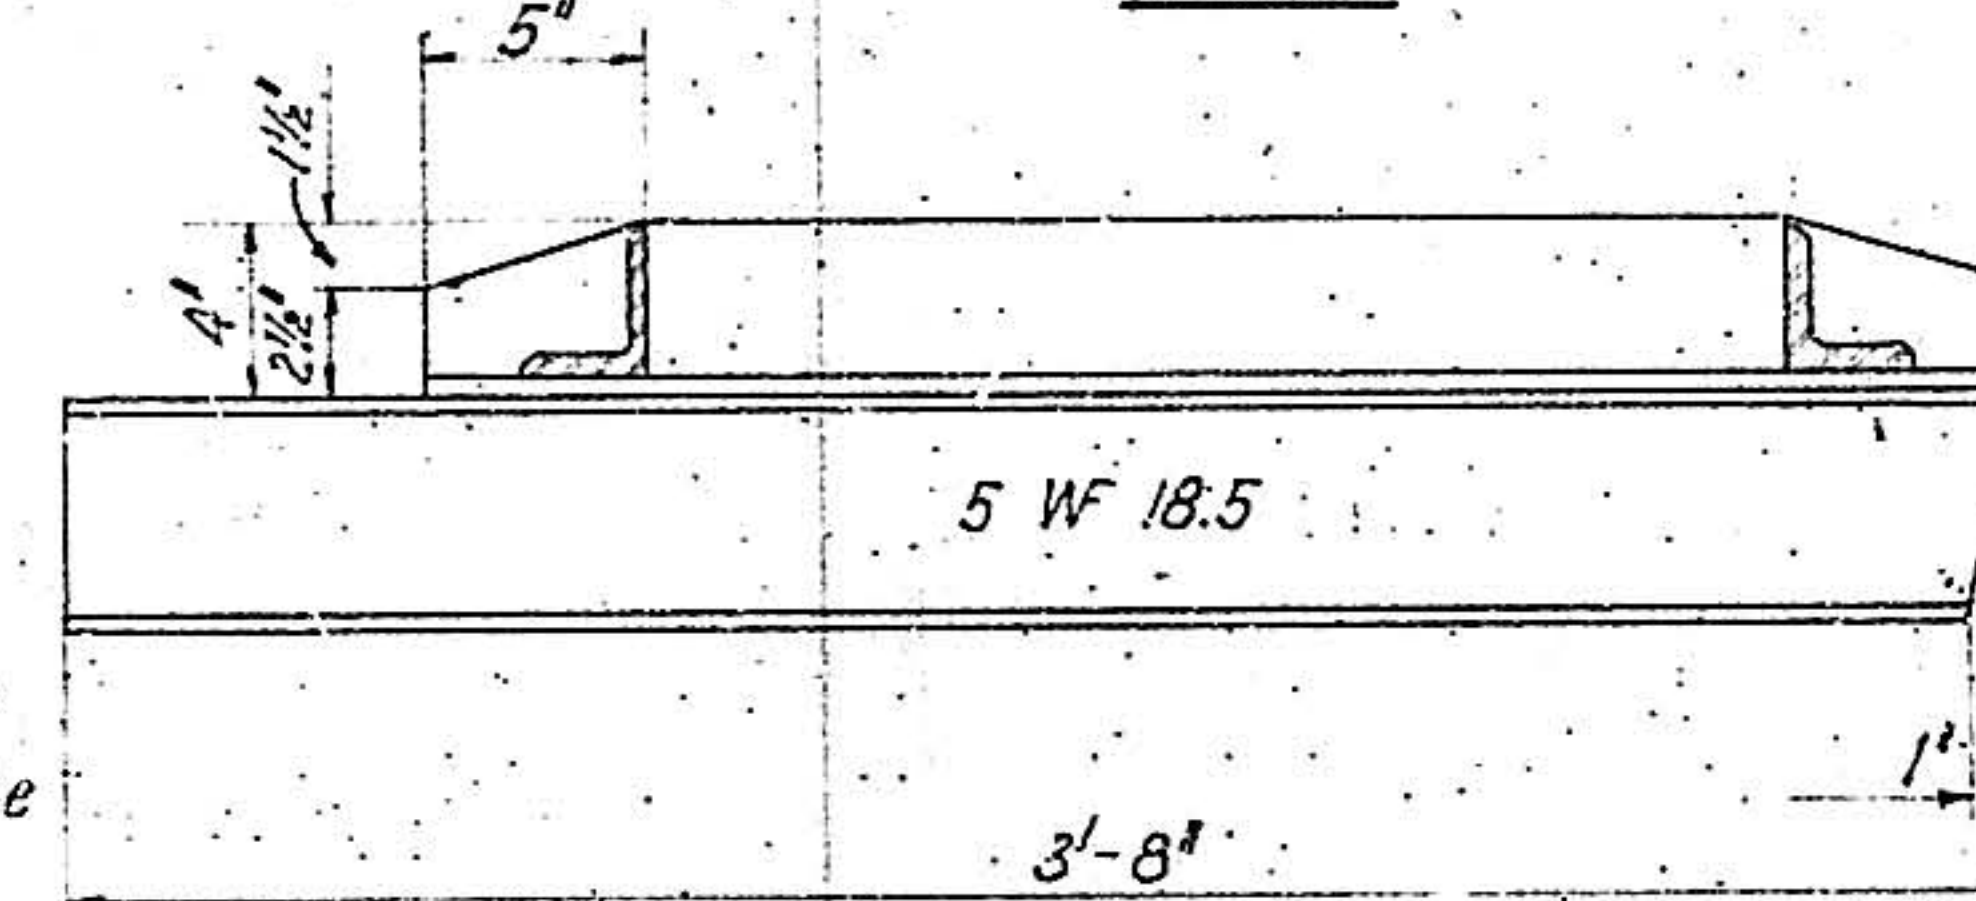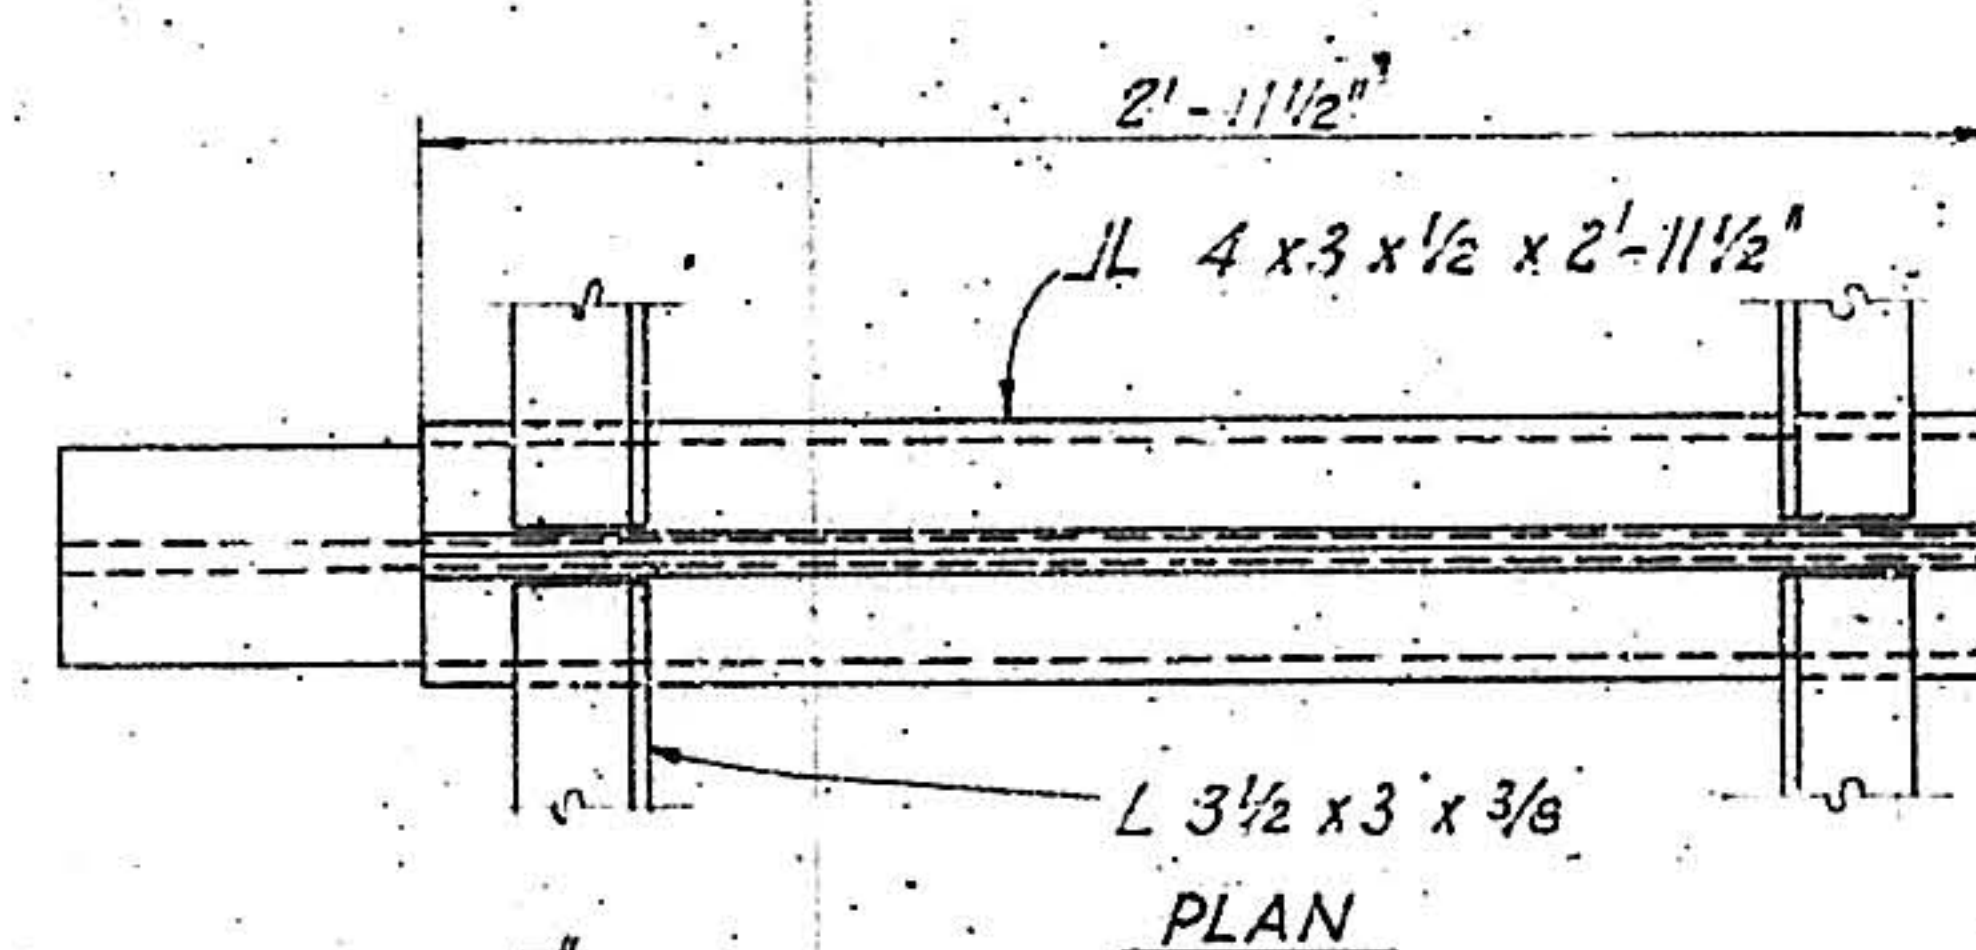
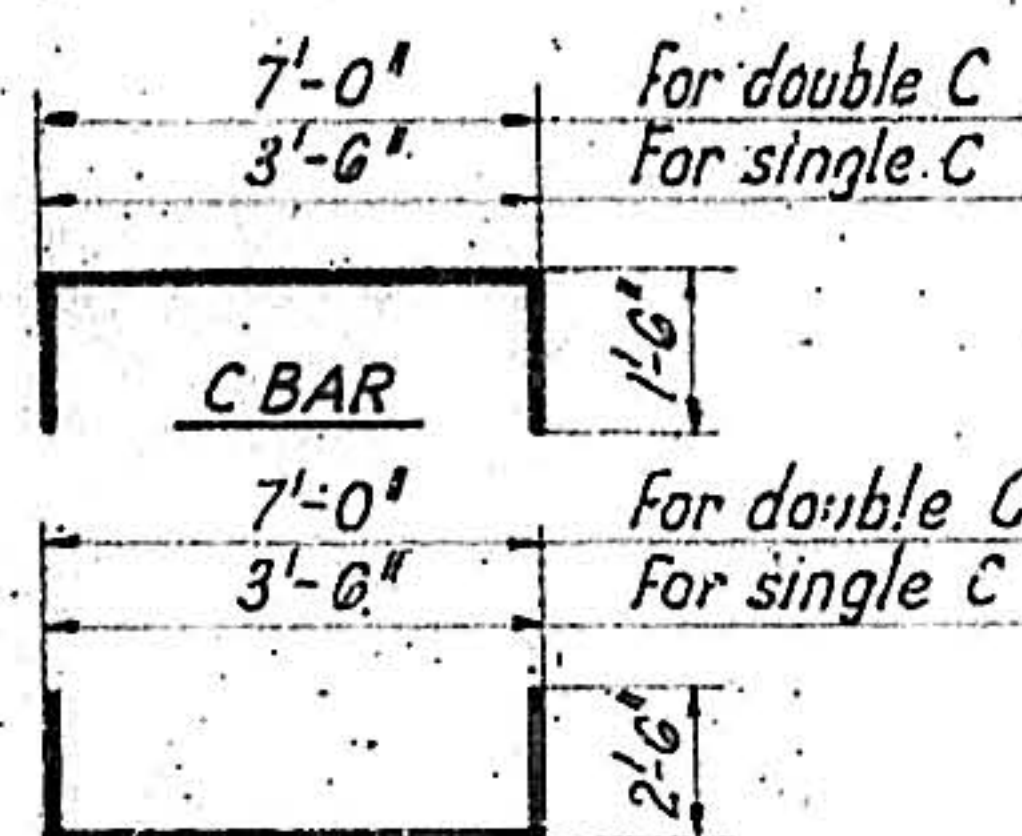


CENTER SUPPORT ASSEMBLY

Scale: 1/2" = 1'-0"




STEP DETAIL

Scale: 3/4" = 1'-0"

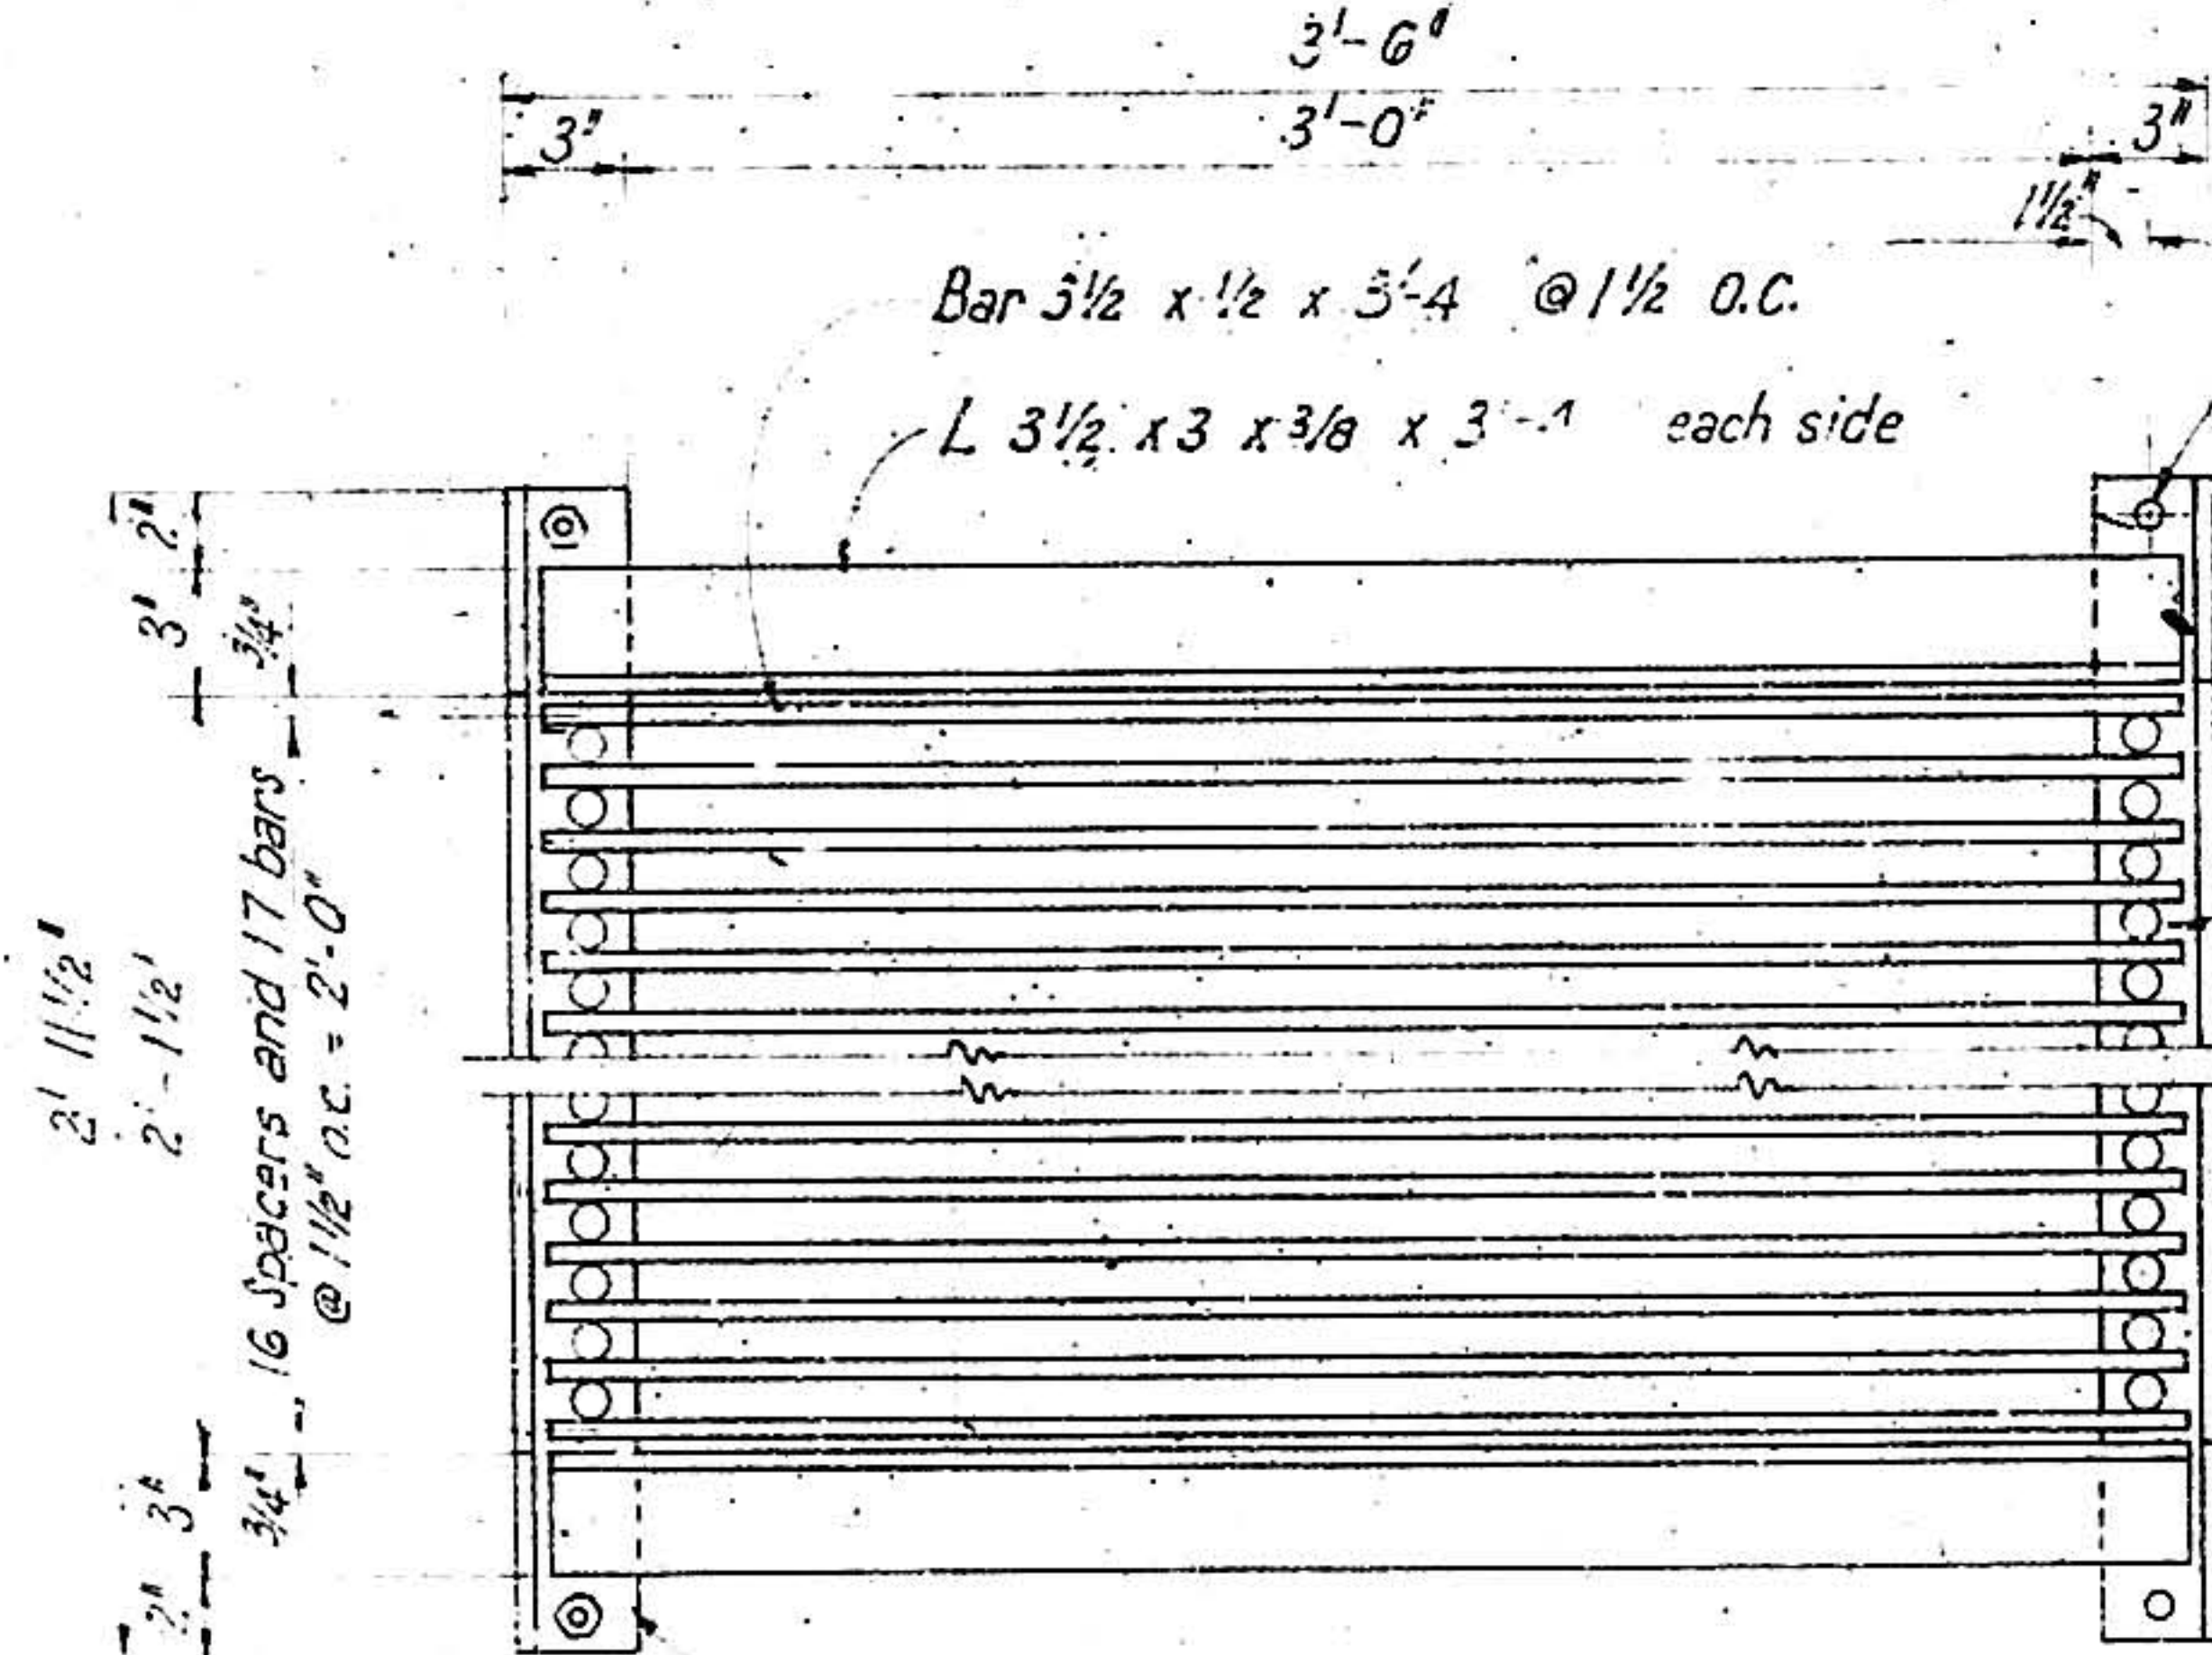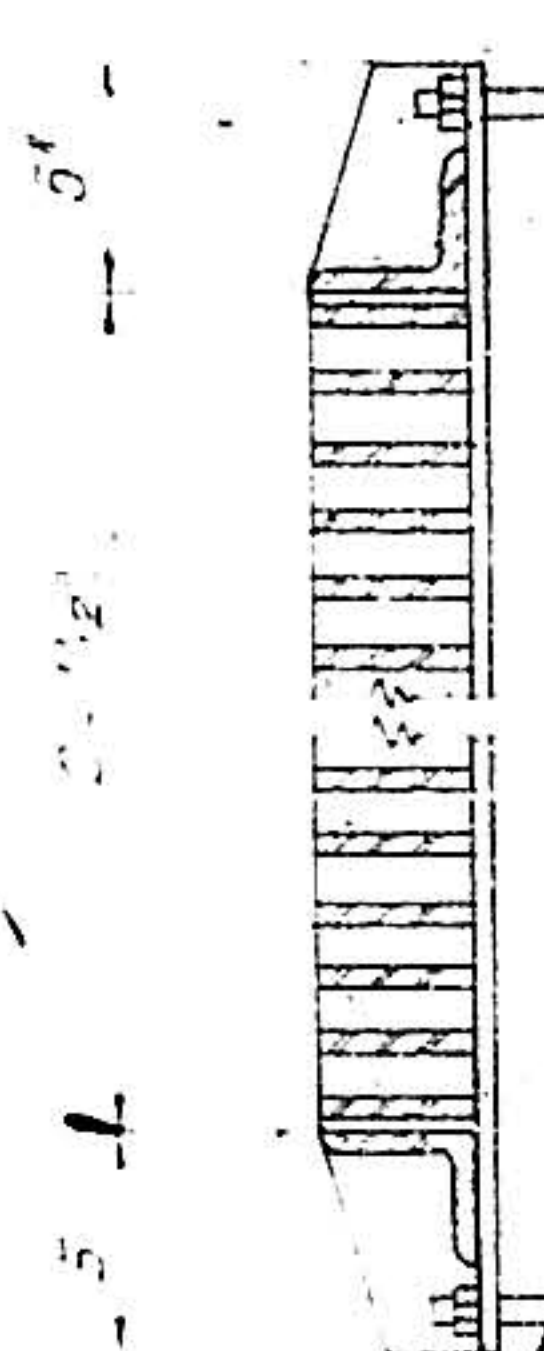

FRAME AND GRATING DETAILS


Scale: 1/2" = 1'-0"

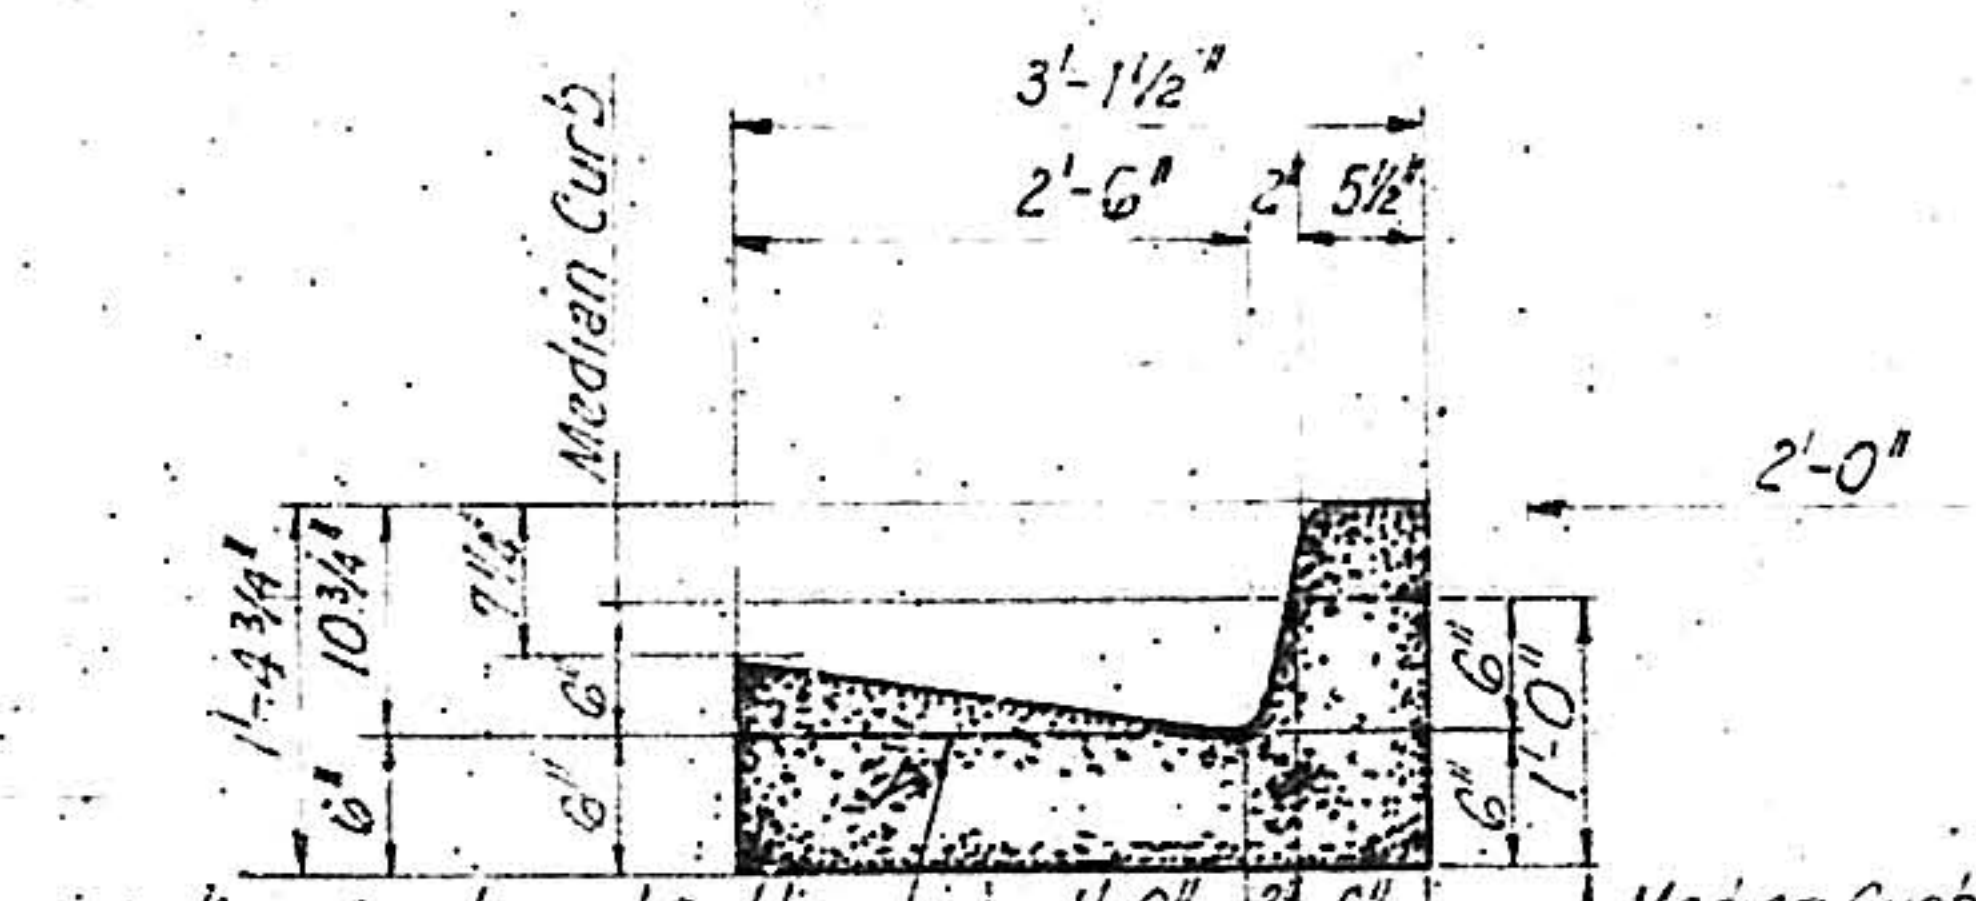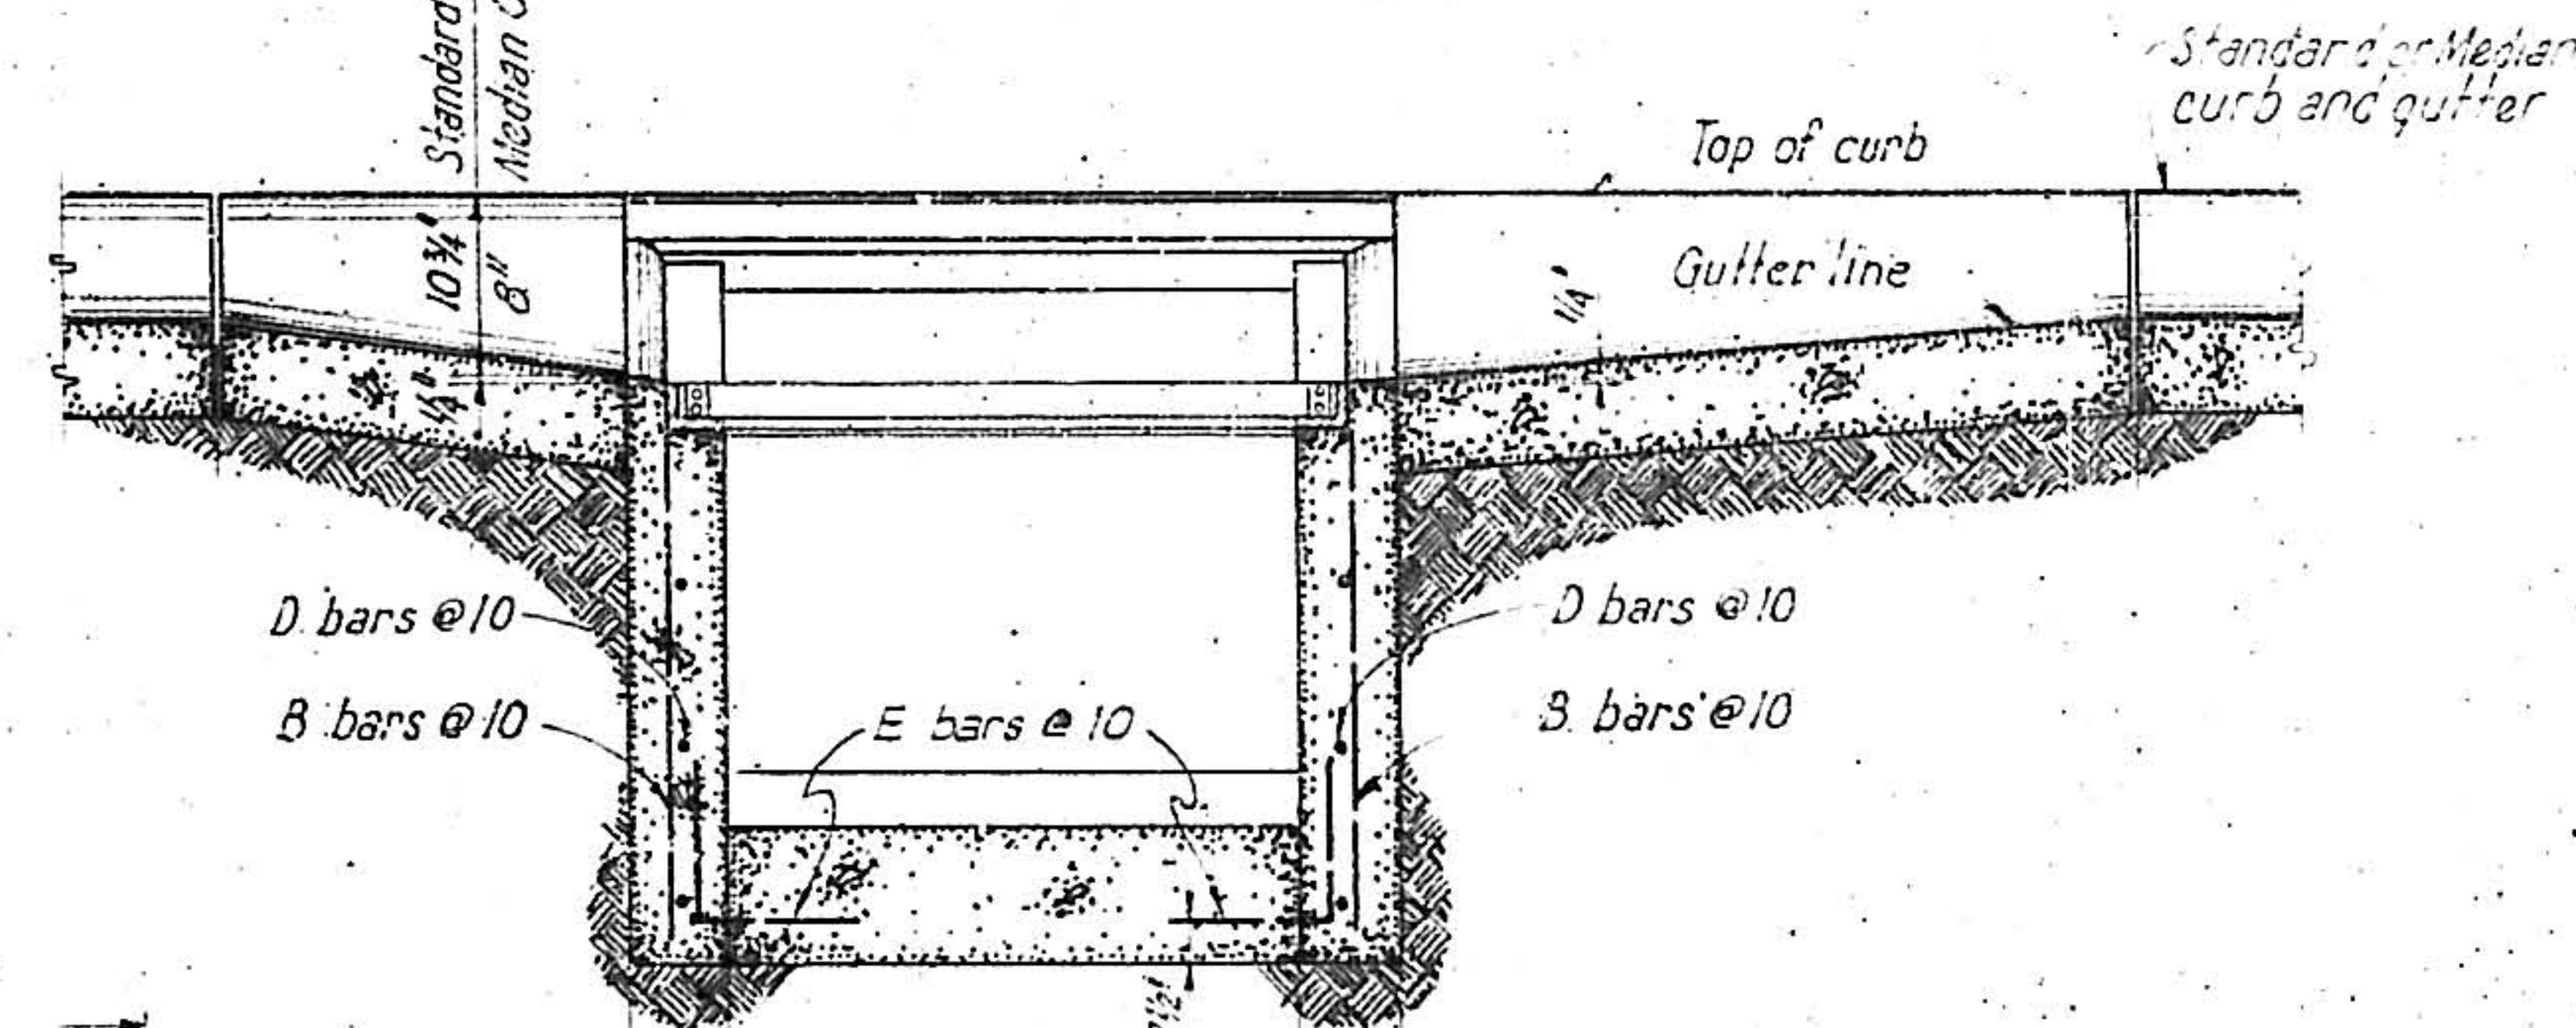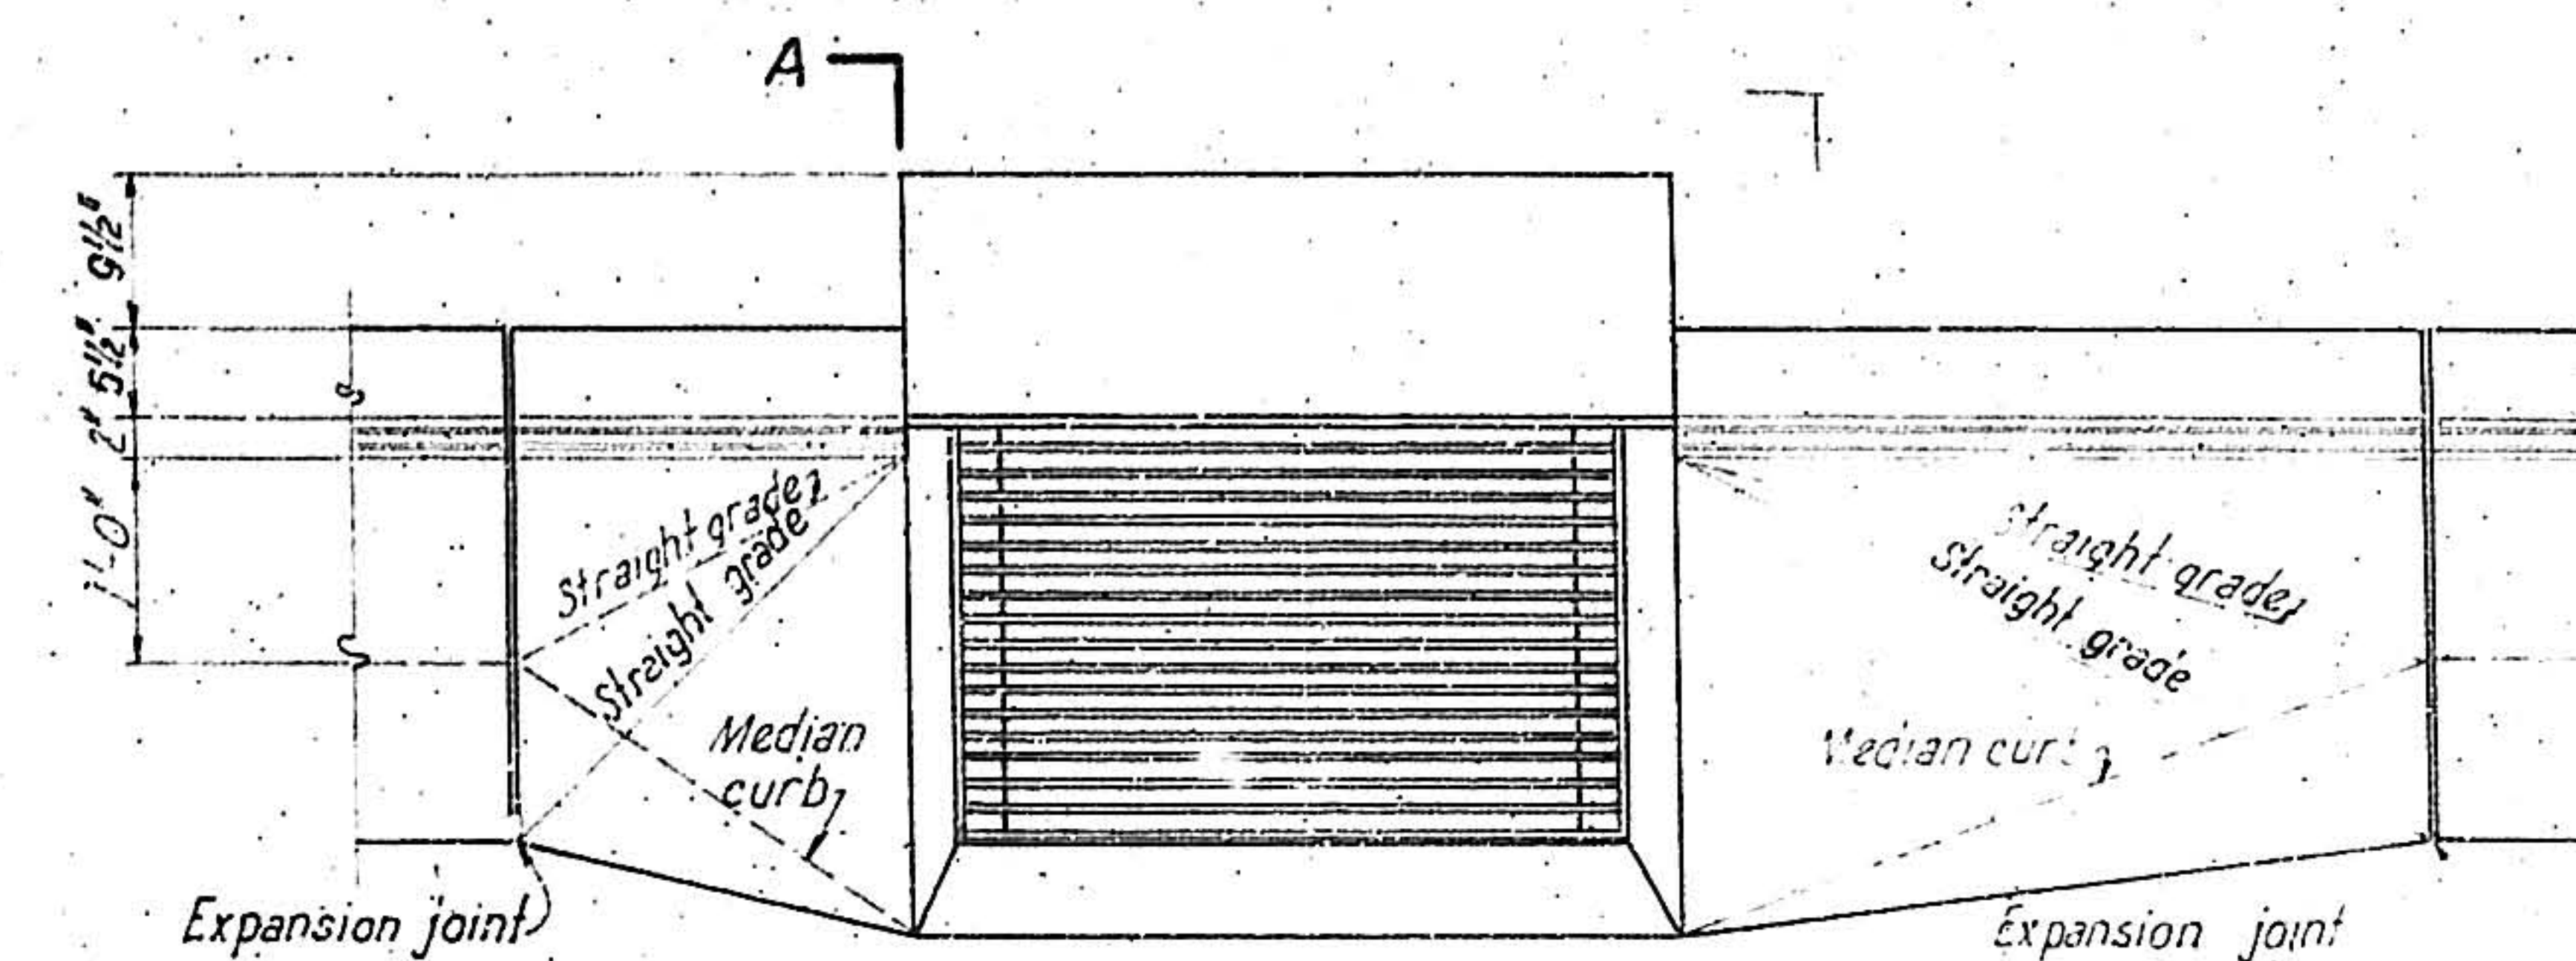

Scale: 3/4" = 1'-0"


LONGITUDINAL SECTION

Scale: 3/4" = 1'-0"

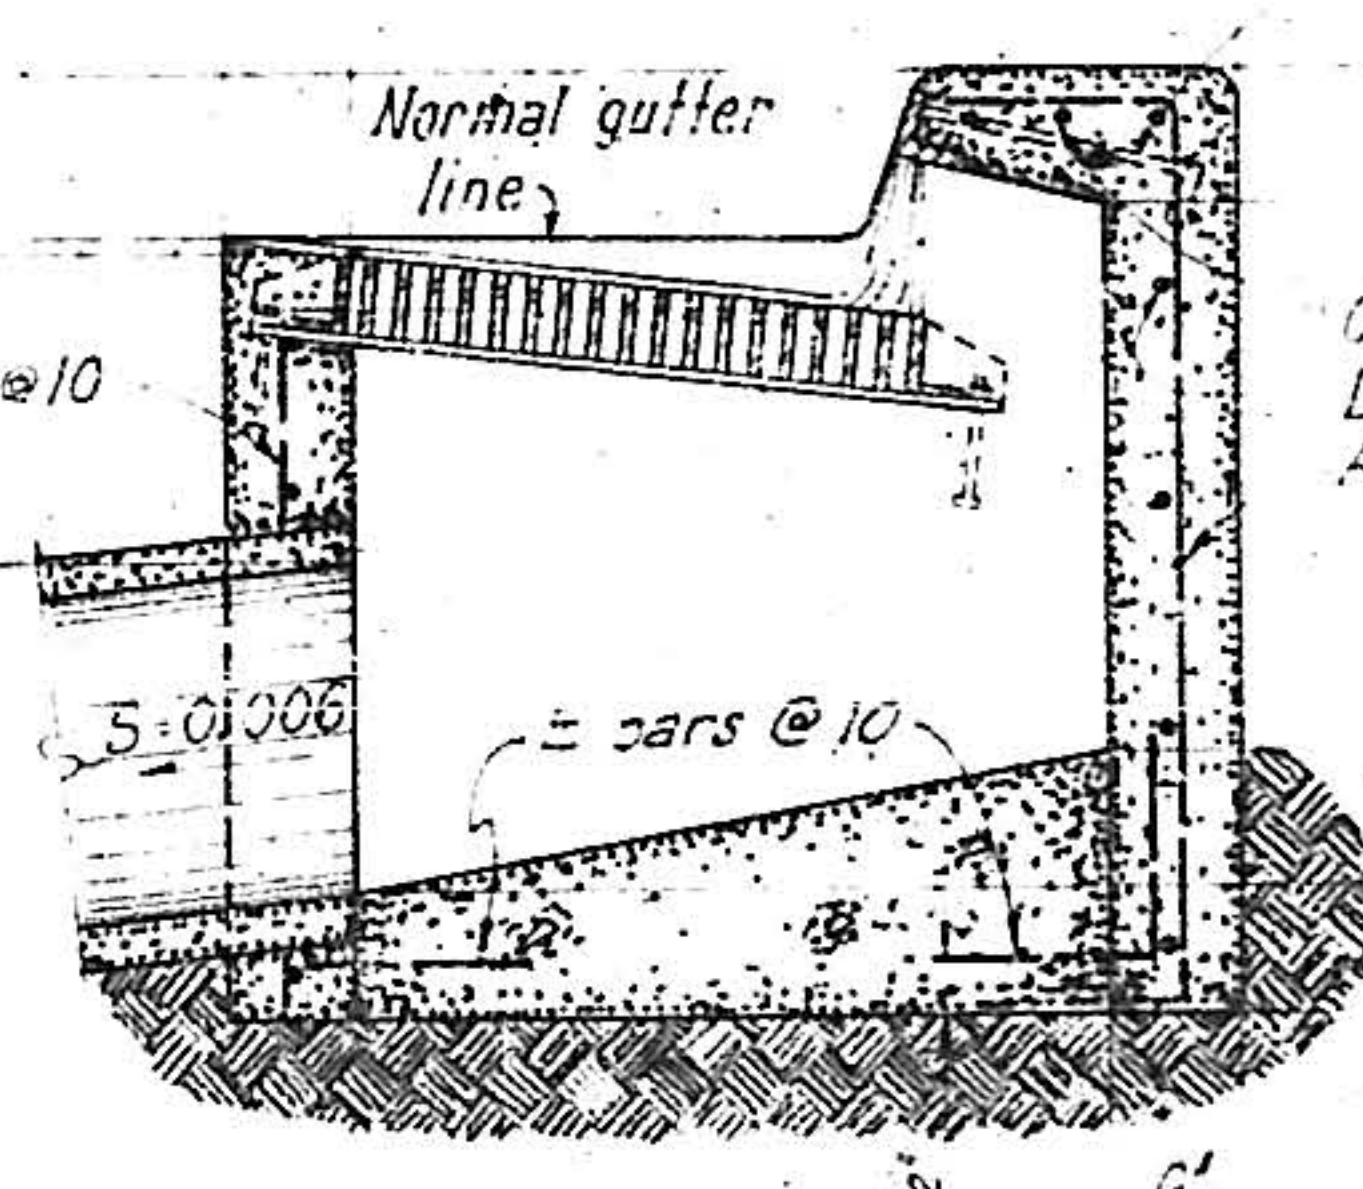

SINGLE C INLET

Scale: 3/4" = 1'-0"






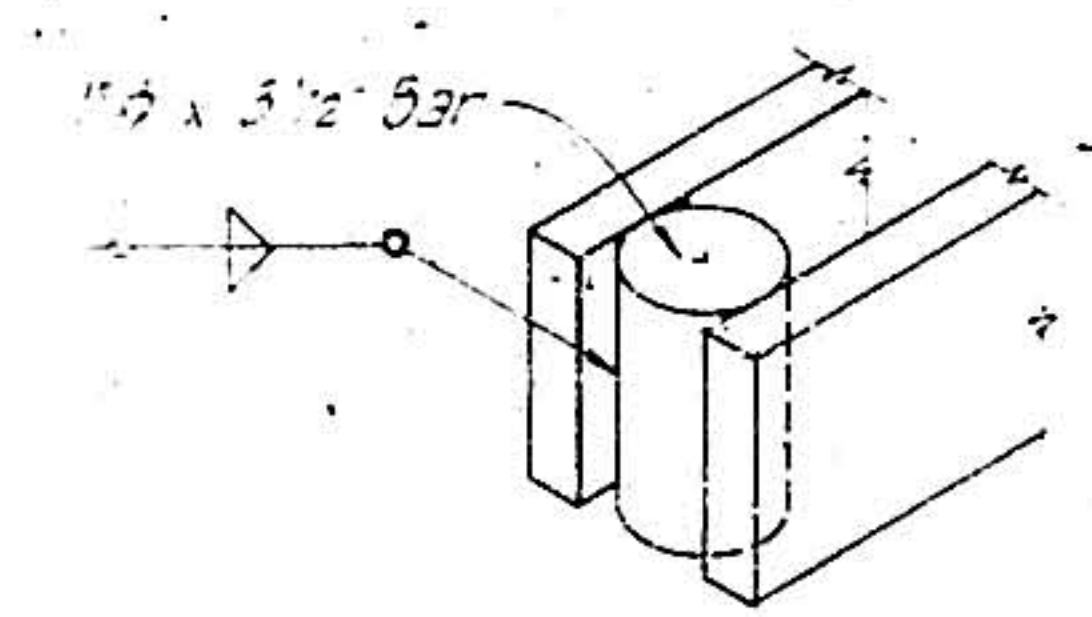


SPACER DETAIL


Not to scale

AS CONSTRUCTED

ALBUQUERQUE, NEW MEXICO			
STORM DRAIN STANDARDS			
DOUBLE C AND SINGLE C DROP INLET DETAILS			
GORDON HERKENHOFF & ASSOCIATES, INC. CONSULTING ENGINEERS			
ALBUQUERQUE	DATE	DRAWN	SHEET 5
SCALE	NOV., 1964	CHECKED: G.A.J.	OF 10

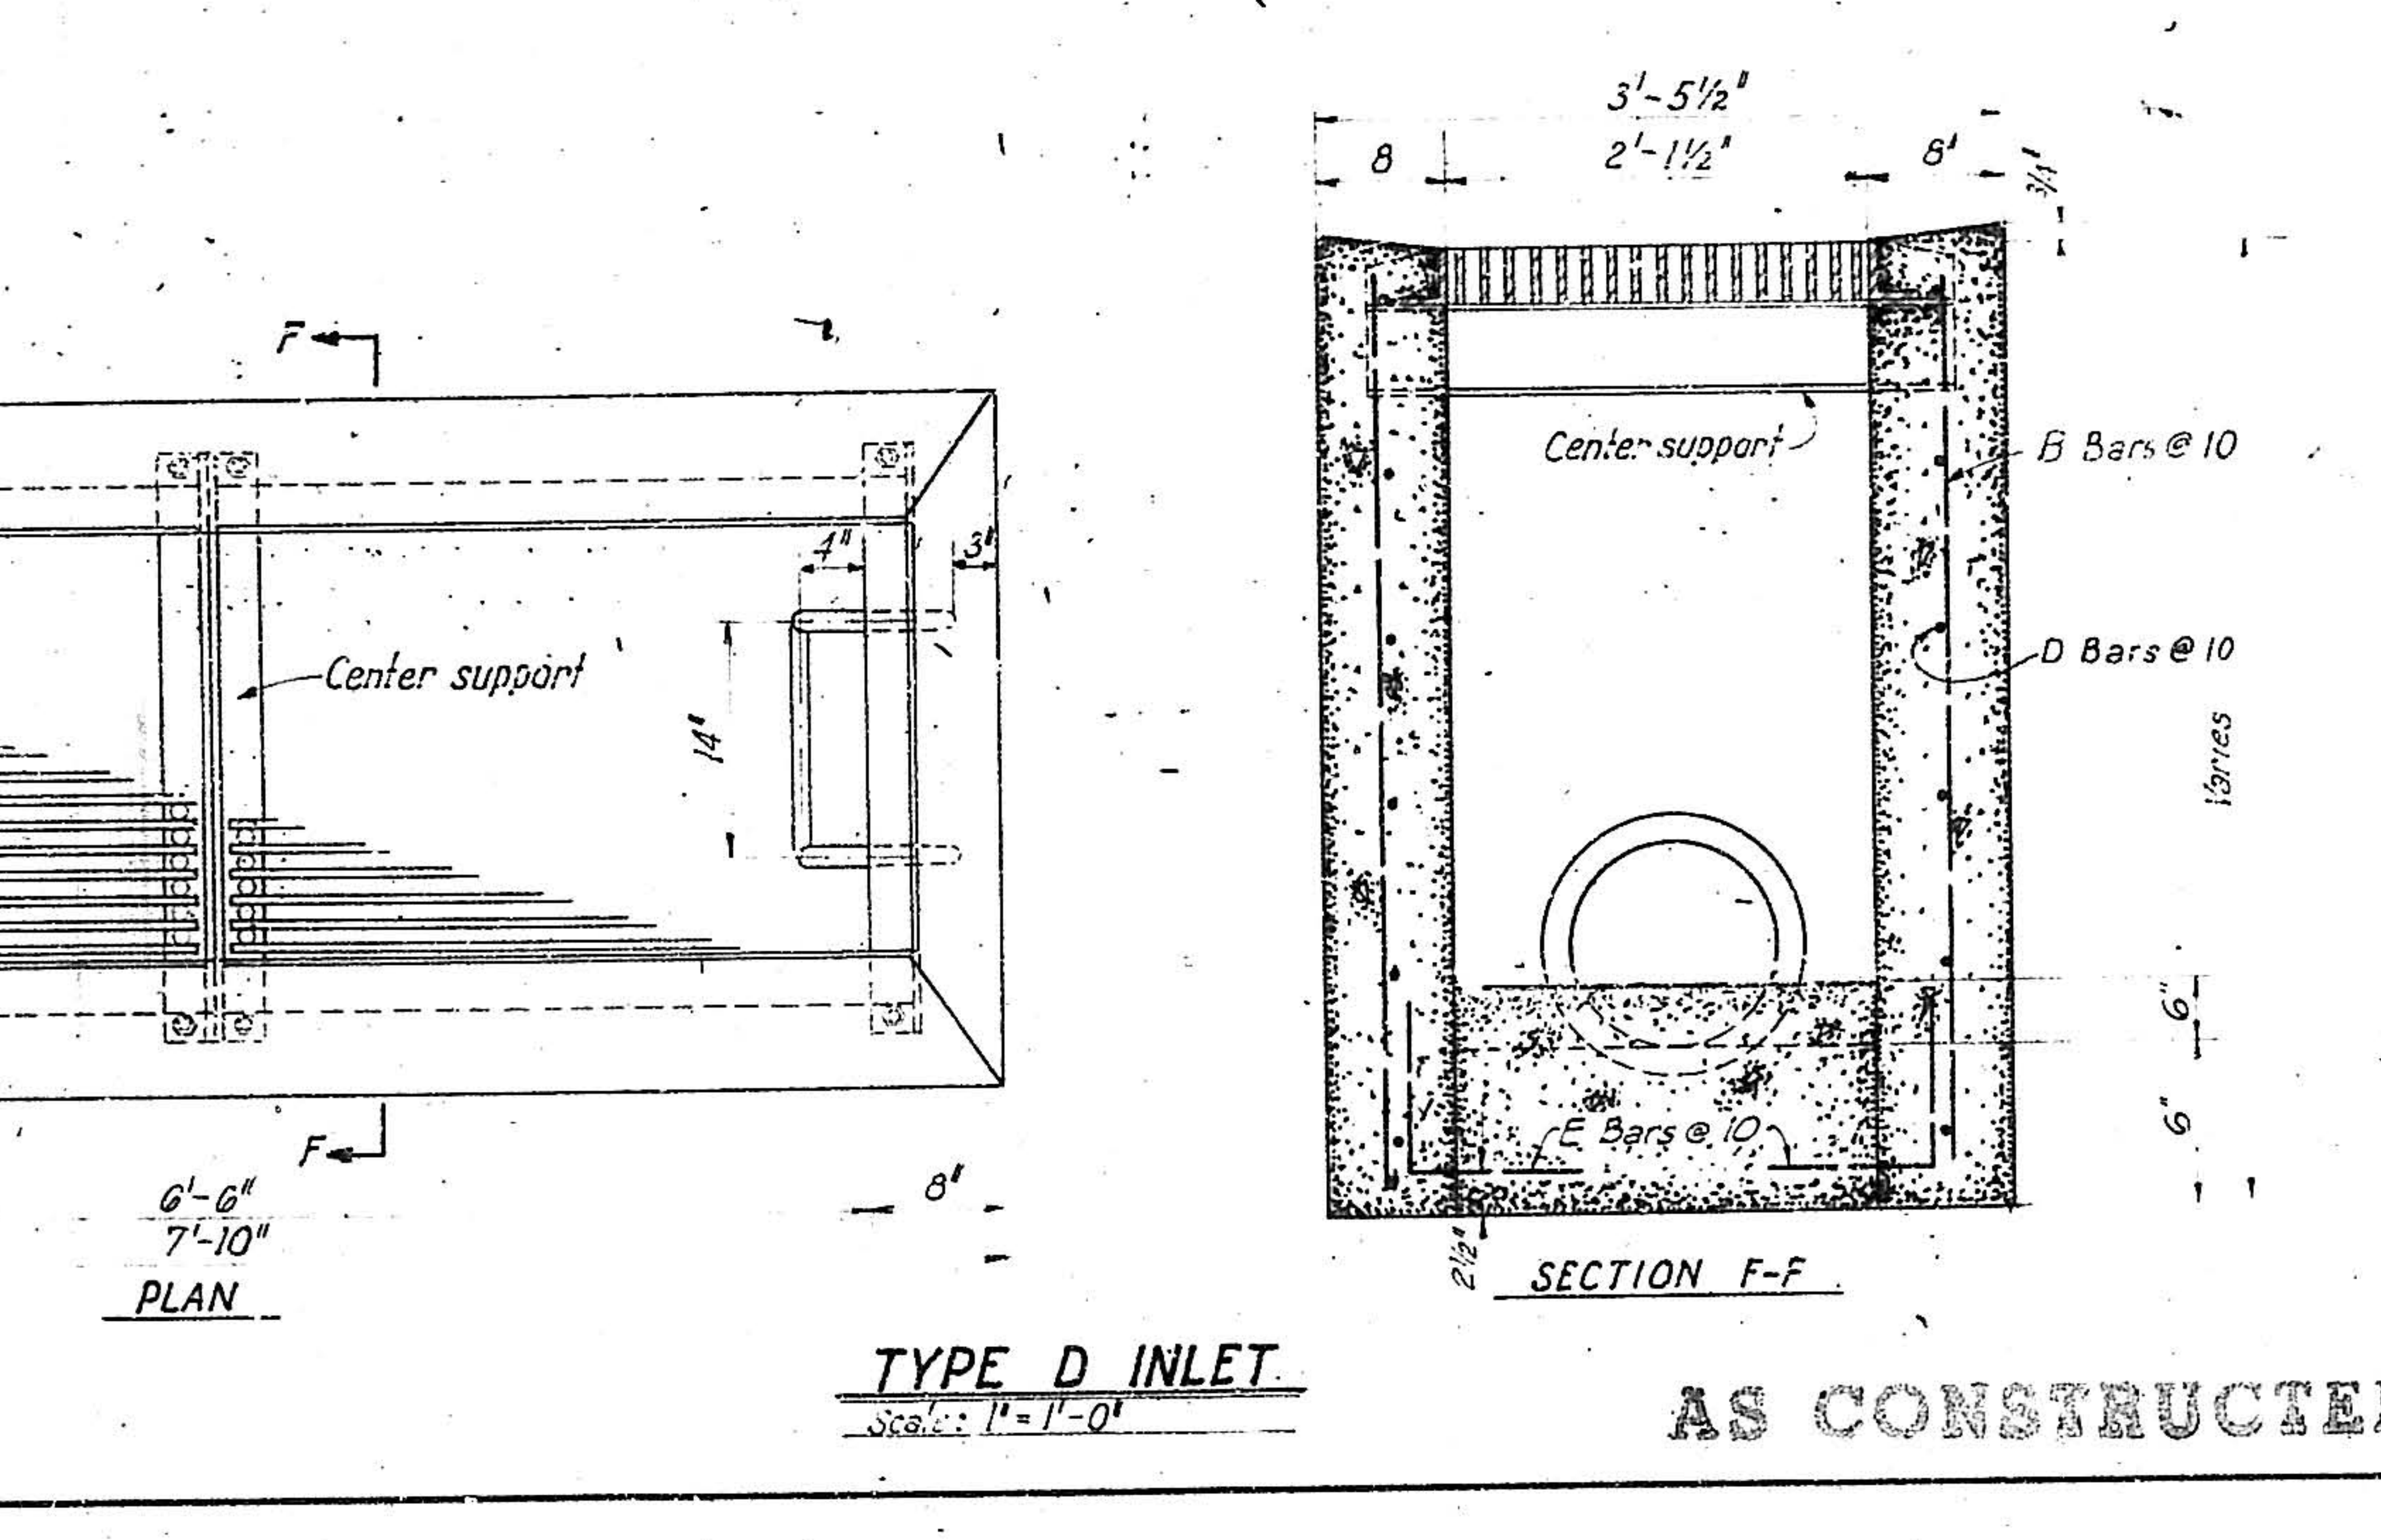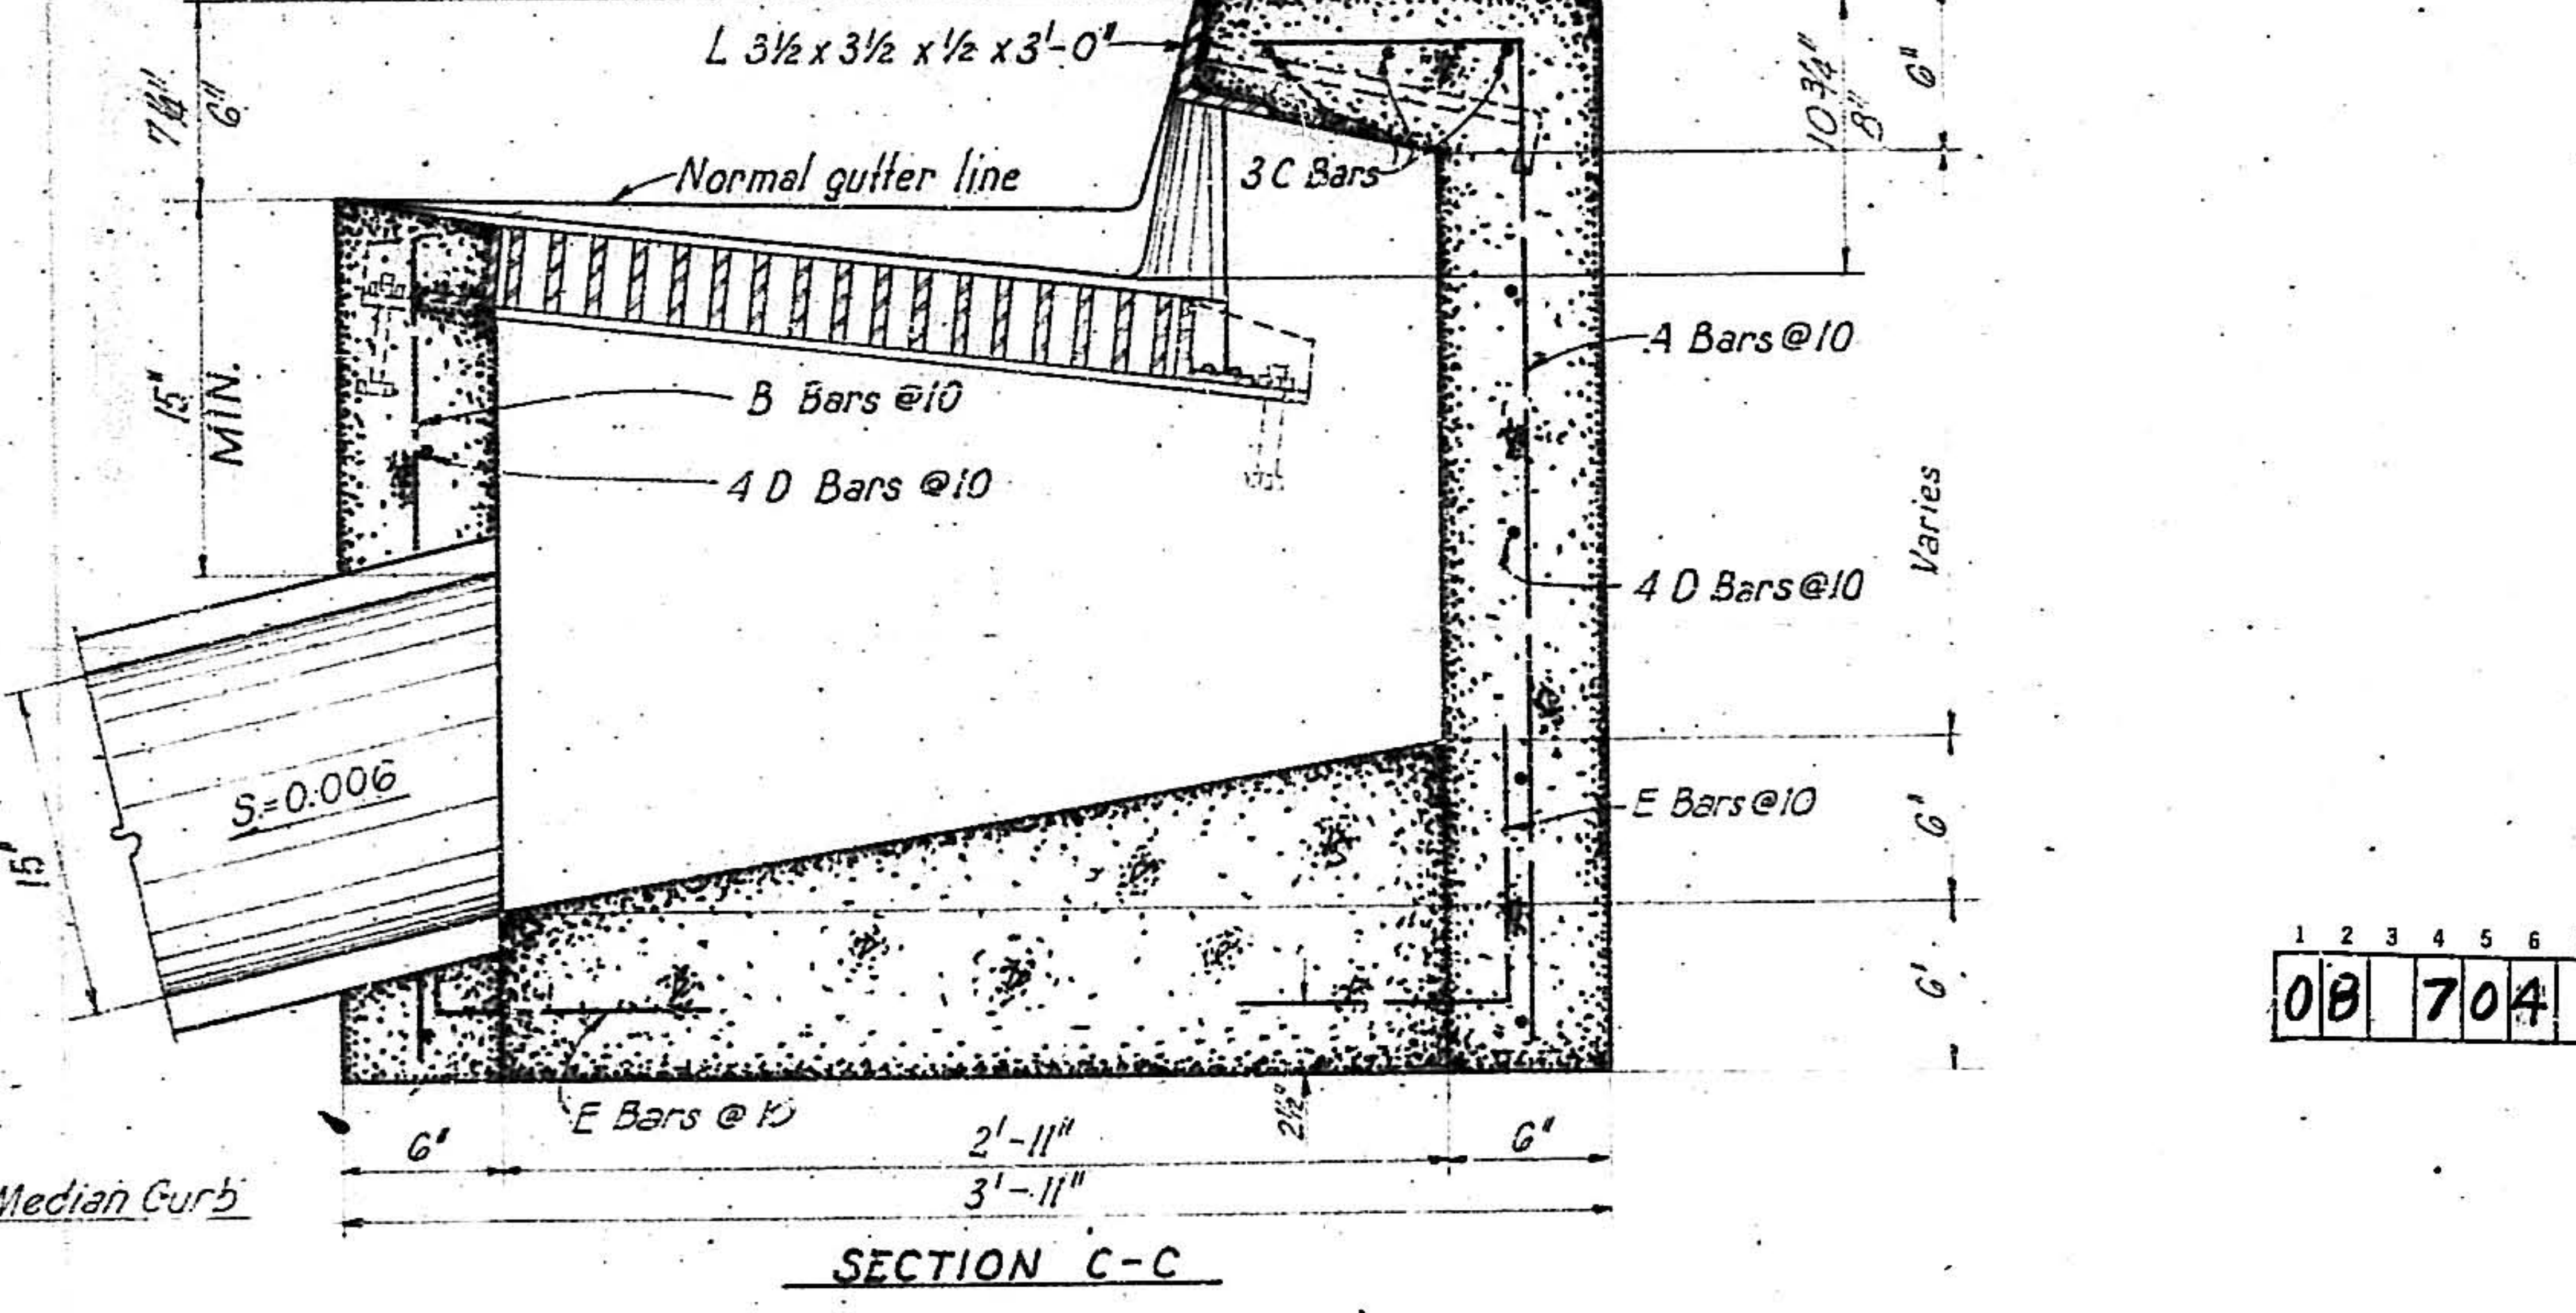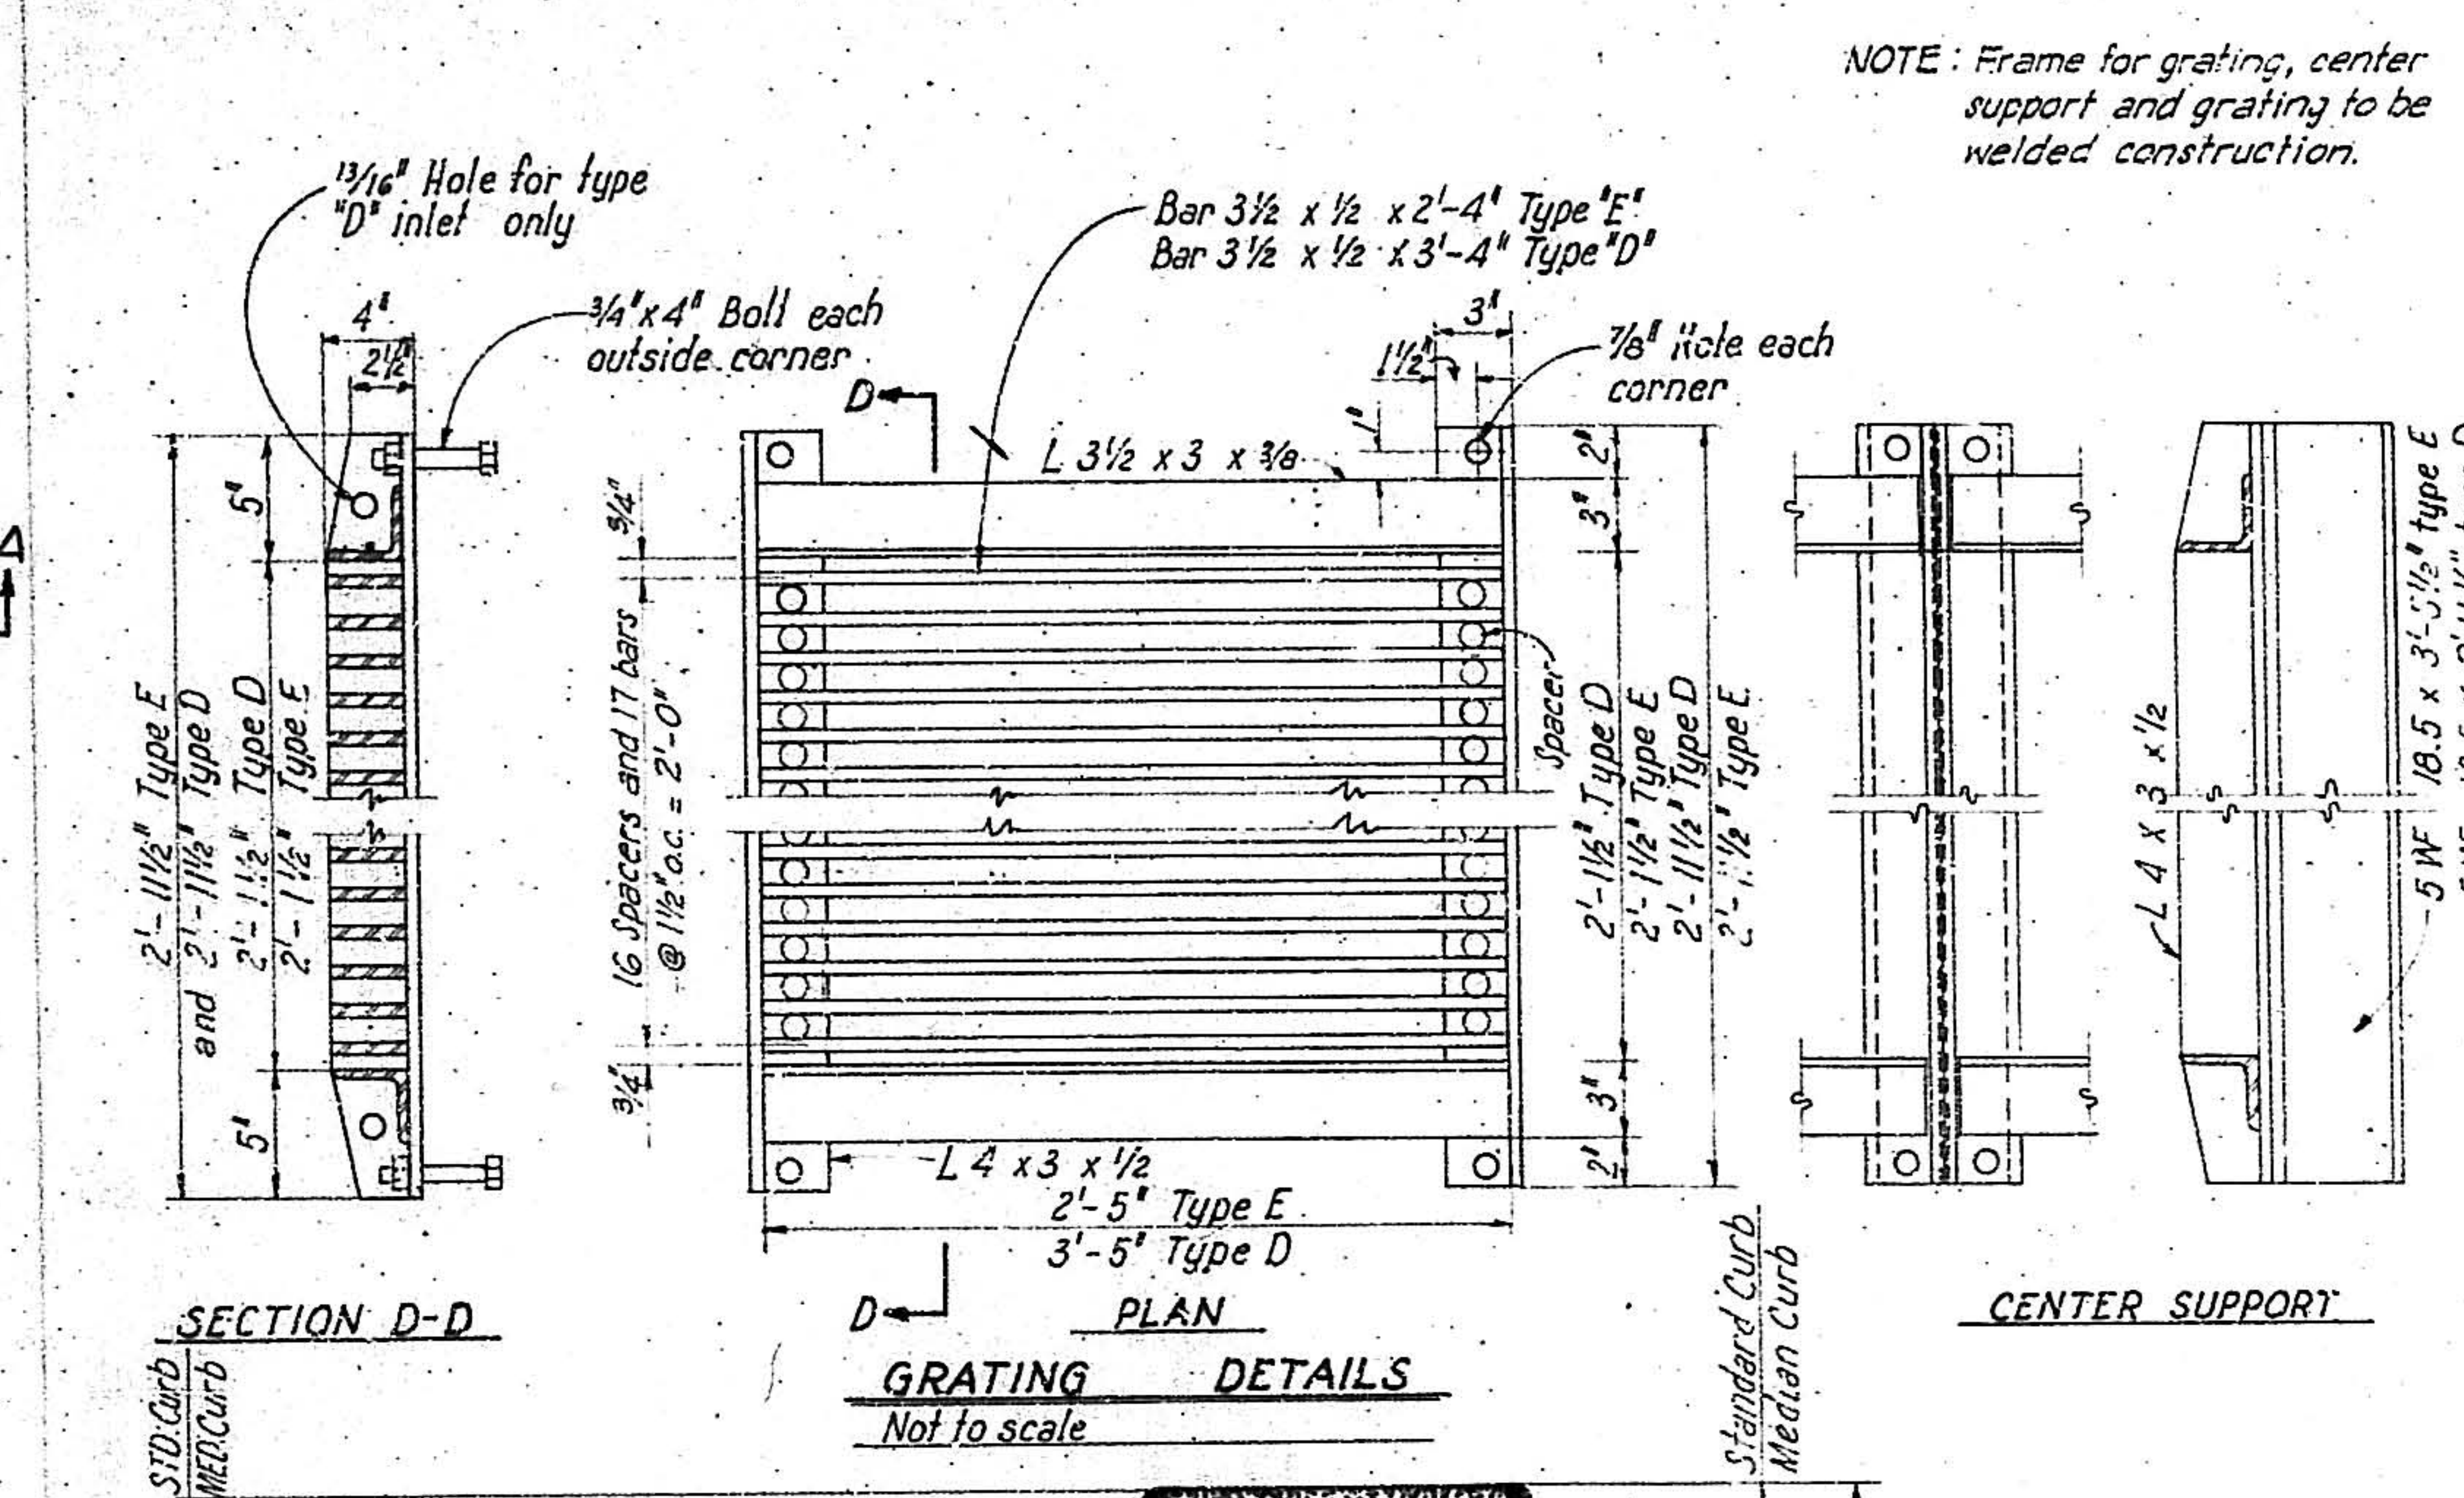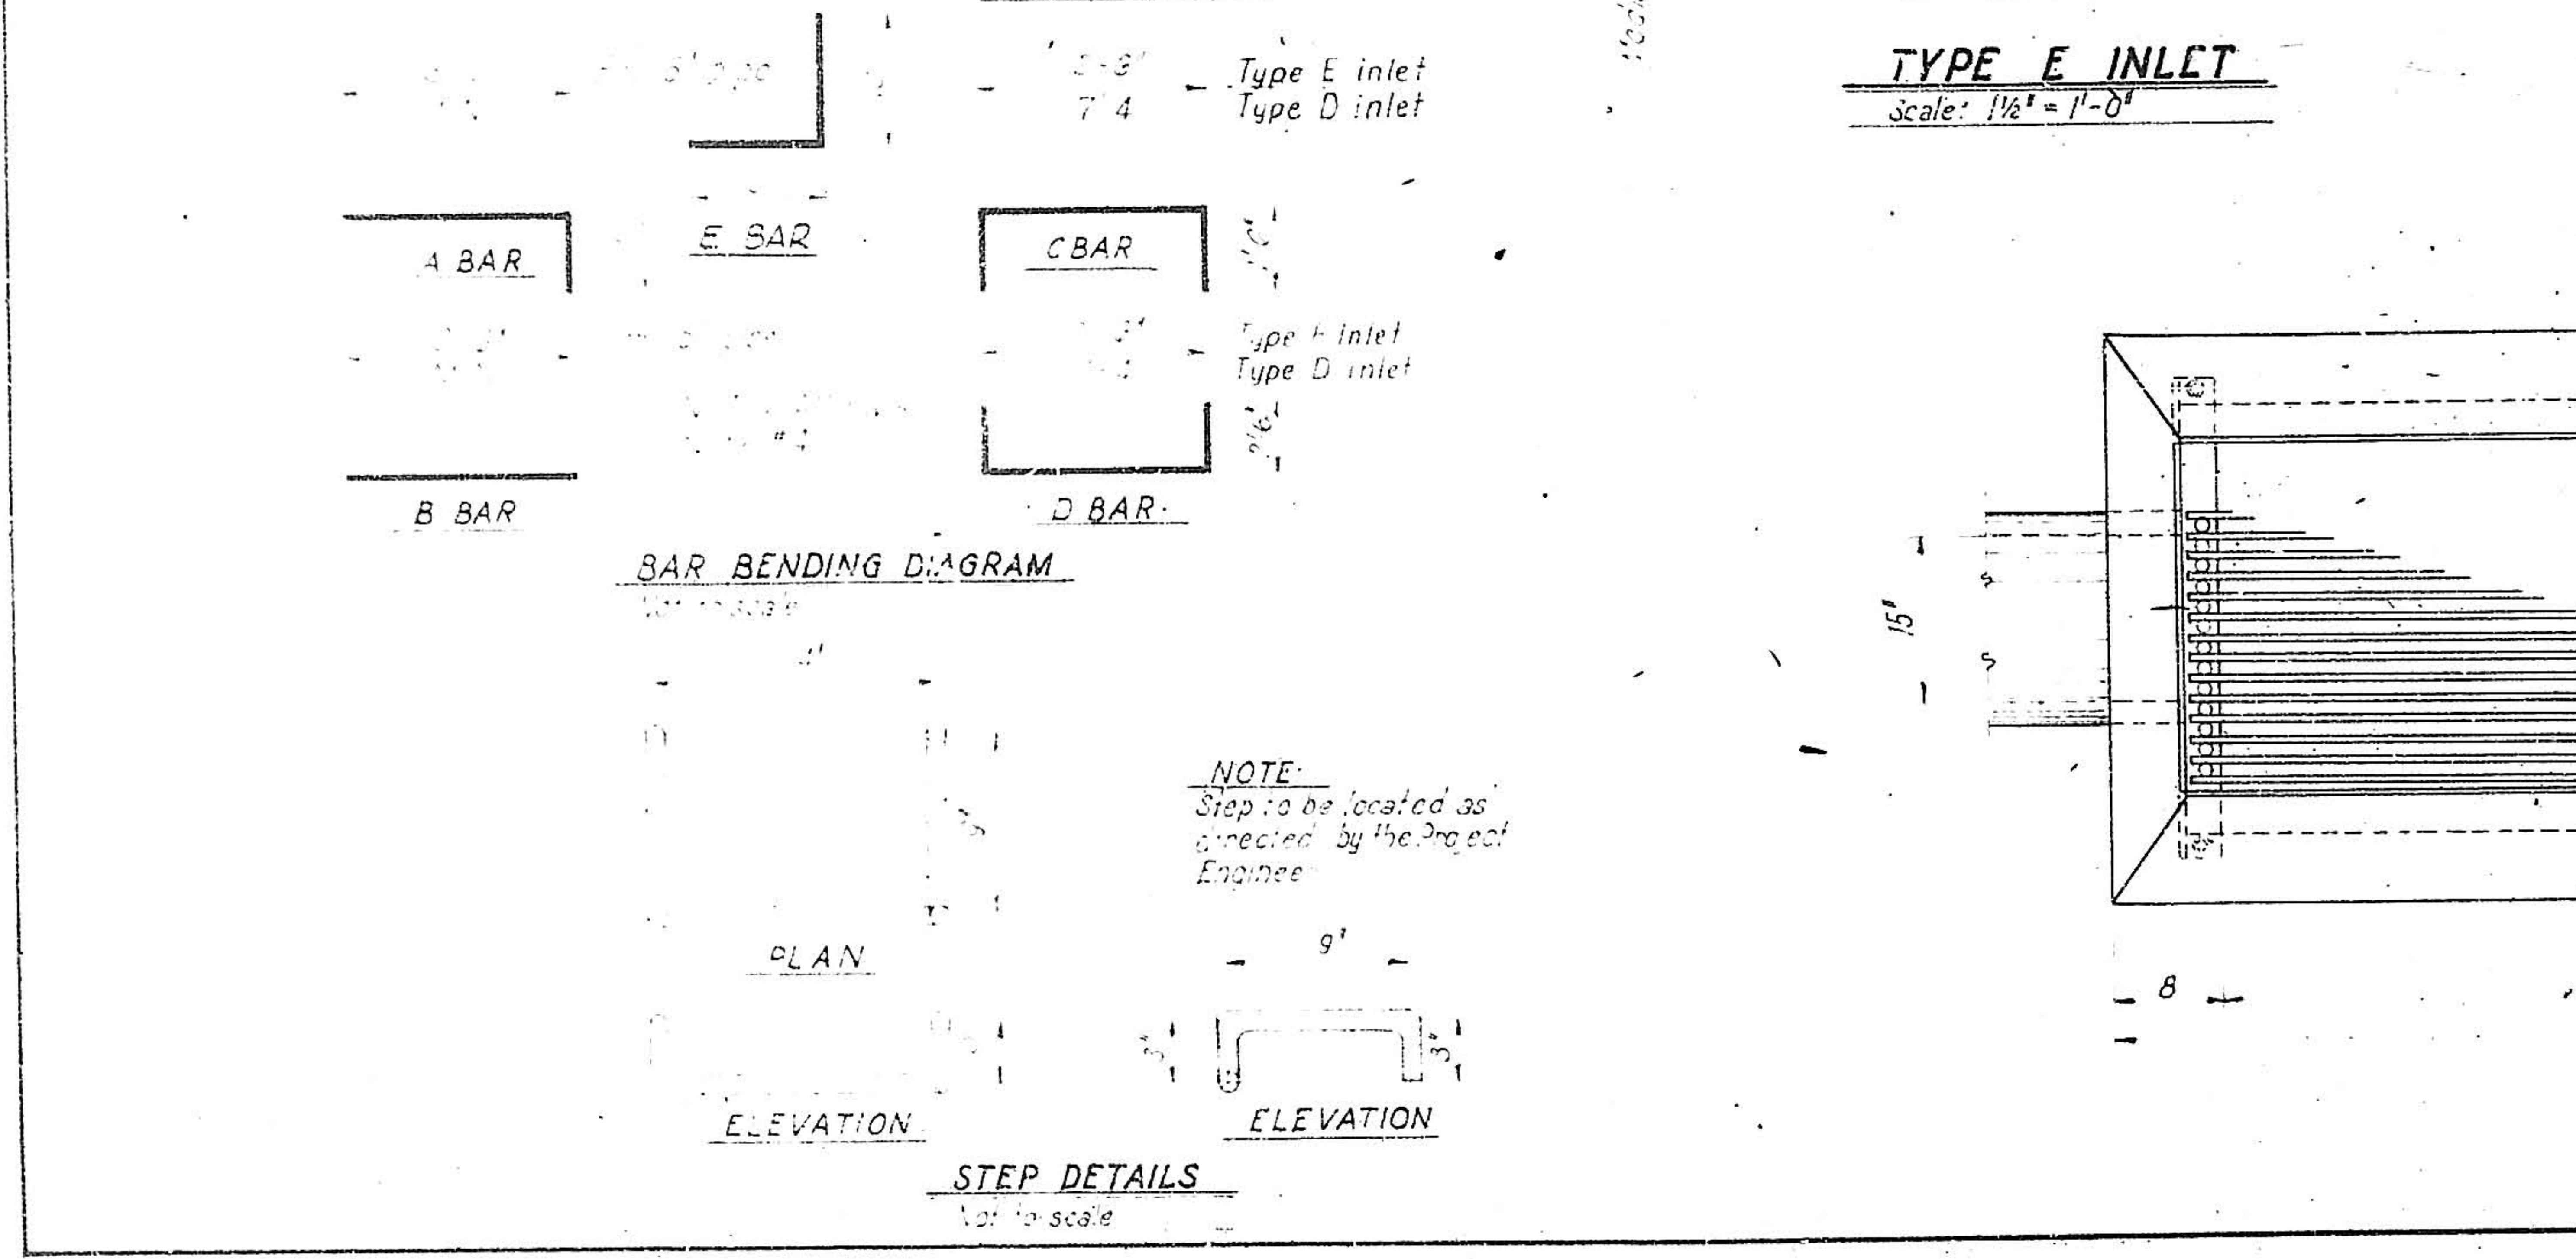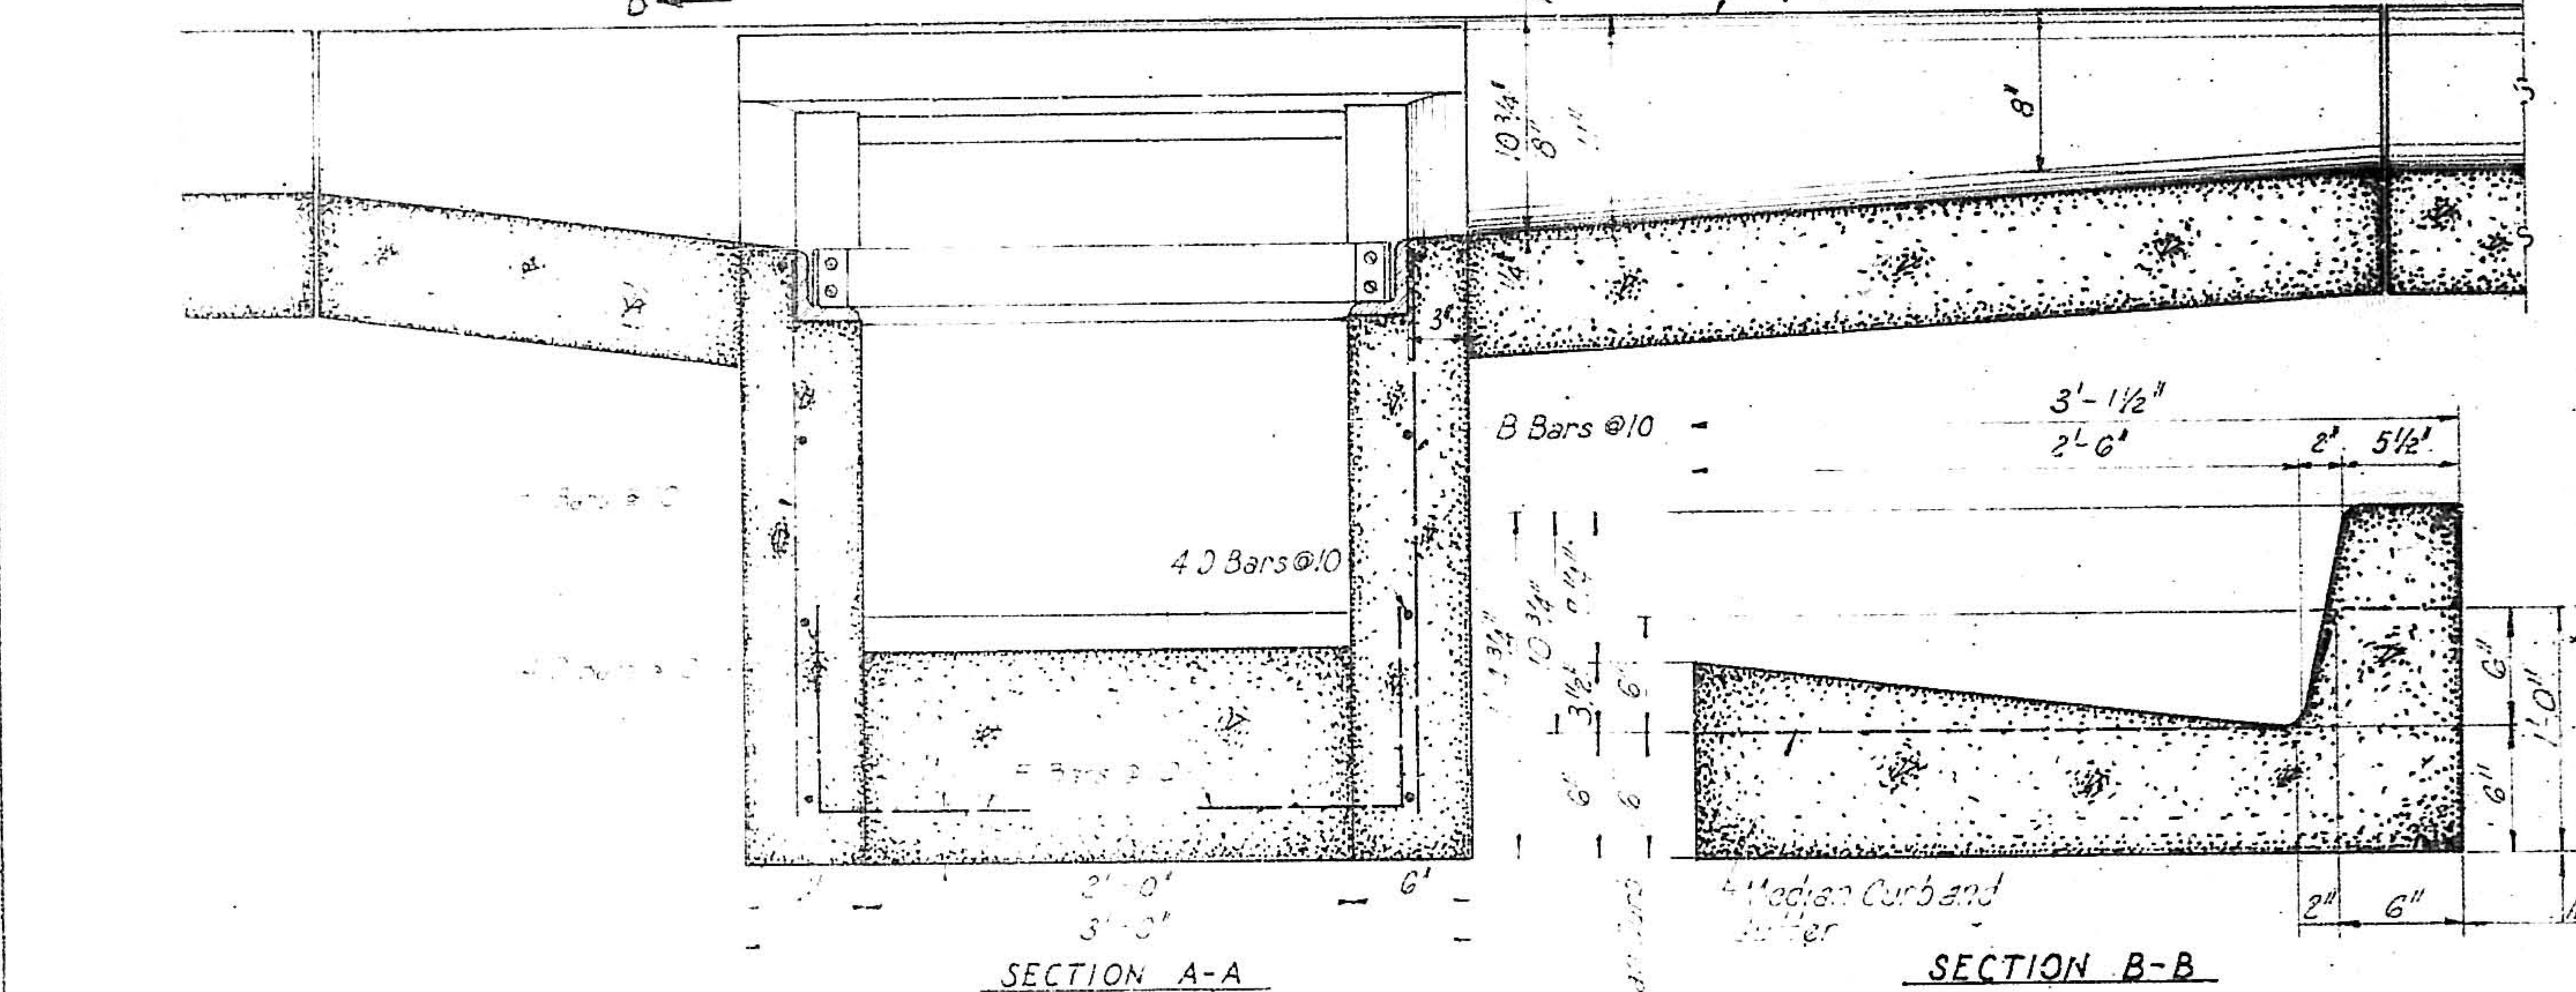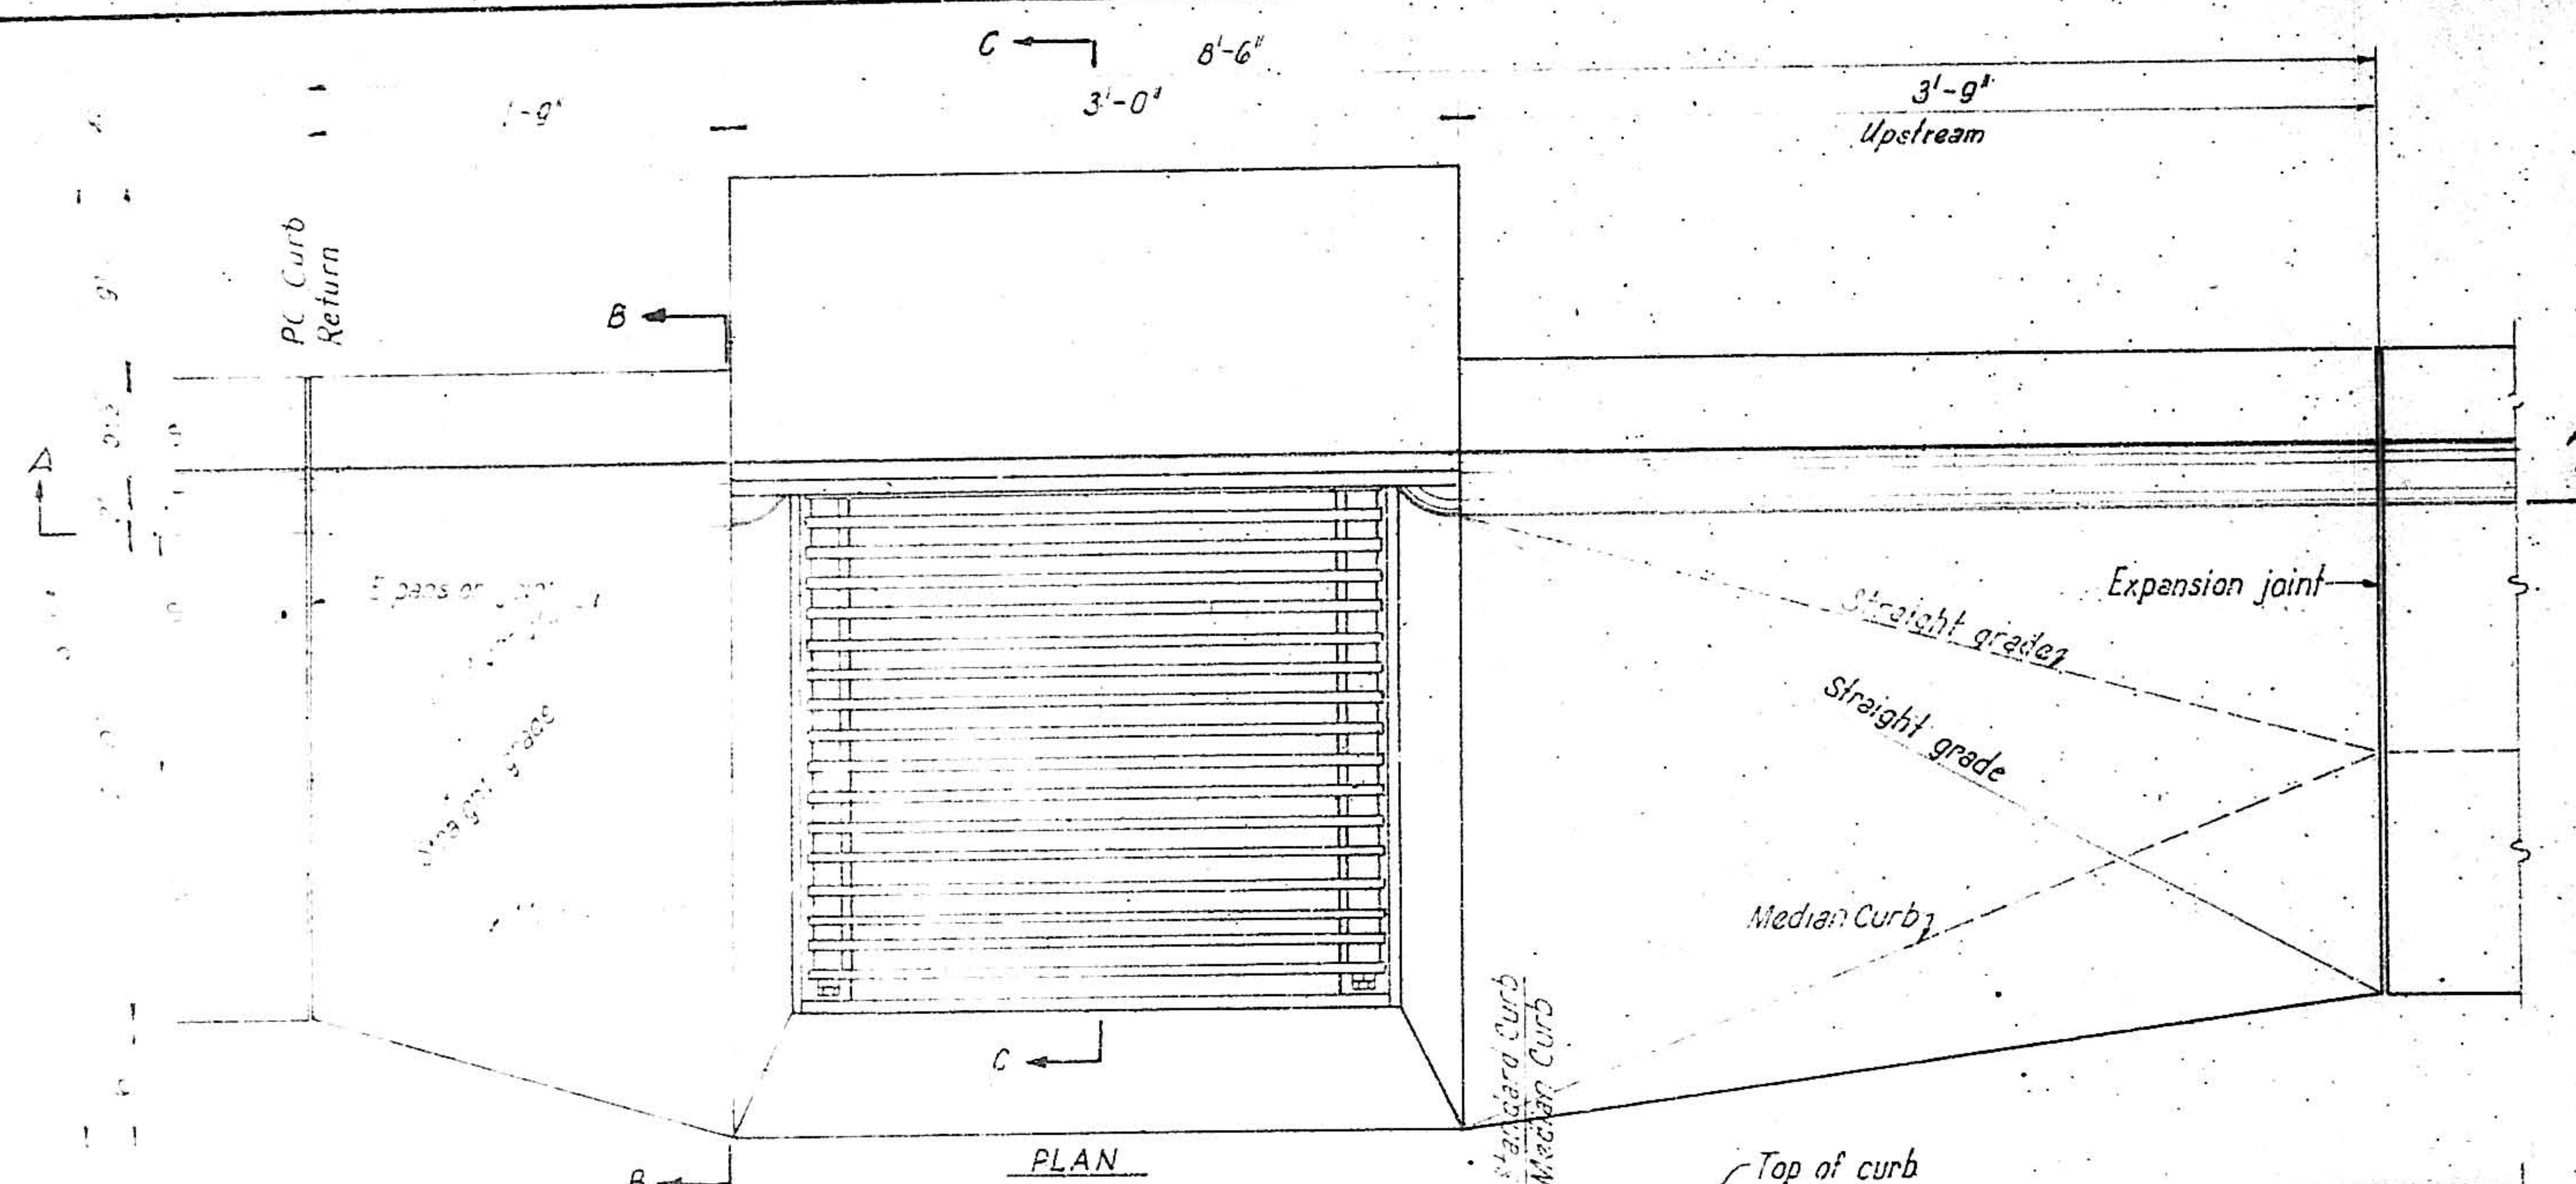

08 704 0670 10																											
ALBUQUERQUE, NEW MEXICO																											
STORM SEWER STANDARDS																											
TYPE D, AND E DROP INLET DETAILS																											
GORDON HERKENHOFF & ASSOCIATES, INC. CONSULTING ENGINEERS																											
ALBUQUERQUE NEW MEXICO																											
SCALE	DATE	DRAWN	A.G.I.	SHEET																							
AS SHOWN	NOV. 1964	CHECKED	G.A.J.	OF	10																						

 

M1432B-D
DATUM: 4933.02 + 2.67 = 4935.69

M1431A-D
DATUM: 4933.3 + 2.67 = 4935.97

M1432A-D
DATUM: 4933.02 + 2.67 = 4936.34

M14233-D
DATUM: 4933.52 + 2.67 = 4936.19

M14224-M14223-D
4936.67 + (0.003 * 180.3) = 4937.21
(M14224)
SLOPE FROM COA UTILITY MAP.

M14321-D
DATUM: 4933.70 + 2.67 = 4936.37

M14223-D
DATUM: 4934.00 + 2.67 = 4936.67

M14222-D
DATUM: 4934.10 + 2.67 = 4936.77

M14221-D
DATUM: 4934.30 + 2.67 = 4936.97

M14121-M14122-D
AS-BUILT DIA: 36"

M14022-M14121-D
AS-BUILT DIA: 36"

M14021-M14022-D
AS-BUILT DIA: 36"

L14931-L14933-D
AS-BUILT DIA: 36"

L14836-L14931-D
AS-BUILT DIA: 36"

L14836-L14931-D
AS-BUILT DIA: 36"

L14933-M14021-D
AS-BUILT DIA: 36"

M14022-D
DATUM: 4935.20 + 2.67 = 4937.87

M14122-D
DATUM: 4934.60 + 2.67 = 4937.27

M14121-D
DATUM: 4934.90 + 2.67 = 4937.57

M14021-D
DATUM: 4935.30 + 2.67 = 4937.97


L14933-D
DATUM: 4935.43 + 2.67 = 4938.10

L14931-D
DATUM: 4935.65 + 2.67 = 4938.32

L14836-D
DATUM: 4935.94 + 2.67 = 4938.61

L14834-D
DATUM: 4935.95 + 2.67 = 4938.62

SAN JOSE STORM SEWER

 

L14932-L14931
MODEL DIA: 24"
AS-BUILT DIA: 24"


L14835-L14834-D
AS-BUILT DIA: 24"

L14832-L14831-D
AS-BUILT DIA: 24"


L14932-D
DATUM: 4937.00 + 2.67 = 4939.67

L14835-D
DATUM: 4937.00 + 2.67 = 4939.67

L14832-D
DATUM: 4937.40 + 2.67 = 4940.07

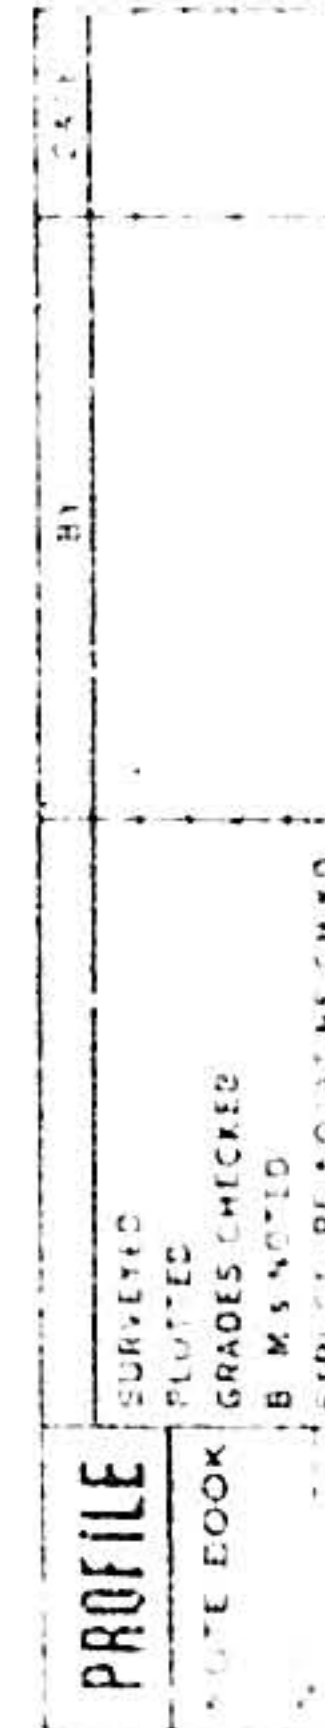

SCALES:
HORIZ: 1"=50'
VERT: 1"=5'

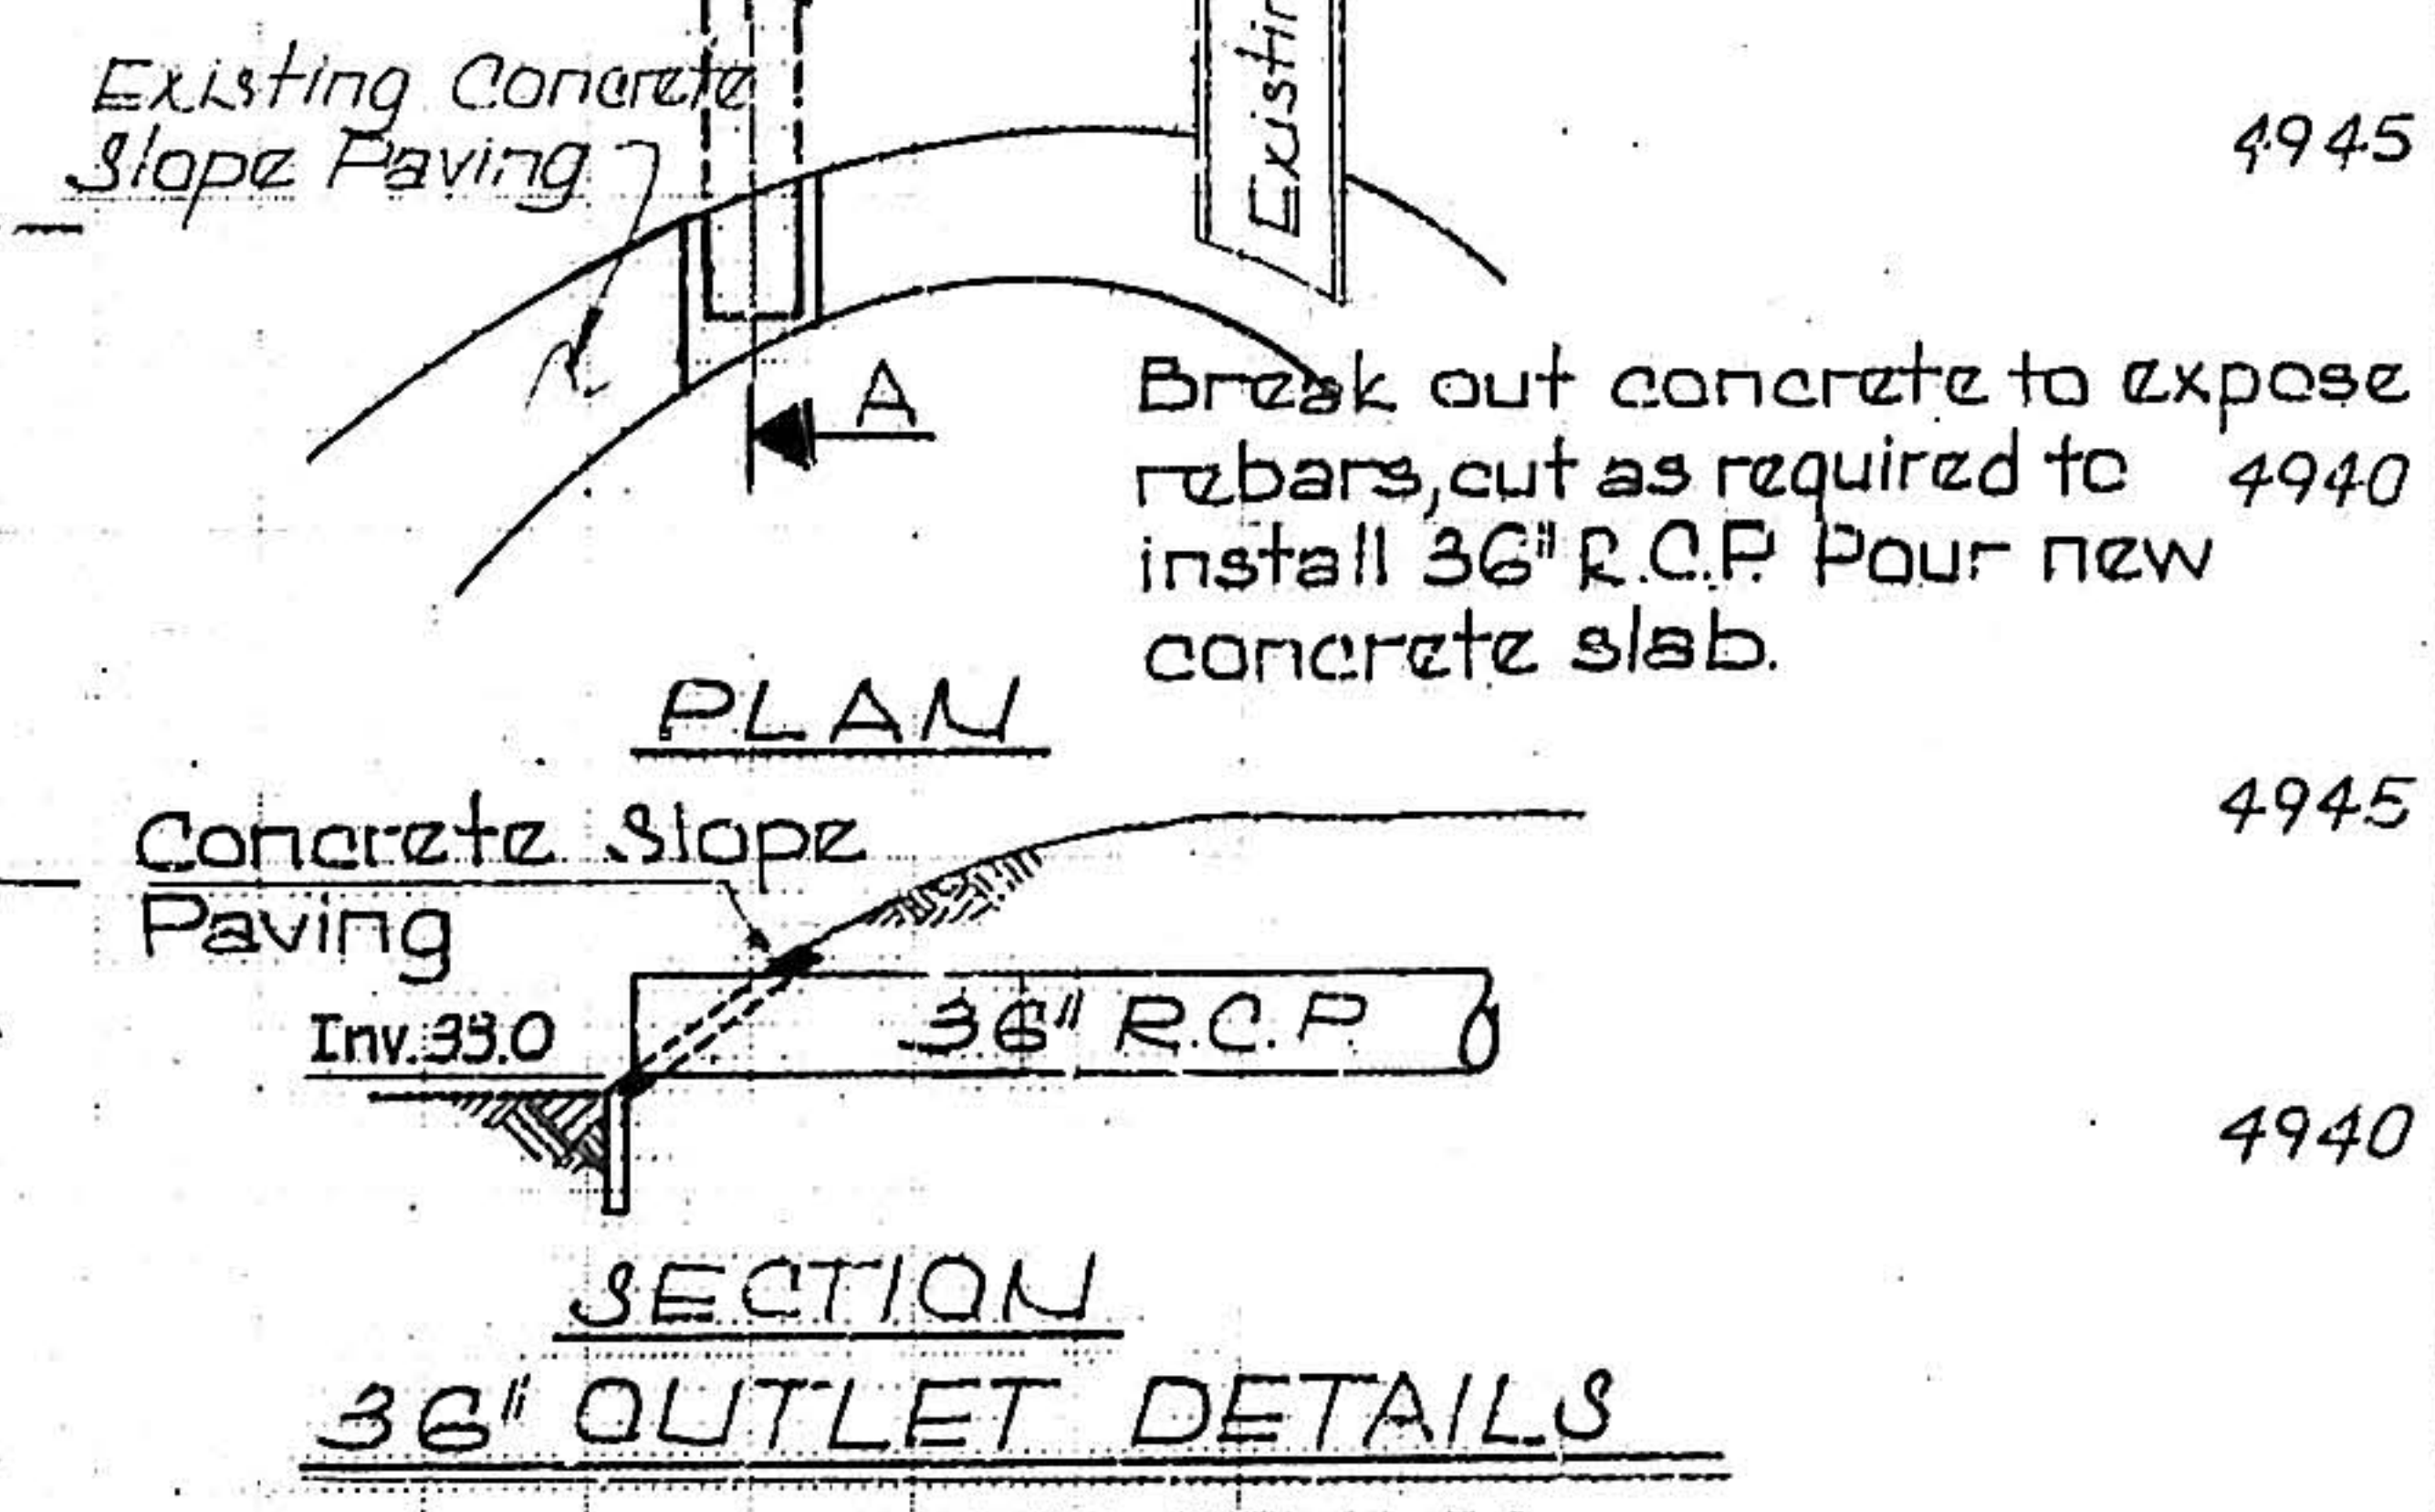

L14632-L14631-D
AS-BUILT DIA: 20"




L14534-L14533-D
AS-BUILT DIA: 24"

L14543-L14532-D
AS-BUILT DIA: 24"

L14632-D
DATUM: 4938.50 + 2.67 = 4941.17


L14534-D
DATUM: 4938.50 + 2.67 = 4941.17

L14543-D
DATUM: 4939.00 + 2.67 = 4941.67

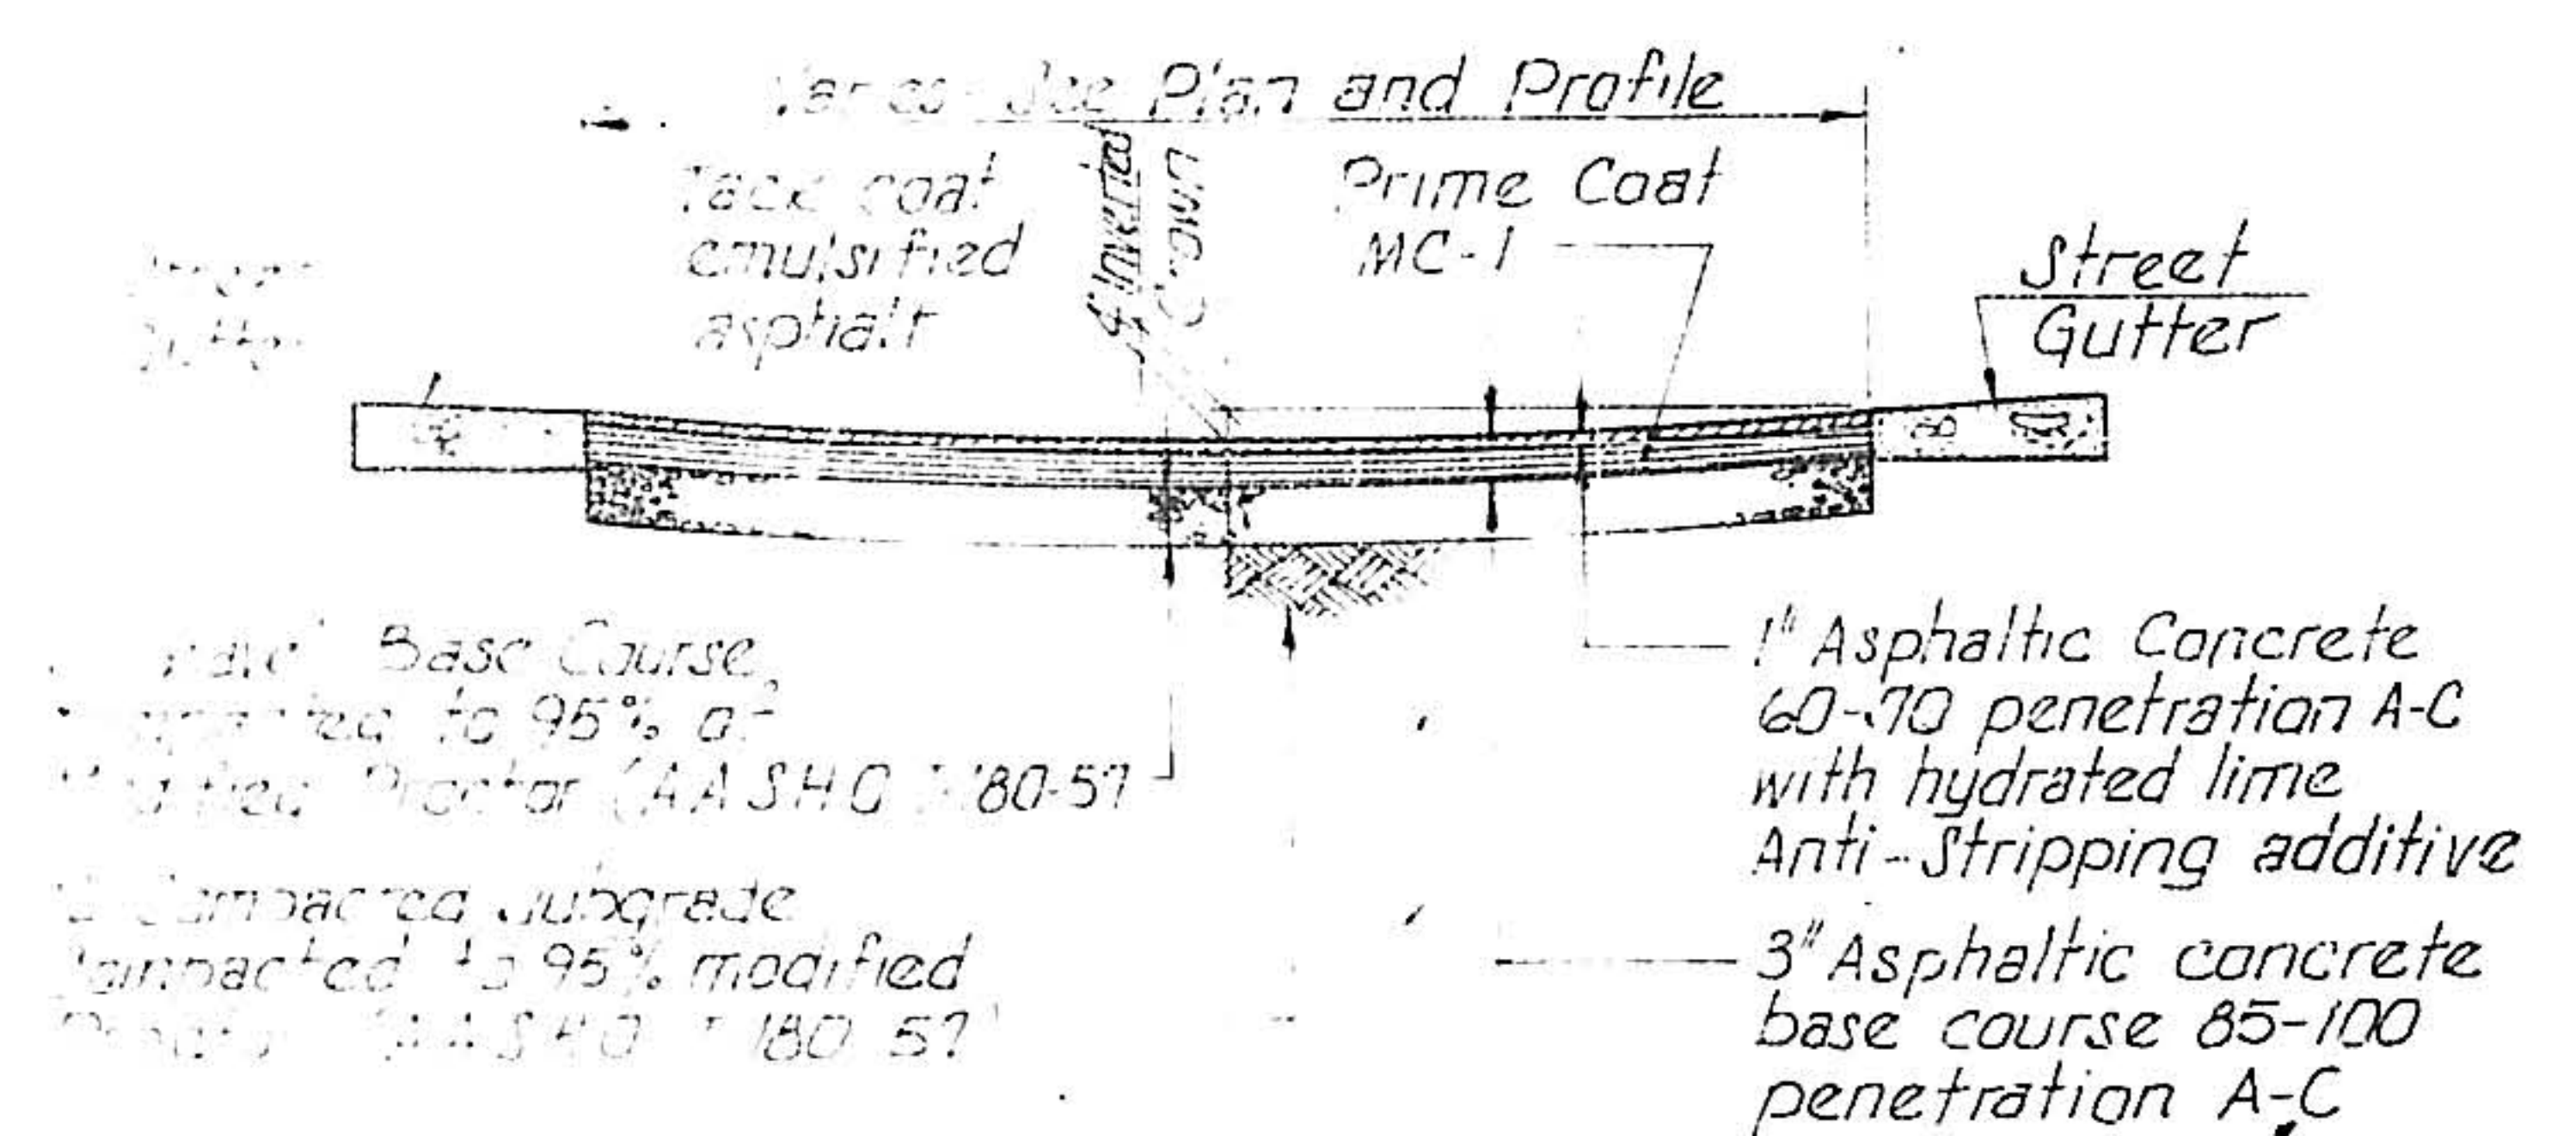  


INVERTED CROWN STREET DETAILS
(Ogle St. only)

1	2	3	4	5	6	7	8	9	10	11	12	13	14	15	16	17	18	19	20	21	22	23	24	25	26	27	28
08	7	0	4	1	0	7	0			0	1			0	1												
10																											

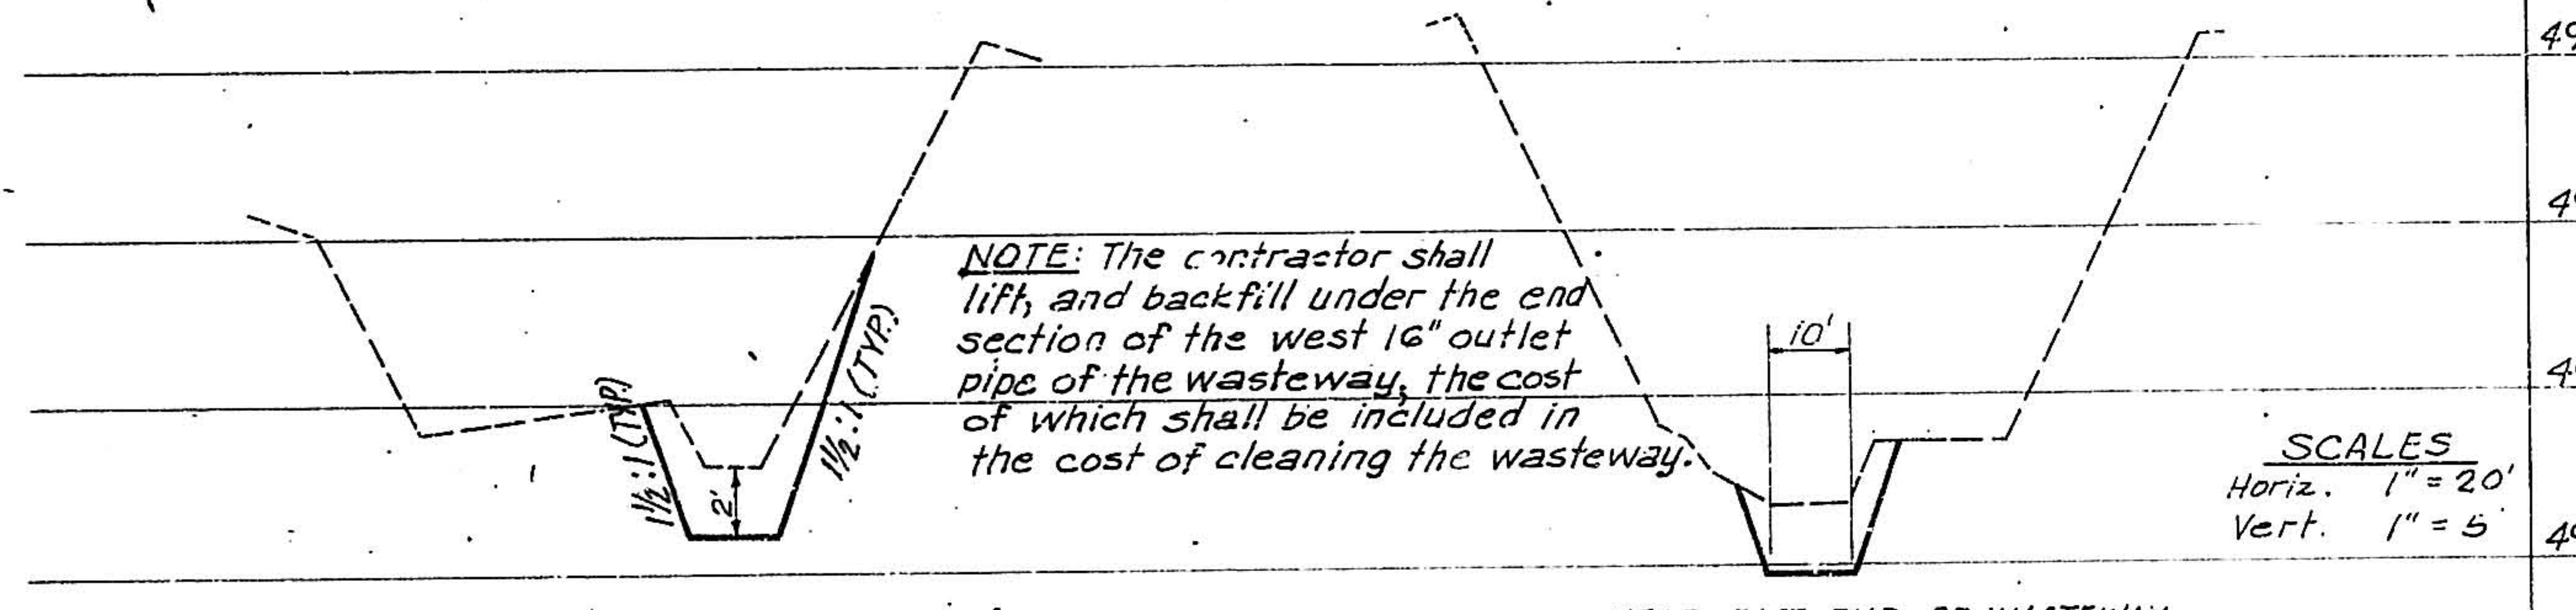

TYPICAL SECTIONS FOR CLEANING SAN JOSE WASTEWAY

 

TYPICAL SECTIONS FOR CLEANING SAN JOSE DRAIN