NO.	DATE	REMARKS	BY
1	6-22-88	AS NOTED	SC
2	6-30-88	AS NOTED	SC

REVISIONS

NOTE:
Utility line to be relocated by P.N.M. and poles removed. Contact Mr. Gene Bustamonte at 848-2741.

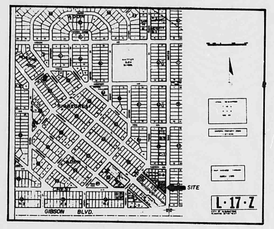

LOCATION MAP

SOILS MAP

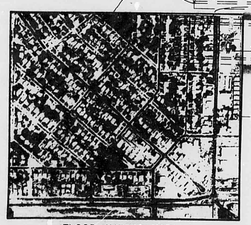

FLOOD HAZARD MAP

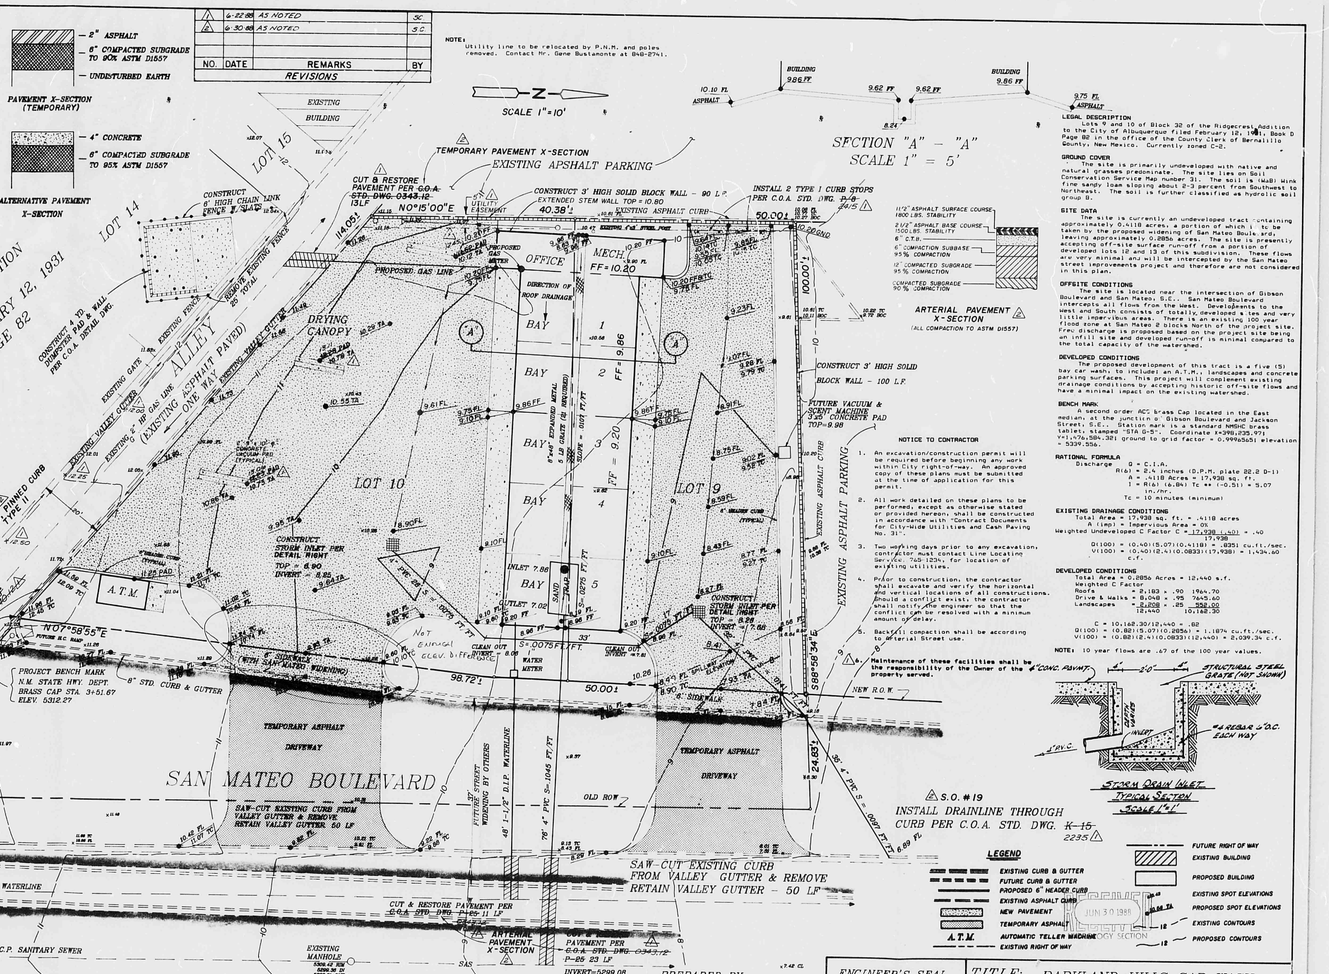

GRADING & DRAINAGE PLAN

PARKLAND HILLS CAR WASH

PREPARED BY:

Tierra West Development Management Services

4127 Carlisle Blvd. N.E.
Albuquerque, New Mexico 87107
(505)883-7592

ENGINEER'S SEAL

5-9-88

TITLE: PARKLAND HILLS CAR WASH GRADING & DRAINAGE PLAN

APPROVALS	ENGINEER	DATE	APPROVALS	ENGINEER	DATE
~~CITY ENGR.~~			FIELD INSP.		
~~A.C.E. DESIGN~~			~~A.C.E. FIELD~~		
HYD. DESIGN			CONST. DIV.		
~~A.M.A.F.C.A.~~					

DRAWING NO. | MAP NO. L-17-Z | SHEET 2 OF 3

RF 22 DATE 6-23-93 OP

CITY OF ALBUQUERQUE

This microimage is certified to be a complete and accurate copy of the original as it appears in the files of the PUBLIC WORKS DEPARTMENT - HYDROLOGY DIVISION and was filmed in the normal course of business. The photographic processes used meet the Basic Microfilm Standards of the National Micrographics Association (NS115-1977).

CITY CLERK RECORDER

OFFICIAL SEAL
NORBERTA SANCHEZ
NOTARY PUBLIC
STATE OF NEW MEXICO
My Commission Expires May 8, 1995

THIS PLAN SHOT TWICE ONCE ON LIGHT AND ONCE ON DARK.

CITY OF ALBUQUERQUE
THIS MICROIMAGE IS THE BEST POSSIBLE REPRODUCTION DUE TO THE POOR QUALITY OF THE ORIGINAL DOCUMENT.

PLANS/PLATS ON FILE

FILE DESC: L-17/D013

PLANS/PLATS 1

F 30 D 24 C 20 B 16 A 12 | CITY OF ALBUQUERQUE C D F

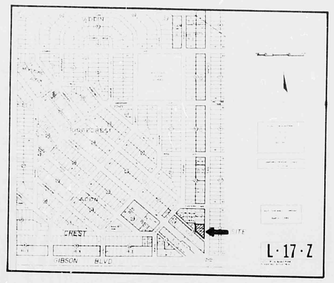

LOCATION MAP

SOILS MAP

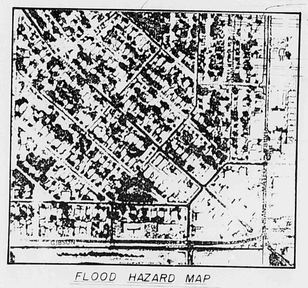

FLOOD HAZARD MAP

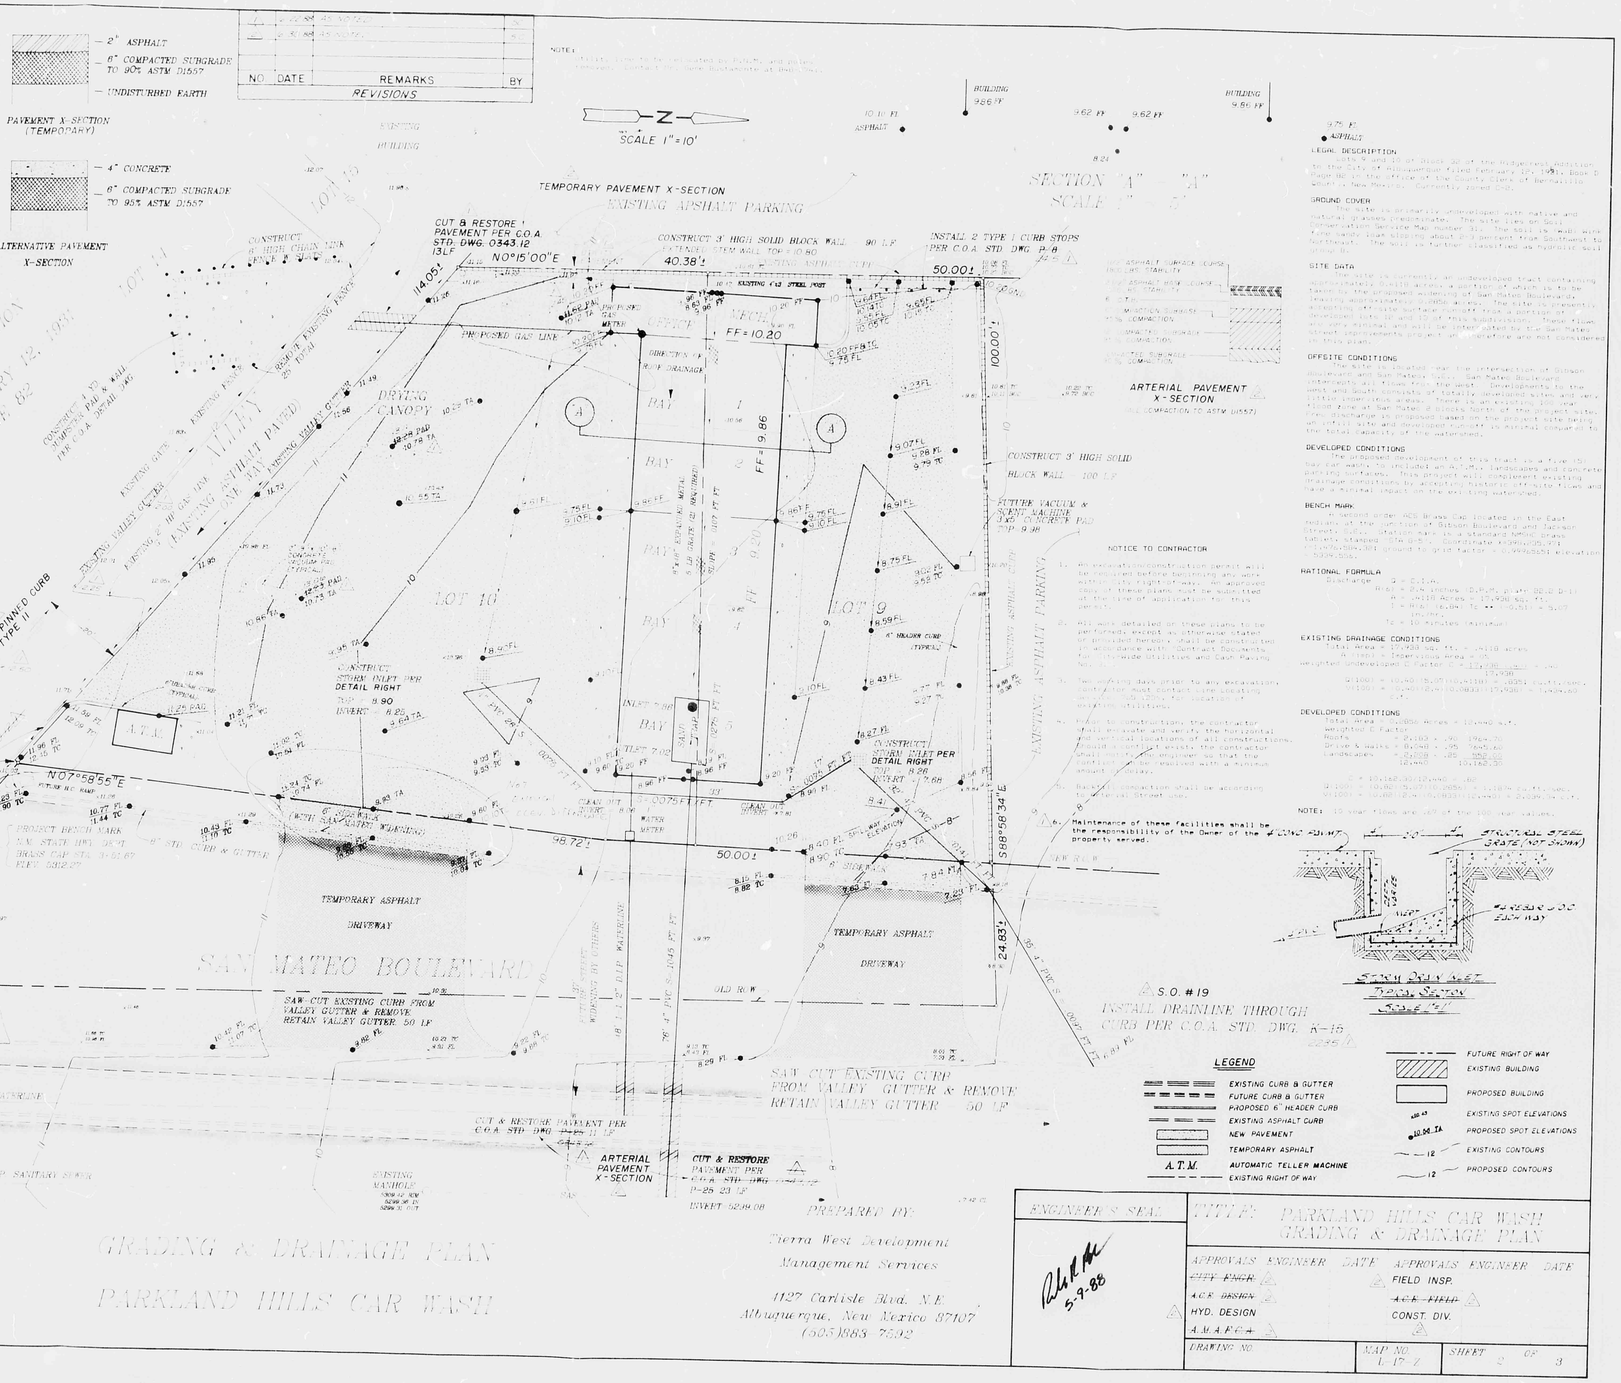

THIS PLAN SHOT TWICE ONCE ON LIGHT AND ONCE ON DARK.

CITY OF ALBUQUERQUE
THIS MICROIMAGE IS THE BEST POSSIBLE REPRODUCTION DUE TO THE POOR QUALITY OF THE ORIGINAL DOCUMENT.

BY: _____ DATE: _____ OF: _____

CITY OF ALBUQUERQUE

This microimage is certified to be a complete and accurate copy of the original as it appears in the files of the PUBLIC WORKS DEPARTMENT - HYDROLOGY DIVISION and was filmed in the normal course of business. The photographic processes used meet the Basic Microfilm Standards of the National Micrographics Association (NMA115-1977).

Karen Acuna
CITY CLERK RECORDER

OFFICIAL SEAL
NORBERTA SANCHEZ
NOTARY PUBLIC
STATE OF NEW MEXICO
My Commission Expires

D 24 C 20 B 16 A 12

CITY OF ALBUQUERQUE

C D