HYDROLOGY

L20/D27

ONE PLAN

FLINCHEM-BEALL

WAREHOUSE

L20/D27

1 PLAN

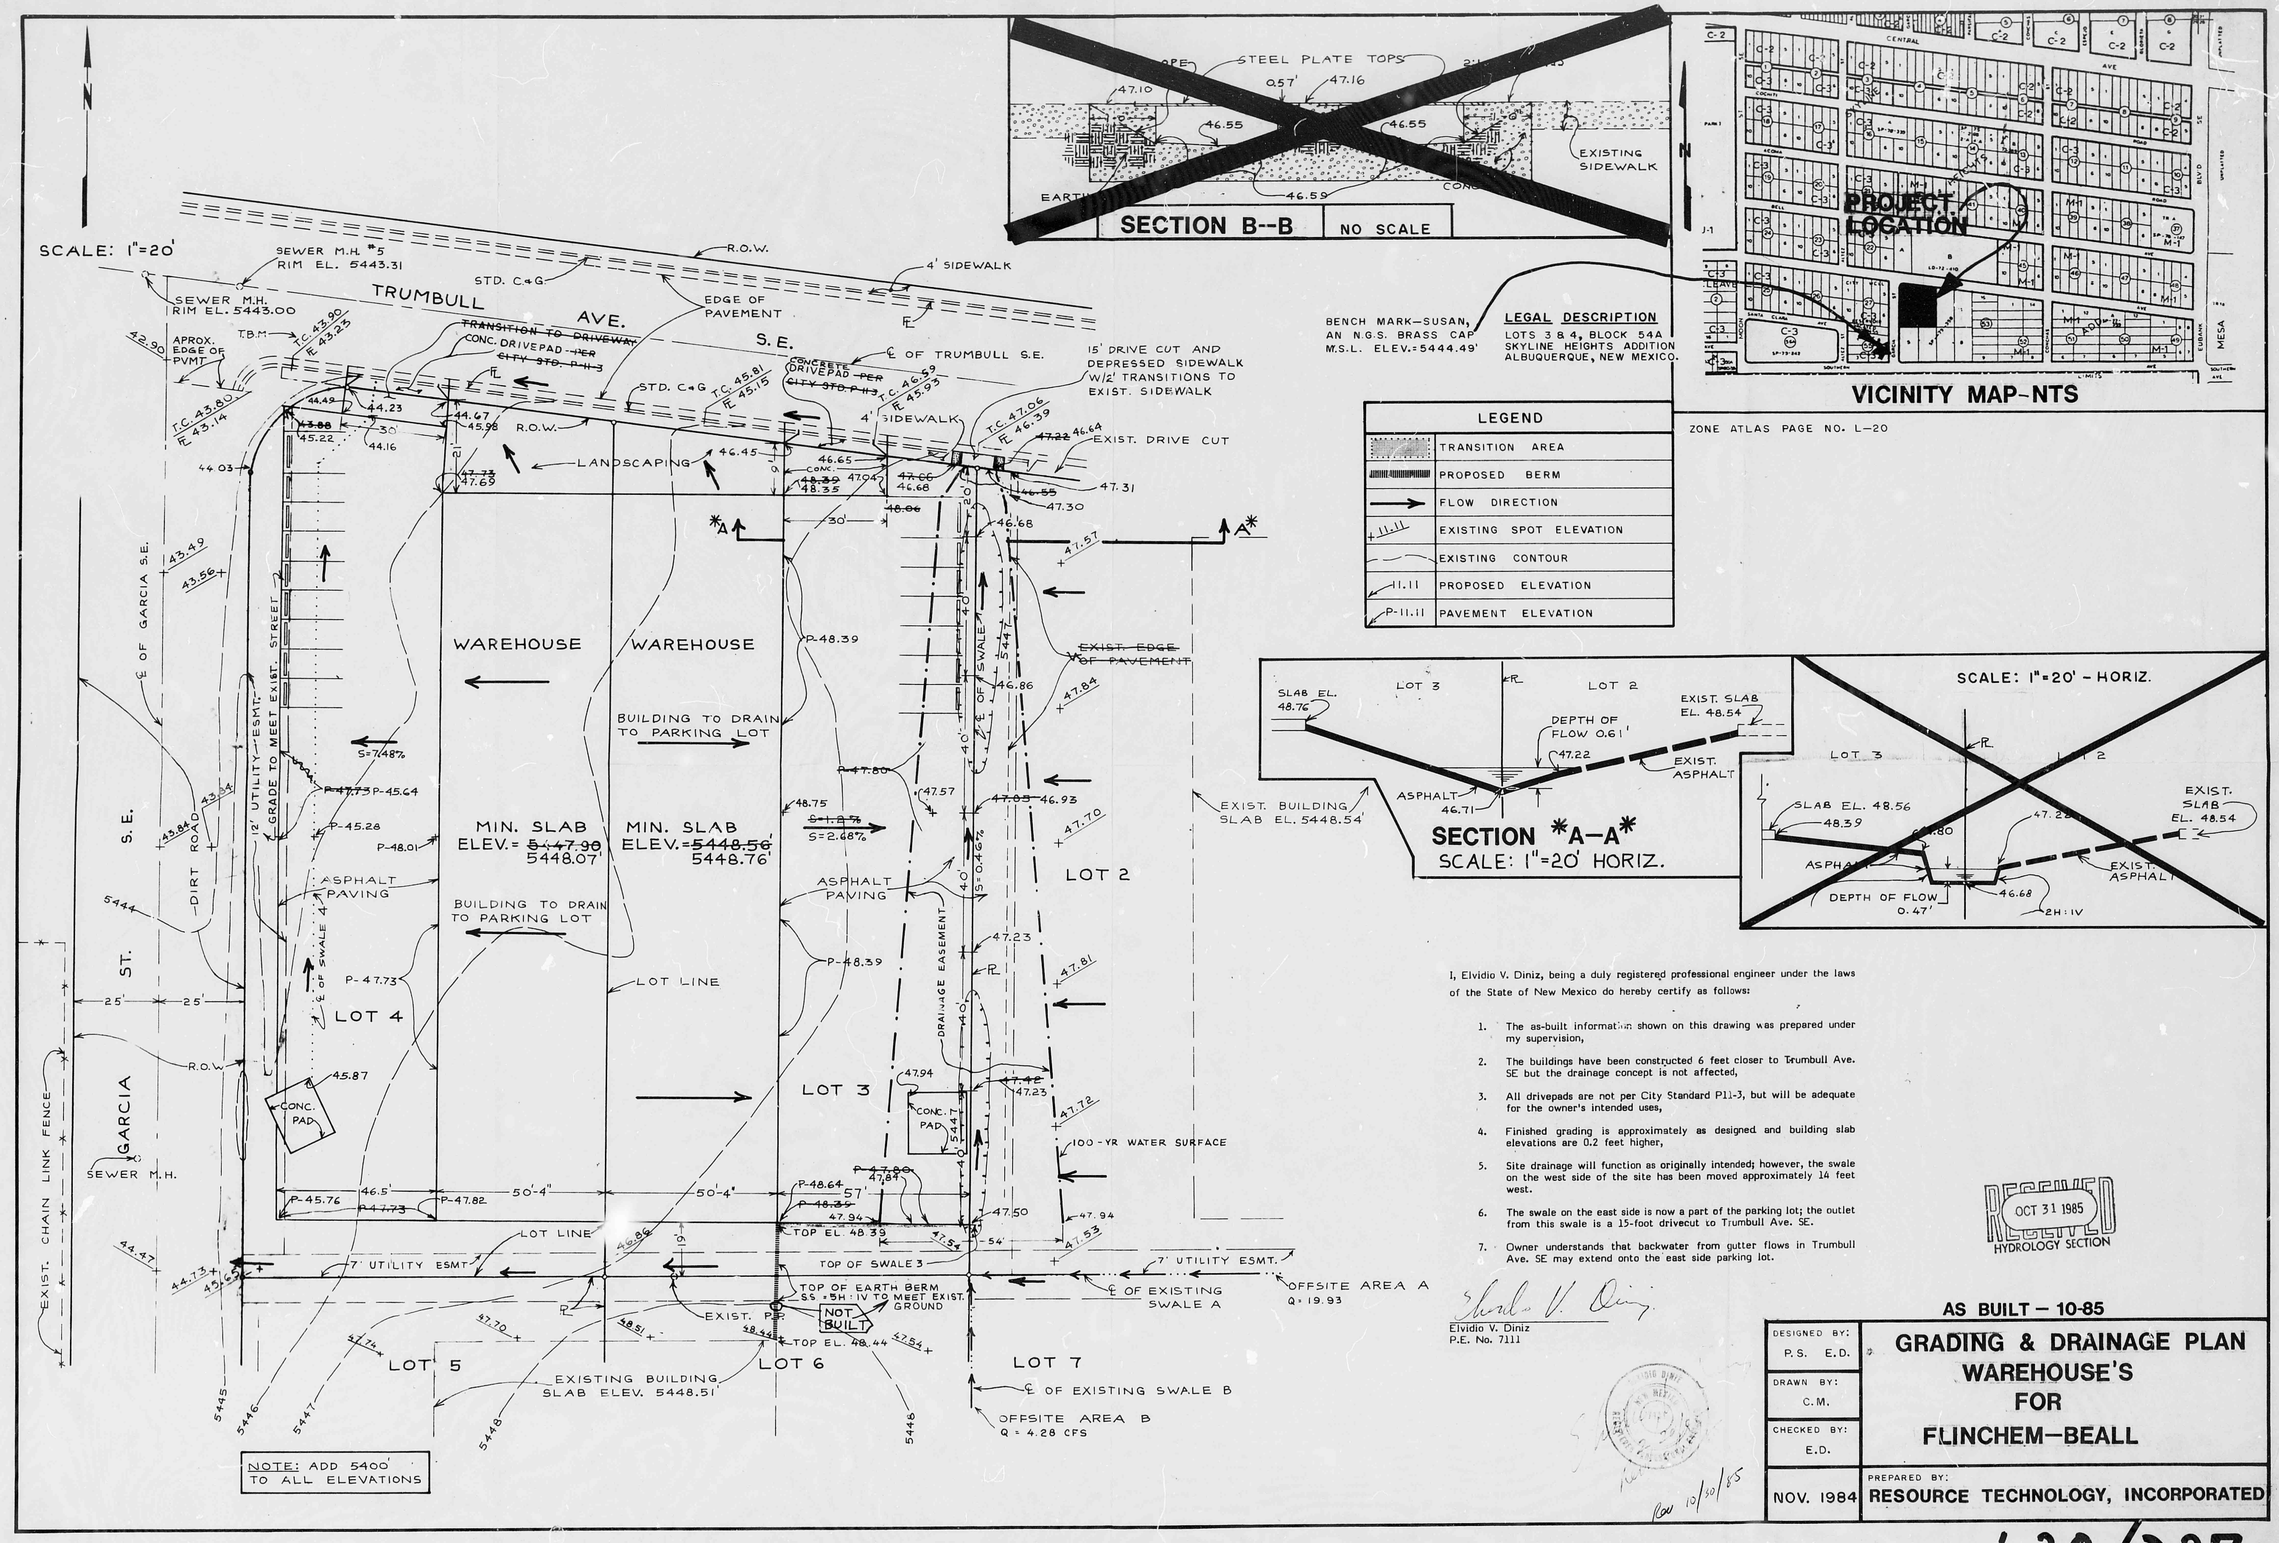

I, Elvidio V. Diniz, being a duly registered professional engineer under the laws of the State of New Mexico do hereby certify as follows:

1. The as-built information shown on this drawing was prepared under my supervision,
2. The buildings have been constructed 6 feet closer to Trumbull Ave. SE but the drainage concept is not affected,
3. All drivepads are not per City Standard P11-3, but will be adequate for the owner's intended uses,
4. Finished grading is approximately as designed and building slab elevations are 0.2 feet higher,
5. Site drainage will function as originally intended; however, the swale on the west side of the site has been moved approximately 14 feet west.
6. The swale on the east side is now a part of the parking lot; the outlet from this swale is a 15-foot drivecut to Trumbull Ave. SE.
7. Owner understands that backwater from gutter flows in Trumbull Ave. SE may extend onto the east side parking lot.

Elvidio V. Diniz
P.E. No. 7111

10/30/85

AS BUILT — 10-85

DESIGNED BY: P.S. E.D.	GRADING & DRAINAGE PLAN WAREHOUSE'S FOR FLINCHEM—BEALL
DRAWN BY: C.M.	
CHECKED BY: E.D.	
NOV. 1984	PREPARED BY: RESOURCE TECHNOLOGY, INCORPORATED

L20/D27