HYDROLOGY

L22/D15
ONE PLAN

L22-D15

1 PLAN

L22/D15

DRAINAGE PLAN
FOR
McDONALDS
AT
TRAMWAY & CENTRAL

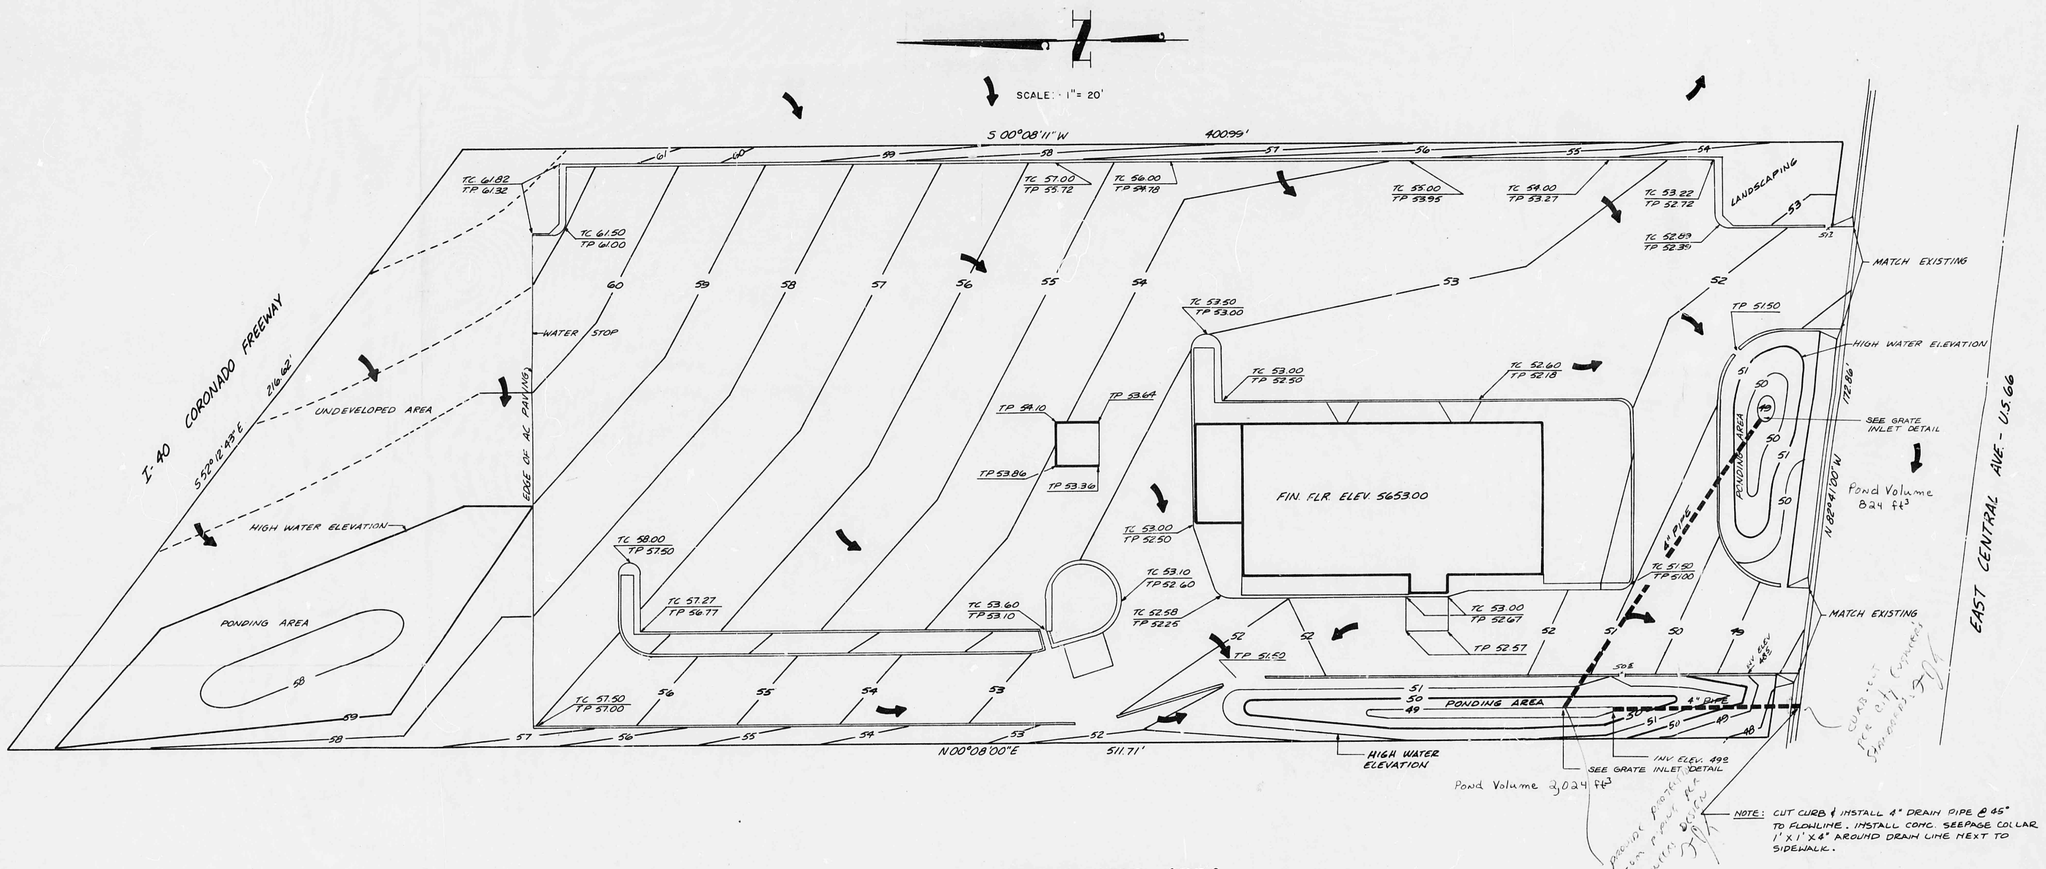

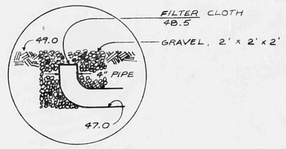

GRATE INLET DETAIL
No Scale

LEGEND

TC	TOP OF CONC. CURB ELEV.
TP	TOP OF PAVING ELEV.
----------	EXISTING CONTOURS
—54—	PROPOSED CONTOURS
➡	PROPOSED DRAINAGE

AS BUILT INFORMATION

		DATE
CONTRACTOR		
WORK STAKED BY		
INSPECTOR'S ACCEPTANCE BY		DATE
FIELD VERIFICATION BY		DATE
DRAWINGS CORRECTED BY		DATE

MICRO-FILM INFORMATION

	DATE
RECORDED BY	
NO.	

BENCH MARKS

SURVEY INFORMATION

FIELD NOTES

NO.	BY	DATE

REFERENCES

MAP NO.		
EST. NO.	WO. NO.	

NO.	DATE	REMARKS	BY
2	4-7-80	MOVED DRAIN LINE	L.M.
1	4-2-80	ADD DRAIN PIPES, CURB OPENING	LMA

REVISIONS

DESIGNED BY UEB — DATE
DRAWN BY CSS — DATE
CHECKED BY — DATE

MEURER, SERAFINI AND MEURER, INC. — CONSULTING ENGINEERS · SURVEYORS · PLANNERS

2601 WYOMING BLVD. N.E. SUITE F ALBUQUERQUE, NEW MEXICO 87112 (505) 292-1936

PLANS PREPARED UNDER THE DIRECTION OF

APPROVED FOR CONSTRUCTION

CITY ENGINEER — DATE

CITY OF ALBUQUERQUE
PUBLIC WORKS DEPARTMENT
ENGINEERING DIVISION

TITLE: DRAINAGE PLAN
McDONALDS
TRAMWAY & CENTRAL

APPROVALS	ENGINEER	DATE	APPROVALS	ENGINEER	DATE
City Engineer			Liquid Waste		
A.C.E.- Design			Traffic		
A.C.E.- Hydrology			Water		

DRAWING NO.

SHEET 1 OF 1

0640 L22/D15