
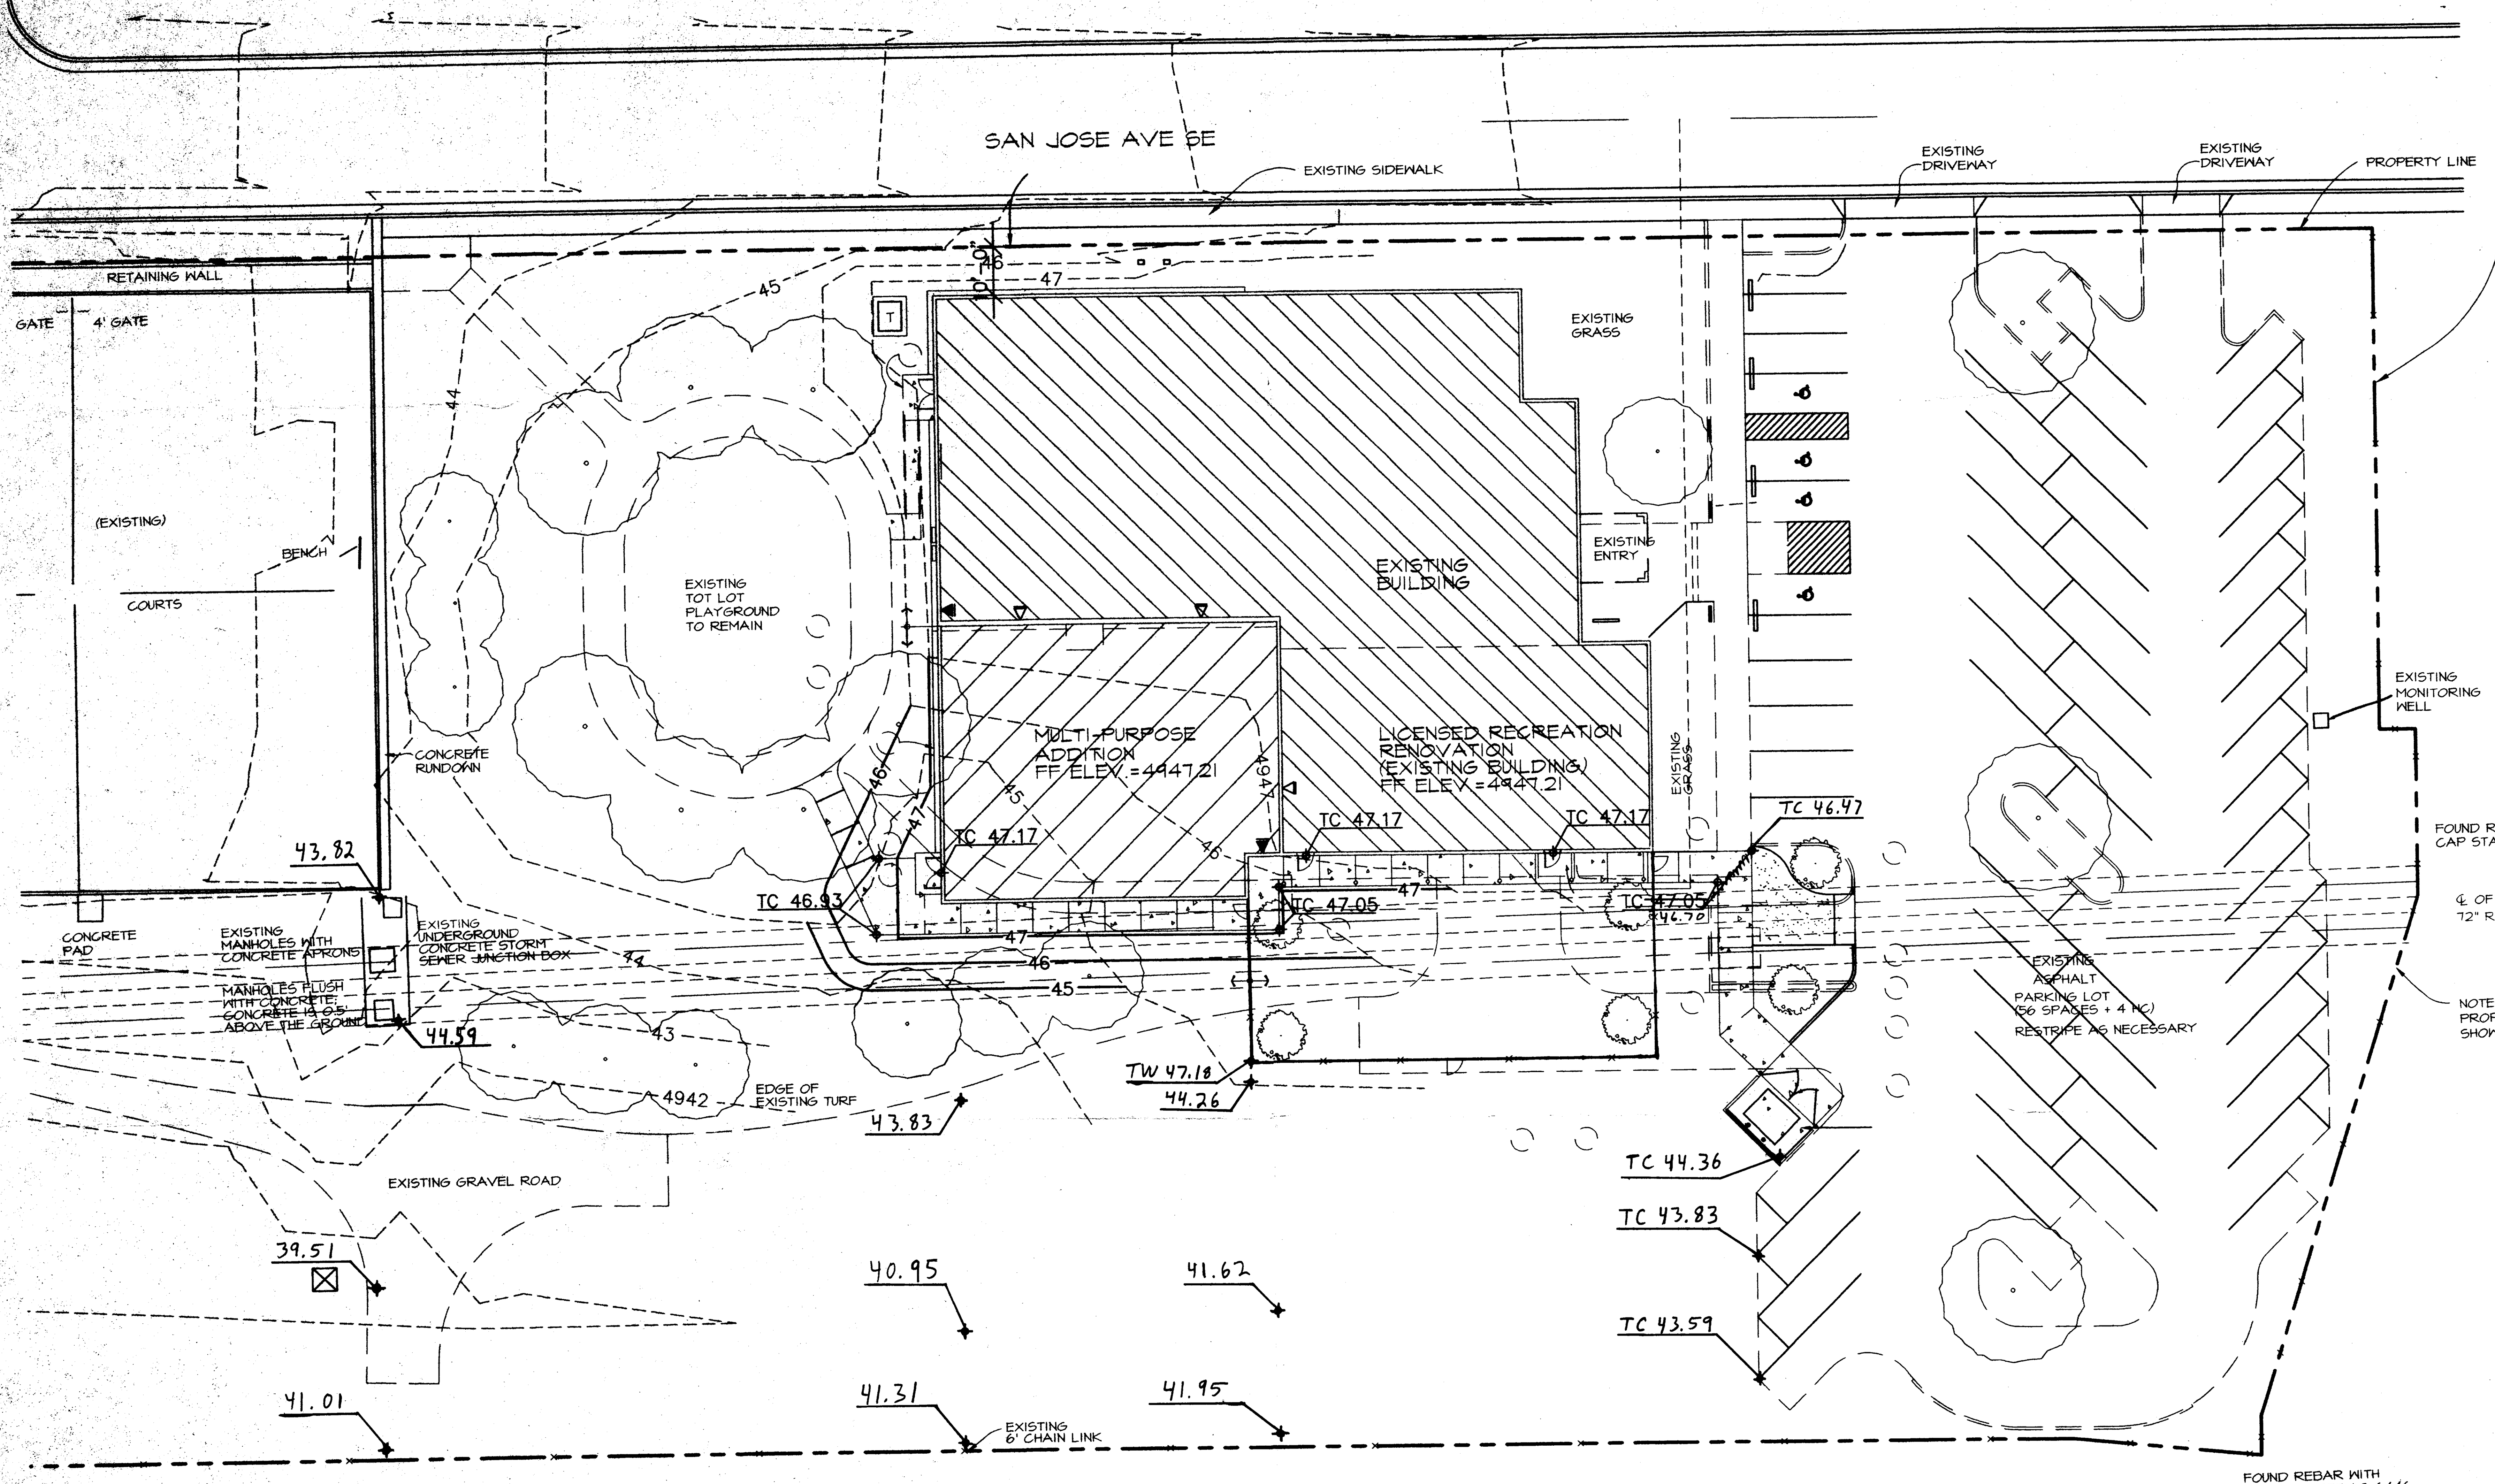


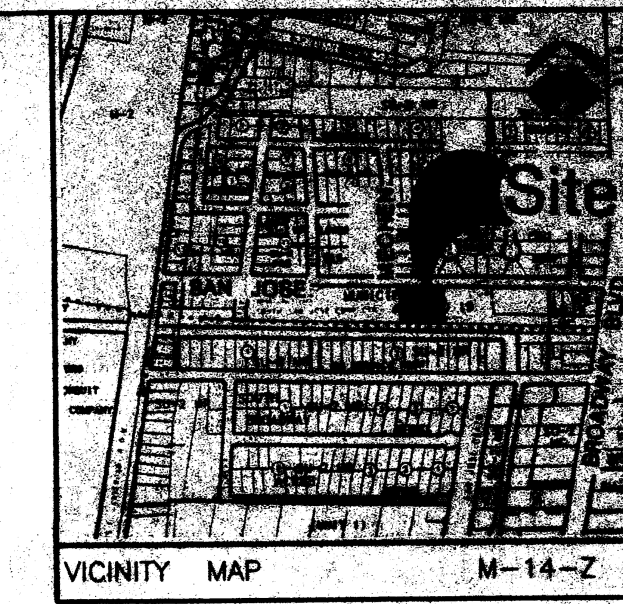

VICINITY MAP M-14-Z

AS BUILT INFORMATION

CONTRACTOR	DATE:
WORK STAKED BY	DATE:
INSPECTOR'S APPROVAL	DATE:
FIELD VERIFICATION BY	DATE:
DRAWING CORRECTED BY	DATE:

MICRO-FILM INFORMATION

RECORDED BY	DATE:
NO.	

BENCH MARK

ACS BENCHMARK "11-M14" ALUMINUM DISK SET IN TOP OF CURB. ELEVATION = 4941.07

SURVEY INFORMATION
FIELD NOTES

NO.	BY	DATE
	SURVEY PROVIDED BY THE CITY OF ALBUQUERQUE PUBLIC WORKS DEPARTMENT, ENGINEERING GROUP SURVEY SECTION	2-92

LEGEND

DESCRIPTION	EXISTING	NEW
BUILDING		
CONCRETE	CONC	
CURB AND GUTTER		
PROPERTY LINE		
CONTOUR	47	47
GRAVEL ROAD		
HEADER CURB		
FENCE		—x—x—
ASPHALT		
ROOF DRAIN	▽	▼
SPOT ELEVATION	45.65	45.65
DIRECTION OF FLOW	⟶	⟶
FUTURE CONSTRUCTION		

RECEIVED JAN 23 2001 HYDROLOGY SECTION

JOSEPH L. DeFRONZO NEW MEXICO 12863 REGISTERED PROFESSIONAL ENGINEER

9-4-98

LEGAL DESCRIPTION

BLOCKS 16, 17, 18, & 19 OF LOWER BROADWAY ADDITION. BERNALILLO COUNTY, NEW MEXICO.

REVISIONS/REMARKS

NO.	DATE	BY

DESIGNED BY: JD DATE:
DRAWN BY: JM/RC DATE:
CHECKED BY: JD DATE:

GRADING AND DRAINAGE PLAN

NORTH 1"=20'-0"

LEGEND

DESIGN ELEV TC 47.17

AS-BUILT ELEV TC 47.20

I HEREBY CERTIFY THIS AS-BUILT DRAINAGE PLAN IS IN SUBSTANTIAL COMPLIANCE WITH THE APPROVED DRAINAGE PLAN.

SIGNED:

DATED: 01.23.01

JAMES E. M... NEW MEXICO 7670 REGISTERED PROFESSIONAL ENGINEER

CHAVEZ · GRIEVES CONSULTING ENGINEERS, INC.
THE ENGINEERING FIRM OF CHOICE
5639 JEFFERSON STREET N.E. • ALBUQUERQUE, NEW MEXICO 87109
PHONE (505) 344-4080 • FAX (505) 343-8759

DESIGN DEVELOPMENT SUBMITTAL

GAMELSKY BENTON ARCHITECTS P.C.
622 Tijeras Avenue NW
Albuquerque, NM 87102
TEL (505) 842-8865 FAX (505) 842-1693

FILE JC-GD

CITY OF ALBUQUERQUE
PARKS AND GENERAL SERVICES
DESIGN & DEVELOPMENT DIVISION

TITLE: JACK CANDELARIA COMMUNITY CENTER MULTI-PURPOSE ADDITION AND ALTERATIONS

GRADING AND DRAINAGE PLAN

Design Review Committee	City Engineer Approval	Last Design Update	MO./DAY/YR.	MO./DAY/YR.
			10/30/97	

City Project No.	Zone Map No.	Sheet	Of
	M-14-Z	C-1	

JOB NO.: 621-113-5197
FILE: JC-GD.DWG
ENG/TECH: JD/RC
REV. 08/31/98 (RC)

MATCHLINE SEE SHEET 4

I HEREBY CERTIFY THIS DRAINAGE PLAN IS IN SUBSTANTIAL COMPLIANCE WITH THE APPROVED DRAINAGE PLAN.

SIGNED: _____

DATE: 9/18/92

ALL GENERAL NOTES APPLY TO BOTH THE PUBLIC WORKS CONTRACT WORK AND TO PARKS AND GENERAL SERVICES WORK UNLESS OTHERWISE NOTED.

ALL WORK WHICH IS PART OF THE PUBLIC WORKS CONTRACT WILL BE INDICATED AS SUCH BY A REFERENCE TO "PWC".

ALL WORK WHICH IS PART OF THE PARKS AND GENERAL SERVICES WORK WILL BE INDICATED AS SUCH BY A REFERENCE TO "PARKS".

AS BUILT INFORMATION

CONTRACTOR — DATE

STAKED BY — DATE

INSPECTIONS BY — DATE

FIELD VERIFICATION BY — DATE

DRAWING CORRECTED BY

MICRO-FILM INFORMATION

RECORDED BY — DATE

NO.

BENCH MARKS

AGS BENCH MARK "11-M14" 1-3/4" ALUMINUM DISK SET IN TOP OF CURB, ELEV = 4941.07 FT
N 1475451.5987
E 380842.4688

SURVEY INFORMATION

FIELD NOTES

NO.	BY	DATE
	COA	2/27/92

ENGINEER'S SEAL

REGISTERED PROFESSIONAL ENGINEER — STATE OF NEW MEXICO — SUSAN M. ALVAREZ — 11-23-92

NO.	DATE	REMARKS	BY
1	11/92	REVISED SOUTH EXTERIOR DRAINAGE AREA DIVIDE, REVISED GRAVEL BASE AND MONUMENTATION	-

DESIGNED BY S ALVAREZ — DATE -

DRAWN BY - — DATE -

CHECKED BY - — DATE -

20/91037.14CD2/UPDATE/12-14-92/MRL

NOTE

WORK ORDER DRAWINGS NO. 4349.90 CONSTRUCTED IN 1993 WERE NOT CERTIFIED. AFTER CONSTRUCTION OF THIS 1995 PROJECT, ENGINEER WILL PROVIDE CERTIFICATION OF ENTIRE PROJECT.

ACS BENCH MARK "11-M14" 1-3/4" ALUMINUM DISK SET IN TOP OF CURB ELEVATION = 4941.07 N 1475451.5987 E 380842.4688

MATCH EXISTING GRADE

S 88°53'40"E 288.20'

RETAINING WALL

2.5%

41.60 41.80

MATCH EXISTING GRADE

LIMITS OF PLAZA GRADING (PARKS)

1.6%

PROVIDE SMOOTH TRANSITION FROM PROPOSED GRADE TO EXISTING GRADE AT EXISTING SLAB

PROVIDE MOWSTRIP / VENEER REPLACEMENT PER SHEET 17

LIMITS OF BUILDING GRADING (PARKS)

GRADE @ FACE OF BUILDING = 47.83

SLOPE DOWN TO 47.00'

PROVIDE SMOOTH TRANSITION FROM PROPOSED GRADE TO EXISTING GRADE AT EXISTING SLAB

SAND IS TO BE 2" BELOW SIDWALK PAVEMENT

TILE ENTRANCE TO PLAY AREA PER DETAIL 2/17

8' FT TYP.

LIMITS OF PLAZA GRADING (PARKS)

PROVIDE MOW STRIP REPLACE-MENT PER SHEET 17

FF 4947.21

LIMITS OF PLAZA GRADING (PARKS)

LIMITS OF BUILDING GRADING (PARKS)

MATCH EXISTING GRADE

MATCH EXISTING ELEVATIONS

GRADE TO EXISTING DRAIN (PARK)

PROTECT TREE FROM DAMAGE (PARK)

SAWCUT AND REMOVE EXISTING SIDEWALK AND PVC DRAIN PIPE REPLACE WITH 12" DRAINAGE SIDEWALK CULVERT WITH STEEL PLATE TOP (SD 2236) TO GRADE SHOWN

EXISTING 8" CI WATERLINE (APPROXIMATE LOCATION, FIELD VERIFY) (PWC, PARKS)

PROVIDE MOWSTRIP / VENEER REPLACEMENT PER SHEET 17

6" CURB - MATCH GRADE WITHIN ISLAND TO TOP OF CURB

CAP EXISTING STORM MH 2' BELOW FINISH GRADE (PWC)
N 1475277.6592
E 381240.5869

BRING FILL TO 0.25' FROM RIM (PWC)

LIMITS OF PARK GRADING (PWC)

LIMITS OF PARK GRADING (PWC)

END CURB @ BLOCK WALL PER SHEET 17

REMOVE EXISTING BEEHIVE DRAIN INLET AND REPLACE WITH MH TOP PER DETAIL 6/16

MATCH RIM TO PROPOSED GRADE (PWC)
N 1475261.0583
E 381255.3373

CONNECT TO EXISTING MH (PWC)
18" EL=34.45
N 1475258.7874
E 380896.0437

57 LF 18"ø CLASS III RCP STORM SEWER @ 1% SLOPE (PWC)

PROVIDE 6" GRAVEL BASE IN LIEU OF CRUSHER FINES

PROP SPECIAL AREA INLET PER DETAIL 9/16 (PWC)
RIM EL=38.2
FL=35.02 35.36
N 1475211.1023
E 380864.9908

GRADE FROM EXISTING GRADE ALONG FENCE TOWARD SWALE (TYP) (PWC)

END OF 6" CURB

1' BREAK IN ISLAND TO PROVIDE DRAINAGE (PWC)

6" CURB MATCH GRADE WITHIN ISLAND TO TOP OF CURB

LIMITS OF OPEN SPACE GRADING (PWC)

LIMITS OF PARKING GRADING (PWC)

END 1'-6" RETAINING WALL PER DETAIL (PWC) 7/16
TOP OF WALL ELEV=42.5
OUTSIDE FOOT OF WALL ELEV=41.0
N 1475180.64
E 381258.68

BEGIN 1'-6" RETAINING WALL PER DETAIL (PWC) 7/16
TOP OF WALL ELEV=42.5
OUTSIDE FOOT OF WALL ELEV=41.0
N 1475182.30
E 341191.68

TYPE D GRATE INLET PER CITY STANDARD DETAIL #2206 (PWC)
RIM EL=41.5 42.06
24" FL=38.5 37.23
N 1475175.3081
E 381225.1314

24 LF 18" ø CMP STORM SEWER @ 1%

SPECIAL CMP MH ON EXISTING 12'x6' STEEL PLATE PIPE PER DETAIL 8/16 (PWC)
RIM ELEV=41.8
FL=4930.70
N 1475174.9055
E 381248.6286

PROJECT SITE

VICINITY MAP

M-14-Z

1" = 750'

N

0 10' 20' 40' 60'

1" = 20'-0"

LEGEND

- DRAINAGE AREA BOUNDARY
- 41 PROPOSED CONTOUR
- DRAINAGE SWALE
- LIMITS OF GRADING
- WORK SHOWN ON LANDSCAPING PLAN
- 39.85 SPOT ELEVATION
- 2 DRAINAGE AREA DESIGNATION
- 1.53 4.70 100 YEAR 6 HOUR RUNOFF
- DRAINAGE AREA (ACRES)
- 1/16 DETAIL NUMBER / SHEET NUMBER

TOPOGRAPHIC PLAT OF SOUTH SAN JOSE COMMUNITY CENTER AND PARK COMPRISED OF BLOCKS 16, 17, 18 & 19 OF LOWER BROADWAY ADDITION FILED SEP. 13, 1923 IN BOOK D1, PAGE 32 AND TRACT 58A OF MRGCD MAP NO 44 BERNALILLO COUNTY, NEW MEXICO FEB. 27, 1992

RECORD ELEVATION

- TRAVERSE POINT
- METAL POST
- CABLE TV RISER
- MANHOLE
- DRAIN INLET
- ELECTRIC MANHOLE
- TELEPHONE MANHOLE
- TRAFFIC SIGNAL
- WATER VALVE
- GAS RISER
- WATER RISER
- ELECTRIC RISER
- TELEPHONE RISER
- POWER POLE WITH LIGHT
- POWER POLE
- FIRE HYDRANT
- SIGN POST
- DECIDUOUS TREE
- CONIFEROUS TREE
- BUSH
- CHAIN LINK FENCE
- OH — OVER HEAD WIRE
- UGP — UNDER GROUND PIPE
- GAS — UNDER GROUND GAS LINE
- SAN — SANITARY SEWER LINE
- W — WATER LINE

GENERAL NOTES

ENGINEER: LEEDSHILL-HERKENHOFF, INC.
500 COPPER AVENUE, NW
ALBUQUERQUE, NEW MEXICO, 87103
ATTENTION: SUSAN M. ALVAREZ, P.E.
(505) 247-0294

SURVEYOR: SURVEY PROVIDED BY THE CITY OF ALBUQUERQUE PUBLIC WORKS DEPARTMENT, ENGINEERING GROUP SURVEY SECTION. DATE OF SURVEY: FEBRUARY 1992

BENCHMARK: ACS BENCHMARK "11-M14", 1-3/4" ALUMINUM DISK SET IN TOP OF CURB, ELEVATION = 4941.07 FT.
N 1475451.5967
E 380842.4688

AREA: 6.49 ACRES, APPROXIMATELY 282,558 SQ FT

FLOOD HAZARD: NO PART OF THIS PARK NOR OF THE ADJACENT PUBLIC ROADWAYS ARE SUBJECT TO A FLOOD HAZARD AREA AS DETERMINED BY COMMUNITY PANEL NO. 350002 0034 OF THE FEMA FLOOD INSURANCE RATE MAPS EFFECTIVE OCTOBER 14, 1983. THE PROJECT AREA IS INDICATED AS A "ZONE C", AN AREA OF MINIMAL FLOODING.

MORROW & COMPANY, LTD. LANDSCAPE ARCHITECTS
210 La Veta N.E.
Albuquerque, N.M. 87108
PH: 505 268-2266 FAX: 505 265-9637

LEEDSHILL-HERKENHOFF, INC.
ARCHITECTS ENGINEERS
ALBUQUERQUE SANTA FE SAN DIEGO

CITY OF ALBUQUERQUE
PARKS/GENERAL SERVICES
DESIGN & DEVELOPMENT

TITLE:
SOUTH SAN JOSE PARK RENOVATION
GRADING DRAINAGE AND PLAN EAST

APPROVALS	ENGINEER	DATE	APPROVALS	ENGINEER	DATE
DRC CHAIRMAN		12-10-92	WATER	N/A RWE	11-30-92
TRANSPORTATION	N/A	12-11-92	WASTE WATER	N/A RWE	11-30-92
HYDROLOGY	JPE	12-8-92			
PARKS		11/30/92			

PROJECT NO. 4349.90 | MAP NO. M-14-Z | SHEET 5 OF 20

ALL GENERAL NOTES APPLY TO BOTH THE PUBLIC WORKS CONTRACT WORK AND TO PARKS AND GENERAL SERVICES WORK UNLESS OTHERWISE NOTED.

ALL WORK WHICH IS PART OF THE PUBLIC WORKS CONTRACT WILL BE INDICATED AS SUCH BY A REFERENCE TO "PWC".

ALL WORK WHICH IS PART OF THE PARKS AND GENERAL SERVICES WORK WILL BE INDICATED AS SUCH BY A REFERENCE TO "PARKS".

MATCHLINE SEE SHEET 5

REGRADE EXISTING PLAY AREA PER LANDSCAPE DETAILS (PARKS)

10' TYPICAL

DRAINAGE DIVIDE

LIMITS OF GRADING (PWC)

LIMITS OF SEEDING

MANHOLE ACCESS ROAD PER SHEET 6 (PARKS)

CONCRETE TURNOUT PER CITY STN'D DWG #2425 (PARKS).

MATCH EXISTING GRADE EXCEPT AS NOTED

5' TYP

DO NOT GRADE WITHIN DRIPLINE OF TREES

GRADE FROM EXISTING GRADE AT TREES TO INLET (PWC)

SPECIAL AREA INLET TOP ON EXISTING MH PER DETAIL 5/16 (PWC)
RIM EL = ~~37.0~~ 38.20
36" FL = ~~4932.90~~ 33.63
N = 1475245.0251
E = 380287.0434

GRADE TOWARDS SITE THIS AREA (PWC)

BEGIN SWALE
N 1475193.3860
E 380681.9303
EL = 41.0

MAXIMUM SIDE SLOPE ~33%

MINIMUM SIDE SLOPE ~3.7%

NOTE
WORK ORDER DRAWINGS NO. 4349.90 CONSTRUCTED IN 1993 WERE NOT CERTIFIED. AFTER CONSTRUCTION OF THIS 1995 PROJECT, ENGINEER WILL PROVIDE CERTIFICATION OF ENTIRE PROJECT.

LEGEND

- DRAINAGE AREA BOUNDARY
- 41 PROPOSED CONTOUR
- DRAINAGE SWALE
- LIMITS OF GRADING
- WORK SHOWN ON LANDSCAPING PLAN
- SPOT ELEVATION
- DRAINAGE AREA DESIGNATION
- 100 YEAR 6 HOUR RUNOFF
- DRAINAGE AREA (ACRES)
- DETAIL NUMBER
- SHEET NUMBER

- RECORD ELEVATION
- TRAVERSE POINT
- METAL POST
- CABLE TV RISER
- MANHOLE
- DRAIN INLET
- ELECTRIC MANHOLE
- TELEPHONE MANHOLE
- TRAFFIC SIGNAL
- WATER VALVE
- GAS RISER
- WATER RISER
- ELECTRIC RISER
- TELEPHONE RISER
- POWER POLE WITH LIGHT
- POWER POLE
- FIRE HYDRANT
- SIGN POST
- DECIDUOUS TREE
- CONIFEROUS TREE
- BUSH
- CHAIN LINK FENCE
- OVER HEAD WIRE
- UGP UNDER GROUND PIPE
- GAS UNDER GROUND GAS LINE
- SAN SANITARY SEWER LINE
- W WATER LINE

TOPOGRAPHIC PLAT OF
SOUTH SAN JOSE
COMMUNITY CENTER AND PARK
COMPRISED OF
BLOCKS 16, 17, 18 & 19 OF
LOWER BROADWAY ADDITION
FILED SEP. 13, 1923
IN BOOK D1, PAGE 32
AND TRACT 58A OF MRGCD MAP NO 44
BERNALILLO COUNTY, NEW MEXICO
FEB. 27, 1992

I HEREBY CERTIFY THIS DRAINAGE PLAN IS IN SUBSTANTIAL COMPLIANCE WITH THE APPROVED DRAINAGE PLAN.

SIGNED: Jim P. Kelly

DATE: 9/15/92

GENERAL NOTES

ENGINEER: LEEDSHILL-HERKENHOFF, INC.
500 COPPER AVENUE, NW
ALBUQUERQUE, NEW MEXICO, 87103
ATTENTION: SUSAN M. ALVAREZ, P.E.
(505) 246-0294

SURVEYOR: SURVEY PROVIDED BY THE CITY OF ALBUQUERQUE PUBLIC WORKS DEPARTMENT, ENGINEERING GROUP SURVEY SECTION. DATE OF SURVEY: FEBRUARY 1992

BENCHMARK: ACS BENCHMARK "11-M14", 1-3/4" ALUMINUM DISK SET IN TOP OF CURB, ELEVATION = 4941.07 FT.
N 1475451.5967
E 380842.4688

AREA: 6.49 ACRES, APPROXIMATELY 282,558 SQ FT

FLOOD HAZARD: NO PART OF THIS PARK NOR OF THE ADJACENT PUBLIC ROADWAYS ARE SUBJECT TO A FLOOD HAZARD AREA AS DETERMINED BY COMMUNITY PANEL NO. 350002 0034 OF THE FEMA FLOOD INSURANCE RATE MAPS EFFECTIVE OCTOBER 14, 1983. THE PROJECT AREA IS INDICATED AS A "ZONE C", AN AREA OF MINIMAL FLOODING.

PROJECT SITE

1"=750'±

VICINITY MAP

M-14-Z

N

0 10' 20' 40' 60'
1" = 20'-0"

MORROW & COMPANY, LTD.
LANDSCAPE ARCHITECTS
210 La Veta N.E.
Albuquerque, N.M. 87108
PH: 505 268-2268 FAX: 505 265-9637

LEEDSHILL-HERKENHOFF, INC.
ARCHITECTS ENGINEERS
ALBUQUERQUE SANTA FE SAN DIEGO

NOVEMBER 19, 1992 c:\91037\14CD2\SJGRDNG1\11-02-92\KHK

SURVEY INFORMATION
FIELD NOTES

NO.	BY	DATE
	COA	2/27/92

BENCH MARKS
ACS BENCH MARK "11-M14" 1-3/4" ALUMINUM DISK SET IN TOP OF CURB.
ELEV = 4941.07 FT.
N 1475451.5987
E 380842.4688

AS BUILT INFORMATION

	DATE
CONTRACTOR	
WORK STAKED BY	
INSPECTOR'S ACCEPTANCE BY	
AS-BUILT VERIFICATION BY	
DRAWING CORRECTED BY	
MICRO-FILM INFORMATION	
RECORDED BY	
NO.	

ENGINEER'S SEAL

Susan M. Alvarez
November 9, 1992

NO.	DATE	REMARKS
		REVISIONS


DESIGNED BY S. ALVAREZ DATE –
DRAWN BY – DATE –
CHECKED BY – DATE –


CITY OF ALBUQUERQUE
PARKS/GENERAL SERVICES
DESIGN & DEVELOPMENT

TITLE:
SOUTH SAN JOSE PARK RENOVATION
GRADING & DRAINAGE PLAN WEST

APPROVALS	ENGINEER	DATE	APPROVALS	ENGINEER	DATE
DRC CHAIRMAN	J.G. Hendley	12-10-92	WATER	N/A RWK	11-30-92
TRANSPORTATION	[illegible]	[illegible]	WASTE WATER	N/A RWK	11-30-92
HYDROLOGY	QPC	12-8-92			
PARKS	S. Alvarez	11/20/92			

PROJECT NO. 4349.90 | MAP NO. M-14-Z | SHEET 4 OF 20

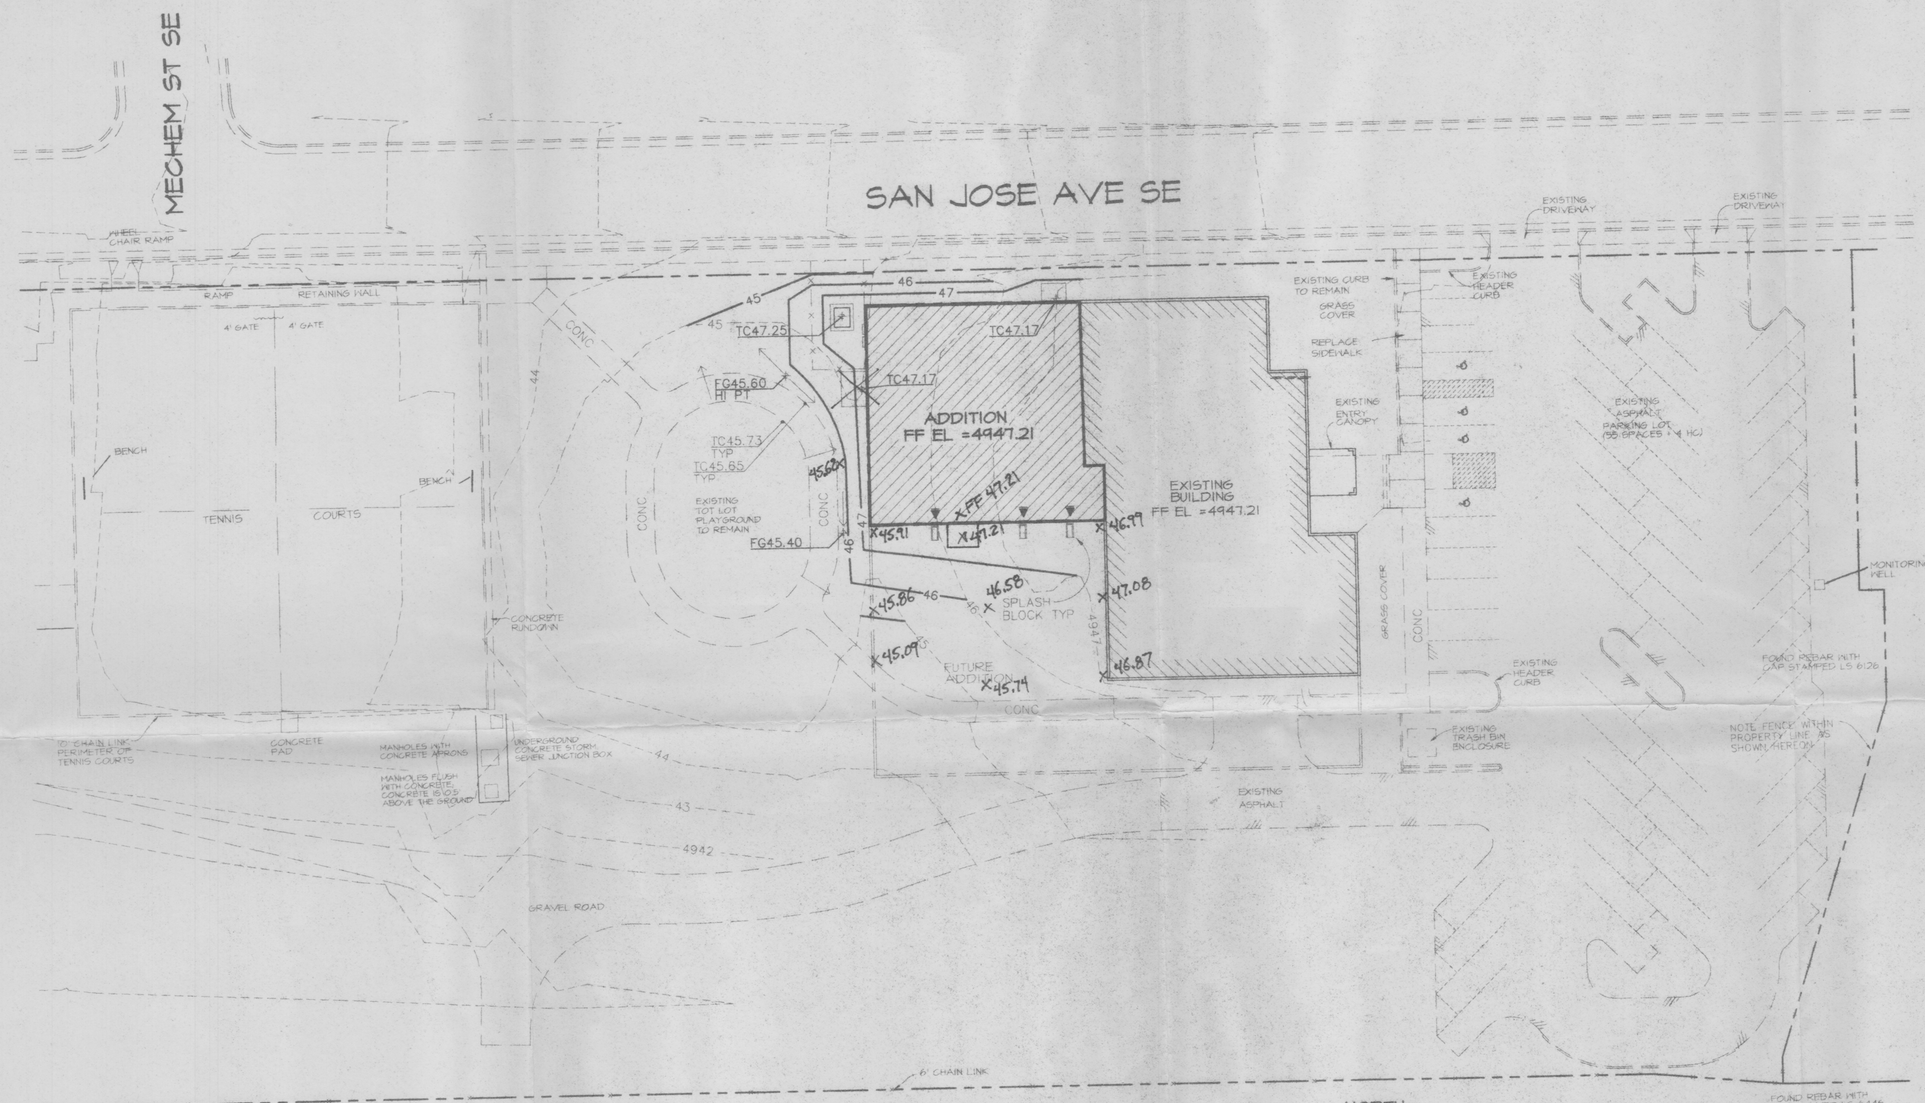

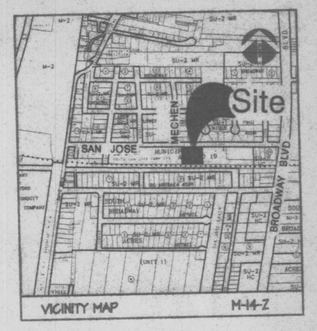

LEGEND

DESCRIPTION	EXISTING	NEW
BUILDING		
CONCRETE	CONC	
CURB AND GUTTER		
PROPERTY LINE		
CONTOUR	47	47
GRAVEL ROAD		
HEADER CURB		
FENCE		
ASPHALT		
ROOF DRAIN		
SPOT ELEVATION	45.65	45.65
DIRECTION OF FLOW		
FUTURE CONSTRUCTION		
RECORD ELEVATION		X45.65

LEGAL DESCRIPTION

BLOCKS 16, 17, 18, & 19 OF LOWER BROADWAY ADDITION. BERNALILLO COUNTY, NEW MEXICO.

BENCHMARK

ACS BENCHMARK "11-M14" ALUMINUM DISK SET IN TOP OF CURB, ELEV=4941.07.

SURVEY

SURVEY PROVIDED BY THE CITY OF ALBUQUERQUE PUBLIC WORKS DEPARTMENT, ENGINEERING GROUP SURVEY SECTION. FEB. 1992.

EROSION CONTROL NOTES

1. THE CONTRACTOR SHALL CONFORM TO ALL CITY, COUNTY, STATE, AND FEDERAL DUST AND EROSION CONTROL REGULATIONS. THE CONTRACTOR SHALL PREPARE AND OBTAIN ANY NECESSARY DUST OR EROSION CONTROL PERMITS FROM REGULATORY AGENCIES.
2. THE CONTRACTOR SHALL SECURE A "TOP SOIL DISTURBANCE PERMIT" FROM THE CITY OF ALBUQUERQUE ENVIRONMENTAL HEALTH DIVISION PRIOR TO BEGINNING CONSTRUCTION.
3. THE CONTRACTOR SHALL PROMPTLY REMOVE ANY MATERIAL EXCAVATED WITHIN THE PUBLIC RIGHT-OF-WAY TO KEEP IT FROM WASHING OFF THE PROJECT SITE.
4. THE CONTRACTOR SHALL ENSURE THAT NO SOIL ERODES FROM THE SITE ONTO OTHER PROPERTY BY CONSTRUCTING TEMPORARY EROSION CONTROL BERMS AT THE PROPERTY LINES AND WETTING THE SOIL TO KEEP IT FROM BLOWING.
5. WATERING, AS REQUIRED FOR CONSTRUCTION AND DUST CONTROL, SHALL BE CONSIDERED INCIDENTAL TO CONSTRUCTION AND NO MEASUREMENT OR PAYMENT SHALL BE MADE THEREFOR. CONSTRUCTION AREAS SHALL BE WATERED FOR DUST CONTROL IN COMPLIANCE WITH GOVERNMENT ORDINANCES. THE CONTRACTOR SHALL BE RESPONSIBLE FOR LOCATING AND SUPPLYING WATER AS REQUIRED.
6. ANY AREAS DISTURBED BY CONSTRUCTION AND NOT COVERED BY LANDSCAPING OR AN IMPERVIOUS SURFACE SHALL BE REVEGETATED WITH RECLAMATION SEEDING.

JOB NO.: 621-105-5195
FILE: JOSE-GD.DWG 8-1-95
REV: 9-12-95

NORTH

GRADING AND DRAINAGE PLAN

1"=20'-0"

I HEREBY CERTIFY THIS DRAINAGE PLAN IS IN SUBSTANTIAL COMPLIANCE WITH THE APPROVED DRAINAGE PLAN.

SIGNED: Joe P. Kelley

DATE: 9/18/96

RECEIVED
OCT 24 1996
HYDROLOGY DIV.

JOB TITLE	DATE
SOUTH SAN JOSE MULTI-PURPOSE CENTER	9/12/95
SHEET TITLE	BY
GRADING AND DRAINAGE PLAN	JK/ Ñ
PROJECT MANAGER	
ISAAC BENTON, AIA	

JOE P. KELLEY NEW MEXICO 9096 REGISTERED PROFESSIONAL ENGINEER 9-11-95

GAMELSKY BENTON ARCHITECTS P.C.
622 Tijeras Avenue NW
Albuquerque, NM 87102
TEL (505) 842-8865 FAX (505) 842-1693

CHAVEZ · GRIEVES CONSULTING ENGINEERS, INC.
5639 JEFFERSON STREET N.E. • ALBUQUERQUE, NEW MEXICO 87109
PHONE (505) 344-4080 • FAX (505) 345-5758

SHEET OF C-2