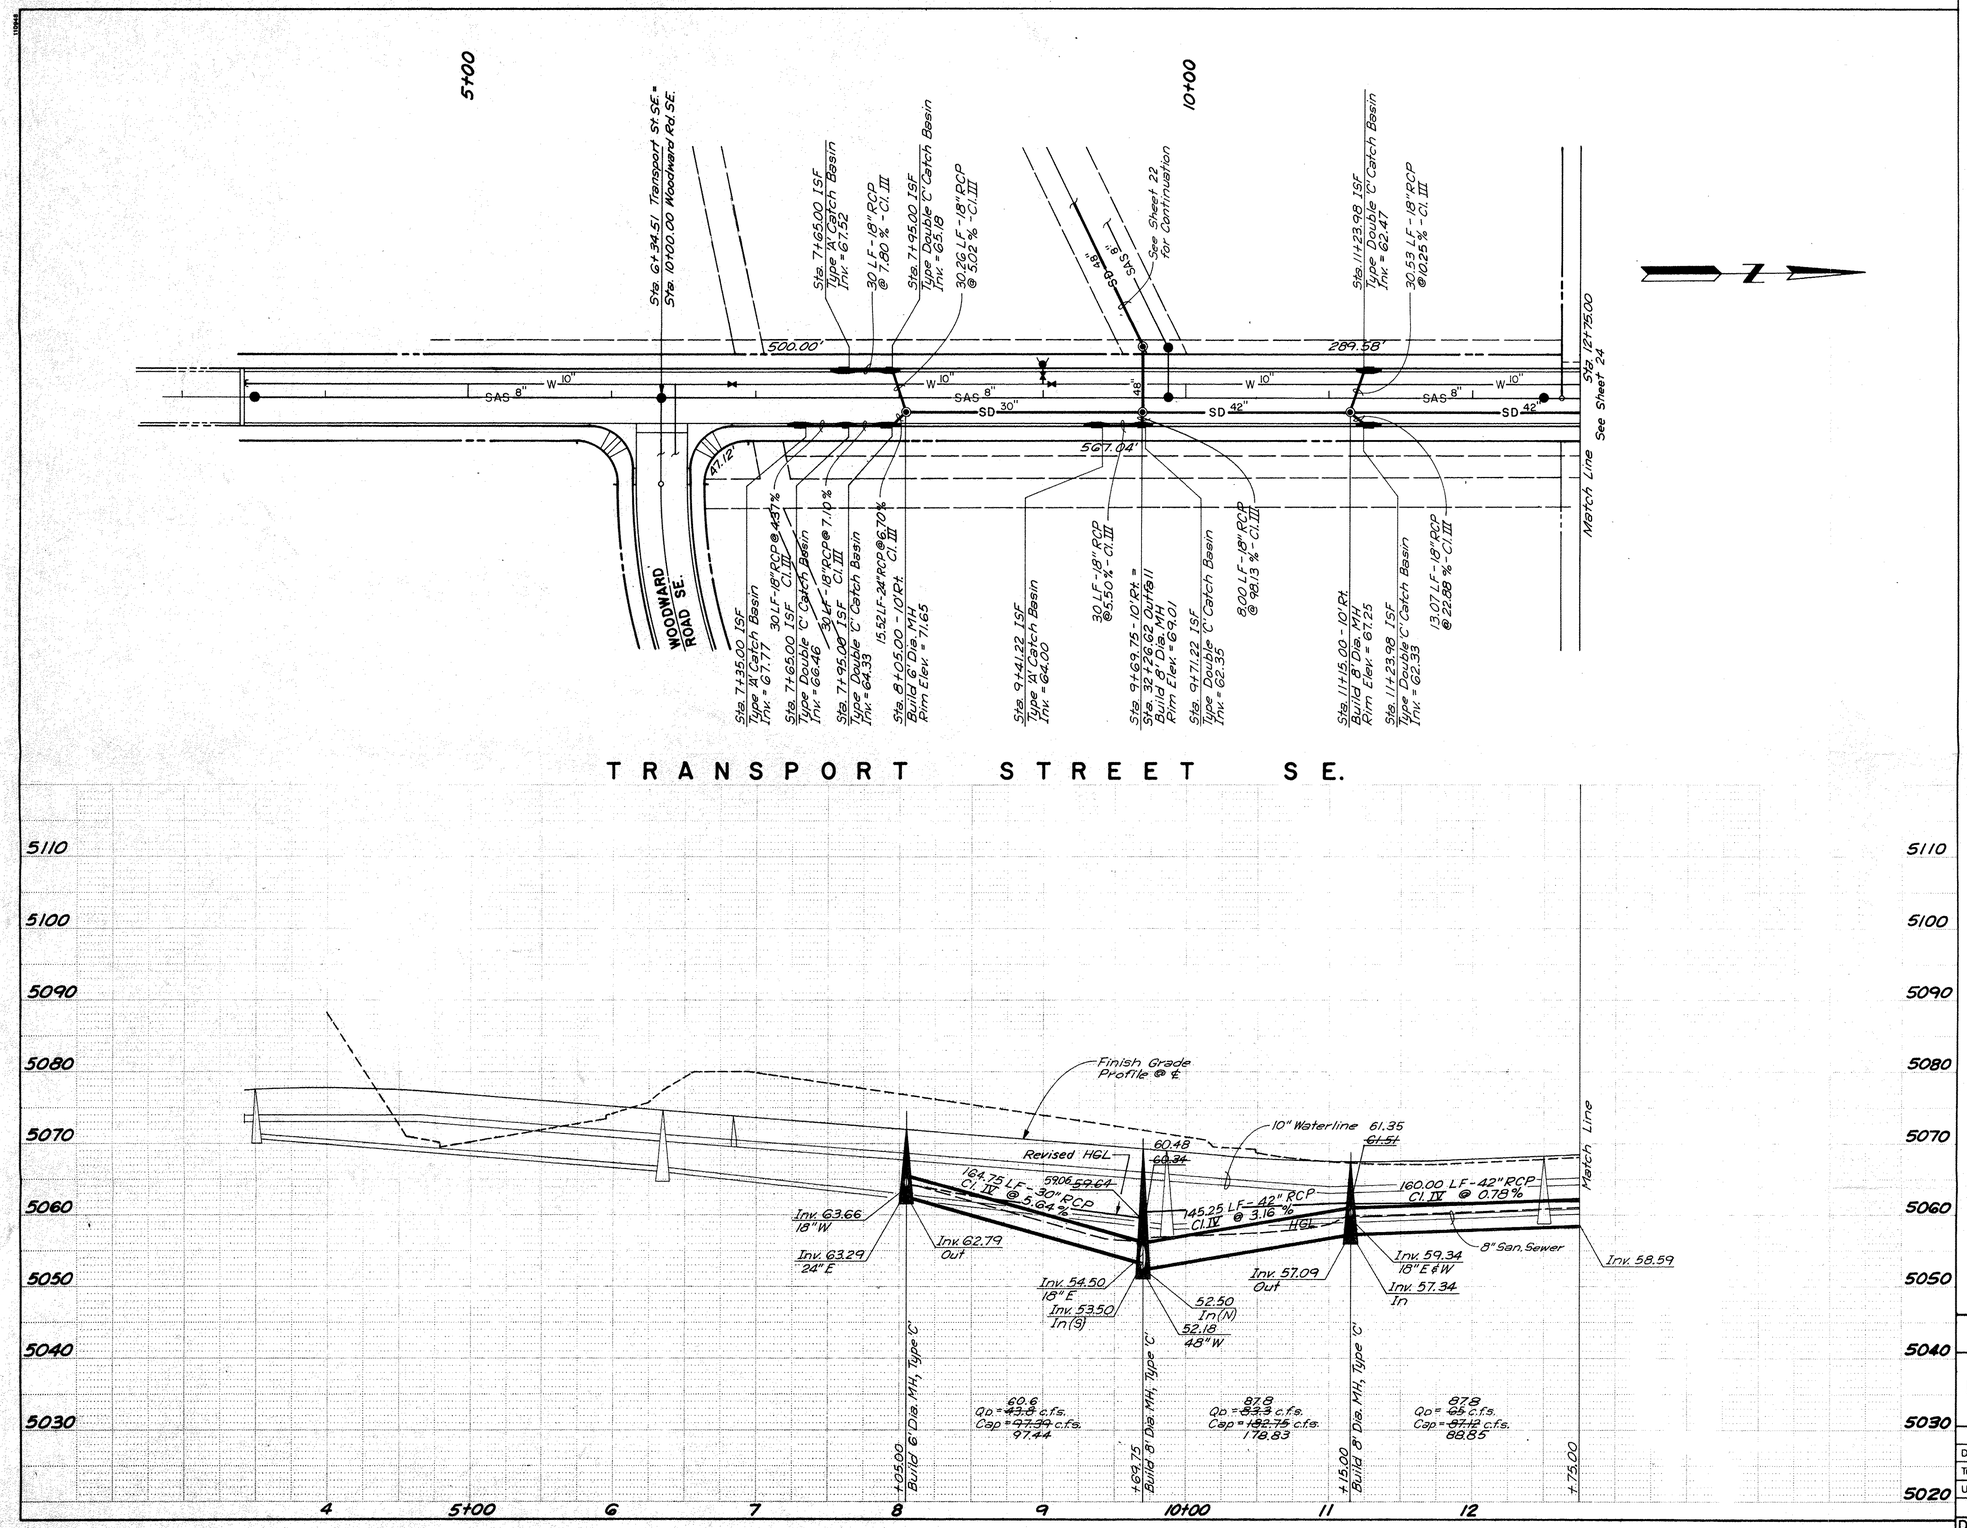

SURVEY INFORMATION			BENCH MARKS	AS BUILT INFORMATION
FIELD NOTES			STA. "1-25-31" ELEVATION 5062.528	CONTRACTOR New Concepts Inc.
NO.	BY	DATE	STANDARD NMSHC BRASS TABLET SET IN CONCRETE POST LOCATED AT THE NORTHEAST CORNER OF THE HIGHWAY I-25 BRIDGE CROSSING OVER AN ABANDONED RAILROAD SPUR LINE APPROXIMATELY 1.15 MILES NORTH OF RIO BRAVO BOULEVARD	WORK STAKED BY AA&R DATE 12-88 INSPECTOR'S ACCEPTANCE BY R.E. DATE 2-89 FIELD VERIFICATION BY AA&R DATE 1-89 DRAWINGS CORRECTED BY MICRO-FILM INFORMATION DATE RECORDED BY DATE NO.

ENGINEER'S SEAL

PROFESSIONAL ENGINEER — STATE OF NEW MEXICO — JOHN A. ANDREWS

ANDREWS, ASBURY & ROBERT, INC.
CONSULTING ENGINEERS
ALBUQUERQUE, NEW MEXICO 88-5150

NO.	DATE	REMARKS	BY
1	7-10-90	Revise HGL	JAR
2	8-22-90	Revise HGL	JAR

REVISIONS

DESIGNED BY JA, RF DATE Oct, 1987
DRAWN BY CB, JCS DATE Oct, 1987
CHECKED BY JA, RF DATE Oct, 1987

John A. Andrews
RECORD DRAWING
2-8-89

26 2950 2389

CITY OF ALBUQUERQUE
PUBLIC WORKS DEPARTMENT

RECEIVED AUG 2 4 1990 ENGINEERING DIVISION

SUNPORT PARK
INFRASTRUCTURE IMPROVEMENTS, PHASE I
STORM DRAIN PLAN & PROFILE
TRANSPORT STREET SE.

APPROVALS	ENGINEER	DATE	APPROVALS	ENGINEER	DATE
D.R.C. Chair					
Trans. Dev.					
Utility Dev.					

DRAWING NO.	MAP NO.	SHEET	OF
2950	M-15	23	26