


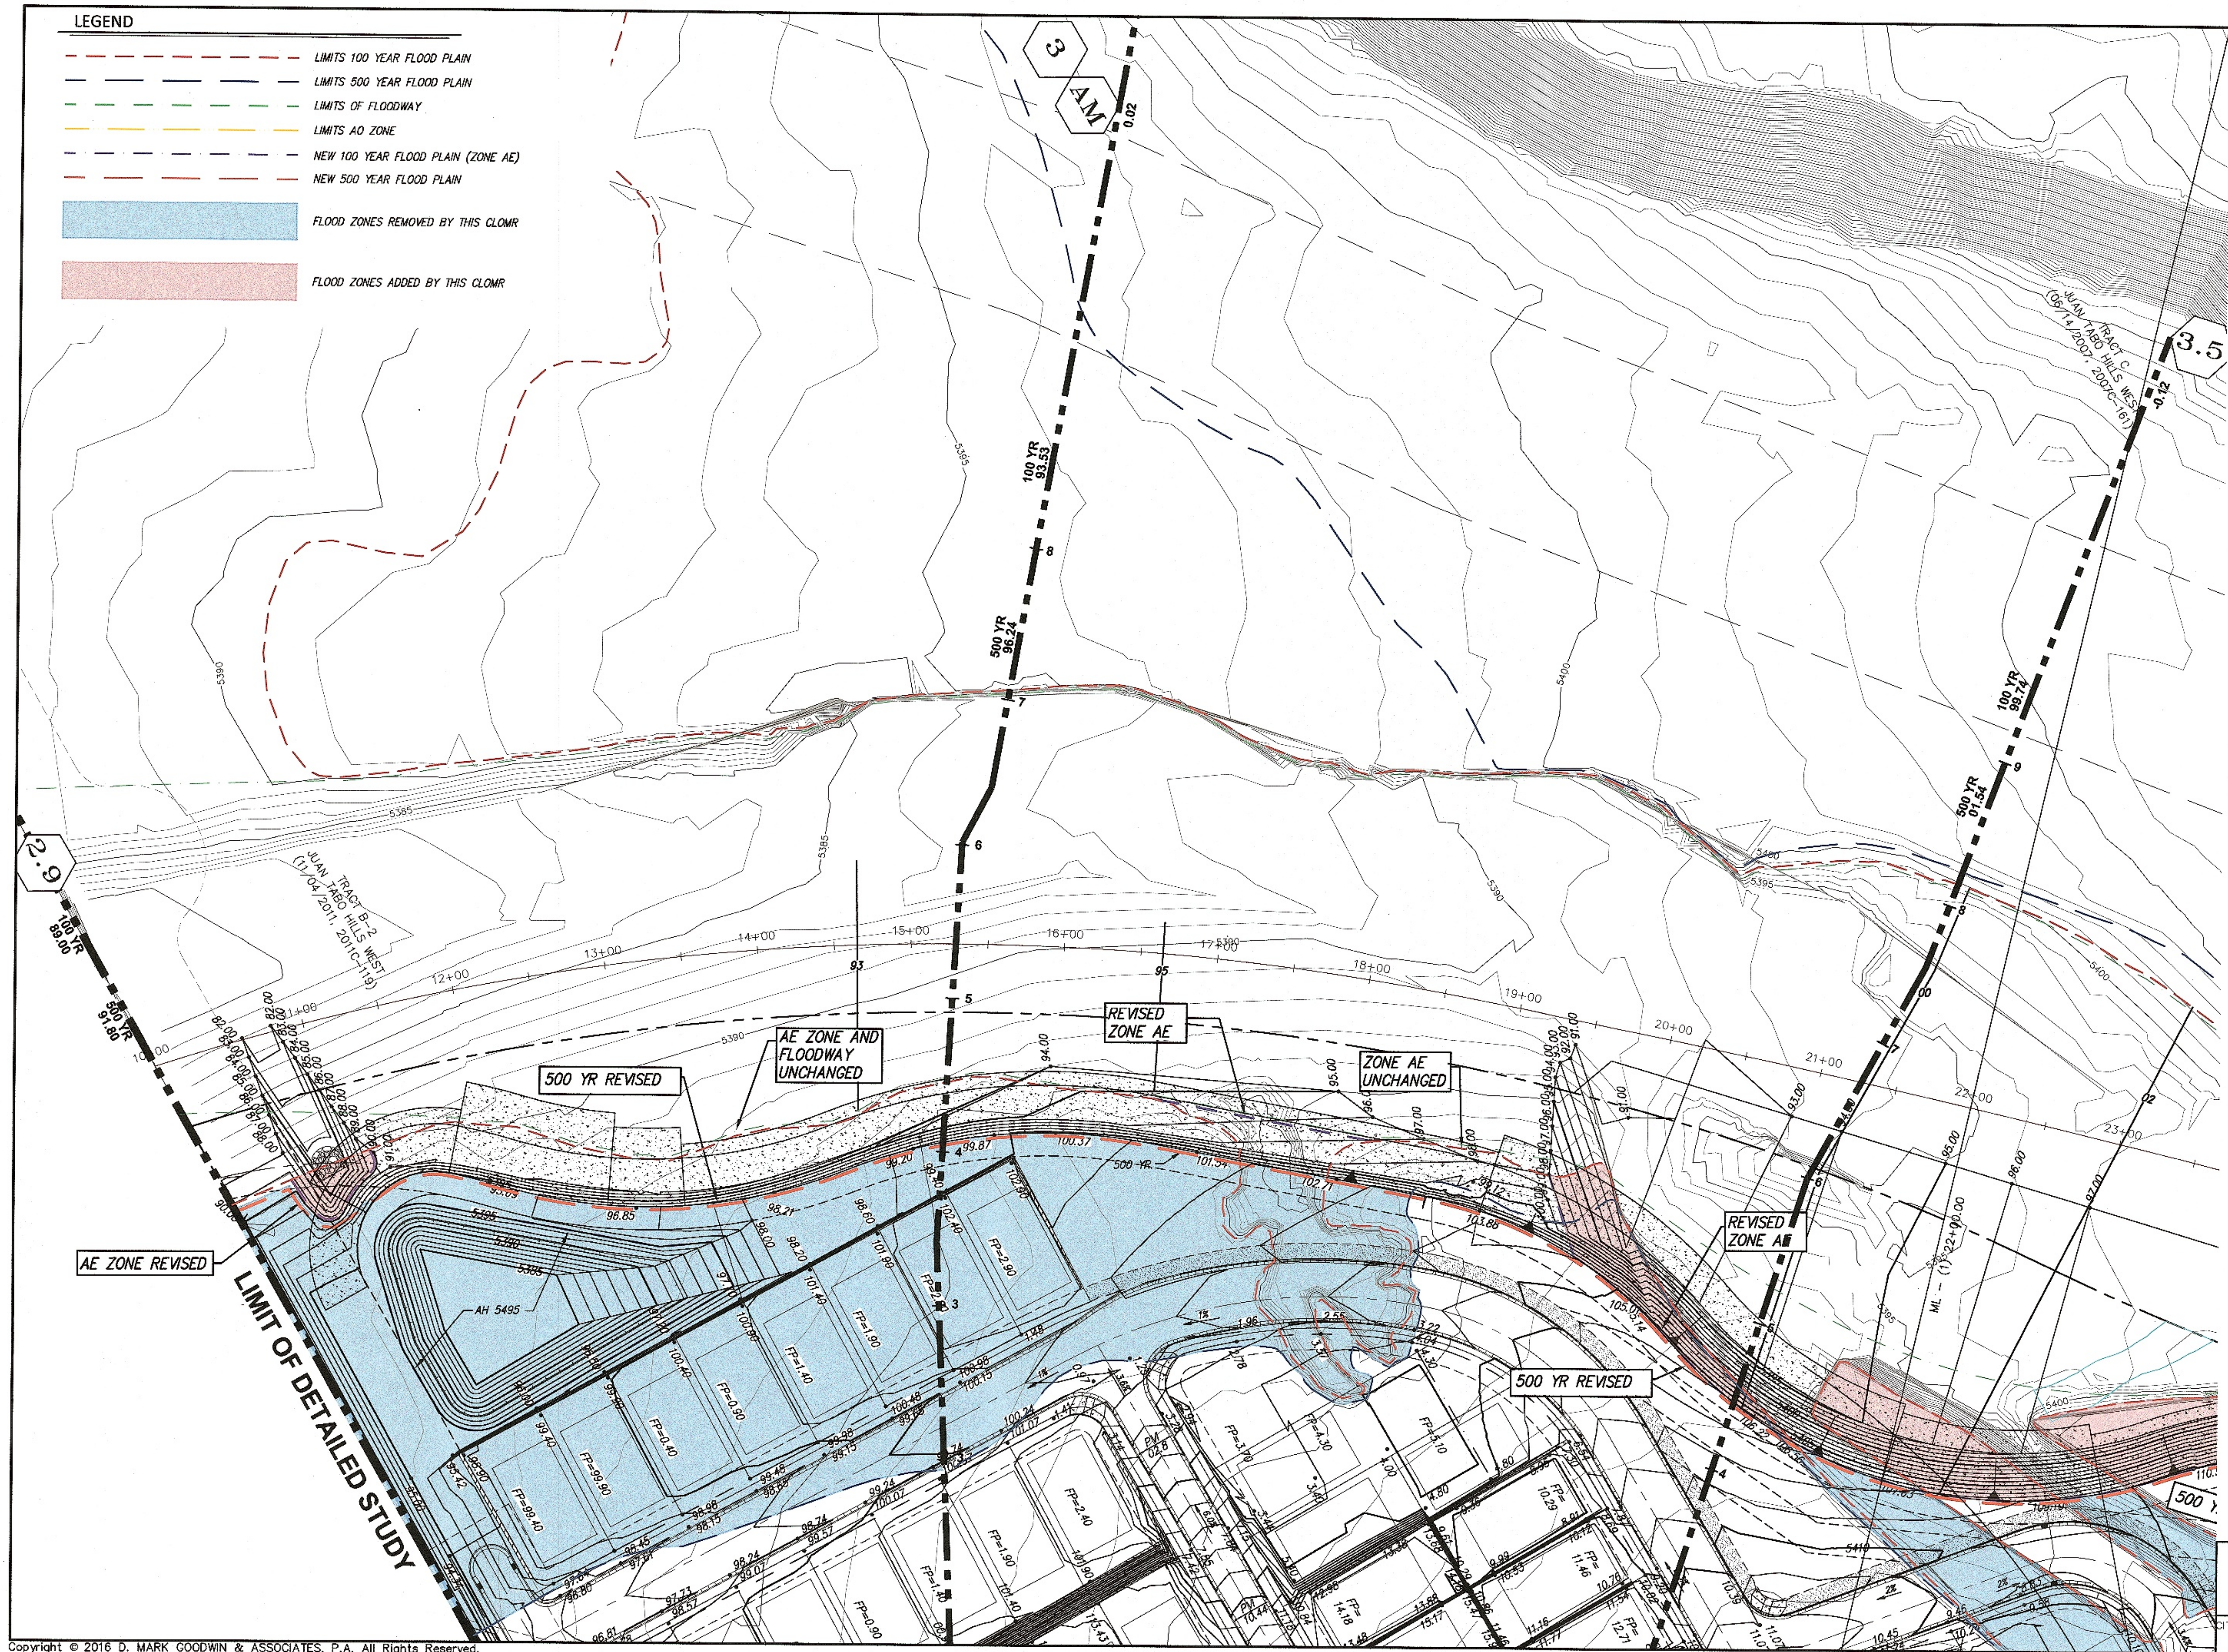


Copyright © 2016 D. MARK GOODWIN & ASSOCIATES, P.A. All Rights Reserved.

THE CONTOURS AND SPOT ELEVATIONS SHOWN ON SHEETS 1-5 IS BASED ON NAVD 1988. THE CONTOURS AND SPOT ELEVATIONS ON SHEETS 6 & 7 IS BASED ON NGVD 1929, AND MAY BE CONVERTED TO NAVD 88 BY ADDING 2.7'.


I, JAMES D. HUGHES DO HEREBY CERTIFY THAT NO STRUCTURES ARE LOCATED IN AREAS THAT WOULD BE IMPACTED BY THE INCREASED BFES BECAUSE OF THESE TWO PROJECTS. (JUAN TABO HILLS AND JUAN TABO HILLS SUBDIVISION, UNIT 3B)

JAMES D. HUGHES
8-30-2016

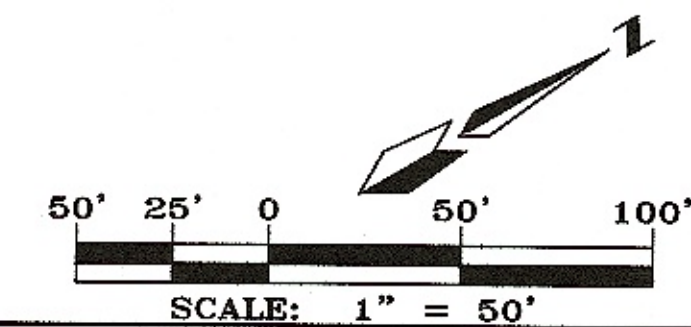

dmg MARK GOODWIN & ASSOCIATES, P.A.
CONSULTING ENGINEERS
P.O. BOX 90606
ALBUQUERQUE, NEW MEXICO 87199
OFFICE (505) 828-2200, FAX (505) 797-9539


CITY PROJECT NO.	ZONE MAP NO.	SHEET	OF
	M-21-Z	1	7

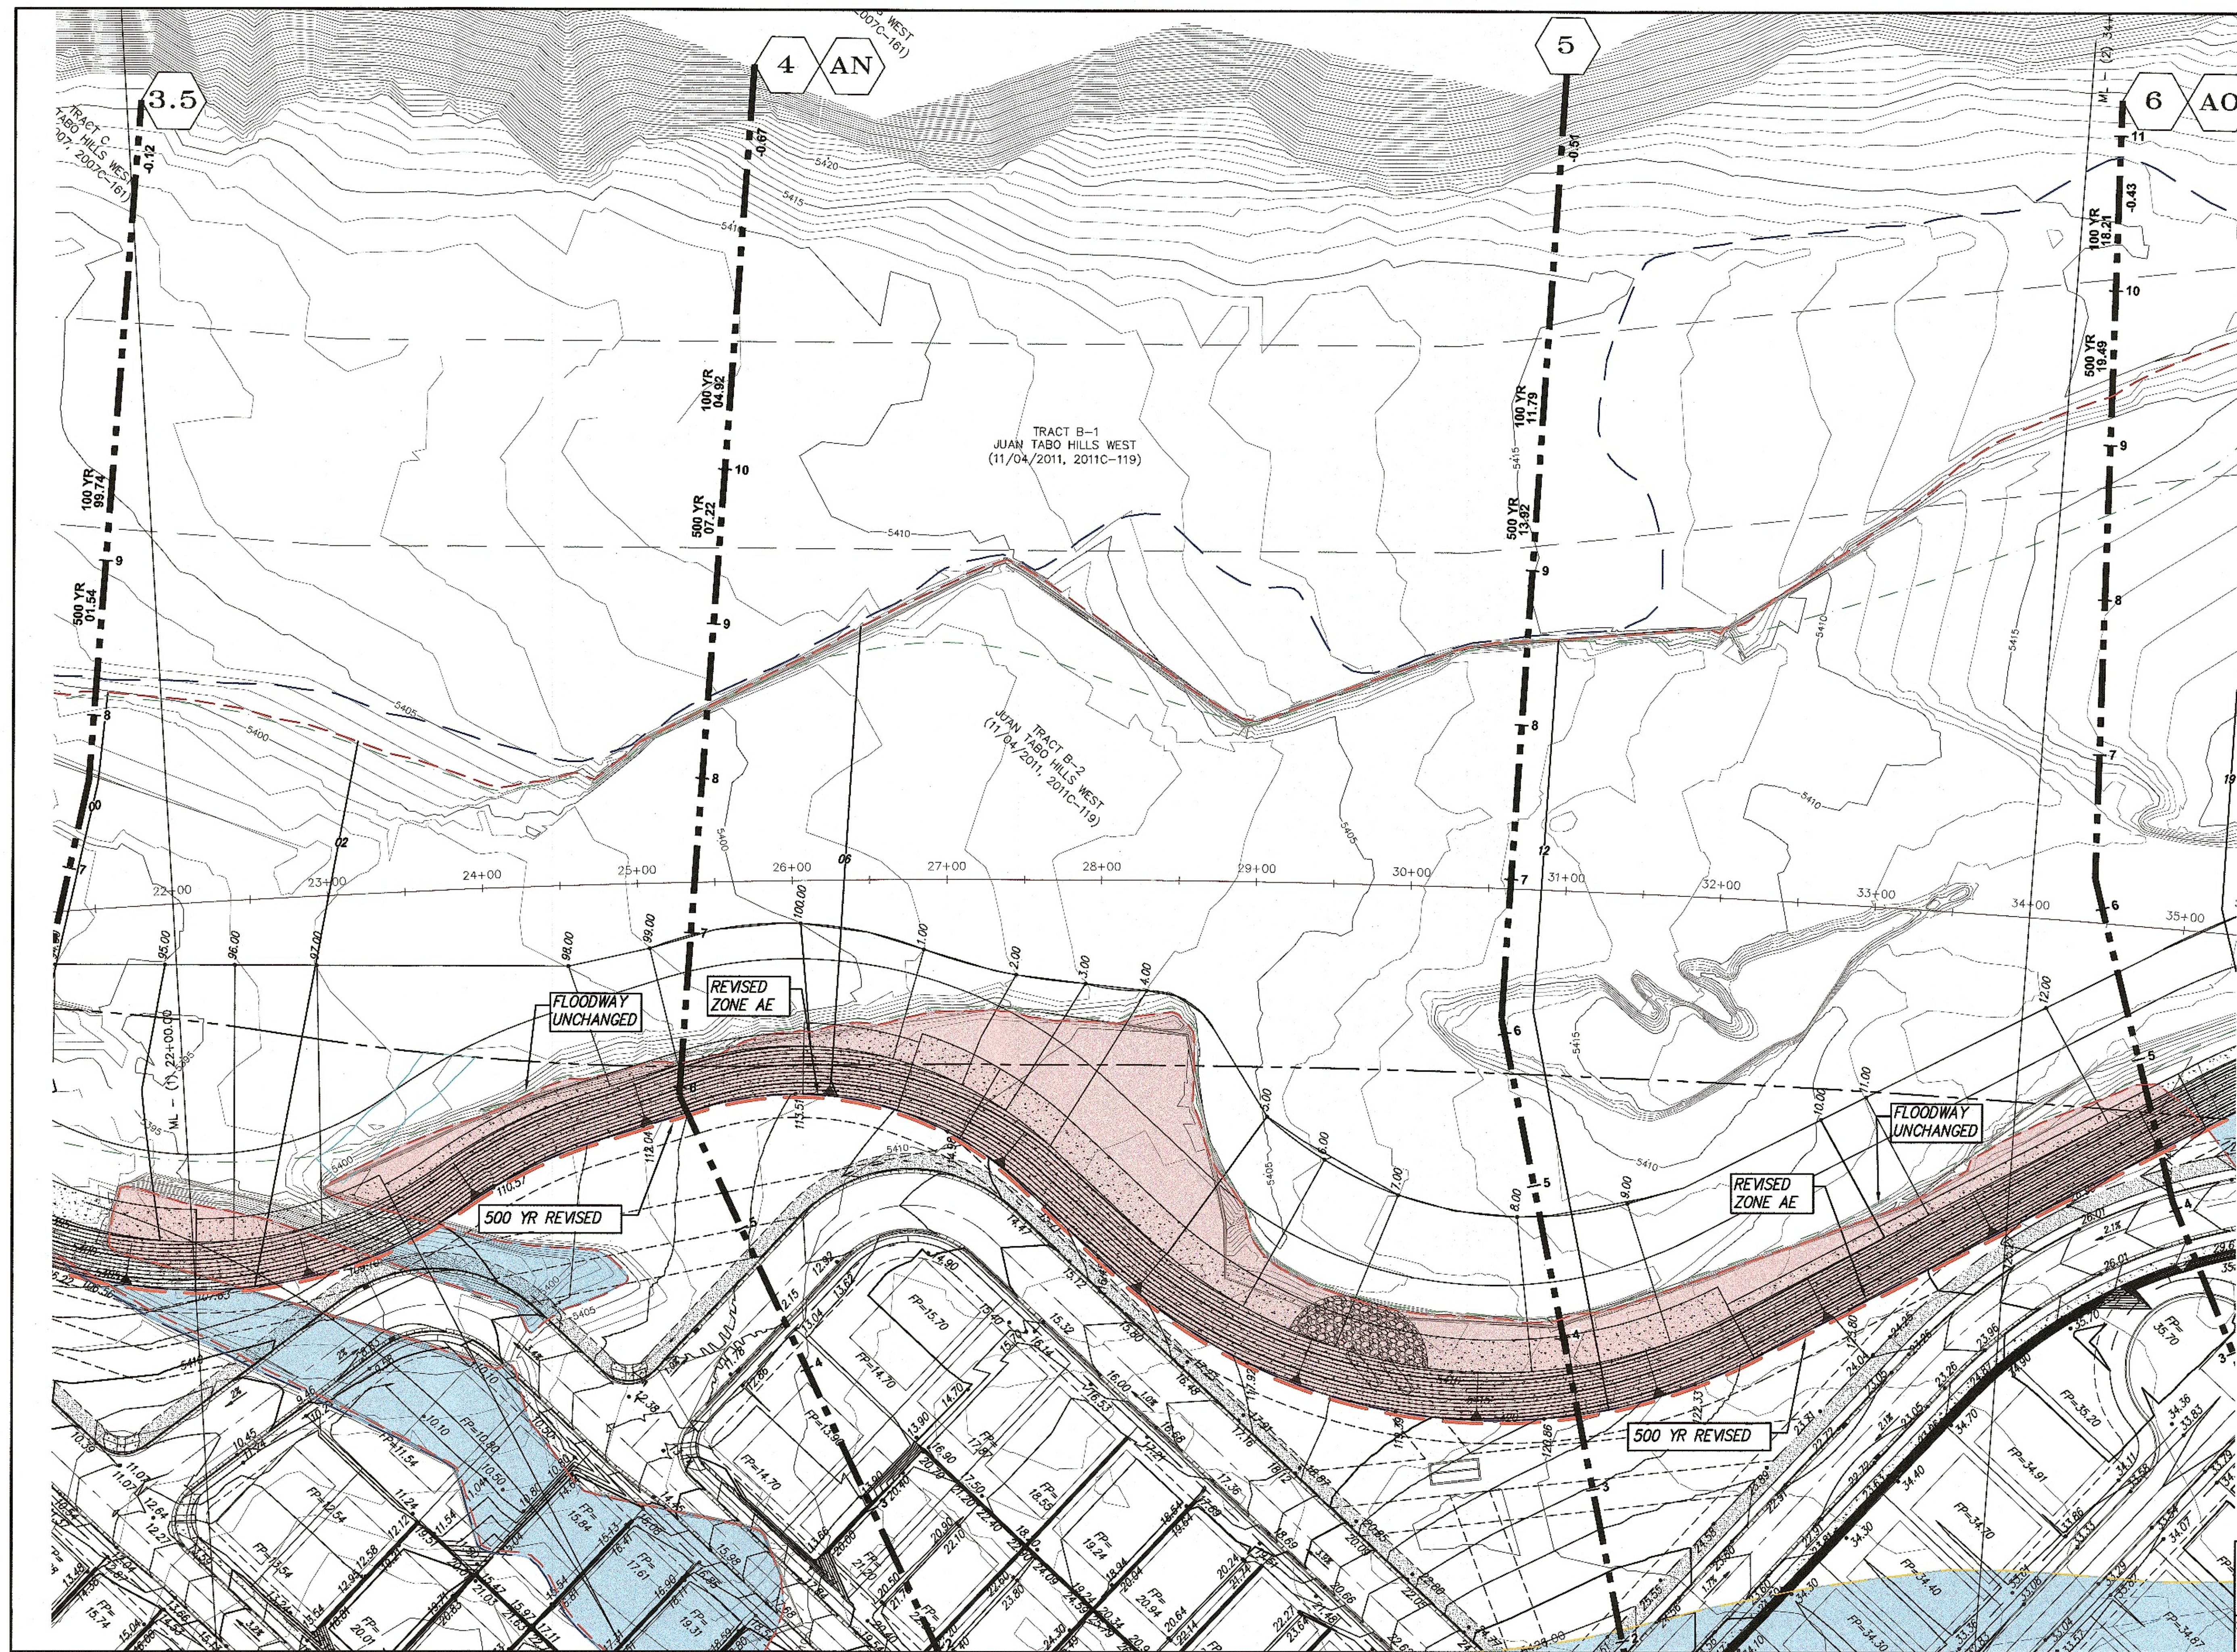

THE CONTOURS AND SPOT ELEVATIONS SHOWN ON SHEETS 1 - 5
IS BASED ON NAVD 1988. THE CONTOURS AND SPOT ELEVATIONS
ON SHEETS 6 & 7 IS BASED ON NGVD 1929, AND MAY BE
CONVERTED TO NAVD 88 BY ADDING 2.7'.


I, JAMES D. HUGHES DO HEREBY CERTIFY THAT NO STRUCTURES ARE LOCATED IN AREAS THAT WOULD BE IMPACTED BY THE INCREASED BFEs BECAUSE OF THESE TWO PROJECTS. (JUAN TABO HILLS AND JUAN TABO HILLS SUBDIVISION, UNIT 3B)

[illegible]

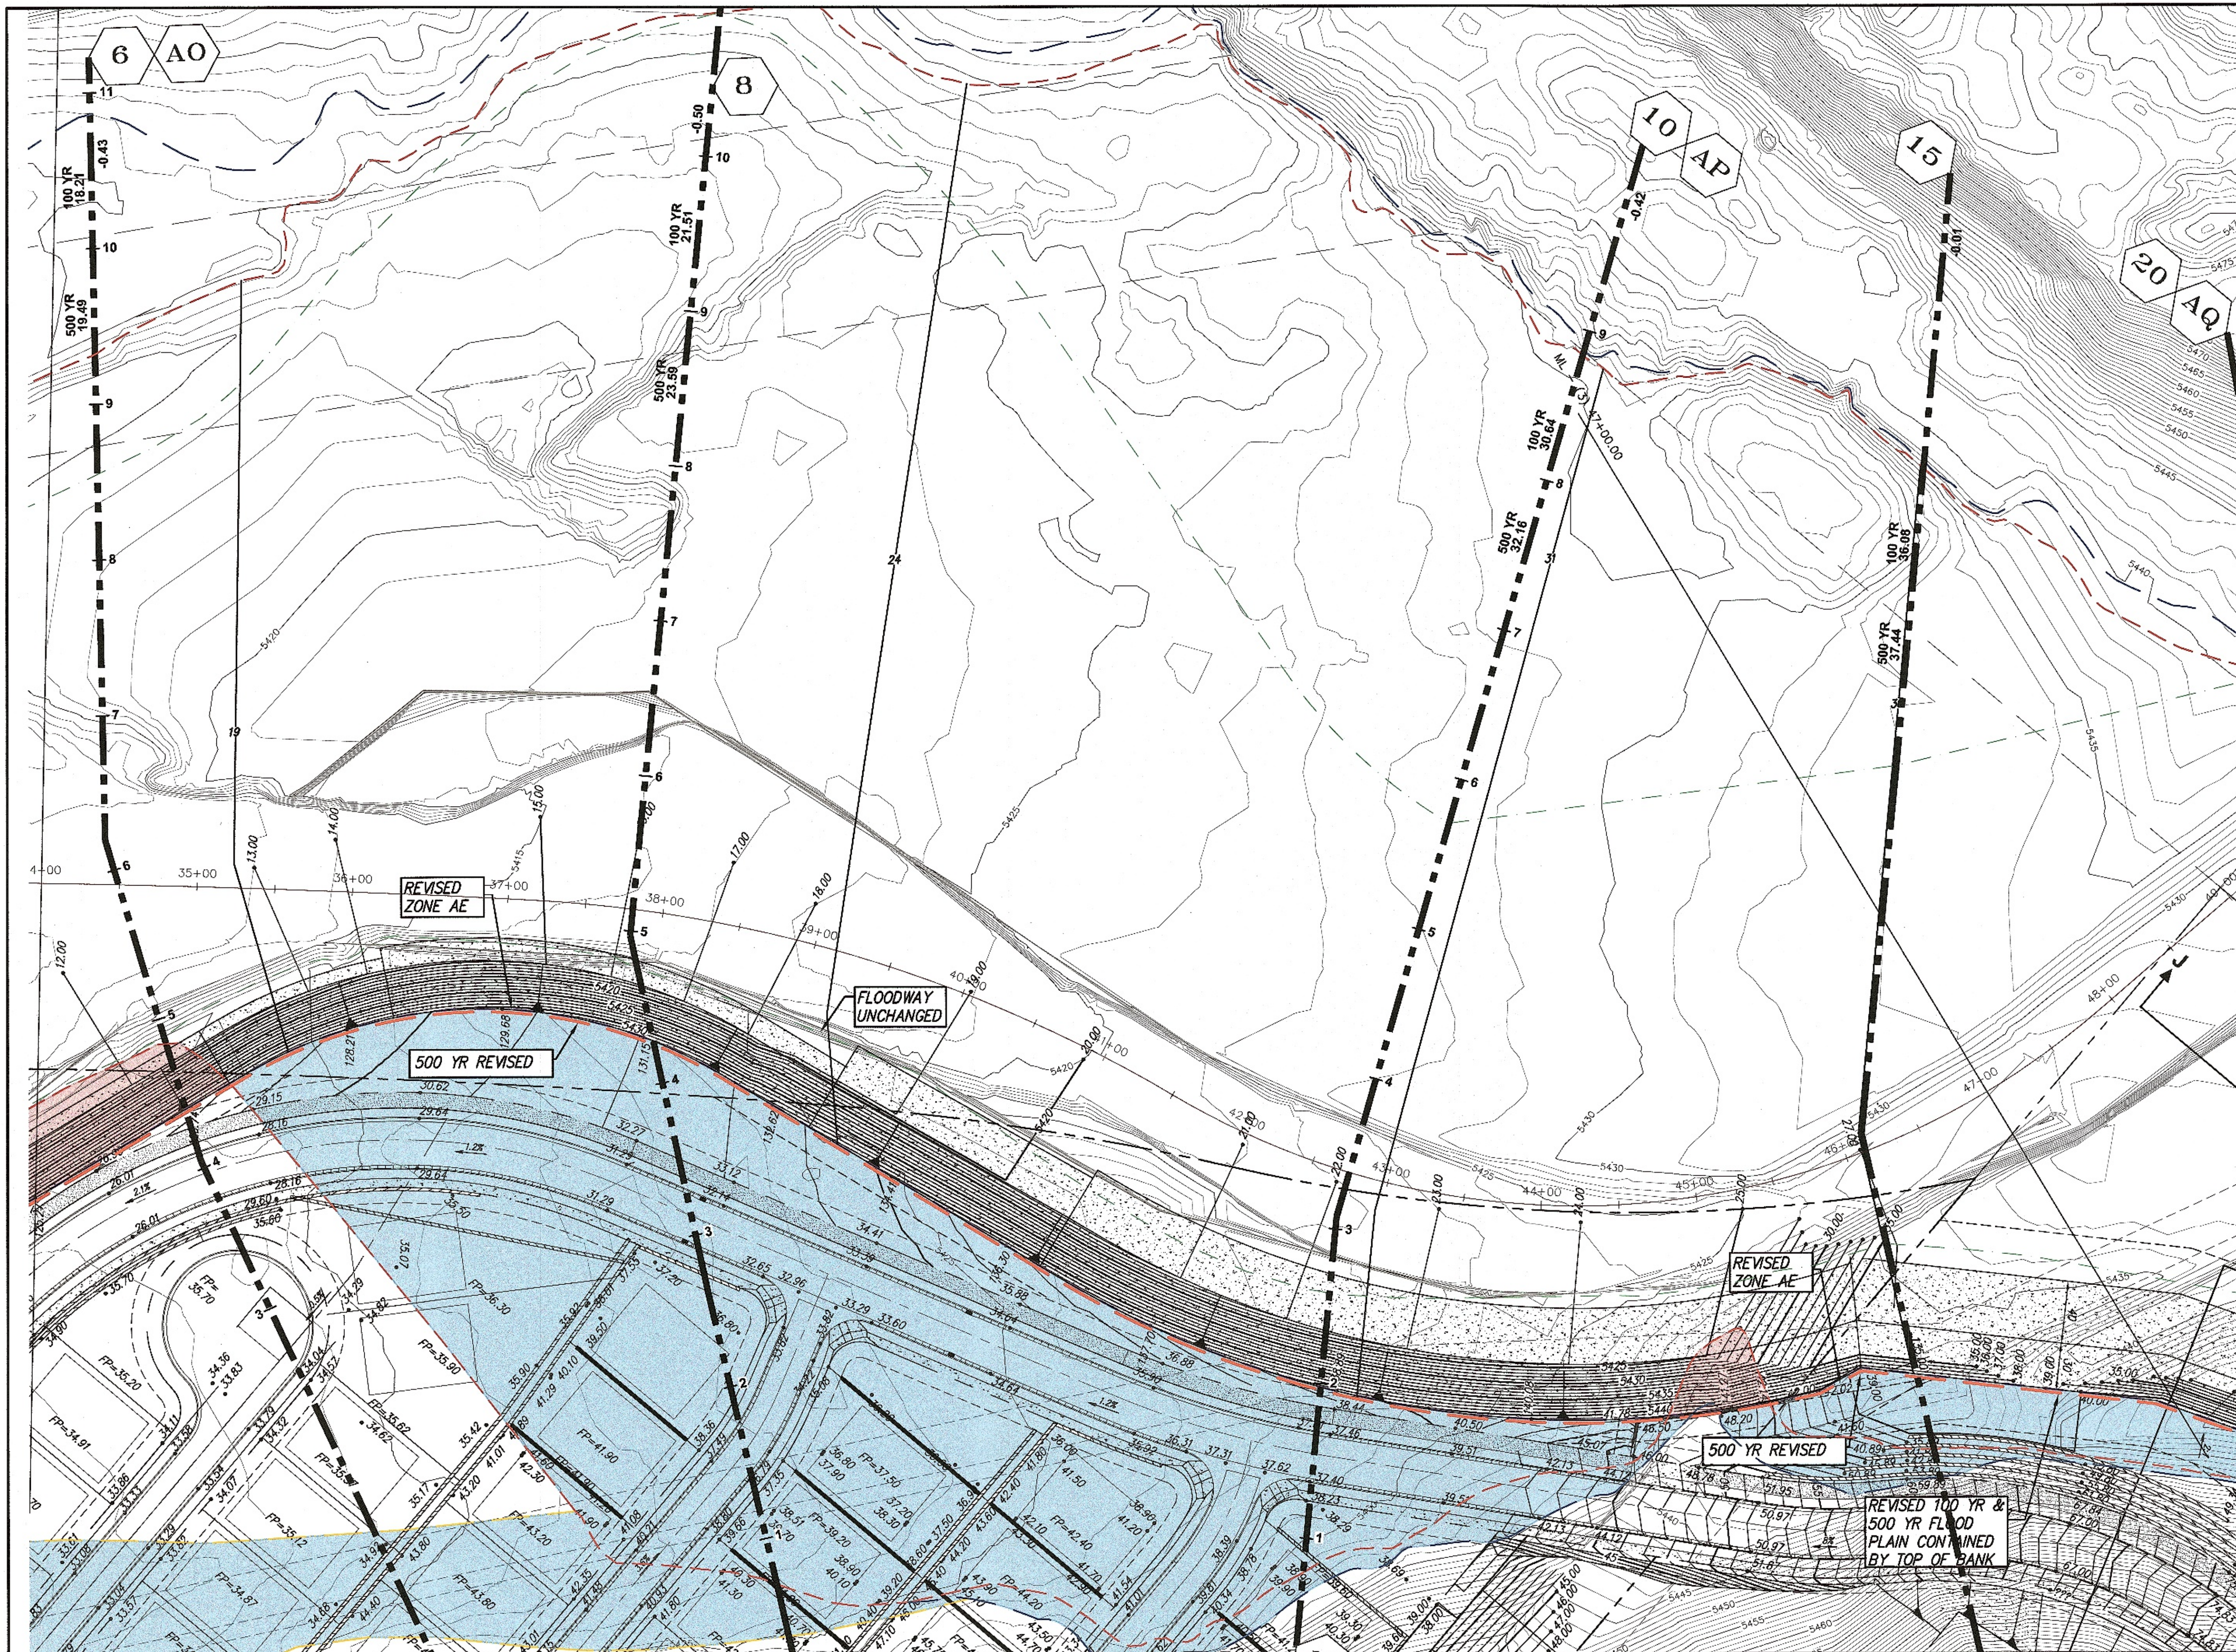


THE CONTOURS AND SPOT ELEVATIONS SHOWN ON SHEETS 1-5
IS BASED ON NAVD 1988. THE CONTOURS AND SPOT ELEVATIONS
ON SHEETS 6 & 7 IS BASED ON NGVD 1929, AND MAY BE
CONVERTED TO NAVD 88 BY ADDING 2.7'.

I, JAMES D. HUGHES DO HEREBY CERTIFY THAT NO STRUCTURES
ARE LOCATED IN AREAS THAT WOULD BE IMPACTED BY THE
INCREASED BFEs BECAUSE OF THESE TWO PROJECTS. (JUAN
TABO HILLS AND JUAN TABO HILLS SUBDIVISION, UNIT 3B)
James D. Hughes
JAMES D. HUGHES
DATE 9-30-2016

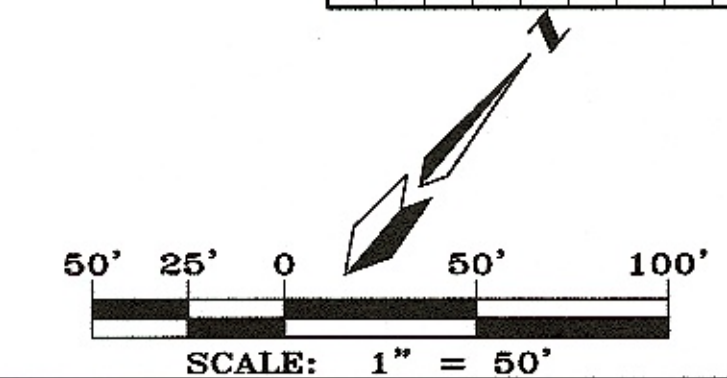

dmg MARK GOODWIN & ASSOCIATES, P.A.
CONSULTING ENGINEERS
P.O. BOX 90508
ALBUQUERQUE, NEW MEXICO 87199
OFFICE (505) 828-2200, FAX (505) 797-9539
CITY PROJECT NO. ZONE MAP NO. SHEET OF
M-21-Z 3 7


ENGINEER'S SEAL		SURVEY INFORMATION		BENCH MARKS		AS BUILT INFORMATION	
 JAMES D. HUGHES REGISTERED PROFESSIONAL ENGINEER STATE OF NEW MEXICO No. 14562 Exp. 12/31/2018	FIELD NOTES		STATION "5-422" IS LOCATED 8.7 MI. SE OF DOWNTOWN ALBUQUERQUE ON THE EAST SIDE OF THE MUNICIPAL LIMITS LINE IN THE FOUR HILLS SUBDIVISION AREA. STATION IS 600 FT. EAST OF MUNICIPAL LIMITS LINE. 77.9' SE OF POWER POLE #357 & 196.0' NW OF POWER POLE #60. STATION IS A STANDARD ACS BRASS DISK SET IN A CONCRETE MONUMENT IN THE GROUND. STATION IS STAMPED "5-422". X= 1,564,263.207, Y= 1,475,762.595, (NAD 83), Z= 5507.219 (NAVD 1988).		CONTRACTOR		
	NO.	DATE	WORK RECORDED BY		DATE		
	BY		INSPECTOR'S FIELD OPTIMANCE BY		DATE		
	REMARKS	BY	VERIFICATION BY		DATE		
	REVISIONS		DATE CORRECTED BY		DATE		
	DESIGN		MICRO-FILM INFORMATION		DATE		
	DESIGNED BY	DATE	RECORDED BY		DATE		
	DRAWN BY	DATE	NO.		NO.		
	CHECKED BY	DATE					
	DMG	06/14					
	ACH	06/14					
	IDH	06/14					

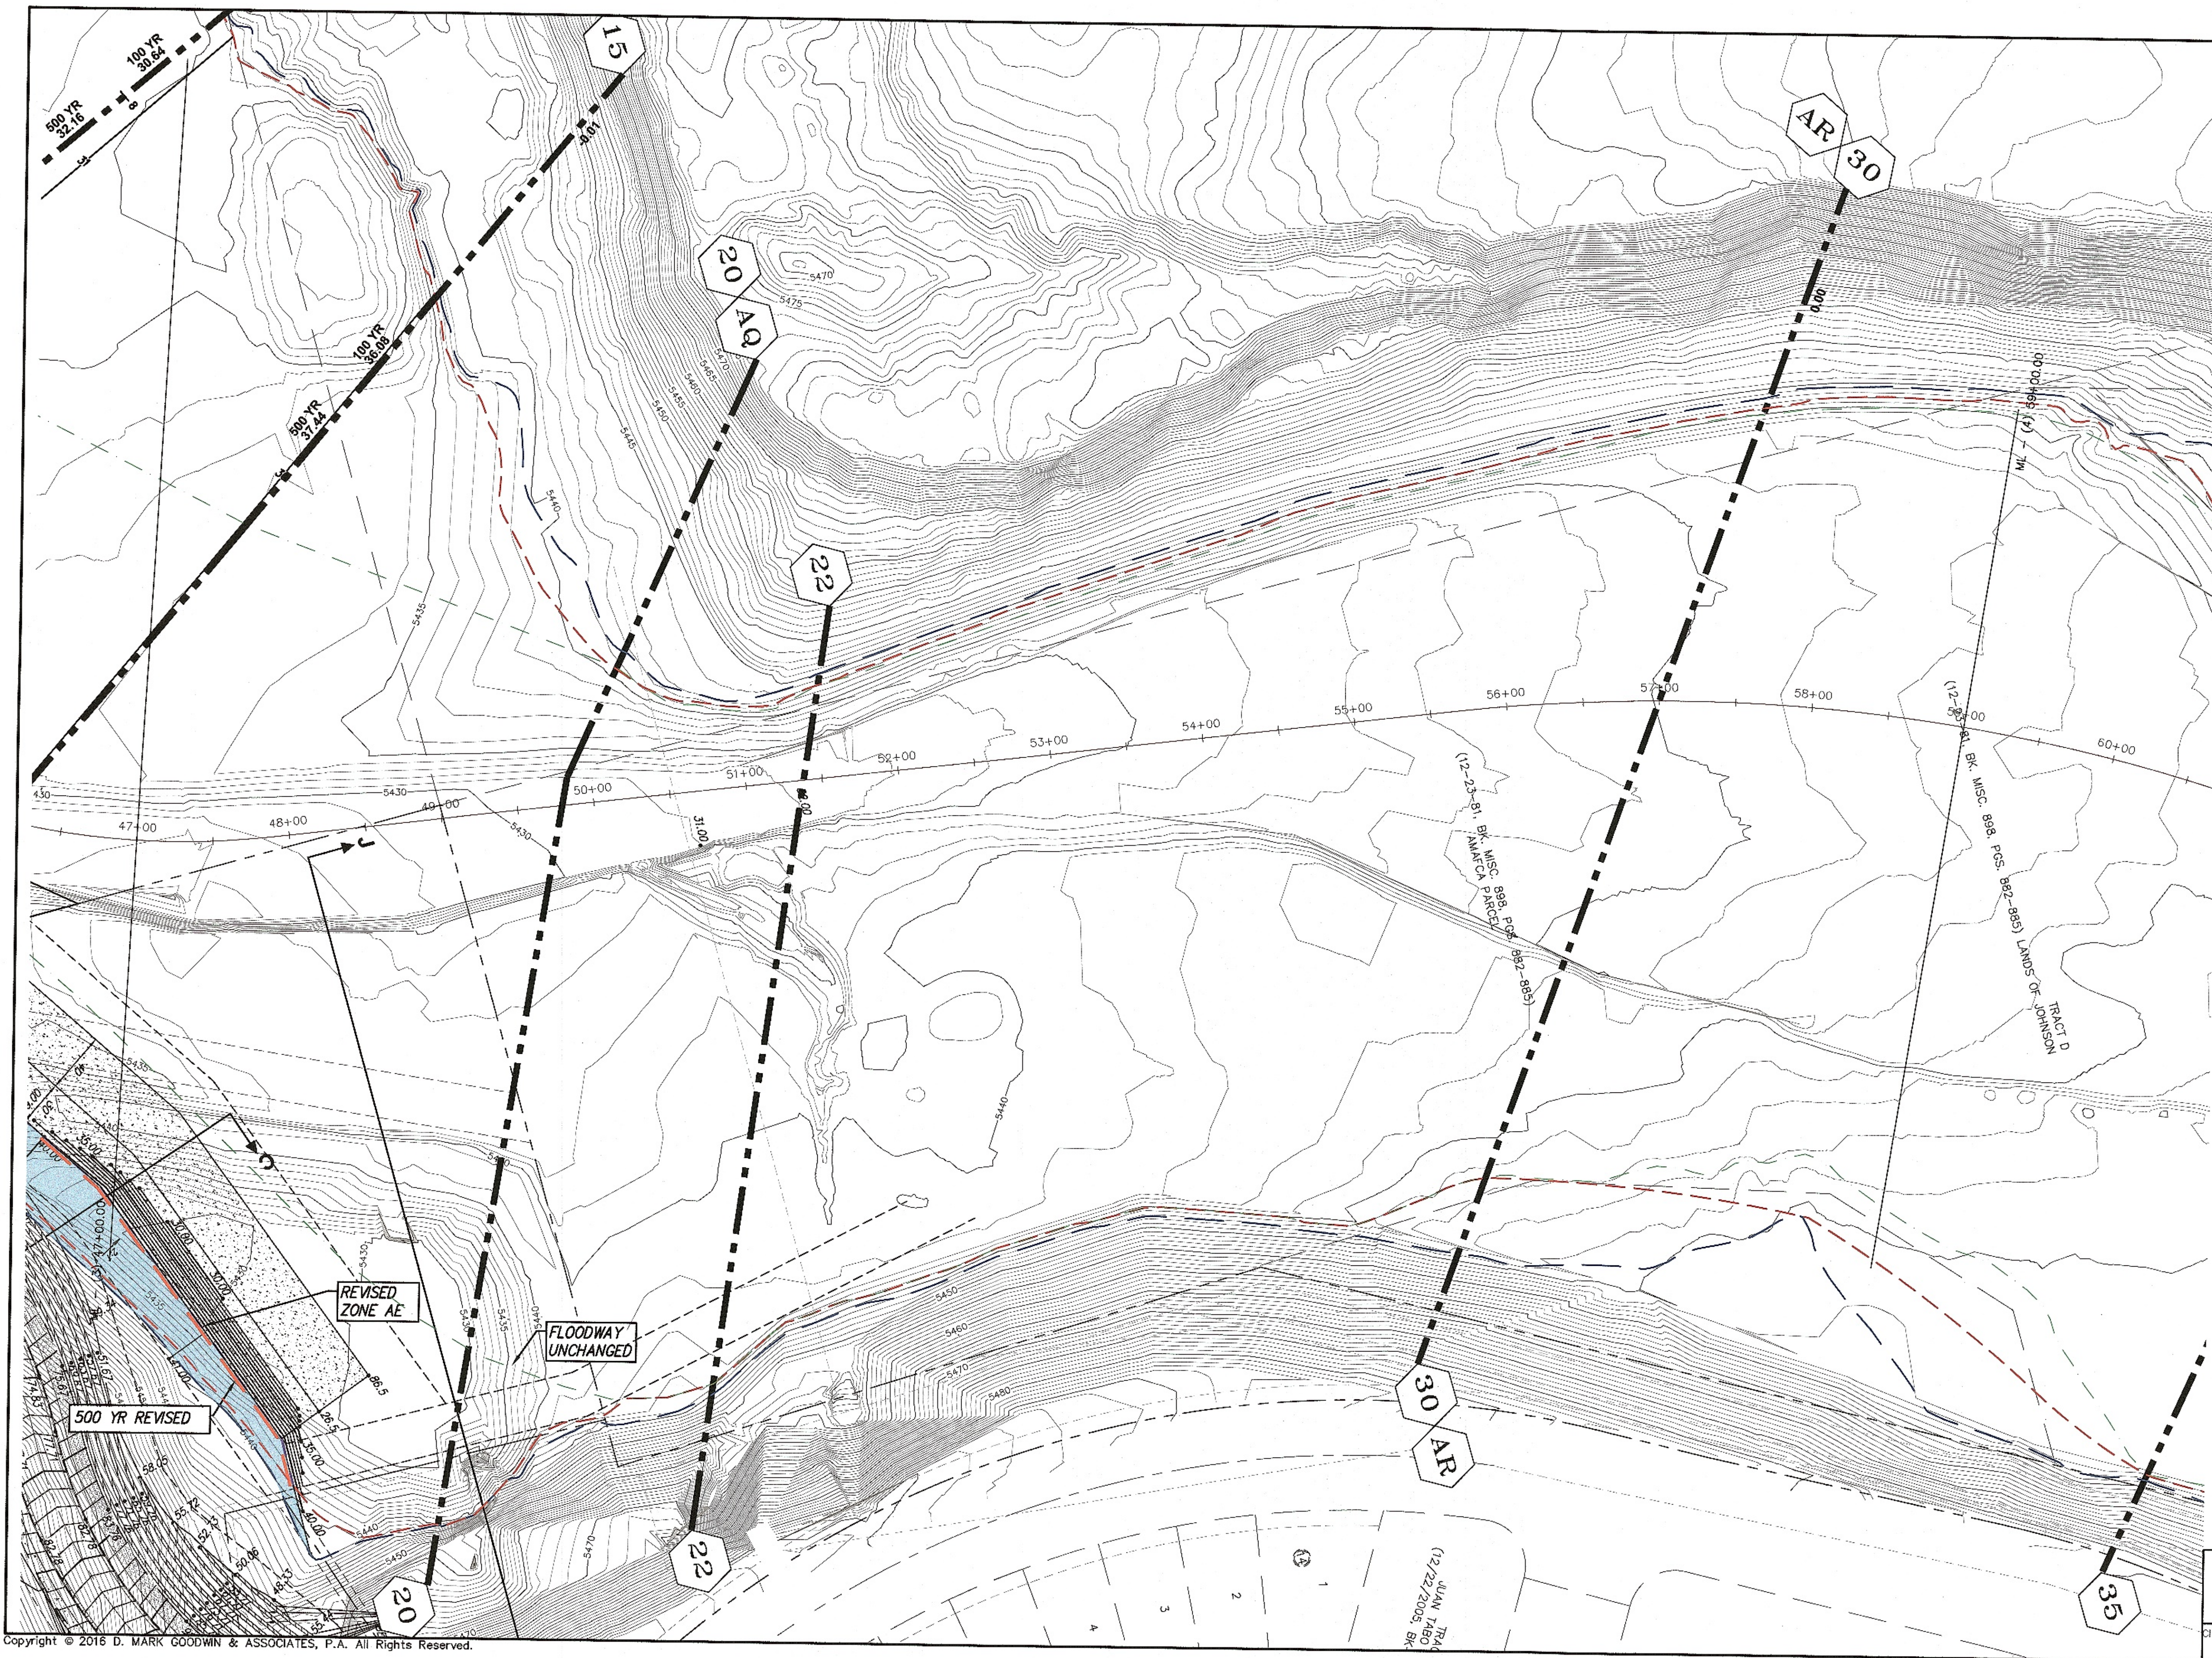

I, JAMES D. HUGHES DO HEREBY CERTIFY THAT NO STRUCTURES ARE LOCATED IN AREAS THAT WOULD BE IMPACTED BY THE INCREASED BFEs BECAUSE OF THESE TWO PROJECTS. (JUAN TABO HILLS AND JUAN TABO HILLS SUBDIVISION, UNIT 3B)

James D. Hughes
JAMES D. HUGHES
DATE 9-30-2016

THE CONTOURS AND SPOT ELEVATIONS SHOWN ON SHEETS 1-5 IS BASED ON NAVD 1988. THE CONTOURS AND SPOT ELEVATIONS ON SHEETS 6 & 7 IS BASED ON NGVD 1929, AND MAY BE CONVERTED TO NAVD 88 BY ADDING 2.7.

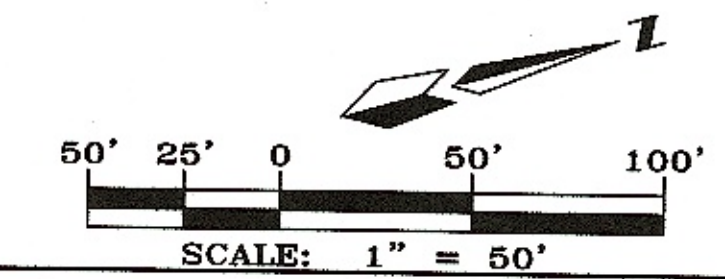

dmg MARK GOODWIN & ASSOCIATES, P.A.
CONSULTING ENGINEERS
P.O. BOX 90806
ALBUQUERQUE, NEW MEXICO 87199
OFFICE (505) 828-2200, FAX (505) 797-9639

CITY PROJECT NO. ZONE MAP NO. SHEET OF
M-21-Z 4 7

SURVEY INFORMATION		BENCH MARKS		AS BUILT INFORMATION	
ENGINEER'S SEAL	DATE	STATION	CONTRACTOR	WORK	DATE
JAMES D. HUGHES	9-30-2016	STATION 5+422.7 IS LOCATED 8.7 M. SE OF DOWNTOWN ALBUQUERQUE ON THE EAST SIDE OF THE MUNICIPAL LIMITS LINE IN THE FOUR HILLS SUBDIVISION AREA. STATION IS 600 FT. EAST OF MUNICIPAL LIMITS LINE. 71.8' SE OF POWER POLE #327 & 168.0' NW OF POWER POLE #60. STATION IS A STANDARD ACS BRASS DISK SET IN A CONCRETE MONUMENT IN THE GROUND. STATION IS STAMPED "5-422.7". X= 1,594,263.207, Y= 1,475,762.595, (NAD 83), Z= 5597.219 (NAVD 1988).	CONTRACTOR	WORK	DATE
NO.	BY	DATE	STATION	CONTRACTOR	DATE
DESIGNED BY	REVISIONS	DATE	STATION	CONTRACTOR	DATE
DRAWN BY	REVISIONS	DATE	STATION	CONTRACTOR	DATE
CHECKED BY	REVISIONS	DATE	STATION	CONTRACTOR	DATE




THE CONTOURS AND SPOT ELEVATIONS SHOWN ON SHEETS 1 - 5
IS BASED ON NAVD 1988. THE CONTOURS AND SPOT ELEVATIONS
ON SHEETS 6 & 7 IS BASED ON NGVD 1929, AND MAY BE
CONVERTED TO NAVD 88 BY ADDING 2.7".

I, JAMES D. HUGHES DO HEREBY CERTIFY THAT NO STRUCTURES ARE LOCATED IN AREAS THAT WOULD BE IMPACTED BY THE INCREASED BPS BECAUSE OF THESE TWO PROJECTS, (JUAN TABO HILLS AND JUAN TABO HILLS SUBDIVISION, UNIT 3B)

James D. Hughes 8-30-2016

[illegible]

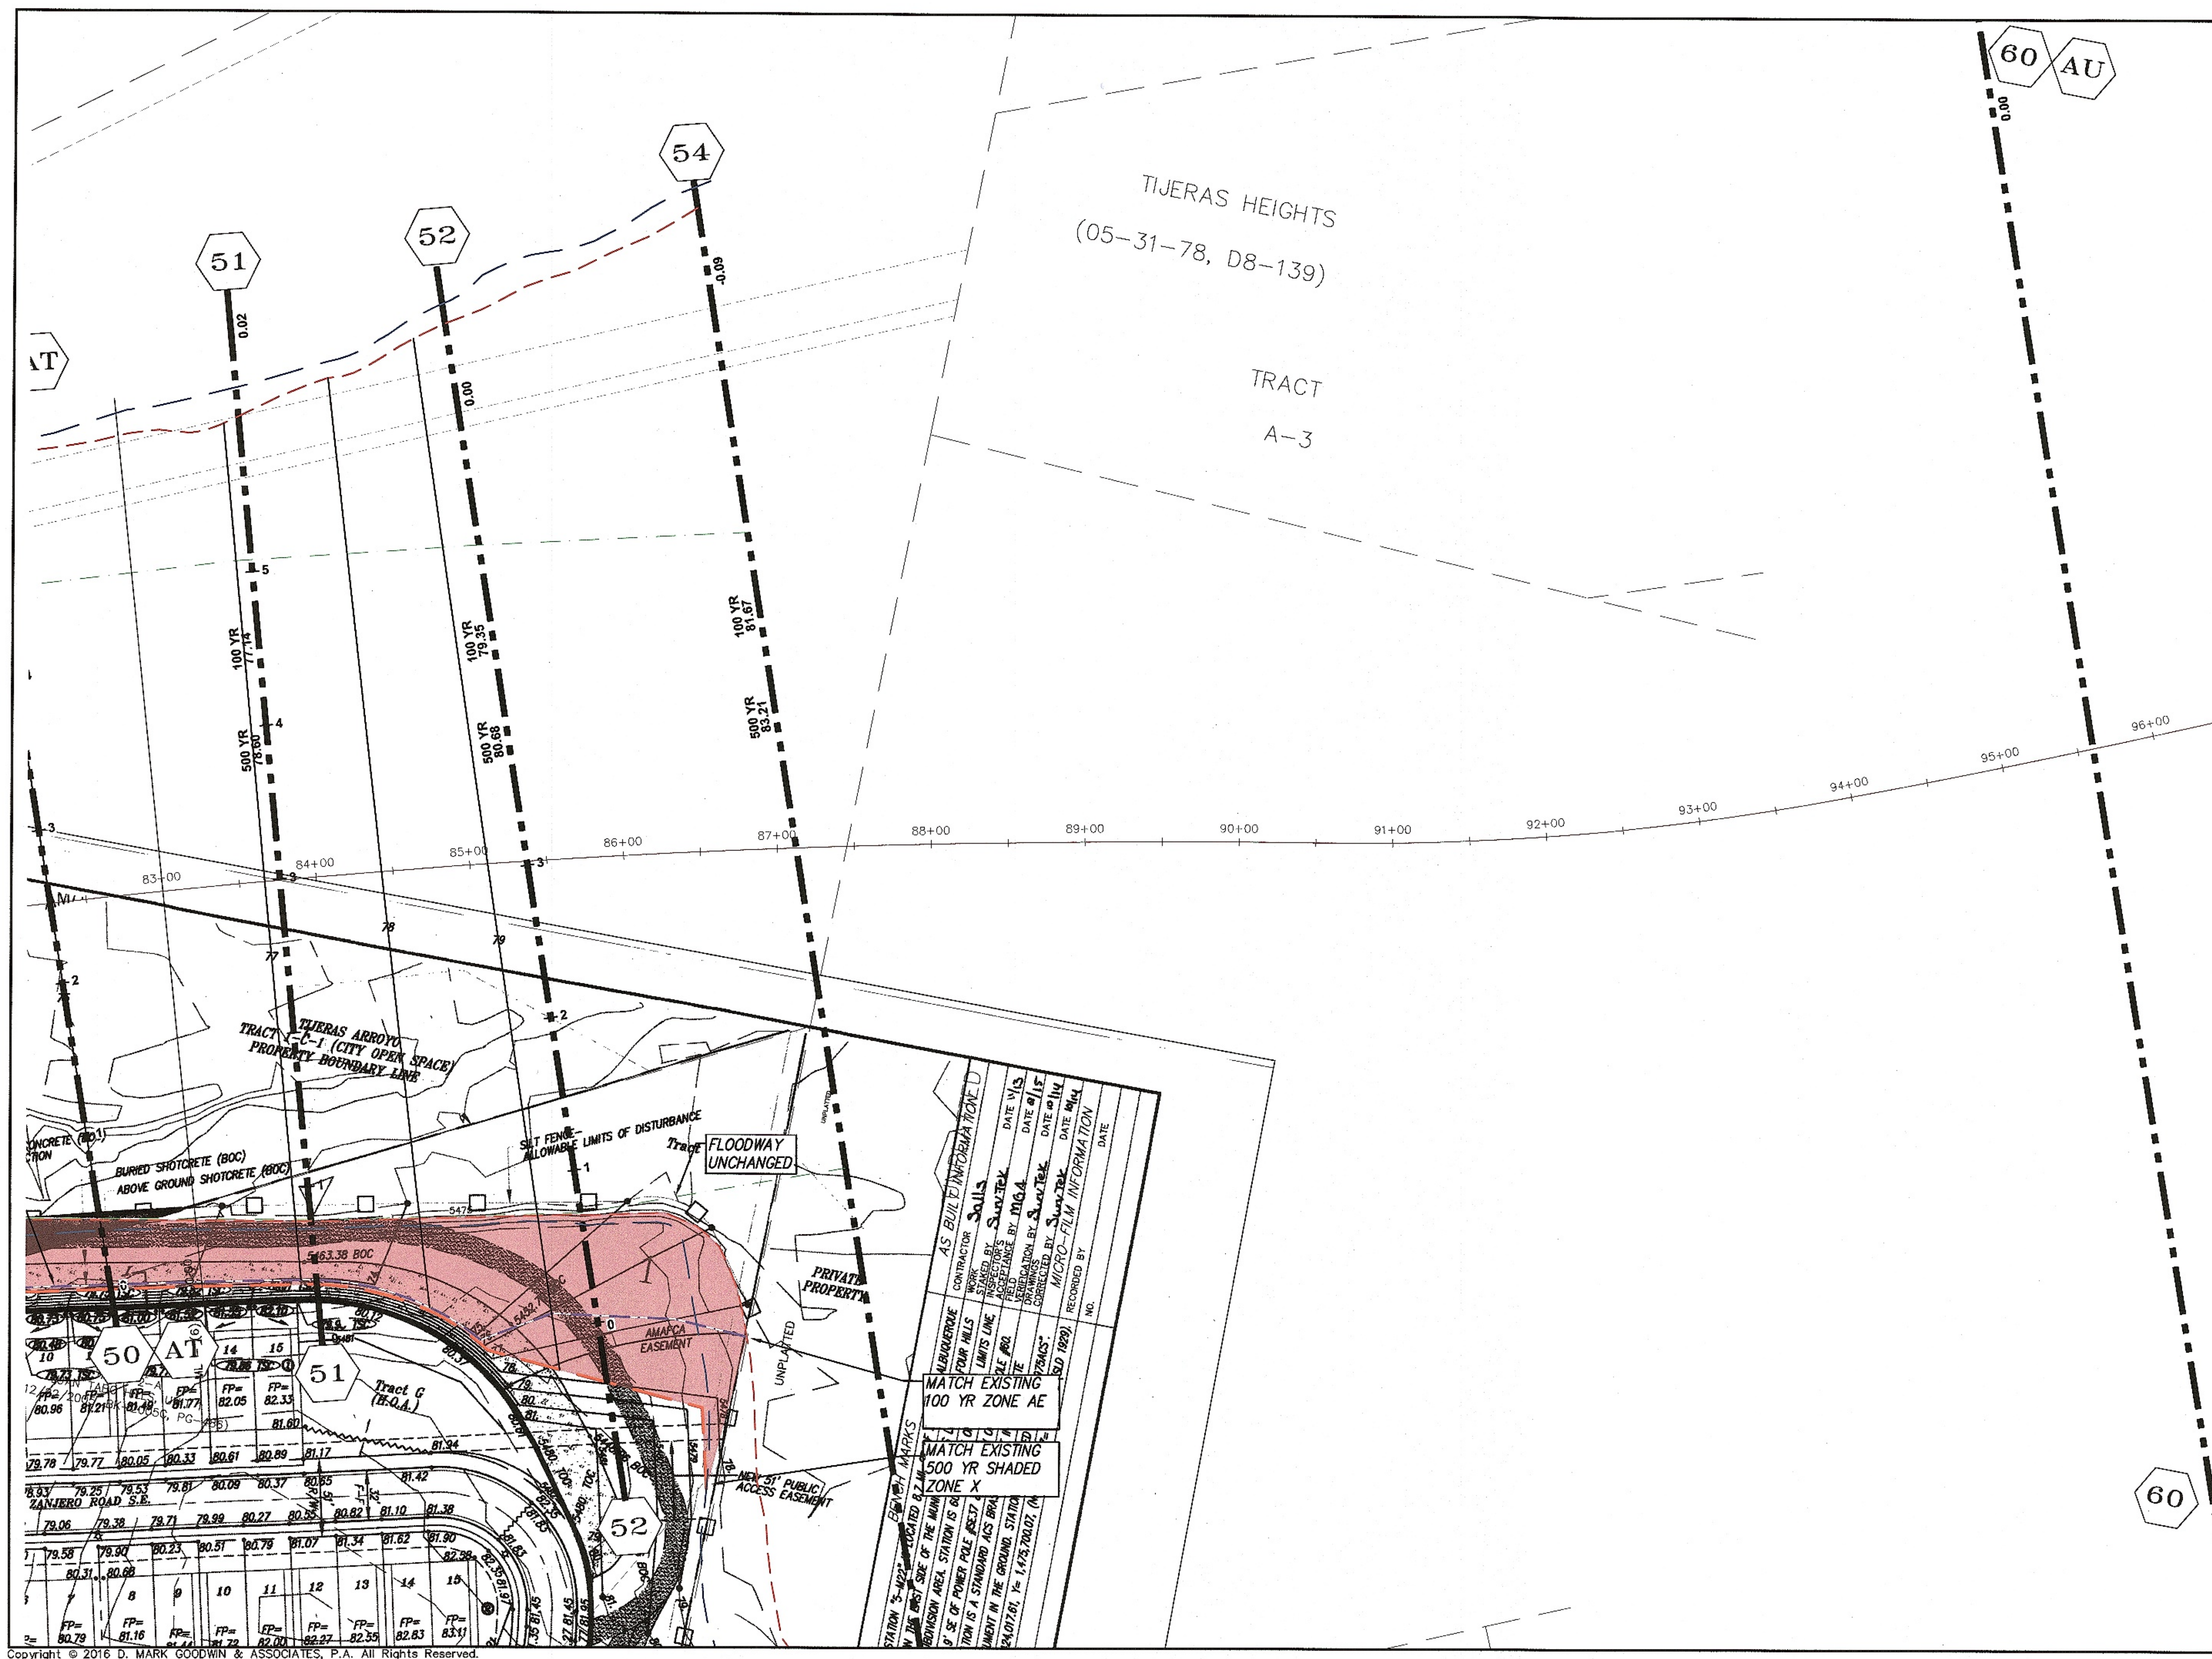

THE CONTOURS AND SPOT ELEVATIONS SHOWN ON SHEETS 1 - 5 IS BASED ON NAVD 1988. THE CONTOURS AND SPOT ELEVATIONS ON SHEETS 6 & 7 IS BASED ON NGVD 1928, AND MAY BE CONVERTED TO NAVD 88 BY ADDING 2.7'.

I, JAMES D. HUGHES DO HEREBY CERTIFY THAT NO STRUCTURES ARE LOCATED IN AREAS THAT WOULD BE IMPACTED BY THE INCREASED BFEs BECAUSE OF THESE TWO PROJECTS. (JUAN TABO HILLS AND JUAN TABO HILLS SUBDIVISION, UNIT 3B)
James D. Hughes
JAMES D. HUGHES
DATE 8-30-2016

ENGINEER'S SEAL		SURVEY INFORMATION		AS BUILT INFORMATION	
		FIELD NOTES		CONTRACTOR	
		NO.	BY	DATE	WORK
		REVISIONS		DATE	
		DESIGN		DATE	
DESIGNED BY	JDH	DATE	06/14	RECORDED BY	
DRAWN BY	ACH	DATE	06/14	NO.	
CHECKED BY	DMG	DATE	06/14	DATE	
CITY PROJECT NO.		ZONE MAP NO.		SHEET OF	
M-21-2		7		7	