



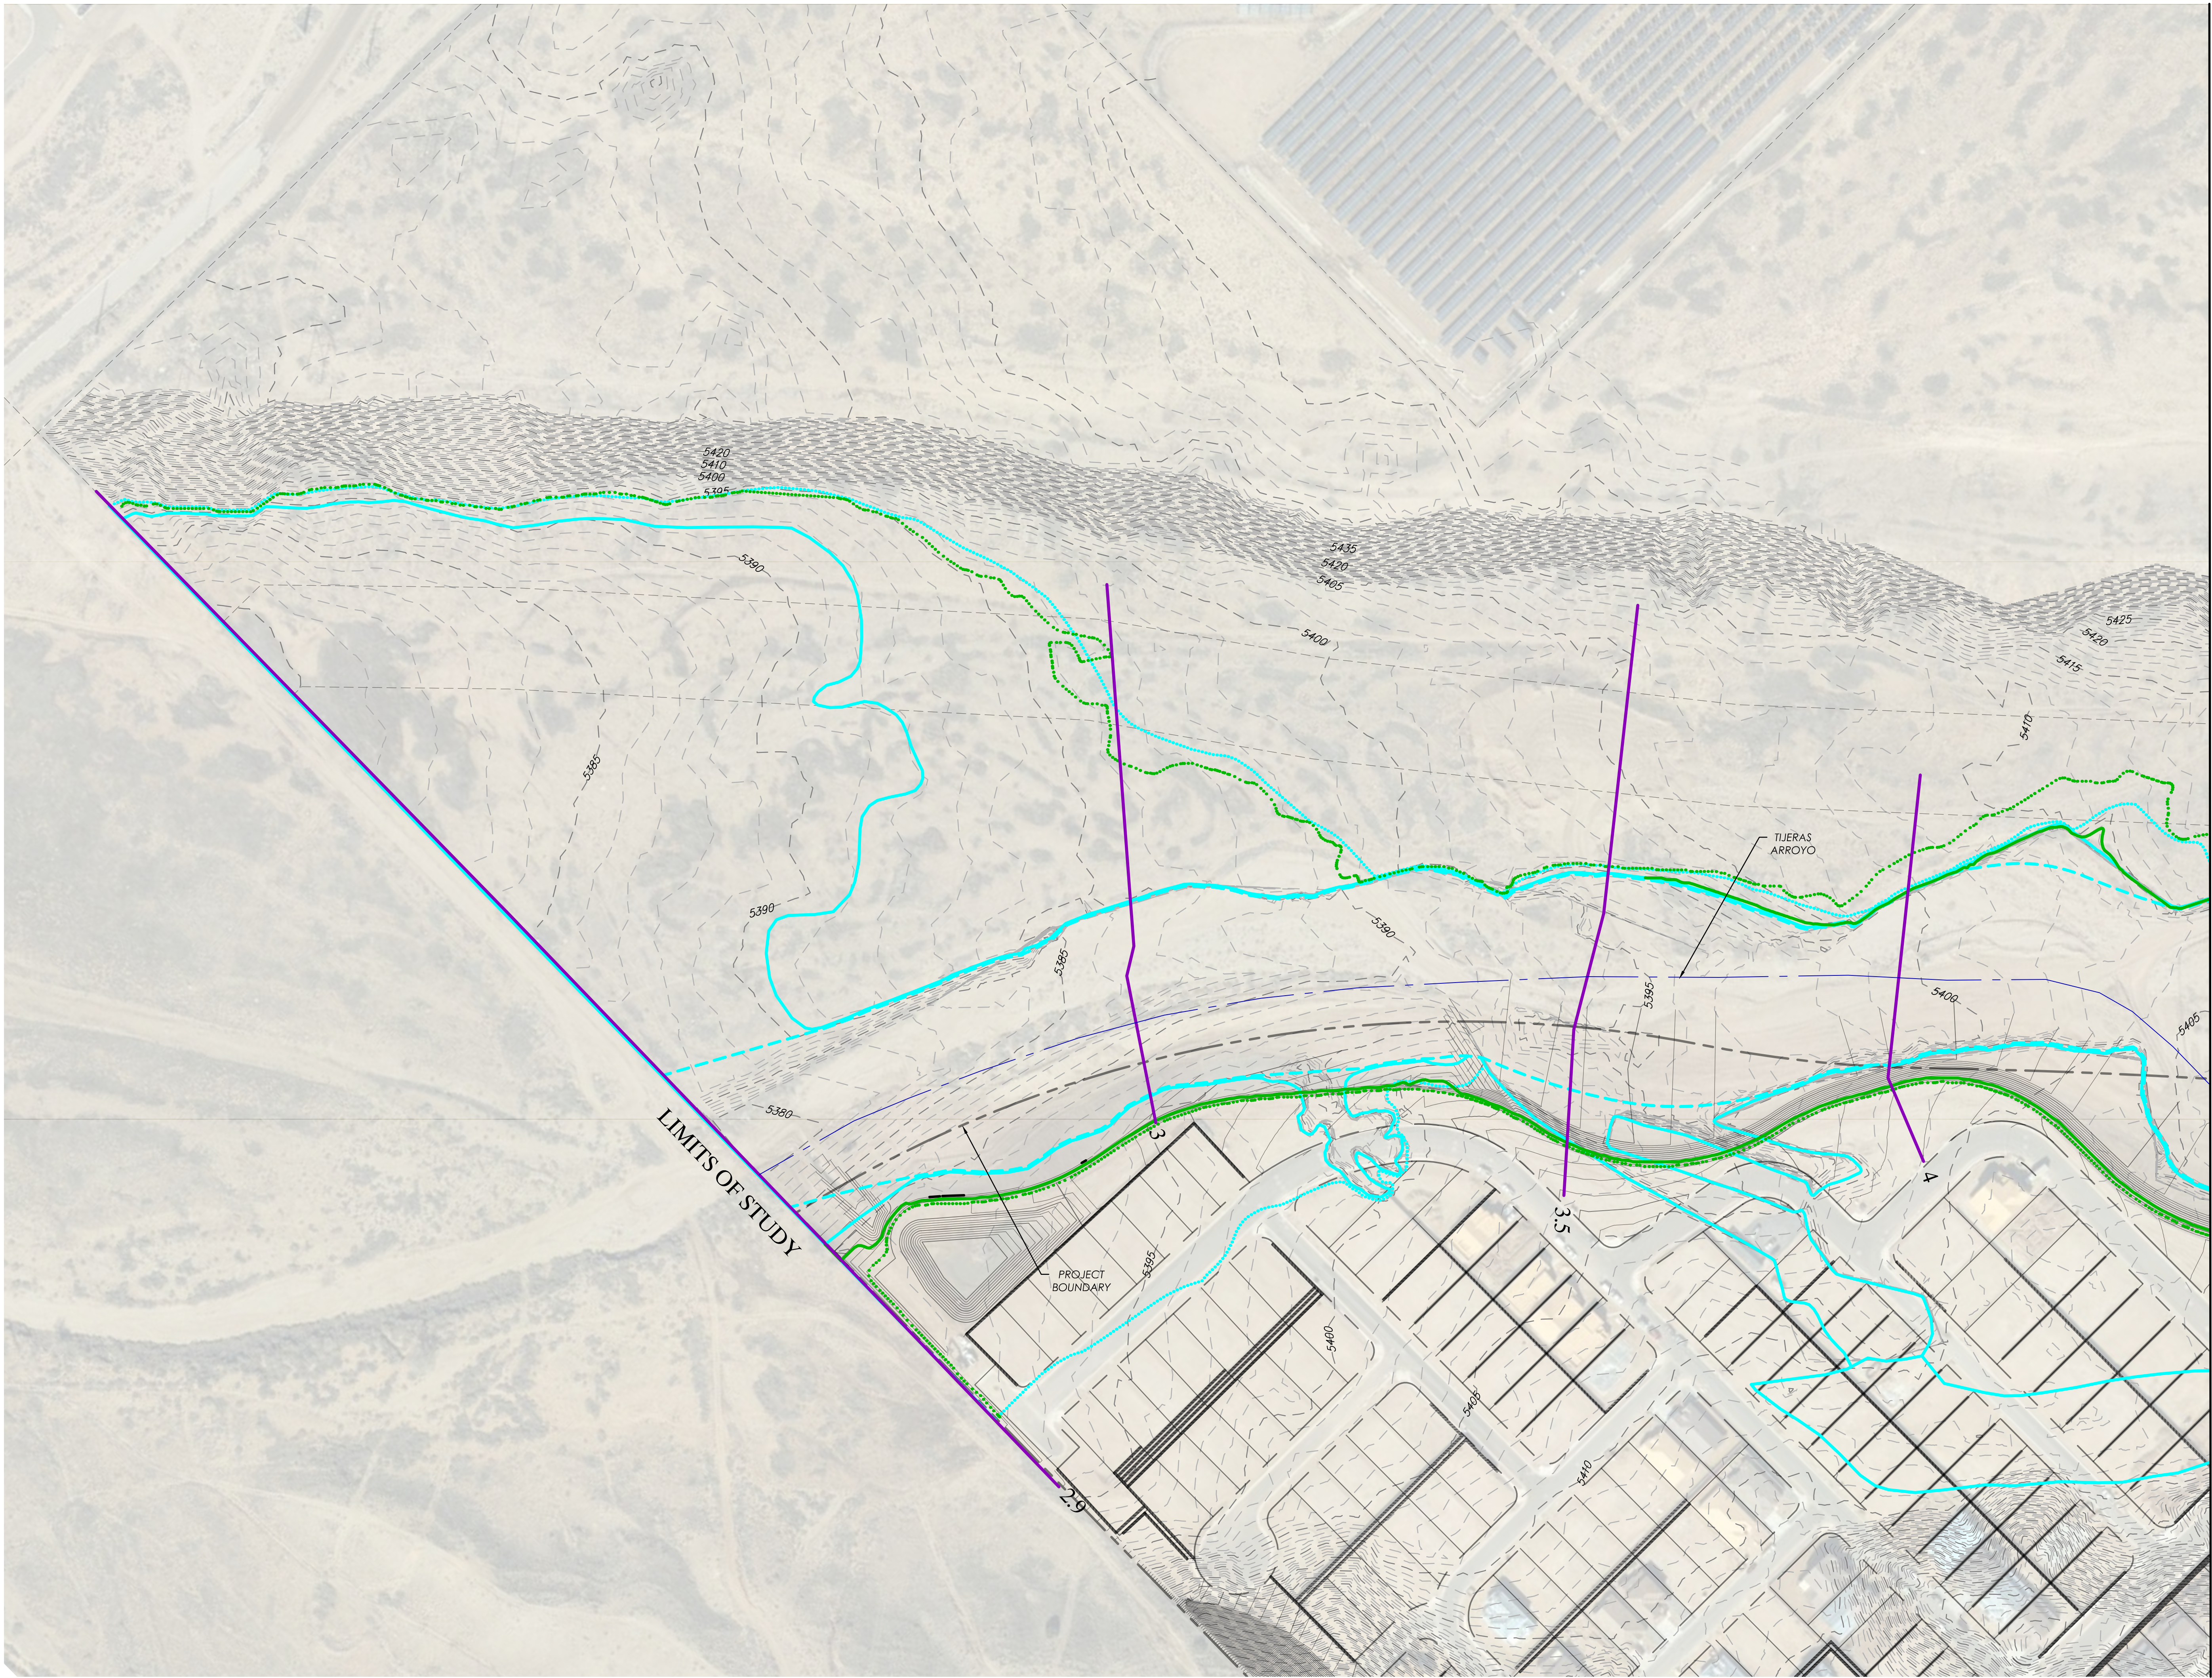

MATCHLINE - SEE PLATE 5

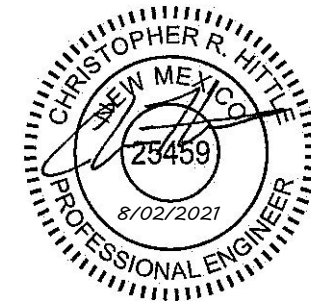

PREPARED BY:
dmg MARK GOODWIN & ASSOCIATES, P.A.
CONSULTING ENGINEERS
P.O. BOX 90806
ALBUQUERQUE, NEW MEXICO 87199
(505)828-2200, FAX (505)797-9539

**AS-BUILT CONDITION
TOPOGRAPHIC WORKMAP
OF
TIJERAS ARROYO
FOR
JUAN TABO HILLS WEST
CITY OF ALBUQUERQUE,
NEW MEXICO
Date: August 2021**